# Addendum No.6 Maple Street Shelter



September 27, 2016

MAPLE STREET SHELTER
1580 Maple Street
Redwood City, CA
Project No. PC019

Issued on September 27, 2016

Bid Due Date: October 6, 2016

#### TO ALL PLAN HOLDERS:

The following Addendum No. 6 to the above referenced project shall be included in the project Plans and Specifications.

#### A. GENERAL:

#### Item 1: Women's Correctional Facility (Jail) Demo

- a. The existing Women's Correctional Facility shall be demolished. Note that utility services for the existing adjacent Modular building are connected to Jail utilities or are attached to the jail building. Disconnect and safe off per plumbing and electrical drawings. Reconnect the Modular building power and gas service after the Jail building demolition. See plumbing and electrical drawings.
- b. Electrical power for the Shelter building originates from the main switchboard serving the jail. Shelter power shall remain in operation at all times during the jail building demolition. See electrical drawings.
- c. A Hazardous Materials Survey has been completed for the Women's Correctional Facility that is to be demolished and was added to the project scope per Addendum #5. Hazardous material abatement at the Shelter (see previously provided Shelter report) and the Jail is to be included in the project. The survey is attached for the contractor's reference.
- d. Unless otherwise noted, **ALL** items including but not limited to casework, equipment, furnishings, bunks, mattresses, exercise equipment, roof mounted HVAC, exhaust fans, boilers, water heaters, solar water heating panels, ground mounted hot water storage tank and associated piping and any other remaining materials inside or outside of the building shall be demolished, off hauled and disposed of by the Contractor.
- e. Maintain structures or utilities noted on the drawings.
- f. Demolish all structures or utilities noted on the drawings.
- g. Demolish noted existing concrete slabs on grade, and concrete foundations. Cut existing wood piles approximately 3'-0" below existing finish floor level. Backfill all removing structural elements with Class II aggregate base rock compacted to 90%. See also original building drawings for reference
- h. Underground utilities to be demolished shall be disconnected 5' +/- beyond the building perimeter and capped. Under slab plumbing shall be excavated, removed and disposed of. Backfill excavations with Class II aggregate base rock compacted to 90%.
- i. Install storm drainage, grade site to drain, and hydro-seed. See civil drawings.



#### Addendum No.6

Maple Street Shelter

#### **B. SPECIFICATIONS**

#### **Item 1: Substitution Requests**

A product substitution request was submitted for:

- a. Polystyrene foam board slab insulation specified in Section 03300, 2.2, L. The product is not required. Delete from the project.
- b. VIPER Vaporcheck II, 15-mil Class A Vapor barrier is an acceptable substitution. Submit during project as typically required.

#### Item 2: Windows

- a. Window W4 shall be a 20 minute rated hollow metal frame and glazing.
- b. Refer to Aluminum Window specification Section 08520, 2.03 A: Exterior aluminum window finish shall be the one color option per paragraph A. DELETE: paragraph B that indicates a dual color option

#### Item 3: Folding Partition

a. Refer to Folding Partition specification Section 10650, 2.01 B: Partition shall be a biparting, meeting at the center of the opening, Series 2000 accordion partition with an estimated 20 STC rating. Provide Type 15 track attached to steel stud framed drop wall per detail with side extension to provide ceiling tile protection from the partition top sweep strips.

#### **Item 4: Stainless Steel Studs**

a. Refer to specifications Section 05400, Cold Formed Metal Framing, Sheets A-7.1 Stud Sizes and Sheet S-2.2 Ceiling Framing. DELETE Reference to Stainless Steel Studs at Shower and Toilet Room cores. PROVIDE: galvanized G-90 metal studs in the specified sizes.

#### C. Drawings, Reissued and on County's Website:

#### Item 1:

The following sheets have been revised and are clouded with the current revision delta and date

- a. T-0.1 Title Sheet added or revised sheets noted
- b. SU-1 Topographic Survey
- c. A-1.2 Site, Phasing & Demolition Plan
- d. A-1.5 Site Details
- e. A-1.5.1 ADA Ramp Details
- f. A-2.0 Demo Plan Shelter
- g. A-2.1 Main Floor Plan
- h. A-2.2 Pet Kennel Plan
- i. A-2.4 Roof Plan
- j. A-4.1 Building Sections
- k. A-5.1 ADA Toilet Rooms
- I. A-5.2 ADA Toilet Rooms
- m. A-5.4 Staff Toilets
- n. A-6.1 Reflected Ceiling Plan
- o. A-6.3 Interior Elevations
- p. A-7.2 Details
- g. A-7.5 Window and Door Details



#### Addendum No.6

Maple Street Shelter

- r. A-7.8 ADA Details
- s. A-8.1 Door and Window Schedules
- t. Entire Civil Set is reissued
- u. M2.1-Rev4
- v. P0.1-Rev4
- w. P2.1 Rev4
- x. P2.4 Rev4
- v. P3.7-Rev4
- z. P3.8-Rev4
- aa. JDP-1-Rev4
- bb. JDP-2-Rev4.
- cc. E0.1A-Rev4
- dd. E0.1B-Rev4.
- ee. E2.1D-Rev4
- ff. E3.2-Rev4
- gg. E4.1-Rev4
- hh. E4.2-Rev4
- ii. E4.4-Rev4
- ii. E4.5-Rev4
- kk. E4.6-Rev4.
- II. SE2-Rev4
- mm. JDE-1-Rev4

#### Item 2: Existing Women's Correctional Center Demolition

Per Addendum #5, the existing Women's Correctional Center, on the same site and adjacent to the Shelter building, shall be demolished under this contract with all demolished materials to be off hauled or recycled per jurisdictional requirements.

See attached revised Site Demolition Plan, Civil Grading/Drainage and Utility Plans and original building drawings for reference:

- a. A-1.2 Site, Phasing and Demolition Plan
- b. C-3.2 Grading & Drainage Plan
- c. C-4.2 Utility Plan

Marked up original building drawings for reference

- d. JD -2.7 Jail Demo Existing Foundation
- e. JD-2.7.1 Jail Demo- Existing Foundation Details
- f. JD-2.7.2 Jail Demo Precast Panels and CMU Walls
- g. JD-2.8 Jail Demo First Floor
- h. JD-2.9 Jail Demo 2<sup>nd</sup> Floor and Sections
- i. JD-2.10 Jail Demo Exterior Elevations
- j. JD-2.11 Jail Demo Upper Roof Plan, Panel and Steel Details
- k. JD-2.12 Jail Demo Miscellaneous Structural Wall Sections and Details
- I. JDP-1 Rev4 Jail Demo- Site Plumbing
- m. JDP-2 Rev4 Jail Demo Building Plumbing
- n. JDE-1 Rev4 Jail Demo Site Electrical

Demolish all structures shown on site plan Sheet A-1.2, remove the existing floor slab, and existing wood piles to 3' below the existing finish floor and grade the site to drain. See also additional building



#### Addendum No.6

Maple Street Shelter

drawings, a hazardous material survey and site grading information will be forthcoming.

Notice of Intent (NOI) and SWPPP requirements will be included.

The building site perimeter and interior will be accessible on the non-mandatory walk through date noted above.

Item 2: See Sheet S-2.4 Roof Framing Plan.
REVISE Detail cut B/S-2 at line 7 between lines G and I to B/S-3.7

#### D. Landscape Irrigation Drawings/Specifications, NOT Reissued:

#### Item 1:

Refer to Landscape drawings and landscape specifications:

DELETE requirement to provide provision for future connection of the irrigation system to future provided recycled water.

Maintain requirement for future connection of recycled water to the facility toilets and laundry.

Questions regarding this project should be directed to Department of Public Works, 555 County Center, 5<sup>th</sup> Floor, Redwood City, California, 94063-1065 (Project Manager is Johnny Chiem, <a href="mailto:jchiem@smcgov.org">jchiem@smcgov.org</a>, 650-599-1349)



# Addendum No.6 Maple Street Shelter

# **Confirmation of Receipt**

This form must be returned with your proposal or received by proposal due date

#### Addendum No. 6

MAPLE STREET SHELTER 1580 Maple Street Redwood City, CA Project No. PC019 Department of Public Works 555 County Center, 5<sup>th</sup> Floor Redwood City, CA 94063

This is to confirm that <b>Addendum No. 6 issued on</b>	has
been received and that all information contained in the addendum has into the Contractor's proposal.	s been incorporated
By Contractors:	
Company Name	
Authorized Signature	
Print Name	
Date	



## Pre-Renovation Hazardous Materials Survey Former Women's Jail 1590 Maple Street, Redwood City, California



Prepared for:



Department of Public Works 555 County Center, 5th Floor Redwood City, CA 94063

Prepared By: Vista Environmental Consulting 2984 Teagarden Street San Leandro, CA 94577

> September 19, 2016 Project No. 161101005

## TABLE OF CONTENTS

#### **EXECUTIVE SUMMARY**

		PAGE
1.	INTRODUCTION	1
2.	METHODOLOGY	1
3.	RESULTS	4
4.	RECOMMENDATIONS	10
5.	LIMITATIONS & EXCLUSIONS	14

#### **APPENDICES**

#### A. BUILDING DATA

Hazardous Materials Summary
Asbestos Sampling Inventory
Sample and Asbestos-Containing Materials Locations Drawings
Asbestos Analytical Reports
Lead XRF Sequential Reports

#### **EXECUTIVE SUMMARY**

Vista Environmental Consulting (Vista) performed a pre-renovation hazardous materials survey at the Former Women's Jail located at 1590 Maple Street, Redwood City, California. The survey was performed to identify and sample accessible suspect asbestos-containing materials, to identify representative building components for the presence of lead-containing surface coatings/lead-based paints (LCSC/LBP), and to visually identify universal waste (UW) materials, polychlorinated biphenyls (PCBs) containing devices, devices which contain ozone depleting chemicals, and other hazardous materials. Vista performed the hazardous materials survey on August 31 and September 12, 2016.

The results of the survey indicate that the following hazardous materials may be in the path of construction areas:

#### Asbestos

MATERIAL	DESCRIPTION	LOCATION	ESTIMATED QUANTITY
Mastic	Black	Associated with Vinyl Floor Tiles: 12" White with Gray Streaks, Marble Pattern, Room 24, Room 38 (Stair Landings)	319 SF
Mechanical Curb/Parapet	White	Upper Roof	3,428 SF
Vinyl Sheet Flooring	Tan, Pebble Pattern	Rooms (31, 32, 43, 44, 57, 58. 59, 60, 61, 62, 64, 72, 84, 85)	348 SF
Vinyl Floor Tile/Mastic	12" Beige, Gray with White Streaks/Black	Room 26 & Stair Landings	180 SF
Mastic	Yellow & Black	Associated with 12" Beige Vinyl Floor Tile with Brown & White Streak, Under Cabinets Rooms (22, 52)	363 SF
Vinyl Floor Tile/Mastic	12" White with Tan Streaks/Black	Room 38	158 SF

#### Lead-Based Paint and Materials

Room	Component	Substrate	Color	Condition	Pb	Units
Site	Floor Stripe	Asphalt	Yellow	Deteriorated	3.9	mg/cm <sup>2</sup>

All remaining tested materials had lead concentrations in excess of the level for compliance with trigger activities, as defined in 8 CCR 1532.1.

Devices with Potential Hazardous Materials

MATERIAL	CONTAMINANT	ESTIMATED QUANTITY
Other Non-Incandescent Lamps	Universal Waste	366
Light Fixture Ballasts	Polychlorinated Biphenyls	183
HVAC	Ozone Depleting Chemicals	1
Smoke Detectors	Low-Level Radiation	13
Exit Signs	Low-Level Radiation	10

The Hazardous Materials Summary, Asbestos Sampling Inventory, Sample and Asbestos-Containing Materials Location Drawings, Asbestos Analytical Reports, Lead XRF Sequential Reports, and Photo Documentation can be found in *Appendix A – Building Data*.

The documents found in the appendices are not stand-alone documents and should not be separated from this report. Quantities and locations listed in the tables are order of magnitude estimates and are not to be used for bidding purposes. It is the sole responsibility of the contractor to verify quantities and locations of hazardous materials in the path of construction through site visits and contractual bid set documents, including, but not limited to all specifications, drawings, and addenda. Any discrepancies between the contractual bid set documentation and site visits must be submitted in writing to the Owner or Owner's representative, prior to bidding.

BAAQMD classifications are based upon the material's condition at the time of the survey or as rendered as a result of standard manual removal/demolition techniques. The use of "mechanical means", non-standard or other aggressive removal/demolition techniques may result in a different classification.

All asbestos (>0.1%) disturbance and/or removal operations must be conducted by a Cal/OSHA registered and State licensed asbestos removal contractor. All disturbance and/or abatement operations should be under the direction of a California Certified Asbestos Consultant.

Should the removal of identified regulated asbestos-containing materials (RACM) involve at least 100 square feet or 100 linear feet per project site, per year, then notification to the Bay Area Air Quality Management District (BAAQMD) and Cal/OSHA must be accomplished prior to the initiation of such activities.

All activities involving potential and identified lead-containing surfaces should be conducted in accordance with California Health & Safety Code sections 17920.10 and 10525, 10525.7, Title 8, California Code of Regulations (CCR), Section 1532.1.

In addition, all removal activities involving identified lead-based paints (LBP) must be conducted in accordance with Title 17, CCR, Division 1, Chapter 8, Sections 35001 through 36100, which prescribes the use of California Department of Public Health (CDPH) certified workers, work practices, and other requirements.

Written notification to Cal/OSHA must be accomplished should LBP activities involve equal to or more than 100 square feet or 100 linear feet of removal in accordance with the requirements of 8 CCR 1532.1.

Any welding, cutting or heating of metal surfaces containing surface coatings should be conducted in accordance with 8 CCR 1537 Welding, Cutting, and Heating of Coated Metals, which require surfaces covered with toxic preservatives, and in enclosed areas, be stripped of all toxic coatings for a distance of at least 4 inches, in all directions, from the area of heat application prior to the initiation of such heat application, or 8 CCR 1536 Ventilation Requirements for Welding, Brazing, and Cutting.

All potential and identified Universal Waste materials (UW) impacted by the work should be removed and recycled or disposed of in accordance with the UW guidelines established by the DTSC, as stated in 22 CCR Sections 66261.9 and 66273.1 thru 66273.90.

All ballasts must be visually inspected prior to disposal to determine if they contain PCB's. Those ballasts marked No PCB's or PCB Free can be considered as such and should be treated as UW - electronic waste. All PCB-containing devices, including, but not limited to ballasts should be removed or have the oils removed and properly handled, collected, stored, transported and recycled or disposed of by an approved recycling or disposal facility in accordance with the requirements of Title 22 CCR 67426.1.

Devices containing ozone depleting chemicals, petroleum or other chemicals, should be collected, waste characterized, disposed or recycled according to California rules and regulations.

Should materials similar to those identified in this report, or if other forms of suspect hazardous materials are encountered, contractors should be instructed to immediately cease work activities which may initiate an exposure episode, and notify the appropriate management personnel.

## Report prepared for the Company by:

Christopher R. Burns Senior Project Manager CAC #92-0224

LRCIA #663

#### 1.0 INTRODUCTION

Vista Environmental Consulting (Vista) performed a pre-renovation hazardous materials survey at the Former Women's Jail located at 1590 Maple Street, Redwood City, California for the County of San Mateo.

The purpose of this survey was to identify hazardous building materials so they could be removed; waste characterized, and properly disposed of prior to being impacted by renovation activities. The data provided in this report can assist all parties involved in this project make informed decisions regarding regulatory compliance and the health and safety of their employees. This survey included the following:

- Visible and accessible suspect asbestos-containing materials (ACM) were assessed and sampled to determine asbestos content.
- Representative painted and coated building components were assessed and categorized based upon standard selective demolition practices and sampled for lead content which can be used in preliminary waste stream characterization estimates and for worker protection.
- Visible and accessible materials commonly found in buildings which can potentially have hazardous properties that are regulated were assessed, but not sampled. These materials include, but are not limited to:
  - Universal Waste (UW) materials, such as non-incandescent lamps, batteries, mercury-containing devices, and electronic waste; Batteries include, but are not limited to those found in exit signs, emergency lights, fire alarm systems, and back-up power systems.
  - Polychlorinated biphenyls (PCBs) containing devices such as lamp ballasts, wettype transformers, and hydraulic systems;
  - Devices which may contain ozone depleting chemicals, such as Heating,
     Ventilation and Air Conditioning (HVAC) systems, refrigerators, freezers, fire suppression systems and water coolers/fountains.

#### 2.0 METHODOLOGY

Vista performed the hazardous materials survey on August 31 and September 12, 2016. The asbestos survey was conducted by Christopher Elliott a State of California Division of



Occupational Safety and Health (Cal/OSHA) Certified Asbestos Consultant (CAC #16-5606). The lead screening survey was conducted by Christopher Elliott, who has a Lead-Related Construction Certificate as an Inspector/Assessor (LRCIA #18373) issued by the State of California Department of Public Health (CDPH). Luis Rocha assisted on the survey.

The survey was not intrusive in nature, and did not include access of areas and sampling of materials which would have required demolition or large scale destructive testing. Roof sampling was performed using 3" stainless steel cores down to the first hard substrate. Vista's intent was to perform a thorough survey and made a good faith effort to access all building materials down to the structural components and/or interstitial spaces.

Quantities and locations are based upon areas that were accessed. Materials similar to those in this report may be present in areas which were not accessed.

Different types of fire doors were checked as part of this survey, however not all doors were checked, and/or sampled. Vista recommends that all doors are checked prior to demolition for suspect asbestos-containing materials not addressed in this report.

Sub-surface areas were not included as part of this survey, hence no excavation was conducted to discover buried asbestos utility piping concealed below the surface. The project site was not assessed for the presence of Naturally Occurring Asbestos in the soil.

#### 2.1 Asbestos

The asbestos survey was performed generally in accordance with the AHERA protocol (40 CFR Part 763, Subpart E). Visual identification was performed by assessing visible and accessible structural, architectural, and mechanical components for the presence of suspect ACM at the Project Site.

This ACM survey was conducted in the following manner:

Suspect ACM was categorized into homogeneous materials. A homogeneous material is defined as being a surfacing material, thermal system insulation, or miscellaneous material which is uniform in color and texture. It may also be additionally subcategorized using the date of installation, when available.



- A sampling scheme was developed based upon the location and quantity of the suspect homogeneous ACM. A rough order of magnitude estimate of each suspect homogeneous ACM was calculated and recorded for future reference. A sampling scheme, including a specific number of samples per suspect homogeneous ACM, was calculated prior to sampling.
- ➤ Sampling guidelines established by the United States Environmental Protection Agency (USEPA) were utilized for sampling each suspected homogeneous ACM. Methods described in Appendix K of 8 California Code of Regulation (CCR) 1529 were utilized in the collection of each suspect homogeneous ACM sample.
- ➤ Trained California asbestos certified personnel, using appropriate sampling tools and leak-tight closable bags, collected building materials that were suspected to contain ACM.
- Each suspect ACM sample was collected and sealed in its container and appropriately labeled with a unique sample identification number and recorded on an asbestos bulk sampling log. Each log contains a chain-of-custody to assure the proper transition of the samples from Vista to the analytical laboratory.
- Sampling tools were decontaminated, by using a clean wet cloth, between the collection of each suspect sample to prevent the possibility of cross contamination of subsequent suspect ACM samples.

Suspect ACM samples were delivered, under proper chain-of-custody protocol, to Forensic Analytical Laboratories in Hayward, California. Forensic Analytical Laboratories is accredited under the National Voluntary Laboratory Accreditation Program (NVLAP) and the California Environmental Laboratory Accreditation Program (Cal-ELAP). The samples were submitted for analysis by Polarized Light Microscopy (PLM) utilizing dispersion staining techniques in accordance with the EPA's "Method for the Determination of Asbestos in Bulk Building Materials" U.S. EPA/600/R-93/116, Visual Area Estimate, dated July 1993 and adopted by the NVLAP as Test Method Code 18/A01.

#### 2.2 Lead

Vista's lead construction screening survey used an X-Ray Fluorescence (XRF) direct read spectrum analyzer device to take readings of representative painted and coated surfaces for evaluation of lead levels for worker health and safety and preliminary waste characterization prior to construction activities. The device was a NITON Corporation XRF Spectrum Analyzer,



September 19, 2016 Project No. 161101005

Model XLp- 300 A. This device is a solid-state detector optimized for lead L-shell and K-shell X-ray detection and uses a 40 mCi 109Cd (1,480 Mbq) isotope for an excitation source.

This survey was a limited screening of paint for the purpose of characterizing the lead content in paint and coatings likely to be disturbed during work activities. For this purpose, XRF analysis was used to screen for lead levels and provides results that are generally representative of typical conditions but are not inclusive of all painted/coated surfaces present at the Project Site. This survey was not a surface by surface inspection as outlined in the U.S. Department of Housing and Urban Development (HUD) Guidelines For the Evaluation and Control of Lead-Based Paint Hazards in Housing pursuant to Title X of the Housing and Community Development Act of 1992. This analytical data can be helpful in evaluation of lead-related environmental risks in general, but cannot be used to calculate worker exposures and is not a substitute for employee exposure monitoring or waste stream sampling.

Lead-Based Paint (LBP) is defined by CDPH as any paint containing lead levels exceeding 0.5 wt % (or 5000 parts per million) via paint chip sampling or 1.0 milligrams per centimeter squared (mg/cm²) or greater via X-Ray Fluorescence (XRF) direct read instrument sampling. Cal/OSHA rules apply to "any detectable concentration of lead" without a specified detection level.

#### 2.3 Devices with Potential Hazardous Materials

Devices with potential hazardous materials were visually identified during the survey walk through and their quantities were estimated and recorded. No attempt was made to disassemble devices or sample suspect materials within the devices. For example, fluorescent light fixtures must be presumed to contain Universal Waste lamps and ballasts which contain PCB oil or are electronic waste, pending removal and disassembly of each unit to determine explicit product specific information that proves otherwise.

#### 3.0 RESULTS

#### **Asbestos**

The results of the bulk samples collected for asbestos, and analyzed by PLM Methodology, indicate that detectable concentrations of asbestos are present in the following materials:



HOMO. ID	MATERIAL	DESCRIPTION	LOCATION	CAL/OSHA CLASS	BAAQMD CATEGORY	ESTIMATED QUANTITY
G	Mastic	Black	Associated with Vinyl Floor Tiles: 12" White with Gray Streaks, Marble Pattern, Room 24 & Room 38 (Stair Landings)	Class II	Category I - Non-Friable	319 SF
L	Mechanical Curb	White	Upper Roof	Class II	Category I - Non-Friable	3,428 SF
U	Vinyl Sheet Flooring	Tan, Pebble Pattern	Rooms (31, 32, 43, 44, 57, 58, 59, 60, 61, 62, 64, 72, 84, 85)	Class II	Friable (RACM when Removed)	348 SF
W	Vinyl Floor Tile/Mastic	12" Beige, Gray with White Streaks/Black	Room 26 & Stair Landings	Class II	Category I - Non-Friable	180 SF
EE	Mastic	Yellow & Black, Under Cabinets	Associated with 12" Beige Vinyl Floor Tile with Brown & White Streak, Under Cabinets Rooms (22 &52)	Class II	Category I - Non-Friable	363 SF
FF	Vinyl Floor Tile/Mastic	12" White with Tan Streaks/Black	Room 38	Class II	Category I - Non-Friable	158 SF

BAAQMD classifications are based upon the material's condition at the time of the survey or as rendered as a result of standard manual removal/demolition techniques. The use of "mechanical means", non-standard or other aggressive removal/demolition techniques may result in a different classification.

The results of the bulk samples collected for asbestos, and analyzed by PLM, indicate that detectable concentrations of asbestos <u>are not present</u> in the following tested materials:

HOMOGENEOUS ID	GENEOUS ID MATERIAL DESCRIPTION		# OF SAMPLES
A	Paint/Texture Coat	Beige/White, Exterior	7
В	Texture Coat	White, Concrete Walls, Interior	7
С	Plaster	White, Walls & Ceilings	7



- 5 -

HOMOGENEOUS ID	MATERIAL	DESCRIPTION	# OF SAMPLES
D	Roof	Black, Tar & Gravel	3
E	Parapet/Mechanical Curb	White, Vinyl	3
F	Sealant	Gray Gooey, HVAC, Roof	2
Н	Sealant	White, Flashing	2
I	Mastic	Gray & Black, Patches & Penetrations	3
J	Asphalt Pads	White, Asphalt	2
K	Mastic	White, Gray, Black Residual Conduit	2
М	Sealant	White, Black Solar Panel, Roof Penetrations	2
N	Mastic	Yellow, Carpet, Tan & Blue Line Pattern	3
О	Sealant	Black, HVAC, Exterior	2
Р	Acoustic Ceiling Tile/Mastic	12"x12" Pinhole, Large Fissure/Brown	3
Q	Wallboard/Joint Compound	White/White	3
R	Texture Coat	White, Medium, Mechanical Room	3
S	Basecove/Mastic	4" Dark Blue/Brown	2
Т	Mastic	Yellow, Stair Tread	2
V	Plaster	Gray, Ceiling, Smooth	7
X	Basecove/Mastic	4" Brown/Yellow	2
Y	Grout/Mortar	White/Gray, 4" Ceramic Walls	1
Z	Grout/Mortar	Gray/Gray, 1" White Ceramic Floors	1
AA	Insulation	Yellow, Fire Door	3
BB	Acoustic Ceiling Panel	2'x4' Pinhole Fissure	2



HOMOGENEOUS ID	MATERIAL	DESCRIPTION	# OF SAMPLES
CC	Seam Tape	White, HVAC	2
DD	Vinyl Floor Tile/Mastic	12" Gray with White Streaks/Yellow	2
GG	Coating	Gray with Blue Specks, Concrete Floor	2
НН	Insulation	White, Hanger	3
II	Jacket/Insulation	White/Yellow, 6" OD pipes	1
11	Paint	Red, Concrete Floor	1
KK	Vinyl Floor Tile/Mastic	12" Plain Gray/Black	1
LL	Mastic	Black, Sink	1
MM	Vinyl Floor Tile/Mastic	12" Beige with White & Gray Streaks/Yellow	2
NN	Acoustic Ceiling Tile/Mastic	12" Pinhole Small Fissure/Yellow	1
00	Paint/Concrete Masonry Unit/Mortar	White/Gray/Light Gray	3
PP	Paint	White, Concrete Floor	1
QQ	Matt/Mastic	Brown/Brown	1
RR	Foundation	Gray	2
SS	Paint/Concrete	Beige/Gray	2
TT	Basecove/Mastic	4" Gray/Brown	1
UU	Grout/Mortar	Gray/Gray, 1" Blue Ceramic Floors	1
VV	Grout/Mastic	White/White, 5" Beige Ceramic Walls	1
WW	Mastic	Beige, Wall Panel	1
XX	Concrete	Gray, Sidewalk	2
YY	Asphalt	Black, Parking	3



HOMOGENEOUS ID	MATERIAL	DESCRIPTION	# OF SAMPLES
ZZ	Mastic	Yellow Carpet, Brown with Dark Brown Line Pattern	2
A3	Mastic	White, Carpet, Gray with Multi- Color Line Pattern	2
В3	Paint/Insulation/Mastic	White/Yellow/Brown & Black, Exterior Water Tank	3
C3	Jacketing/Insulation	Silver/Brown & Black, Exterior	1
D3	Sealant	Gray, Sidewalk, Building Wall, Exterior	2
E3	Sealant	Beige, Sidewalk, Building Wall, Exterior	1
F3	Vapor Barrier	Black, Flower Bed	2

#### Lead

For purposes of this survey, and in accordance with Title 8 CCR, Section 1532.1 (8 CCR 1532.1) and Title 17 of the California Code of Regulations, Section 35001 et. seq. the bulk paint chip sample or XRF direct read instrument results were interpreted as follows:

- Lead-based paints (LBP) are present when bulk paint chip samples revealed a lead concentration of ≥5,000 milligrams per kilogram (mg/kg) or parts per million (ppm), 0.5% by weight (wt%) or ≥1.0 milligrams per centimeter squared (mg/cm²) via XRF direct read instrument sampling.
- 2. Lead-containing paints are present when bulk paint chip samples revealed a lead concentration of <5,000 mg/kg or 0.5 wt% down to the analytical detection limit of the analysis, or <1.0 milligrams per centimeter squared (mg/cm²) via XRF direct read instrument sampling down to the detection limit of the device.
- 3. "No lead detected" was determined when bulk paint chip samples did not reveal a lead concentration above the analytical detection limit of the laboratory or direct read instrument sampling device.

The bulk paint chip results or XRF direct read instrument results for this survey indicated that the following building components and respective surface coatings have lead concentrations defining them as LBP, in accordance with Title 17 of the California Code of Regulations, Section 35001 et. seq.:



-8-

Room	Component	Substrate	Color	Condition	Pb	Units
Site	Floor Stripe	Asphalt	Yellow	Deteriorated	3.9	mg/cm <sup>2</sup>

All remaining tested materials had lead concentrations in excess of the level for compliance with trigger activities, as defined in 8 CCR 1532.1.

#### Devices with Potential Hazardous Materials

Devices with potential hazardous materials were identified at the Project Site. They are as follows:

MATERIAL	CONTAMINANT	ESTIMATED QUANTITY
Other Non-Incandescent Lamps	Universal Waste	366
Light Fixture Ballasts	Polychlorinated Biphenyls	183
HVAC	Ozone Depleting Chemicals	1
Smoke Detectors	Low-Level Radiation	13
Exit Signs	Low-Level Radiation	10

The Hazardous Materials Summary, Asbestos Sampling Inventory, Sample and Asbestos-Containing Materials Location Drawings, Asbestos Analytical Reports, and the Lead XRF Sequential Reports, and Photo Documentation can be found in *Appendix A – Building Data*.

The documents found in the appendices are not stand-alone documents and should not be separated from this report. Quantities and locations listed in the tables are order of magnitude estimates and are not to be used for bidding purposes. It is the sole responsibility of the contractor to verify quantities and locations of hazardous materials in the path of construction through site visits and contractual bid set documents, including, but not limited to all specifications, drawings, and addenda. Any discrepancies between the contractual bid set documentation and site visits must be submitted in writing to the Owner or Owner's representative, prior to bidding.

BAAQMD classifications are based upon the material's condition at the time of the survey or as rendered as a result of standard manual removal/demolition techniques. The use of "mechanical



-9-

means", non-standard or other aggressive removal/demolition techniques may result in a different classification.

#### 4.0 RECOMMENDATIONS

#### 4.1 Asbestos

Work performed during any activities that disturb the asbestos-containing materials identified in this report must be done in compliance with the most recent edition of all applicable federal, state, and local regulations, standards, and codes governing abatement, transport, and disposal of asbestos-containing materials. These include, but are not limited to, the following:

- CCR, Title 8, Chapter 3.2, Subchapter 2, Article 2.5 Registration Asbestos-Related Work Sections 341.6 through 341.14
- CCR, Title 8, Section 1529 Asbestos in the Construction Industry
- BAAQMD Regulation 11, Hazardous Pollutants, Rule 2, Asbestos Demolition, Renovation and Manufacturing
- 40 CFR Part 763 Subpart E, Asbestos Containing Materials in Schools (AHERA)

Materials encountered in the building that are not part of this report must be properly sampled for the content of asbestos or assumed to be asbestos containing prior to any disturbance.

Prior to activities which will disturb identified or assumed asbestos, a Cal/OSHA registered and California licensed asbestos contractor must be utilized for abatement of asbestos that will be impacted. Vista recommends that all abatement operations be conducted under the direction of a California Certified Asbestos Consultant.

#### 4.2 Lead

At present there is no state or federal regulation requiring mandatory lead removal or abatement prior to disturbance of building materials with identified lead paint or coatings. However, there are applicable Cal/OSHA worker protection and training requirements, Cal/EPA waste disposal requirements, CDPH requirements for public and residential buildings, and SB 460 lead hazard regulations that apply to lead-related construction activities, abatement activities and their associated wastes. The following is a brief discussion and summary of applicable regulatory requirements:



September 19, 2016 Project No. 161101005

♦ Cal/OSHA: Title 8, California Code of Regulation (CCR), Section 1532.1 (8 CCR 1532.1) governs occupational exposure to lead. This regulation requires that prior to initiation of certain activities, referred to as "trigger tasks", workers must be trained, medically evaluated, and properly fitted with respiratory protection, and protective clothing until statistically reliable personal eight-hour time weighted average (TWA) results indicate lead exposure levels below the Personal Exposure Limit (PEL) for each unique task which disturbs lead-based and lead-containing coatings. This process is known as a Negative Exposure Assessment or NEA.

If the result of the exposure assessment is above the Action Level (AL) additional monitoring is required and if the result is above the PEL additional exposure monitoring, worker protection (including respirator protection and PPE), training and medical requirements apply. However even where the NEA criteria is met, certain hazard communication training and work practice controls still apply where lead is disturbed. "Trigger tasks" are tasks that are assumed to exceed the PEL pending an exposure assessment and they encompass the majority of construction activities that disturb surface coatings. Examples of "trigger" tasks range from manual paint scraping as a lower expected exposure up to hot work and abrasive blasting as the highest expected exposures, and include any non-listed task that the employer determines may potentially expose employees to lead levels above the AL.

"OSHA does not consider any method that relies solely on the analysis of bulk materials or surface content of lead (or other toxic material) to be acceptable for safely predicting employee exposure to airborne contaminates. Without air monitoring results or without the benefit of historical or objective data (including air sampling which clearly demonstrates that the employee can not be exposed above the action level during any process, operation, or activity) the analysis of bulk or surface samples can not be used to determine employee exposure." OSHA Standard Interpretation May 8, 2000.

OSHA states that these rules apply to "any detectable concentration of lead" without a specified detection level. Due to the Consumer Product Safety Commission currently allowing paint to contain up to 90 parts per million (ppm) or 0.009 wt% of lead, the variation of lead content due to aging and weathering, and the variation of detection limits associated with analysis of bulk materials, such as paint chips and surface content analysis via XRF, it is recommended that all painted or coated surfaces be treated as potentially containing lead. Positive analytical results by either method can be used to indicate that detectable lead is present but negative results cannot be interpreted as conclusively demonstrating the absence of lead.



- 11 -

Analytical data from analysis of bulk materials or surface content of lead can be helpful in evaluation of lead-related environmental risks in general but cannot be used to calculate worker exposures and are not a substitute for employee exposure monitoring. As a result of the above, any employee that works around potential lead-based or lead-containing coatings must have HAZCOM training and personal exposure air monitoring is additionally required for employees that disturb such coatings. Significant additional certification, notification, and work practices are required for materials found to be lead-based.

Any welding, cutting or heating of metal surfaces containing surface coatings should be conducted in accordance with 29 CFR 1926.354 and 8 CCR 1537. These regulations require surfaces covered with toxic preservatives, and in enclosed areas, be stripped of all toxic coatings for a distance of at least 4 inches, in all directions, from the area of heat application prior to the initiation of such heat application.

- ♦ Cal/EPA through the Division of Toxic Substance Control (DTSC) regulates disposal of lead hazardous waste (22 CCR Division 4.5, Minimum Standards for Management of Hazardous and Extremely Hazardous Wastes). DTSC has issued guidance indicating that architectural debris with intact lead paint is normally expected to be handled as general construction waste. However, waste stream segregation and analysis is still required for all lead painted or coated debris regardless if the paint or coating is intact on a building component or not. The resulting wastes may be hazardous under California and federal RCRA standards for lead and therefore require proper handling, packaging, labeling, and transportation under a proper manifest to a permitted hazardous waste storage, treatment and disposal facility.
- ♦ CDPH: The Department of Public Health (CDPH) has specific requirements (Title 17 Sections 35001 thru 36100 et. al.) for hazard assessment and work in public or residential structures in regards to lead-based paint. These regulations require special certifications, work practices, and notification for such activities.
- ♦ Senate Bill 460 (SB 460): An act to amend Section 1941.1 of the Civil Code, and to amend Sections 17961, 17980, and 124130 of, and to add Sections 17920.10, 105251, 105252, 105253, 105254, 105255, 105256, and 105257 to, the Health and Safety Code, relating to lead abatement. This bill allows for fines and criminal penalties to be levied on any person who is found to have performed lead abatement without containment or created a measurable "lead hazard" based



September 19, 2016 Project No. 161101005

upon current CDPH standards. A "lead hazard" means deteriorated lead-based paint, lead contaminated dust, lead contaminated soil, disturbing lead-based paint or presumed lead-based paint without containment, or any other nuisance which may result in persistent and quantifiable lead exposure.

Vista recommends that all parties that come into contact with paint and dust that has detectable lead content follow all applicable federal, state and local regulations relating to employee health and safety and proper disposal of generated wastes.

#### 4.3 Devices with Potential Hazardous Materials

All potential and identified Universal Waste materials (UW) impacted by the work should be removed and recycled or disposed of in accordance with the UW guidelines established by the DTSC, as stated in 22 CCR Sections 66261.9 and 66273.1 thru 66273.90.

Vista's limited visual survey indicated that light fixtures with ballasts that may contain PCB oil are present. However, due to the limited nature of the random spot checks, Vista recommends that all ballasts be visually inspected prior to disposal to determine if they contain PCB's. Those ballasts marked No PCB's or PCB Free can be considered as such as should be treated as UW - electronic waste.

All PCB-containing devices, including, but not limited to ballasts and transformers should be removed or have the oils removed and properly handled, collected, stored, transported and recycled or disposed of by an approved recycling or disposal facility in accordance with the requirements of Title 22 CCR 67426.1.

Devices containing ozone depleting chemicals, petroleum or other chemicals, should be collected, waste characterized, disposed or recycled according to California rules and regulations.

If the underground storage tanks still exist, the closure of them requires following all local rules and regulations for obtaining permits, performing soil sampling and obtaining closure certification on the tank system.



All personnel who perform hazardous materials work must be trained and qualified to do so. They must also follow the most current OSHA regulations including 29 CFR 1910.120 and 8 CCR 5192, Hazardous Waste Operations and Emergency Response, as well as other applicable federal, state and local laws and regulations.

#### 5.0 LIMITATIONS & EXCLUSIONS

The following areas were not accessible for sampling during the survey field work:

- Storage Closets Rooms 97
- Mechanical Pipe Chases

Quantities and locations are based upon areas that were accessed. Materials similar those in this report may be present in areas which were not accessed. Because of this, Vista recommends including line item pricing, allowances, and/or additive/deductive wording to bid sheets for unforeseen conditions.

All material quantities reported herein are rough order of magnitude estimates and should not be used for bidding purposes. All contractors are responsible for accurately determining quantities and locations of materials identified in this report.

The survey performed was limited to representative rooms/areas, was not intrusive in nature, and did not include access of areas and sampling of materials which would have required demolition or large scale destructive testing. Roof sampling was performed using 3" stainless steel cores down to the first hard substrate. Vista made a good faith effort based on accepted industry standards to access all areas in order to assess their potential for having hazardous materials, however additional materials such as vinyl floor tile or mastics may be under carpeting or other floor finishes and fixtures, piping and elbows may be inside wall or ceiling voids, and additional layers of roofing may be under the first layer of hard substrate. Vista made every effort to access these areas, however because non-destructive techniques had to be employed since staff were still using the buildings, not all interstitial spaces could be accessed.



Respectfully Submitted, Vista Environmental Consulting

Reviewed and Approved

Charles R. Bove Principal

CAC #92-0160

Christopher R. Burns



# FORMER WOMEN'S JAIL 1590 MAPLE STREET, REDWOOD CITY, CA HAZARDOUS MATERIALS SUMMARY

#### Asbestos

HOMO. ID	MATERIAL	DESCRIPTION	LOCATION	CAL/OSHA CLASS	BAAQMD CATEGORY	ESTIMATED QUANTITY
G	Mastic	Black	Associated with Vinyl Floor Tiles: 12" White with Gray Streaks, Marble Pattern, Room 24, Room 38 (Stair Landings)	Class II	Category I - Non-Friable	319 SF
L	Mechanical Curb/Parapet	White	Upper Roof	Class II	Category I - Non-Friable	3,428 SF
U	Vinyl Sheet Flooring	Tan, Pebble Pattern	Rooms (31, 32, 43, 44, 57, 58, 59, 60 61, 62, 64, 72, 84, 85)	Class II	Friable (RACM when Removed)	348 SF
W	Vinyl Floor Tile/Mastic	12" Beige, Gray with White Streaks/Black	Room 26 & Stair Landings	Class II	Category I - Non-Friable	180 SF
EE	Mastic	Yellow & Black	Associated with 12" Beige Vinyl Floor Tile with Brown & White Streak, Under Cabinets Rooms (22, 52)	Class II	Category I - Non-Friable	363 SF
FF	Vinyl Floor Tile/Mastic	12" White with Tan Streaks/Black	Room 38	Class II	Category I - Non-Friable	158 SF

#### Lead-Based Paint and Materials

Room	Component	Substrate	Color	Condition	Pb	Units
Site	Floor Stripe	Asphalt	Yellow	Deteriorated	3.9	mg/cm <sup>2</sup>

All remaining tested materials had lead concentrations in excess of the level for compliance with trigger activities, as defined in 8 CCR 1532.1.

#### Other Hazardous Materials

MATERIAL	CONTAMINANT	ESTIMATED QUANTITY
Other Non-Incandescent Lamps	Universal Waste	366
Light Fixture Ballasts	Polychlorinated Biphenyls	183



# FORMER WOMEN'S JAIL 1590 MAPLE STREET, REDWOOD CITY, CA HAZARDOUS MATERIALS SUMMARY

MATERIAL	CONTAMINANT	ESTIMATED QUANTITY
HVAC	Ozone Depleting Chemicals	1
Smoke Detectors	Low-Level Radiation	13
Exit Signs	Low-Level Radiation	10



# FORMER WOMEN'S JAIL 1590 MAPLE STREET, REDWOOD CITY, CA ASBESTOS SAMPLING INVENTORY

HOMOGENEOUS ID MATERIAL		DESCRIPTION	# OF SAMPLES
A	Paint/Texture Coat	Beige/White, Exterior	7
В	Texture Coat	White, Concrete Walls, Interior	7
С	Plaster	White, Walls & Ceilings	7
D	Roof	Black, Tar & Gravel	3
Е	Parapet/Mechanical Curb	White, Vinyl	3
F	Sealant	Gray Gooey, HVAC, Roof	2
G	Vinyl Floor Tile/Mastic	12" White with Gray Streaks, Marble Pattern/Black	2
Н	Sealant	White, Flashing	2
I	Mastic	Gray & Black, Patches & Penetrations	3
J	Asphalt Pads	White, Asphalt	2
K	Mastic	White, Gray, Black Residual Conduit	2
L	Mechanical Curb/Parapet	White, Asphalt, Upper Roof	1
M	Sealant	White, Black Solar Panel, Roof Penetrations	2
N	Mastic	Yellow, Carpet, Tan & Blue Line Pattern	3
О	Sealant	Black, HVAC, Exterior	2
P	Acoustic Ceiling Tile/Mastic	12"x12" Pinhole, Large Fissure/Brown	3
Q	Wallboard/Joint Compound	White/White	3
R	Texture Coat	White, Medium, Mechanical Room	3
S	Basecove/Mastic	4" Dark Blue/Brown	2
Т	Mastic	Yellow, Stair Tread	2
U	Vinyl Sheet Flooring	Tan, Pebble Pattern	2



# FORMER WOMEN'S JAIL 1590 MAPLE STREET, REDWOOD CITY, CA ASBESTOS SAMPLING INVENTORY


HOMOGENEOUS ID	MATERIAL	DESCRIPTION	# OF SAMPLES
V	Plaster	Gray, Ceiling, Smooth	7
W	Vinyl Floor Tile/Mastic	12" Beige, Gray with White Streaks/Black	2
X	Basecove/Mastic	4" Brown/Yellow	2
Y	Grout/Mortar	White/Gray, 4" Ceramic Walls	1
Z	Grout/Mortar	Gray/Gray, 1" White Ceramic Floors	1
AA	Insulation	Yellow, Fire Door	3
ВВ	Acoustic Ceiling Panel	2'x4' Pinhole Fissure	2
CC	Seam Tape	White, HVAC	2
DD	Vinyl Floor Tile/Mastic	12" Gray with White Streaks/Yellow	2
EE Vinyl Floor Tile/Mastic		12" Beige with Brown & White Streaks/ Yellow & Black, Under Cabinets	2
FF	Vinyl Floor Tile/Mastic	12" White with Tan Streaks/Black	2
GG	Coating	Gray with Blue Specks, Concrete Floor	2
НН	Insulation	White, Hanger	3
II	Jacket/Insulation White/Yellow, 6" Ol		1
JJ	JJ Paint		1
KK	Vinyl Floor Tile/Mastic	12" Plain Gray/Black	1
LL	Mastic	Black, Sink	1
MM	Vinyl Floor Tile/Mastic	12" Beige with White & Gray Streaks/Yellow	2
NN	Acoustic Ceiling Tile/Mastic	12" Pinhole Small Fissure/Yellow	1
00	Paint/Concrete Masonry Unit/Mortar	White/Gray/Light Gray	3
PP	Paint	White, Concrete Floor	1





# FORMER WOMEN'S JAIL 1590 MAPLE STREET, REDWOOD CITY, CA ASBESTOS SAMPLING INVENTORY


HOMOGENEOUS ID	MATERIAL	DESCRIPTION	# OF SAMPLES
QQ	Matt/Mastic	Brown/Brown	1
RR	Foundation	Gray	2
SS	Paint/Concrete	Beige/Gray	2
TT	Basecove/Mastic	4" Gray/Brown	1
UU	Grout/Mortar	Gray/Gray, 1" Blue Ceramic Floors	1
VV	Grout/Mastic	White/White, 5" Beige Ceramic Walls	1
ww	Mastic	Beige, Wall Panel	1
XX	Concrete	Gray, Sidewalk	2
YY	Asphalt	Black, Parking	3
ZZ	Mastic	Yellow Carpet, Brown with Dark Brown Line Pattern	2
A3	Mastic	White, Carpet, Gray with Multi- Color Line Pattern	2
В3	Paint/Insulation/Mastic	White/Yellow/Brown & Black, Exterior Water Tank	3
C3	Jacketing/Insulation	Silver/Brown & Black, Exterior	1
D3	Sealant	Gray, Sidewalk, Building Wall, Exterior	2
E3	Sealant	Beige, Sidewalk, Building Wall, Exterior	1
F3	Vapor Barrier	Black, Flower Bed	2




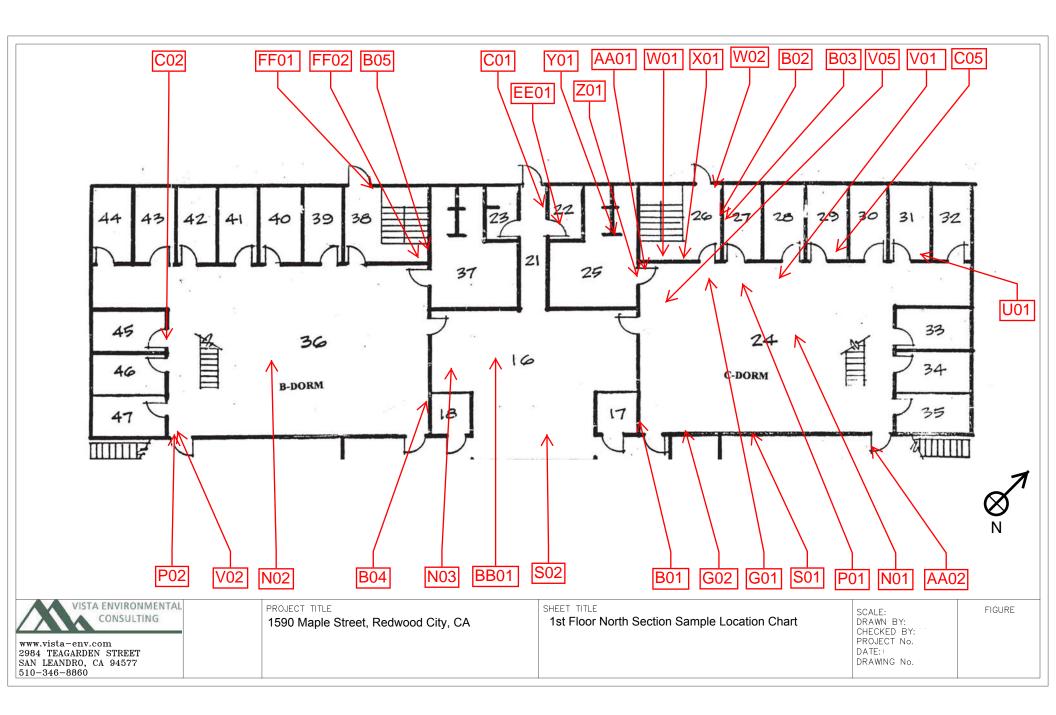


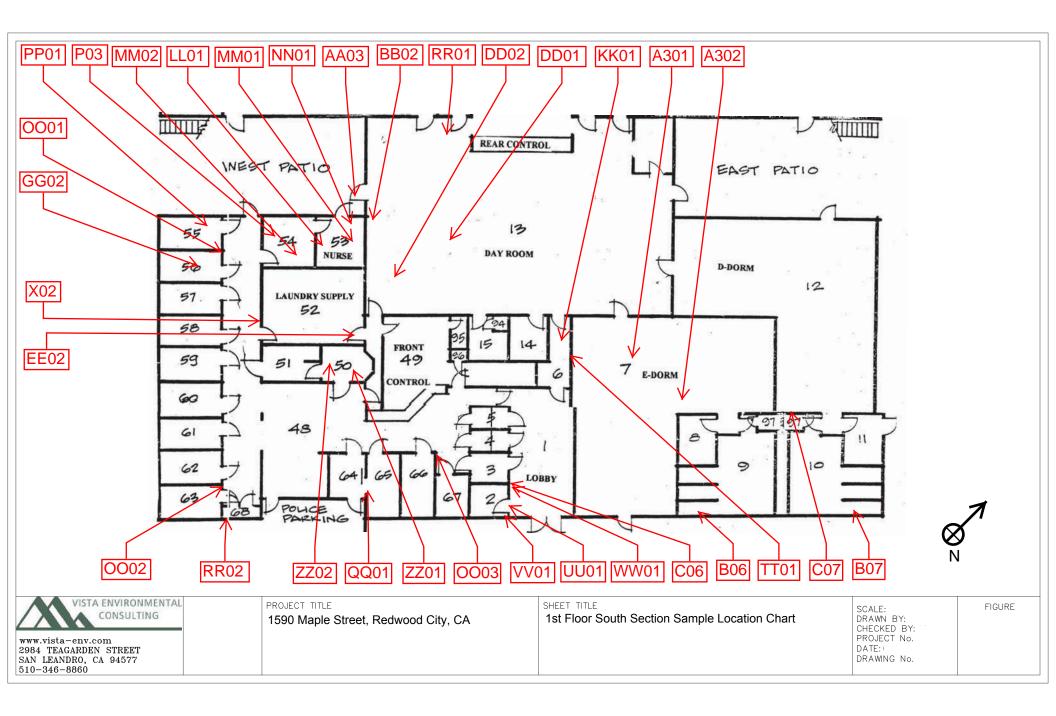

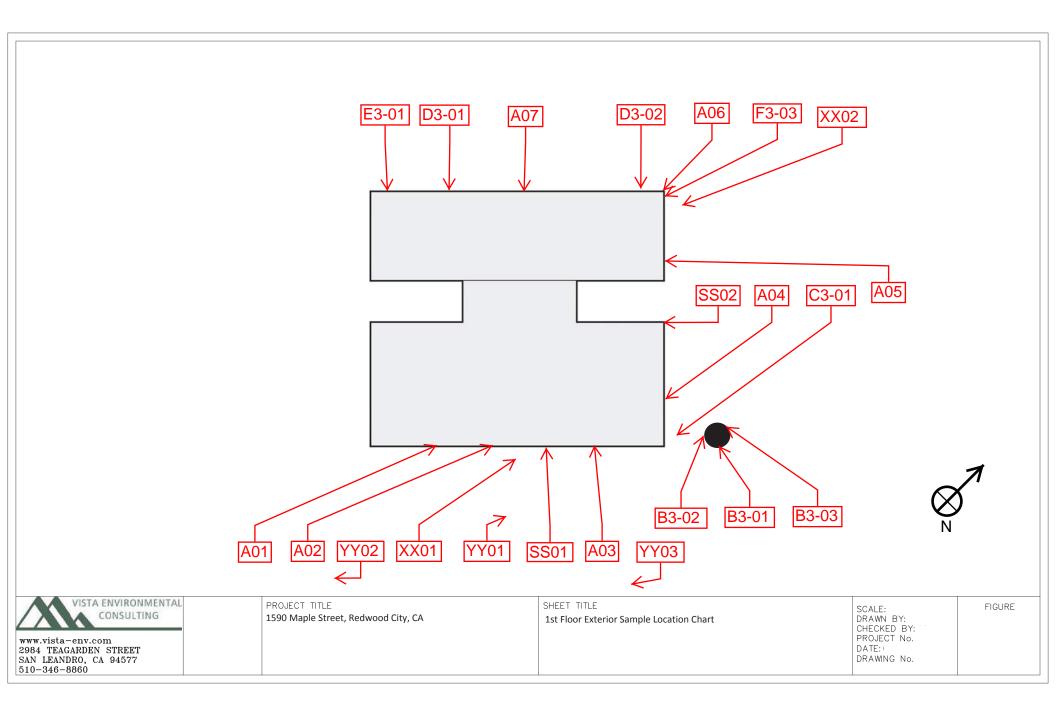

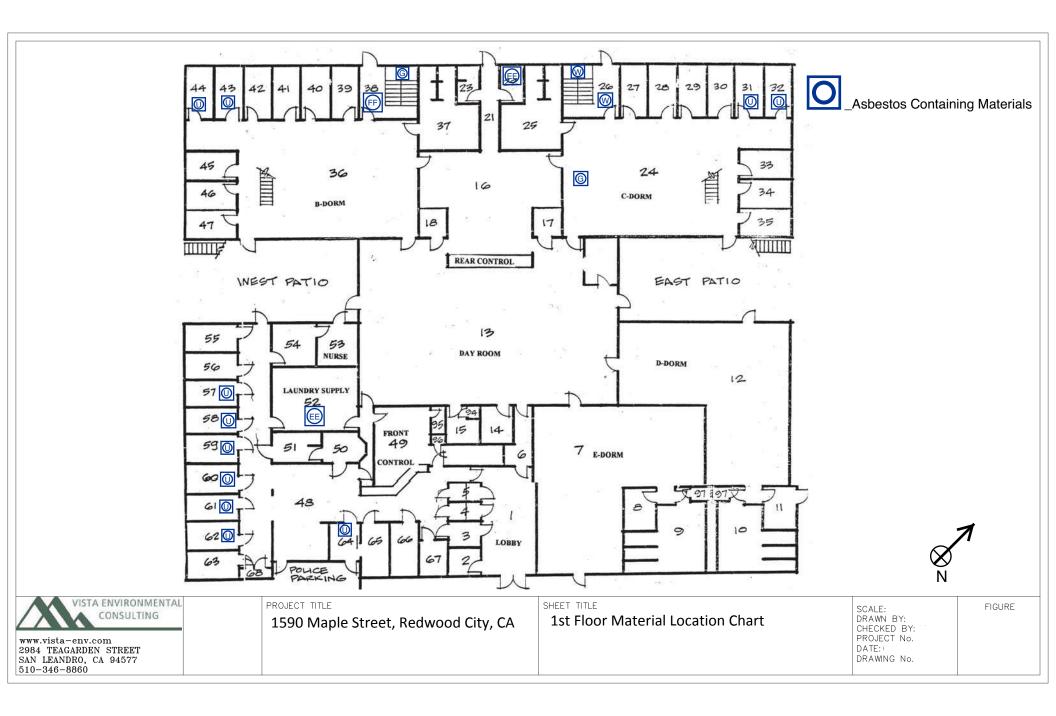

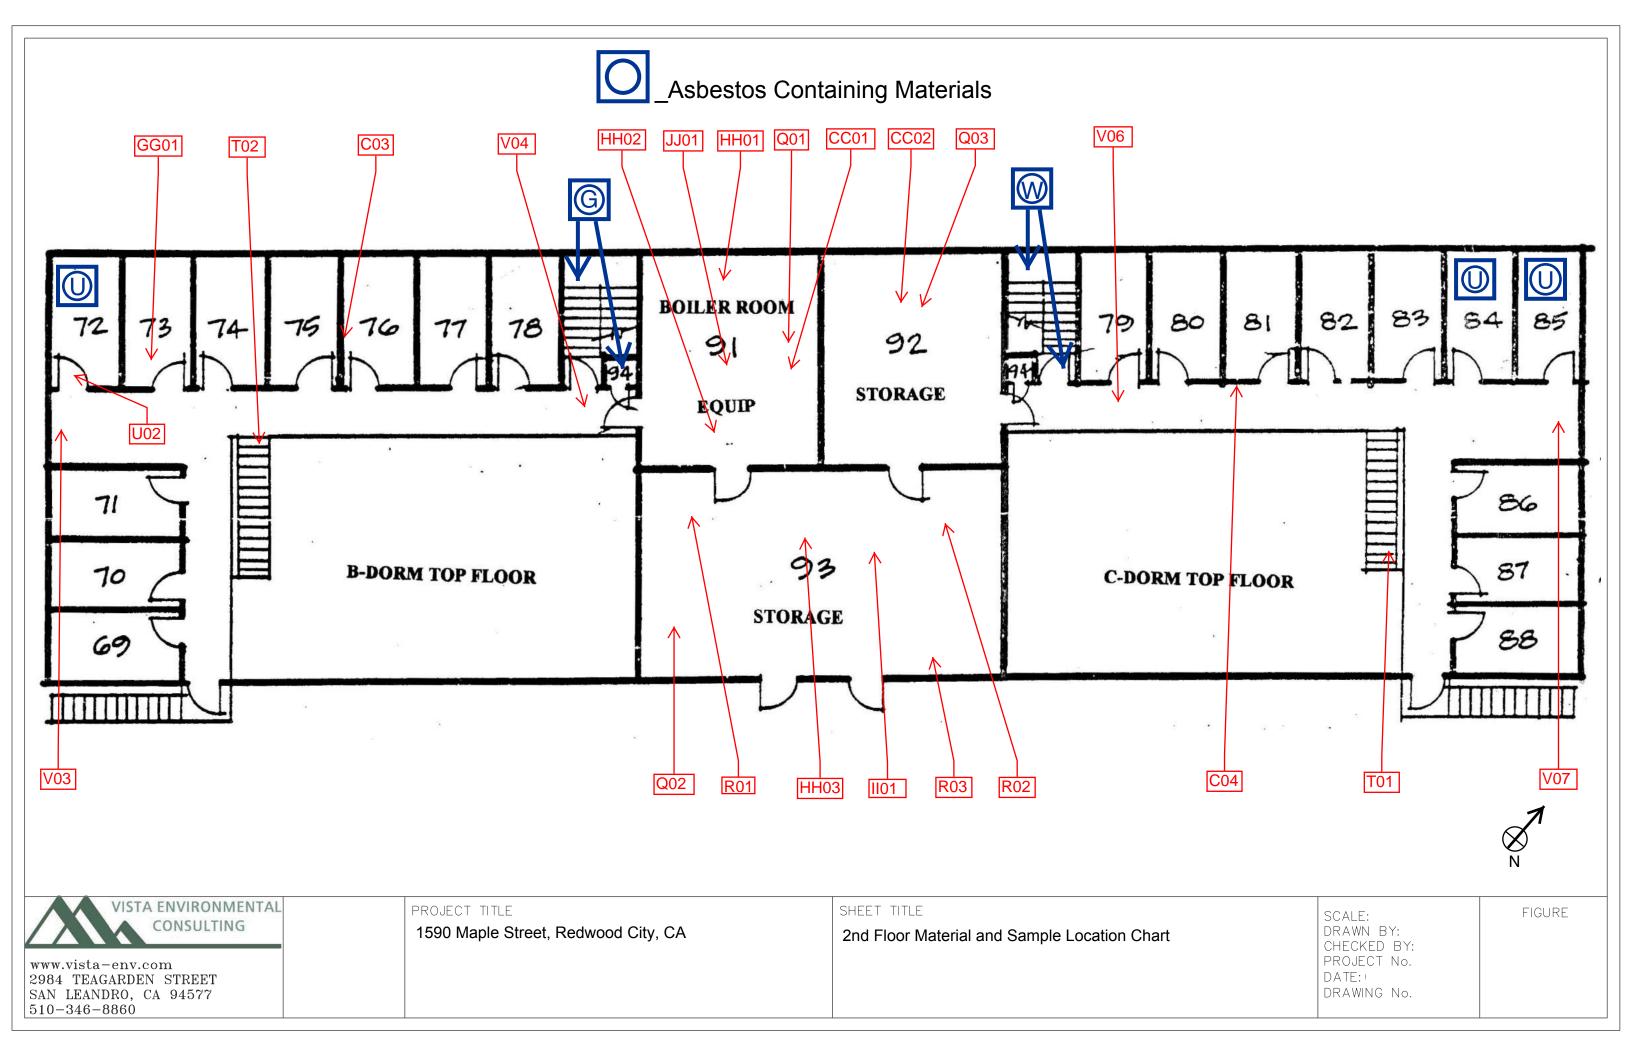

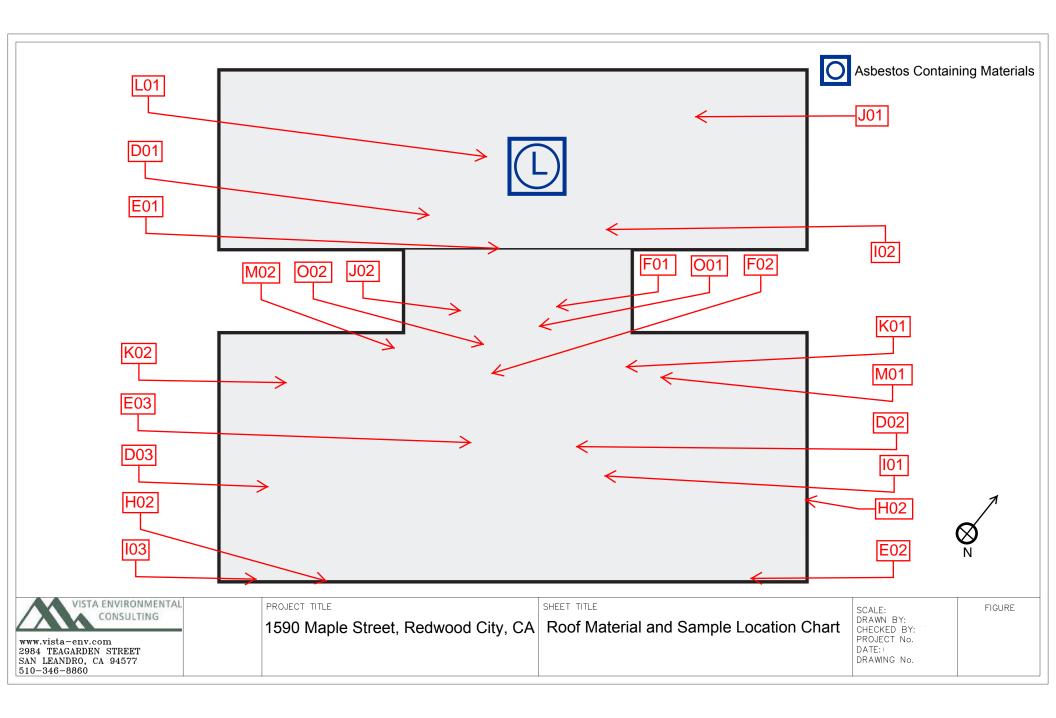



### **Bulk Asbestos Analysis**

(EPA Method 600/R-93-116, Visual Area Estimation)

Vista Environmental Consultants **Client ID:** L1161 Project Manager **Report Number:** B227496 2984 Teagarden St. **Date Received:** 09/06/16 **Date Analyzed:** 09/07/16 San Leandro, CA 94577 **Date Printed:** 09/07/16 09/07/16 First Reported: **Job ID/Site:** 161101005 - 1590 Maple St., Redwood City, CA 95063 FALI Job ID: L1161 **Total Samples Submitted:** 119 **Date(s) Collected:** 08/31/2016 **Total Samples Analyzed:** Percent in Asbestos Percent in Asbestos Percent in Asbestos Sample ID Lab Number Type Layer Type Layer Type Layer 1590-A01 11805538 Layer: White Texture ND ND Layer: Paint Total Composite Values of Fibrous Components: Asbestos (ND) Cellulose (Trace) 1590-A02 11805539 Layer: White Texture ND ND Layer: Paint Total Composite Values of Fibrous Components: Asbestos (ND) Cellulose (Trace) 11805540 1590-A03 ND Layer: White Texture Layer: Paint ND Total Composite Values of Fibrous Components: Asbestos (ND) Cellulose (Trace) 1590-A04 11805541 Layer: White Texture ND Layer: Paint ND Total Composite Values of Fibrous Components: Asbestos (ND) Cellulose (Trace) 1590-A05 11805542 Layer: White Texture ND ND Layer: Paint Total Composite Values of Fibrous Components: Asbestos (ND) Cellulose (Trace) 1590-A06 11805543 ND Layer: White Texture Layer: Paint ND Total Composite Values of Fibrous Components: Asbestos (ND) Cellulose (Trace)

Sample ID	Lab Numbe	Asbestos er Type	Percent in Layer	Asbestos Type	Percent in Layer	Asbestos Type	Percent in Layer
1590-A07 Layer: White Texture Layer: Paint	11805544		ND ND				
Total Composite Values of Fibrous Con Cellulose (Trace)	nponents:	Asbestos (ND)					
1590-B01 Layer: Tan Texture Layer: Paint	11805545		ND ND				
Total Composite Values of Fibrous Con Cellulose (Trace)	ponents:	Asbestos (ND)					
1590-B02 Layer: Tan Texture Layer: Paint	11805546		ND ND				
Total Composite Values of Fibrous Con Cellulose (Trace)	iponents:	Asbestos (ND)					
1590-B03 Layer: Tan Texture Layer: Paint	11805547		ND ND				
Total Composite Values of Fibrous Con Cellulose (Trace)	ponents:	Asbestos (ND)					
1590-B04 Layer: Tan Texture Layer: Paint	11805548		ND ND				
Total Composite Values of Fibrous Con Cellulose (Trace)	nponents:	Asbestos (ND)					
1590-B05  Layer: Tan Texture  Layer: Paint	11805549		ND ND				
Total Composite Values of Fibrous Con Cellulose (Trace)	ponents:	Asbestos (ND)					
1590-B06  Layer: Tan Texture  Layer: Paint	11805550		ND ND				
Total Composite Values of Fibrous Con Cellulose (Trace)	ponents:	Asbestos (ND)					
1590-B07 Layer: Tan Texture Layer: Paint	11805551		ND ND				
Total Composite Values of Fibrous Con Cellulose (Trace)	nponents:	Asbestos (ND)					

Sample ID	Lab Numbe	Asbestos r Type	Percent in Layer	Asbestos Type	Percent in Layer	Asbestos Type	Percent in Layer
1590-C01 Layer: Grey Plaster Layer: Paint	11805552		ND ND				
Total Composite Values of Fibrous Con Cellulose (Trace)	mponents:	Asbestos (ND)					
1590-C02  Layer: Grey Plaster  Layer: Brown Plaster  Layer: Paint	11805553		ND ND ND				
Total Composite Values of Fibrous Con Cellulose (Trace)	mponents:	Asbestos (ND)					
1590-C03  Layer: Grey Plaster  Layer: Brown Plaster  Layer: Paint	11805554		ND ND ND				
Total Composite Values of Fibrous Cor Cellulose (Trace)	mponents:	Asbestos (ND)					
1590-C04  Layer: Grey Plaster  Layer: Light Grey Plaster  Layer: Paint	11805555		ND ND ND				
Total Composite Values of Fibrous Cor Cellulose (Trace)	mponents:	Asbestos (ND)					
1590-C05  Layer: Grey Plaster  Layer: Light Grey Plaster  Layer: Paint	11805556		ND ND ND				
Total Composite Values of Fibrous Cor Cellulose (Trace)	mponents:	Asbestos (ND)					
1590-C06  Layer: Grey Plaster  Layer: White Plaster  Layer: Paint	11805557		ND ND ND				
Total Composite Values of Fibrous Con Cellulose (Trace)	mponents:	Asbestos (ND)					
1590-C07  Layer: Grey Plaster  Layer: Light Grey Plaster  Layer: Paint	11805558		ND ND ND				
Total Composite Values of Fibrous Cor Cellulose (Trace)	mponents:	Asbestos (ND)					

Sample ID	Lab Number	Asbestos Type	Percent in Layer	Asbestos Type	Percent in Layer	Asbestos Type	Percent in Layer
1590-D01  Layer: Black Tar  Layer: Black Felt  Layer: Black Tar  Layer: Black Felt  Layer: Yellow Foam	11805559		ND ND ND ND ND				
Total Composite Values of Fibrous Cor Cellulose (15 %) Fibrous Glass (5	_	sbestos (ND)					
1590-D02  Layer: Black Tar  Layer: Black Felt  Layer: Black Tar  Layer: Black Felt  Layer: Brown Fibrous Material  Layer: Yellow Foam	11805560		ND ND ND ND ND				
Total Composite Values of Fibrous Cor Cellulose (20 %) Fibrous Glass (5		sbestos (ND)					
1590-D03  Layer: Black Semi-Fibrous Tar  Layer: Yellow Fibrous Material  Layer: Yellow Foam	11805561		ND ND ND				
Total Composite Values of Fibrous Cor Fibrous Glass (40 %)	mponents: A	sbestos (ND)					
Layer: White Coating Layer: Stones Layer: Black Tar Layer: Black Felt Layer: Black Tar Layer: Black Tar Layer: Black Tar Layer: Black Felt Layer: Black Felt	11805562		ND ND ND ND ND ND ND				
Total Composite Values of Fibrous Cor Cellulose (40 %) Fibrous Glass (10	•	sbestos (ND)					
Layer: White Coating Layer: Black Tar Layer: Black Felt Layer: Black Tar Layer: Black Tar Layer: Black Felt Layer: Brown Fibrous Material	11805563		ND ND ND ND ND				
Total Composite Values of Fibrous Cor Cellulose (40 %) Fibrous Glass (10	_	sbestos (ND)					

Sample ID	Lab Numbe	Asbestos r Type	Percent in Layer	Asbestos Type	Percent in Layer	Asbestos Type	Percent in Layer
1590-E03	11805564						
Layer: White Coating			ND				
Layer: Black Tar			ND				
Layer: Black Felt			ND				
Layer: Black Tar			ND				
Layer: Black Felt			ND				
Layer: Brown Fibrous Material			ND				
Total Composite Values of Fibrous Cor	-	Asbestos (ND)					
Cellulose (40 %) Fibrous Glass (10							
1590-F01	11805565						
Layer: Grey Non-Fibrous Material			ND				
Layer: Paint			ND				
Total Composite Values of Fibrous Cor Cellulose (Trace)	mponents:	Asbestos (ND)					
1590-F02	11805566						
Layer: Grey Non-Fibrous Material			ND				
Layer: Paint			ND				
Total Composite Values of Fibrous Cor	mnonents:	Asbestos (ND)					
Cellulose (Trace)	пропента.	Asbestos (ND)					
1590-G01	11805567						
Layer: White Tile			ND				
Layer: Yellow Mastic			ND				
Layer: Black Mastic		Chrysotile	2 %				
Total Composite Values of Fibrous Cor	nponents:	Asbestos (Trace	e)				
Cellulose (Trace)	r	(	-,				
1590-G02	11805568						
Layer: White Tile			ND				
Layer: Yellow Mastic			ND				
Total Composite Values of Fibrous Cor	mnonents:	Asbestos (ND)					
Cellulose (Trace)	iipoliciits.	Aspestos (ND)					
1590-H01	11805569						
Layer: White Non-Fibrous Material			ND				
Layer: Paint			ND				
Total Composite Values of Fibrous Cor	nponents:	Asbestos (ND)					
Cellulose (Trace)	1	(-1)					
1590-Н02	11805570						
Layer: White Non-Fibrous Material			ND				
Layer: Grey Non-Fibrous Material			ND				
Total Composite Values of Fibrous Cor	mponents:	Asbestos (ND)					
1590-I01	11805571						
Layer: Black Mastic	11000011		ND				
Total Composite Values of Fibrous Cor	nponents:	Asbestos (ND)					
Fibrous Glass (5 %)	г	(1,2)					

Client Name: Vista Environmental Consultants 09/07/16 Asbestos Percent in Asbestos Percent in Asbestos Percent in Sample ID Lab Number Type Layer Type Layer Type Layer 1590-I02 11805572 Layer: Black Mastic ND Total Composite Values of Fibrous Components: Asbestos (ND) Fibrous Glass (5 %) 1590-I03 11805573 ND Layer: Black Mastic Total Composite Values of Fibrous Components: Asbestos (ND) 1590-J01 11805574 Layer: Black Semi-Fibrous Tar ND Total Composite Values of Fibrous Components: Asbestos (ND) Fibrous Glass (5 %) 1590-J02 11805575 ND Layer: Black Semi-Fibrous Tar Total Composite Values of Fibrous Components: Asbestos (ND) Fibrous Glass (5 %) 11805576 1590-K01 Layer: Black Mastic ND Layer: White Coating ND Total Composite Values of Fibrous Components: Asbestos (ND) Cellulose (Trace) 1590-K02 11805577 ND Layer: Black Mastic ND Layer: White Coating Total Composite Values of Fibrous Components: Asbestos (ND) Cellulose (Trace) 1590-L01 11805578 ND Layer: Black Tar Layer: Stones ND Layer: Black Tar ND Layer: Black Felt Chrysotile 10 % Layer: Black Felt ND Total Composite Values of Fibrous Components: Asbestos (5%) Cellulose (45 %) Fibrous Glass (5 %) 1590-M01 11805579 Layer: White Non-Fibrous Material ND Layer: Paint ND Total Composite Values of Fibrous Components: Asbestos (ND) Cellulose (Trace) 11805580 1590-M02 ND Layer: White Non-Fibrous Material Layer: Paint ND Total Composite Values of Fibrous Components: Asbestos (ND) Cellulose (Trace)

**Report Number:** B227496

**Date Printed:** Client Name: Vista Environmental Consultants 09/07/16

Sample ID	Lab Numbe	Asbestos er Type	Percent in Layer	Asbestos Type	Percent in Layer	Asbestos Type	Percent in Layer
1590-N01 Layer: Yellow Mastic	11805581		ND				_
Total Composite Values of Fibrous Co Synthetic (Trace)	emponents:	Asbestos (ND)					
1590-N02 Layer: Yellow Mastic	11805582		ND				
Total Composite Values of Fibrous Co Synthetic (Trace)	emponents:	Asbestos (ND)					
1590-N03 Layer: Yellow Mastic	11805583		ND				
Total Composite Values of Fibrous Co Synthetic (Trace)	emponents:	Asbestos (ND)					
<b>1590-O01</b> Layer: Grey Non-Fibrous Material	11805584		ND				
Total Composite Values of Fibrous Co	omponents:	Asbestos (ND)					
<b>1590-O02</b> Layer: Grey Non-Fibrous Material	11805585		ND				
Total Composite Values of Fibrous Co	omponents:	Asbestos (ND)					
1590-P01  Layer: Brown Mastic  Layer: Beige Fibrous Material  Layer: Paint	11805586		ND ND ND				
Total Composite Values of Fibrous Co Cellulose (35 %) Fibrous Glass (4	-	Asbestos (ND)					
1590-P02  Layer: Yellow Mastic  Layer: Beige Fibrous Material  Layer: Paint	11805587		ND ND ND				
Total Composite Values of Fibrous Co Cellulose (35 %) Fibrous Glass (4	•	Asbestos (ND)					
1590-P03  Layer: Yellow Mastic  Layer: Beige Fibrous Material  Layer: Paint	11805588		ND ND ND				
Total Composite Values of Fibrous Co Cellulose (35 %) Fibrous Glass (4	_	Asbestos (ND)					
1590-Q01  Layer: White Drywall  Layer: White Joint Compound	11805589		ND ND				
Total Composite Values of Fibrous Co Cellulose (20 %) Fibrous Glass (1	-	Asbestos (ND)					

Sample ID	Lab Number	Asbestos r Type	Percent in Layer	Asbestos Type	Percent in Layer	Asbestos Type	Percent in Layer
1590-Q02  Layer: White Drywall  Layer: White Joint Compound  Layer: White Tape  Layer: White Joint Compound	11805590		ND ND ND ND				
Total Composite Values of Fibrous Com Cellulose (20 %) Fibrous Glass (10	•	Asbestos (ND)					
1590-Q03  Layer: White Drywall  Layer: White Joint Compound  Layer: White Tape  Layer: White Joint Compound	11805591		ND ND ND ND				
Total Composite Values of Fibrous Com Cellulose (20 %) Fibrous Glass (10	_	Asbestos (ND)					
1590-R01 Layer: White Drywall Layer: White Texture	11805592		ND ND				
Total Composite Values of Fibrous Com Cellulose (20 %) Fibrous Glass (10	-	Asbestos (ND)					
1590-R02  Layer: White Drywall  Layer: White Texture	11805593		ND ND				
Total Composite Values of Fibrous Com Cellulose (20 %) Fibrous Glass (10	•	Asbestos (ND)					
1590-R03  Layer: White Drywall  Layer: White Texture	11805594		ND ND				
Total Composite Values of Fibrous Com Cellulose (20 %) Fibrous Glass (10	-	Asbestos (ND)					
1590-S01  Layer: Blue Non-Fibrous Material  Layer: White Mastic  Layer: Paint  Layer: Brown Mastic	11805595		ND ND ND ND				
Total Composite Values of Fibrous Com	ponents:	Asbestos (ND)					
Layer: Blue Non-Fibrous Material Layer: White Mastic Layer: Paint Layer: Brown Mastic	11805596		ND ND ND ND				
Total Composite Values of Fibrous Com	ponents:	Asbestos (ND)					

Client Name: Vista Environmental Consultants

Asbestos Percent in Asbestos Percent in Asbestos Percent in Sample ID Lab Number Type Layer Type Layer Type Layer 1590-T01 11805597 Layer: Grey Non-Fibrous Material ND Layer: Yellow Mastic ND Layer: Paint ND Total Composite Values of Fibrous Components: Asbestos (ND) 1590-T02 11805598 Layer: Blue Non-Fibrous Material ND Layer: Yellow Mastic ND Layer: Paint ND Total Composite Values of Fibrous Components: Asbestos (ND) 1590-U01 11805599 ND Layer: Tan Sheet Flooring Layer: Fibrous Backing ND Layer: Yellow Mastic **ND** Total Composite Values of Fibrous Components: Asbestos (ND) Cellulose (20 %) Fibrous Glass (5 %) Synthetic (10 %) 1590-U02 11805600 Layer: Tan Sheet Flooring ND Layer: Fibrous Backing Chrysotile 70 % Layer: Yellow Mastic ND Total Composite Values of Fibrous Components: Asbestos (25%) Cellulose (5 %) 1590-V01 11805601 Layer: Grey Plaster ND Layer: Paint ND Total Composite Values of Fibrous Components: Asbestos (ND) Cellulose (Trace) 1590-V02 11805602 Layer: Grey Plaster ND Layer: Paint ND Total Composite Values of Fibrous Components: Asbestos (ND) Cellulose (Trace) 1590-V03 11805603 Layer: Grey Plaster ND Layer: Paint ND Total Composite Values of Fibrous Components: Asbestos (ND) Cellulose (Trace) 1590-V04 11805604 ND Layer: Grey Plaster ND Layer: Paint Total Composite Values of Fibrous Components: Asbestos (ND) Cellulose (Trace)

Sample ID	Lab Numbe	Asbestos r Type	Percent in Layer	Asbestos Type	Percent in Layer	Asbestos Type	Percent in Layer
1590-V05  Layer: Beige Fibrous Material  Layer: Grey Plaster  Layer: Paint	11805605		ND ND ND				
Total Composite Values of Fibrous Com Cellulose (40 %) Fibrous Glass (30		Asbestos (ND)					
1590-V06 Layer: Grey Plaster Layer: Paint	11805606		ND ND				
Total Composite Values of Fibrous Com Cellulose (Trace)	ponents:	Asbestos (ND)					
1590-V07  Layer: Grey Plaster  Layer: Paint	11805607		ND ND				
Total Composite Values of Fibrous Com- Cellulose (Trace)	ponents:	Asbestos (ND)					
1590-W01 Layer: Beige Tile Layer: Black Mastic	11805608	Chrysotile Chrysotile	2 % 2 %				
Total Composite Values of Fibrous Com Cellulose (Trace)	ponents:	Asbestos (2%)					
1590-W02 Layer: Beige Tile Layer: Black Mastic	11805609	Chrysotile Chrysotile	2 % 2 %				
Total Composite Values of Fibrous Com Cellulose (Trace)	ponents:	Asbestos (2%)					
1590-X01 Layer: Brown Non-Fibrous Material Layer: Yellow Mastic	11805610		ND ND				
Total Composite Values of Fibrous Com	ponents:	Asbestos (ND)					
1590-X02 Layer: Brown Non-Fibrous Material Layer: Yellow Mastic	11805611		ND ND				
Total Composite Values of Fibrous Com	ponents:	Asbestos (ND)					
1590-Y01  Layer: White Grout  Layer: Grey Cementitious Material  Layer: Light Grey Cementitious Materia	11805612 1		ND ND ND				
Total Composite Values of Fibrous Com	ponents:	Asbestos (ND)					

Sample ID	Lab Numbe	Asbestos er Type	Percent in Layer	Asbestos Type	Percent in Layer	Asbestos Type	Percent in Layer
1590-Z01  Layer: White Ceramic Tile  Layer: Grey Grout  Layer: Grey Mortar	11805613		ND ND ND				
Total Composite Values of Fibrous Con Cellulose (5 %)	iponents:	Asbestos (ND)					
<b>1590-AA01</b> Layer: Yellow Fibrous Material	11805614		ND				
Total Composite Values of Fibrous Com Fibrous Glass (95 %)	nponents:	Asbestos (ND)					
<b>1590-AA02</b> Layer: Yellow Fibrous Material	11805615		ND				
Total Composite Values of Fibrous Com Fibrous Glass (95 %)	nponents:	Asbestos (ND)					
<b>1590-AA03</b> Layer: Yellow Fibrous Material	11805616		ND				
Total Composite Values of Fibrous Com Fibrous Glass (95 %)	nponents:	Asbestos (ND)					
<b>1590-BB01</b> Layer: Beige Fibrous Material Layer: Paint	11805617		ND ND				
Total Composite Values of Fibrous Com Cellulose (70 %) Fibrous Glass (10	-	Asbestos (ND)					
<b>1590-BB02</b> Layer: Beige Fibrous Material Layer: Paint	11805618		ND ND				
Total Composite Values of Fibrous Com Cellulose (70 %) Fibrous Glass (10	-	Asbestos (ND)					
1590-CC01 Layer: White Tape	11805619		ND				
Total Composite Values of Fibrous Com Cellulose (90 %)	nponents:	Asbestos (ND)					
1590-CC02 Layer: White Tape	11805620		ND				
Total Composite Values of Fibrous Com Cellulose (90 %)	nponents:	Asbestos (ND)					
1590-EE01  Layer: Tan Tile  Layer: Yellow Mastic	11805621		ND ND				
Total Composite Values of Fibrous Com Cellulose (Trace)	nponents:	Asbestos (ND)					

Sample ID	Lab Numbe	Asbestos r Type	Percent in Layer	Asbestos Type	Percent in Layer	Asbestos Type	Percent in Layer
1590-EE02 Layer: Beige Tile Layer: Black Mastic	11805622	Chrysotile	ND 5 %				
Total Composite Values of Fibrous Com Cellulose (Trace)	ponents:	Asbestos (Trace	)				
1590-DD01 Layer: Grey Tile Layer: Yellow Mastic	11805623		ND ND				
Total Composite Values of Fibrous Com Cellulose (Trace)	ponents:	Asbestos (ND)					
1590-DD02 Layer: Grey Tile Layer: Yellow Mastic	11805624		ND ND				
Total Composite Values of Fibrous Com Cellulose (Trace)	ponents:	Asbestos (ND)					
1590-FF01  Layer: White Tile  Layer: Black Mastic	11805625	Chrysotile	ND 2 %				
Total Composite Values of Fibrous Com Cellulose (Trace)	ponents:	Asbestos (Trace	)				
1590-FF02 Layer: Off-White Tile Layer: Black Mastic	11805626	Chrysotile Chrysotile	Trace 5 %				
Total Composite Values of Fibrous Com Cellulose (Trace)	ponents:	Asbestos (Trace	)				
1590-GG01 Layer: Grey Coating	11805627		ND				
Total Composite Values of Fibrous Com	ponents:	Asbestos (ND)					
1590-GG02  Layer: Grey Cementitious Material  Layer: Grey Coating	11805628		ND ND				
Total Composite Values of Fibrous Com	ponents:	Asbestos (ND)					
<b>1590-HH01</b> Layer: Tan Semi-Fibrous Material	11805629		ND				
Total Composite Values of Fibrous Com Fibrous Glass (2 %) Synthetic (5 %)	•	Asbestos (ND)					
<b>1590-HH02</b> Layer: Tan Semi-Fibrous Material	11805630		ND				
Total Composite Values of Fibrous Com Fibrous Glass (2 %) Synthetic (5 %)	-	Asbestos (ND)					

**Report Number:** B227496

**Date Printed:** Client Name: Vista Environmental Consultants 09/07/16

Sample ID	Lab Numbe	Asbestos r Type	Percent in Layer	Asbestos Type	Percent in Layer	Asbestos Type	Percent in Layer
<b>1590-HH03</b> Layer: White Semi-Fibrous Material	11805631		ND				
Total Composite Values of Fibrous Con Cellulose (7 %)	mponents:	Asbestos (ND)					
1590-II01  Layer: Yellow Fibrous Material  Layer: White Fibrous Material  Layer: Yellow Mastic  Layer: Foil	11805632		ND ND ND ND				
Total Composite Values of Fibrous Con Cellulose (5 %) Fibrous Glass (90 %)		Asbestos (ND)					
1590-JJ01  Layer: Grey Cementitious Material  Layer: Paint	11805633		ND ND				
Total Composite Values of Fibrous Con Cellulose (Trace)	mponents:	Asbestos (ND)					
1590-KK01 Layer: Grey Tile Layer: Black Mastic	11805634		ND ND				
Total Composite Values of Fibrous Con Cellulose (Trace)	mponents:	Asbestos (ND)					
<b>1590-LL01</b> Layer: Black Mastic	11805635		ND				
Total Composite Values of Fibrous Con Cellulose (Trace)	mponents:	Asbestos (ND)					
1590-MM01 Layer: Beige Tile Layer: Yellow Mastic	11805636		ND ND				
Total Composite Values of Fibrous Con Cellulose (Trace)	nponents:	Asbestos (ND)					
1590-MM02 Layer: Beige Tile Layer: Yellow Mastic	11805637		ND ND				
Total Composite Values of Fibrous Con Cellulose (Trace)	mponents:	Asbestos (ND)					
1590-NN01  Layer: Yellow Mastic  Layer: Beige Fibrous Material  Layer: Paint	11805638		ND ND ND				
Total Composite Values of Fibrous Con Cellulose (35 %) Fibrous Glass (45	_	Asbestos (ND)					

**Report Number:** B227496 **Date Printed:** Client Name: Vista Environmental Consultants 09/07/16

Sample ID	Lab Number	Asbestos Type	Percent in Layer	Asbestos Type	Percent in Layer	Asbestos Type	Percent in Layer
1590-OO01  Layer: Grey Cementitious Material  Layer: Paint	11805639		ND ND				
Total Composite Values of Fibrous Co Cellulose (Trace)	mponents:	Asbestos (ND)					
1590-OO02  Layer: Grey Cementitious Material  Layer: Grey Cementitious Material  Layer: Paint	11805640		ND ND ND				
Total Composite Values of Fibrous Co Cellulose (Trace)	mponents:	Asbestos (ND)					
1590-OO03  Layer: Grey Cementitious Material  Layer: Grey Cementitious Material  Layer: Paint	11805641		ND ND ND				
Total Composite Values of Fibrous Co Cellulose (Trace)	mponents:	Asbestos (ND)					
1590-PP01 Layer: White Paint	11805642		ND				
Total Composite Values of Fibrous Co	mponents:	Asbestos (ND)					
1590-QQ01 Layer: Brown Non-Fibrous Material Layer: Beige Mastic	11805643		ND ND				
Total Composite Values of Fibrous Co	mponents:	Asbestos (ND)					
<b>1590-RR01</b> Layer: Grey Cementitious Material	11805644		ND				
Total Composite Values of Fibrous Co	mponents:	Asbestos (ND)					
1590-RR02 Layer: Grey Cementitious Material	11805645		ND				
Total Composite Values of Fibrous Co	mponents:	Asbestos (ND)					
1590-SS01  Layer: Grey Cementitious Material  Layer: Paint	11805646		ND ND				
Total Composite Values of Fibrous Co Cellulose (Trace)	mponents:	Asbestos (ND)					
1590-SS02  Layer: Grey Cementitious Material  Layer: Paint	11805647		ND ND				
Total Composite Values of Fibrous Co Cellulose (Trace)	mponents:	Asbestos (ND)					

**Report Number:** B227496

**Date Printed:** Client Name: Vista Environmental Consultants 09/07/16

Sample ID	Lab Number	Asbestos r Type	Percent in Layer	Asbestos Type	Percent in Layer	Asbestos Type	Percent in Layer
1590-TT01 Layer: Grey Non-Fibrous Material Layer: Brown Mastic	11805648		ND ND				
Total Composite Values of Fibrous Com	ponents:	Asbestos (ND)					
1590-UU01  Layer: Blue Cementitious Material  Layer: Grey Cementitious Material  Layer: Black Mastic	11805649		ND ND ND				
Total Composite Values of Fibrous Com	ponents:	Asbestos (ND)					
1590-VV01  Layer: Brown Non-Fibrous Material  Layer: White Non-Fibrous Material	11805650		ND ND				
Total Composite Values of Fibrous Com	ponents:	Asbestos (ND)					
1590-WW01  Layer: Grey Cementitious Material Layer: Paint Layer: White Skimcoat/Joint Compound Layer: Paint Layer: Tan Mastic	11805651		ND ND ND ND				
Total Composite Values of Fibrous Com Cellulose (Trace)	ponents:	Asbestos (ND)					
1590-XX01  Layer: Grey Cementitious Material	11805652		ND				
Total Composite Values of Fibrous Com	ponents:	Asbestos (ND)					
1590-XX02  Layer: Grey Cementitious Material	11805653		ND				
Total Composite Values of Fibrous Com	ponents:	Asbestos (ND)					
1590-YY01  Layer: Black Cementitious Tar	11805654		ND				
Total Composite Values of Fibrous Com Cellulose (Trace)	iponents:	Asbestos (ND)					
1590-YY02  Layer: Black Cementitious Tar	11805655		ND				
Total Composite Values of Fibrous Com Cellulose (Trace)	ponents:	Asbestos (ND)					
1590-YY03 Layer: Black Cementitious Tar	11805656		ND				
Total Composite Values of Fibrous Com Cellulose (Trace)	iponents:	Asbestos (ND)					

**Report Number:** B227496 Client Name: Vista Environmental Consultants **Date Printed:** 09/07/16 Asbestos Percent in Asbestos Percent in Asbestos Percent in Sample ID Lab Number Layer Type Layer Type Type Layer

Tad Thrower

Tad Thrower, Laboratory Supervisor, Hayward Laboratory

Note: Limit of Quantification ('LOQ') = 1%. 'Trace' denotes the presence of asbestos below the LOQ. 'ND' = 'None Detected'.

Analytical results and reports are generated by Forensic Analytical Laboratories Inc. (FALI) at the request of and for the exclusive use of the person or entity (client) named on such

Analytical results and reports are generated by Forensic Analytical Laboratories Inc. (FALI) at the request of and for the exclusive use of the person or entity (client) named on such report. Results, reports or copies of same will not be released by FALI to any third party without prior written request from client. This report applies only to the sample(s) tested. Supporting laboratory documentation is available upon request. This report must not be reproduced except in full, unless approved by FALI. The client is solely responsible for the use and interpretation of test results and reports requested from FALI. Forensic Analytical Laboratories Inc. is not able to assess the degree of hazard resulting from materials analyzed. FALI reserves the right to dispose of all samples after a period of thirty (30) days, according to all state and federal guidelines, unless otherwise specified. All samples were received in acceptable condition unless otherwise noted.

PAGE\_1\_\_OF\_\_12\_\_

#### ASBESTOS BULK SAMPLE LOG

2984 TEAGA SAN LEANDR					OFFICE 5	10.346.8860 88.653.8889
CLIENT: CO	unty of Sa	n Mateo			DATE: 0	8/31/16
			wood_City, CA.	94063 PROJE	ст Number: <u>1611</u>	01005
SAMPLED B	Y: CR	_			CAC OR SST	No: 16-5606
BUILDING	HOMO AREA ID	NUMBER	MATERIAL	DESCRIPTION	LOCATION	QUANTITY (SF/LF/EA)
1590	Α	01	PAINT/ TRXTURECOST	BIEKIE WHITT	E	
1590	A	02				
1590	A	03				
1590	A	04				
1590	A	05				
1590	A	06				
1590	A	07	1	$\downarrow$		
1590	В	01	TRIXTUPPLEDAT	WHITE,		
1590	B	02				
1590	В	03				
ANALYTICAL	МЕТНОД:	PLM 40	O PT COUNT	TURNAROUND T	IME: SAME DAY	24HR 48 HR 3 DAY
DATA SENT	To:	CH	RISTOPHER BUR			
SPECIAL INS	TRUCTION	c.		QUEST	TIONS CALL: 510.6	58.8860
		2.2.2				
CHAIN OI	CUSIN	DDY:	(	L 1- 511.4		
1.	TRANSF	ER SIGNATI	JRE	PRINTED NAME	DA	TE/TIME
2.				£ 1(8) 9 10		
	TRANSF	ER SIGNATI	JRE /	S PRINTED NAME	DA	TE/TIME
3	TRANSF	ER SIGNATI	IRE	RECEIVED	\\\\\\\\\\\\\\\\\\\\\\\\\\\\\\\\\\\\\\	TE/TIME



# ASBESTOS BULK SAMPLE LOG OFFICE 510.346.8860 FAX 888.653.8889

2984 TEAGARDEN STREET SAN LEANDRO, CA 94577

CLIENT: COL	inty of Sa	n Mateo			DATE: 08/31/	16
LOCATION:_	1590 Mar	ole St. Redy	vood City, CA.	94063 PROJEC	CT NUMBER: 161101005	5
SAMPLED B		_	•		CAC OR SST NO:	16-500
BUILDING	HOMO AREA ID	NUMBER	MATERIAL	DESCRIPTION	LOCATION	QUANTITY (SF/LF/EA)
1590	В	04				
1590	В	05				
1590	В	06	<b>1</b>	<b>V</b>		
1590	В	07		1		
1590	C	OI	RASTER	WHITE,		
1590	C	02				
1590	C	03				
1590	C	04				
1590	C	05				
1590	C	00	1	1		_
ANALYTICAL	_ METHOD	PLM 40	D PT COUNT	TURNAROUND TI	ME: SAME DAY 24HF	ABHR 3 DAY
DATA SENT			HRISTOPHER BUF	RNS VIA E-MAIL: CH QUEST	IRISBURNS@VISTA-ENV.	СОМ 3860
SPECIAL IN	STRUCTION	NS:				
CHAINO	E CUST	ODY:				
1.	TRANS	FER SIGNAT	URE	PRINTED NAME	DATE/T	TME
2	TRANS	FER SIGNAT	URE	PRINTED NAME TO	DATE/T	TIME
3	TRANS	FER SIGNAT	URE	PRINTEDWANTED	DATE/T	TIME
PAGE 1	OF	12		SEP 0 6 201	16 PR	



### ASBESTOS BULK SAMPLE LOG OFFICE 510.346.8860 FAX 888.653.8889

2984 TEAGARDEN STREET SAN LEANDRO, CA 94577

CLIENT: COL	inty of Sa	n Mateo			DATE: 08/31	116
			wood City, CA.	94063 PROJEC	T NUMBER: 161101005	
SAMPLED BY	CFC	_			CAC OR SST NO:_	14-5606
BUILDING	HOMO AREA ID	NUMBER	MATERIAL	DESCRIPTION	LOCATION	QUANTITY (SF/LF/EA)
1590	<b>C</b>	07		1		
1590	P	01	FIRED	BLACK, TGG		
1590	P	02				
1590	P	03		1		
1590	E	01	PARAPET /MICH CUP	WHITE, B VINLY		
1590	FL	02				
1590	E	03	1	<b>1</b>		
1590	F	01	SRALANT	BIRAY, GOORY HVAC, EXT		
1590	F	02	<u> </u>	1		
1590	G	01	VFT/ MAS	12" WHITE WE STERAKS YR	HON	
ANALYTICAL	МЕТНО	PLM 40	OPT COUNT	TURNAROUND TI	ME: SAME DAY 24HR	48 HR 3 DAY
DATA SENT	To: (	Ch	RISTOPHER BUF		RISBURNS@VISTA-ENV.C IONS CALL: 510.658.88	
SPECIAL INS	TRUCTION	IS:				
CHAINO	CUST	ODY:		, , , , ,	mbi	140
	WAN 9	ER SIGNATI	JRE	PRINTED NAME	DATE/TH	VIE VE
2	TRANSF	ER SIGNATI	JRE	PRINTED NAMES	9 10 7 DATE/TIN	иE
3		ER SIGNATI		RECEIV		45
PAGE 3	OF		JKE	SEP 0 6	2016 PDATE/TIM	ne.
		10		TO THE STATE OF TH	19976	



# ASBESTOS BULK SAMPLE LOG OFFICE 510.346.8860 FAX 888.653.8889

2984 TEAGARDEN STREET SAN LEANDRO, CA 94577

CLIENT: COU	inty of Sai	n Mateo			DATE: 08/31	10
LOCATION:_	1590 Map	le St. Red	wood_City, CA.	94063 PROJEC	T NUMBER: 161101005	
SAMPLED BY	C. CE	_			CAC OR SST NO:	9-900
BUILDING	HOMO AREA ID	NUMBER	MATERIAL	DESCRIPTION	LOCATION	QUANTITY (SF/LF/EA)
1590	G	02	1	$\downarrow$		
1590	Н	01	STALANT	PLASHING		
1590	H	02	1	$\downarrow$		
1590	I	01	MASTIC	CIPAY & BLA PATCHES	CK	
1590	T	02				
1590	I	03	$\downarrow$			
1590	2	01	PADS	BLACK, ASPHARET		
1590	2	02	1	1		
1590	K	01	MASTIC	WHITE, GRAY, ELA CONDUIT	CF	
1590	K	02	1	$\downarrow$		
ANALYTICAL	. МЕТНОО	PLM 40	<del>OPT COUN</del> T	TURNAROUND TII	ME: SAME DAY 24HR	48 HR 3 DAY
DATA SENT	To:	CI	HRISTOPHER BUF		RISBURNS@VISTA-ENV.CO	
SPECIAL INS	STRUCTION	NS:				
CHAINO	FCUST	ODY:		Chris Ellia	14 10/21/	W
1.	TRANSF	FER SIGNAT	URE	PRINTED NAME	DATE/TIM	1E
2	TRANSF	FER SIGNAT	URE	PRINTED NAME 5	6 7 8 DATE/TIM	ME .
3	TDANICI	FER SIGNAT	TIPE	PRINTELENAME	ECEIVED DATE/TIM	ı=
PAGE 4	OF			SE SE	P 0 6 2016	-
		WHI		Carlot of	68199750	

2984 TEAGARDEN STREET SAN LEANDRO, CA 94577

CLIENT:_Co	unty of Sa	n Mateo			DATE: 08/31	116
LOCATION:_	1590 Map	le St. Red	wood_City, CA.	94063 PROJECT	NUMBER: 161101005	
SAMPLED B	Y: CR	-			CAC OR SST NO: 16	5-5606
BUILDING	HOMO AREA ID	NUMBER	MATERIAL	DESCRIPTION	LOCATION	QUANTITY (SF/LF/EA)
1590	L	01	MRCH CUPB	WHITE ASTHMETS		(6) 7 21 7 21 7
1590	M	01	SPALANT	WHITE, BLACK		
1590	M	02	1	1		
1590	N	01	MASTIC	YRLLOW, CARPRT: TAN, BU	UE LIME	
1590	N	02		1		
1590	N	03	<b>V</b>			
1590	0	01	STALANT	BLACE. HVAC FORT		
1590	0	62				
1590	P	01	ACT	12"x12" PINHUR LARGE FISSUFA		
1590	P	02		$\downarrow$		
ANALYTICAL DATA SENT	L		PT COUNT		SAME DAY 24HR 4	М
SPECIAL INS	TRUCTION	s:		QUESTION	NS CALL, 5 10.036.000	
CHAIN OF	-5	DDY:	(	Chais Elliath	09/31/10 DATE/TIME	2
2	TRANSFI	ER SIGNATL	RE	PRINTED NAME	DATE/TIME	
3	TRANSFI	ER SIGNATU	RE	PRINTED NAME	RECEIVED DATE TIME	
PAGE 5	OF	2_		AM T	SEP 0 & 2016	

### ASBESTOS BULK SAMPLE LOG OFFICE 510.346.8860

2984 TEAGARDEN STREET

PAGE 6 OF 12

SAN LEANDR	eo, CA 945	77				33.8889
CLIENT:_Co	unty of Sa	n Mateo			DATE: 08/2	31/16
			wood_City, CA	. 94063 PROJEC	T NUMBER: 16110100	5
SAMPLED B	Y: CR	_			CAC or SST No:	15-5600
BUILDING	HOMO AREA ID	NUMBER	MATERIAL	DESCRIPTION	LOCATION	QUANTITY (SF/LF/EA)
1590	P	03	1			
1590	Q	01	WB/JC	WHITE		
1590	Q	02			4	
1590	Q	03	1			
1590	2	01	COAT	WHITE, MEPIUM MECH 200M	1	
1590	P	02				
1590	R	03	$\downarrow$			
1590	5	01	BCMAS	4" PAZK BLUR BROWN		
1590	5	02				
1590	T	01	MASTIC	YTELLOW, STAIRTERAD		1
ANALYTICAL	. МЕТНОО:	PLM 40	PT COUNT	TURNAROUND TIM	IE: SAME DAY 24HR	748 HR 3 DAY
DATA SENT			IRISTOPHER BU	IRNS VIA E-MAIL: CHR	ISBURNS@VISTA-ENV.C	COM
SPECIAL INS	STRUCTION	ıs:		SQ 0 110	710 CALL. 0 10.000.0	
CHAIN O	FCUST	ODY:			- 0 /2.	1.4
1.	TRANSF	ER SIGNATI	JRE	Chais Ellicht PRINTED NAME	08/31/ DATE/TI	ME ME
2	TRANSF	ER SIGNATL	JRE -	PRINTED NAME 9	ID DATE/TI	ME
2	1, 54,100	- San Ara I h	· comme	(3) A	The same	*******
3.	TRANSF	ER SIGNATL	JRE	PRINTED NAME IVE	DATE/TI	ME

2984 TEAGARDEN STREET SAN LEANDRO, CA 94577

#### ASBESTOS BULK SAMPLE LOG

CLIENT: CO	JENT: County of San Mateo						TE: 08/	131/1	6
			wood_City, CA.	94063	PROJEC		R: <u>1611010</u>		
SAMPLED B	Y: CR	_	mistable	MA		CAC	OR SST NO	:16-	5606
BUILDING	HOMO AREA ID	NUMBER	MATERIAL	DESCR	RIPTION	LC	OCATION	- 22	QUANTITY SF/LF/EA)
1590	T	01			/				
1590	U	01	VSF	PRE	BLE				
1590	U	02	¥		/				
1590	V,	01	PLASTER	GRAY.	CEILING	;			
1590	V	02		X					
1590	V	03							
1590	V.	04							
1590	V	05							
1590	V	06							
1590	V	07	<b>V</b> .						
ANALYTICAL	МЕТНОБ:	PLM 400	PT COUNT	TURNAR	OUND TIM	IE: SAMI	E DAY 24H	R/48 H	HR 3 DAY
DATA SENT	To:	Сн	RISTOPHER BUR	NS VIA E-I	MAIL: CHE	ISBURNS	PVISTA-ENV	COM	
SPECIAL INS	TRUCTION	s:			QUESTIC	JNS CALL	: 510.658.8	8860	_
CHAIN OF	CUSTO	ODY:					,	,	
1.	TRANSF	ER SIGNATL	JRE	hais o	Elliatt NAME		09/31/ DATE/	// CO	_
2	TDANISE	ER SIGNATL	IDE -	PRINTEI	NU 00 6 7	8 9 10 77	DATE/		
3.				PRINTE	10	CEIVED	DATE	TIME	
		ER SIGNATL	IRE	PRINTE		0 3 2018	DATE/	TIME	<del></del>
PAGE_7	_OF	12			IE Y	e Dr.	12		
					4 11 0	6819	3/		

SAN LEANDS					OFFICE FAX	510.346. 888.653.	
CLIENT: Co	ounty of Sa	n Mateo			DATE:	08/31	116
LOCATION:	1590 Mar	ole St. Red	wood City, CA.	94063 PROJEC	T NUMBER:_		
SAMPLED B							5-5606
BUILDING	HOMO AREA ID	NUMBER	MATERIAL	DESCRIPTION	LOCA	TION	QUANTITY (SF/LF/EA)
1590	W	01	WASTIC	12" BEGE, GRAY WHITE ST PLACE	BINCE		
1590	W	02	1				
1590	X	01	BC/MAS	1 Brown	W		
1590	X	02		1			
1590	Y	01	MORTA	WHITE CIPAY, 4°	TUR		
1590	Z	01	MORTA?	GRAY, I" THE YRLLOW	٤		
1590	AA	01	NEXATION	FIRE POOR			
1590	AA	02					
1590	AA	03	$\downarrow$				
1590	BB	01	ACP	Z'X1' PINHOR	•		
ANALYTICAL	. МЕТНОБ:	PLM 49	PT COUNT	TURNAROUND TIM	ME: SAME D	AY 24HR 4	18 HR 3 DAY
DATA SENT	To:	CH	IRISTOPHER BUR	NS VIA E-MAIL: CHR QUESTIO		STA-ENV.CO	М
SPECIAL INS	STRUCTION	s:					
CHAIN O	FCUST	ODY:				/ /	
1	TRANSF	ER SIGNATU	JRE (	hais Ellicht PRINTED NAME	a	3/31/	160
2	TRANSF	ER SIGNATI	URE	PRIMED NAME	10 77 33	DATE/TIME	
3	TRANSFI	ER SIGNATU	JRE	RECEIVE CONTENTS	2016	DATE/TIME	
PAGE_	_of_	L		1 ha C	10/5/		



SAN LEANDE					FAX 888.653.	
CLIENT:_Co	ounty of Sa	n Mateo			DATE: 08/31	116
LOCATION:	1590 Mar	ole St. Red	wood City, CA.	94063 PROJEC	T NUMBER: 161101005	
SAMPLED E		_	**************************************		CAC OR SST NO:	5-5606
BUILDING	HOMO AREA ID	NUMBER	MATERIAL	DESCRIPTION	LOCATION	QUANTITY (SF/LF/EA)
1590	BB	02	1	1		
1590	CC	01	SRAM TAPE	HVAT HVAT		
1590	CC	02	<b>1</b>	V (2	20	
1590	EE	01	VPT/ MASTIC	12" BRIGE W/BI WHITE STREAM	S YELLOW & BLACK	-
1590	RE	02		V		
1590	DD	01	WHS	12" GRAY WY WHITE STRIM	Specion	
1590	DD	02		V _		
1590	FF	01	VPT/MAS	12" WHITE THE	BLACK	
1590	FF	02	<b>V</b>		Of all	
1590	GG	01	COATING	CONCREGED		
ANALYTICA	L METHOD	PLM 40	<del>O PT COUN</del> T	TURNAROUND TI	ME: SAME DAY 24HR	48 HR 3 DA
DATA SENT	To:	CI	HRISTOPHER BUF	RNS VIA E-MAIL: CH QUEST	RISBURNS@VISTA-ENV.CO	рм 60
SPECIAL IN	STRUCTION	NS:				
CHAIN C	FCUST	ODY:			/- /	60
1	TRANSF	-ER SIGNAT	URE	PRINTED NAME	DATE/TIM	E
2	TRANSF	FER SIGNAT	URE	PRINTED NAME	DATE/TIM	E
3	TRANSF	ER SIGNAT	URE	PRINTED NAME	1/8 9 10 // DATE/TIM	E
PAGE_	OF	2		REC	CEIVED E	

2984 TEAGARDEN STREET SAN LEANDRO, CA 94577

CLIENT:_Co	unty of Sai	n Mateo			DATE: 08/31	116
			wood_City, CA.	94063 PROJEC	T NUMBER: 161101005	
SAMPLED B	BY: CR	_			CAC OR SST No: 16	5-5606
BUILDING	HOMO AREA ID	NUMBER	MATERIAL	DESCRIPTION	LOCATION	QUANTITY (SF/LF/EA)
1590	GG	02	1			
1590	HH	01	INSULATION	WHITE, HANGRE		
1590	НН	02				
1590	HH	03	$\downarrow$	1		
1590	II	01	JACKRUT MUSICATION	WHITE YELL	aw aw	
1590	22	d	PAWT	CONCEPTIFE		
1590	KK	01	MAS	12" GRAY/ BLACK		
1590	4	01	MASTIC	BLACK, SINK		
1590	мм	01	VPT/ mas	SINK 12" BRIGK, WHOTE GRAY GITH	BLACK	
1590	mm	02	$\downarrow$	$\downarrow$ 1		
ANALYTICAL	метноб:	PLM 40	O PT COUNT	TURNAROUND TIM	ME: SAME DAY 24HR	48 HR 3 DAY
DATA SENT	To:	CH	IRISTOPHER BURI		RISBURNS@VISTA-ENV.CO	М
SPECIAL INS	STRUCTION	s:				
CHAIN O	FCUSTO	DDY:			10/0	
1	TRANSFI	ER SIGNATI	JRE	PRINTED NAME	OC/31/10	
2	TRANSFI	ER SIGNATL	IDE .	\$ 6 7 8 9 10 PRINTED NAME	DATE COME	
,	110/140/1	IN DIGINATE	/	RECEIVED	DATE/TIME	
	TRANSFI	ER SIGNATU	JRE .	PRINTED NAME 201	DATE/TIME	
PAGE / C	_OF	L		15 8ch 04/50	[2]	



2984 TEAGARDEN STREET SAN LEANDRO, CA 94577

#### ASBESTOS BULK SAMPLE LOG

CLIENT:_Co	unty of Sai	n Mateo			DATE: 08/3	31/14
LOCATION:	1590 Map	le St. Red	wood City, CA.	94063 PROJEC	т Number: 16110100:	5
SAMPLED B	Y: CR	_			CAC OR SST NO:_	15-5600
BUILDING	HOMO AREA ID	NUMBER	MATERIAL	DESCRIPTION	LOCATION	QUANTITY (SF/LF/EA)
1590	NN	01	MASTIC	12" PINHOCIE SMALL FISSUPE	YRUOW	
1590	00	ØI	PAWT/EMY/MORTA	E WHITE/CIPAY/C	rmy	
1590	00	<i>ф</i> 2				
1590	00	Ø3	V			-
1590	PP	01	PAINT,	CONFRATRE	eu?	
1590	QQ	01	MAIT	Brown		
1590	RR	01	FOUNDATION	GRAY		
1590	RR	02	2. 1/	BRIGH/		
1590	55	01	CONCESSIO	/		
1590	55	02		$\downarrow$		
ANALYTICAL	METHOD:	PLM 49	O PT COUNT	TURNAROUND TI	ME: SAME DAY 24HR	748 HR 3 DAY
DATA SENT	To:	CI	HRISTOPHER BUR		RISBURNS@VISTA-ENV. ONS CALL: 510.658.8	
SPECIAL IN	STRUCTION	IS:				
CHAIN O	FCUST	ODY:			6.	1.10
1.	TRANSF	ER SIGNAT	URE	PRINTED NAME	08/31/ DATE/T	IME
2	TRANSE	ER SIGNAT	URE	PRINTED NAME	10 11 DATE/T	IME
3.				RECEIVE		
	TRANSF	ER SIGNAT	URE	THINTED NAMES	DATE/T	IME
Page_//	OF/			8 d 11 d 6 8	393	

2984 TEAGARDEN STREET SAN LEANDRO, CA 94577

#### ASBESTOS BULK SAMPLE LOG

CLIENT:_CO	unty of Sa	n Mateo			DATE: 08/31	116
LOCATION:	1590 Mar	ole St. Red	wood_City, CA.	94063 PROJEC	T NUMBER: 161101005	
SAMPLED B	BY: CR	_			CAC OR SST NO: 16	5-5600
BUILDING	HOMO AREA ID	NUMBER	MATERIAL	DESCRIPTION	LOCATION	QUANTITY (SF/LF/EA)
1590	TT	01	mas	A" GRAY/ BROWN		
1590	UU	01	CI POUT/ MORTHY		BLUE TILE	
1590	VV	01	MORTAL	WHITE WASK, WA	re	
1590	WW	01	MASTIC	BEKIR,	4	
1590	XX	.01	CONCERTA	CIPAX, SIDRWAR	د	
1590	XX	02	1			
1590	λĂ	01	ASPHACT	BLACK		
1590	УУ	02	4			
1590	уУ	03	$\downarrow$	<i>\\</i> .		
ANALYTICAL	метноб:	PLM 40	PT COUNT	TURNAROUND TIM	ME: SAME DAY 24HR	18 HR 3 DAY
DATA SENT	To:	CH	IRISTOPHER BURI		RISBURNS@VISTA-ENV.COI	
SPECIAL INS	STRUCTION	s:				
CHAIN O	FCUST	ODY:			- /-	1.
1.	TRANSF	ER SIGNATI	JRE (	hais Elliath	OC/31 ) DATE/TIME	16
2	TRANSF	ER SIGNATU	JRE	PRINTED NAME 10	DATE/TIME	
3	TRANSF	ER SIGNATU	JRE	PRINTED NAME	DATE/TIME	
PAGE_12				SEP 0 6 20		



### **Bulk Asbestos Analysis**

(EPA Method 600/R-93-116, Visual Area Estimation)

Vista Environmental Consultants **Client ID:** L1161 Project Manager **Report Number:** B227797 2984 Teagarden St. **Date Received:** 09/12/16 **Date Analyzed:** 09/12/16 San Leandro, CA 94577 **Date Printed:** 09/12/16 09/12/16 First Reported: Job ID/Site: 161101005 - County of San Mateo, 1590 Maple St., Redwood City, CA 94063 FALI Job ID: L1161 **Total Samples Submitted:** 12 **Date(s) Collected:** 09/12/2016 **Total Samples Analyzed:** Percent in Percent in Asbestos Asbestos Asbestos Percent in Sample ID Lab Number Type Layer Type Layer Type Layer 1590-ZZ01 11807936 ND Layer: Yellow Mastic Total Composite Values of Fibrous Components: Asbestos (ND) Cellulose (2 %) 1590-ZZ02 11807937 ND Layer: Yellow Mastic Total Composite Values of Fibrous Components: Asbestos (ND) Cellulose (2 %) 1590-A301 11807938 Layer: Tan Foam ND Layer: White Mastic ND Total Composite Values of Fibrous Components: Asbestos (ND) 1590-A302 11807939 Layer: Grey Carpet ND Layer: Tan Foam ND Layer: White Mastic ND Total Composite Values of Fibrous Components: Asbestos (ND) Synthetic (45 %) 1590-B301 11807940 Layer: Black Non-Fibrous Material ND Layer: Yellow Foam ND Layer: Paint ND Total Composite Values of Fibrous Components: Asbestos (ND) 11807941 1590-B302 ND Layer: Yellow Foam Layer: Paint ND Total Composite Values of Fibrous Components: Asbestos (ND)

Report Number: B227797
Client Name: Vista Environmental Consultants
Date Printed: 09/12/16

Sample ID	Lab Number	Asbestos r Type	Percent in Layer	Asbestos Type	Percent in Layer	Asbestos Type	Percent in Layer
1590-B303  Layer: Black Non-Fibrous Material  Layer: Yellow Foam  Layer: Paint	11807942		ND ND ND				
Total Composite Values of Fibrous Com	ponents:	Asbestos (ND)					
1590-C301  Layer: Black Foam  Layer: Tan Fibrous Material  Layer: Silver Foil	11807943		ND ND ND				
Total Composite Values of Fibrous Com Cellulose (5 %)	ponents:	Asbestos (ND)					
<b>1590-D301</b> Layer: Grey Non-Fibrous Material	11807944		ND				
Total Composite Values of Fibrous Com	ponents:	Asbestos (ND)					
<b>1590-D302</b> Layer: Grey Non-Fibrous Material	11807945		ND				
Total Composite Values of Fibrous Com	ponents:	Asbestos (ND)					
<b>1590-E301</b> Layer: Beige Non-Fibrous Material	11807946		ND				
Total Composite Values of Fibrous Com	ponents:	Asbestos (ND)					
<b>1590-F301</b> Layer: Black Non-Fibrous Material Layer: Paint	11807947		ND ND				
Total Composite Values of Fibrous Com	ponents:	Asbestos (ND)					

Tad Thrower

Tad Thrower, Laboratory Supervisor, Hayward Laboratory

Note: Limit of Quantification ('LOQ') = 1%. 'Trace' denotes the presence of asbestos below the LOQ. 'ND' = 'None Detected'.

Analytical results and reports are generated by Forensic Analytical Laboratories Inc. (FALI) at the request of and for the exclusive use of the person or entity (client) named on such report. Results, reports or copies of same will not be released by FALI to any third party without prior written request from client. This report applies only to the sample(s) tested. Supporting laboratory documentation is available upon request. This report must not be reproduced except in full, unless approved by FALI. The client is solely responsible for the use and interpretation of test results and reports requested from FALI. Forensic Analytical Laboratories Inc. is not able to assess the degree of hazard resulting from materials analyzed. FALI reserves the right to dispose of all samples after a period of thirty (30) days, according to all state and federal guidelines, unless otherwise specified. All samples were received in acceptable condition unless otherwise noted.



CLIENT: County of San Mateo

# ASBESTOS BULK SAMPLE LOG OFFICE 510.346.8860 FAX 888.653.8889

2984 TEAGARDEN STREET SAN LEANDRO, CA 94577

DATE: 9-12-16

SAMPLED B		_	wood_City, CA.		CAC OR SST NO: 16	-5606
BUILDING	HOMO AREA ID	NUMBER	MATERIAL	DESCRIPTION	LOCATION	QUANTITY (SF/LF/EA)
1590	77	01	Mastic	Vellow, Brown		
1590	72	02	1	\\\\\\\\\\\\\\\\\\\\\\\\\\\\\\\\\\\\\\		
1590	A3	01	mastic	wt, 5828+	e pattern	
1590	As	02	1	V		
1590	83	0)	Point/Insulating	Brown, Block		
1590	<b>B</b> 3	02		1	-	
1590	83	03	1			
1590	٧3	0)	socketies!	Silver Brown	ĸ	
1590	03	16	Sealant	gray, sidenalk,		
1590	D3	02	1	1		
OATA SENT	STRUCTION	CH Is:		RNS VIA E-MAIL: CHE	ME: SAME DAY 24HR 4 RISBURNS@VISTA-ENV.CO! DNS CALL: 510.658.886	M 50
CHAIN O	Ell'Ale	71	?	PRINTED NAME  S HOLL GER  PRINTED NAME	SEP 1 2	100
 Page_ 1	TRANSF OF	ER SIGNATU	JRE	PRINTED NAME	DATE/TIME	61



2984 TEAGARDEN STREET SAN LEANDRO, CA 94577

CLIENT: County of San Mateo

OFFICE 510.346.8860 FAX 888.653.8889

DATE: 9-12-16

LOCATION:		ole St. Red	wood_City, CA.	94063 PROJEC	CAC OR SST NO:	5-56M
SAMPLED B	10-2-11-11-1				CAC OR SST NO: IL	
BUILDING	HOMO AREA ID	NUMBER	MATERIAL	DESCRIPTION	LOCATION	QUANTITY (SF/LF/EA)
1590	E3	10	Scalant	Beige Sidewalks	heall	
.15	F3	01	Aborganier	Boige Sidewalk		
			1.			
			/	7		
				The Marie of the M		
				8/3/		
				To.	. (	
ANALYTICA	L METHOD	:PLM 40	OPT COUNT	TURNAROUND T	IME: SAME DAY) 24HR	48 HR 3 DAY
DATA SENT	To:	CH	HRISTOPHER BUI		RISBURNS@VISTA-ENV.CO	
SPECIAL IN	STRUCTION	NS:				
CHAIN	E CUST	ODY:	_		- O PM	
1. —	TRANSF	FER SIGNAT	URE	Chris Ellioth	9-12-16 DATE/TIM	<b>203</b>
2	THANSI	FERSIGNAT		. HOUISTOR PRINTED NAME	SEP LATERIA	E 7 8
3	TRANSI	FER SIGNAT	URE	PRINTED NAME	DATE TIM	E
PAGE 2	OF	2			MA CI	

#### Former Women's Jail 1590 Maple St., Redwood City XRF Sequential Report

Reading No	ROOM	COMPONENT	SUBSTRATE	COLOR	CONDITION	Results	PbC	Units
1		SHUTTER_CAL					5.83	cps
2		SHUTTER_CAL					5.88	cps
3		SHUTTER_CAL					5.96	cps
4		CALIBRATE				Positive	1.3	mg / cm ^2
5		CALIBRATE				Positive	1.2	mg / cm ^2
6		CALIBRATE				Positive	1.1	mg / cm ^2
7	OUTSIDE	WALL	CONCRETE	BEIGE	INTACT	Negative	0	mg / cm ^2
8	OUTSIDE	COLUMN	CONCRETE	BEIGE	INTACT	Negative	0	mg / cm ^2
9	OUTSIDE	WINDOW	METAL	TAN	INTACT	Negative	0.2	mg / cm ^2
10	OUTSIDE	DOWNSPOUT	METAL	BEIGE	INTACT	Negative	0.02	mg / cm ^2
11	OUTSIDE	DOOR FRAME	METAL	TAN	INTACT	Negative	0.3	mg / cm ^2
12	OUTSIDE	DOOR	METAL	TAN	INTACT	Negative	0.08	mg / cm ^2
13	OUTSIDE	OVERHANG,ENTRY	WOOD	BROWN	DETERIORATED	Negative	0.01	mg / cm ^2
14	OUTSIDE	FENCE	WOOD	GREEN	DETERIORATED	Negative	0	mg / cm ^2
15	OUTSIDE	WALL	STUCCO	BEIGE	INTACT	Negative	0	mg / cm ^2
16	OUTSIDE	DOOR	METAL	BEIGE	INTACT	Negative	0	mg / cm ^2
17	OUTSIDE	GUTTER	METAL	TAN	DETERIORATED	Negative	0.03	mg / cm ^2
18	OUTSIDE	FLASHING	METAL	TAN	DETERIORATED	Negative	0	mg / cm ^2
19	OUTSIDE	DOOR FRAME	METAL	TAN	DETERIORATED	Negative	0	mg / cm ^2
20	OUTSIDE	WALL	CONCRETE	BEIGE	INTACT	Negative	0	mg / cm ^2
21	OUTSIDE	WINDOW	METAL	TAN	INTACT	Negative	0.5	mg / cm ^2
22	OUTSIDE	DOOR FRAME	METAL	TAN	INTACT	Negative	0.13	mg / cm ^2
23	OUTSIDE	DOOR	METAL	TAN	INTACT	Negative	0.3	mg / cm ^2
24	OUTSIDE	FLASHING	METAL	TAN	INTACT	Negative	0	mg / cm ^2
25	ROOF	PIPE	METAL	WHITE	DETERIORATED	Negative	0	mg / cm ^2
26	ROOF	PARAPET WALL	CONCRETE	WHITE	INTACT	Negative	0	mg / cm ^2
27	ROOF	HVAC	METAL	GREEN	INTACT	Negative	0	mg / cm ^2
28	ROOF	HVAC BASE	METAL	BEIGE	INTACT	Negative	0.06	mg / cm ^2
29	ROOF	PARAPET WALL	METAL	WHITE	INTACT	Negative	0	mg / cm ^2
30	INSIDE	DOOR FRAME	METAL	WHITE	INTACT	Negative	0.2	mg / cm ^2



#### Former Women's Jail 1590 Maple St., Redwood City XRF Sequential Report

Reading No	ROOM	COMPONENT	SUBSTRATE	COLOR	CONDITION	Results	PbC	Units
31	INSIDE	DOOR	METAL	BLUE	INTACT	Negative	-0.32	mg / cm ^2
32	INSIDE	WALL	PLASTER	BLUE	INTACT	Negative	0	mg / cm ^2
33	INSIDE	WALL	PLASTER	YELLOW	INTACT	Negative	0	mg / cm ^2
34	INSIDE	WALL	PLASTER	WHITE	INTACT	Negative	0	mg / cm ^2
35	INSIDE	WALL	CERAMIC	BEIGE	INTACT	Negative	0.01	mg / cm ^2
36	INSIDE	WALL	CERAMIC	BLUE	INTACT	Negative	-0.32	mg / cm ^2
37	INSIDE	FLOOR	CERAMIC	BLUE	INTACT	Negative	0.01	mg / cm ^2
38	INSIDE	TRIM	WOOD	WHITE	INTACT	Negative	0	mg / cm ^2
39	INSIDE	WINDOW FRAME	METAL	WHITE	INTACT	Negative	0.14	mg / cm ^2
40	INSIDE	DOOR	METAL	BLUE	INTACT	Negative	-0.09	mg / cm ^2
41	INSIDE	WALL	PLASTER	WHITE	INTACT	Negative	0	mg / cm ^2
42	INSIDE	WINDOW	METAL	WHITE	INTACT	Negative	0.28	mg / cm ^2
43	INSIDE	CEILING	PLASTER	WHITE	INTACT	Negative	0	mg / cm ^2
44	INSIDE	STAIRS	METAL	WHITE	INTACT	Negative	0	mg / cm ^2
45	INSIDE	WALL	WOOD	RED	INTACT	Negative	0	mg / cm ^2
46	INSIDE	DOOR FRAME	METAL	BROWN	INTACT	Negative	0.24	mg / cm ^2
47	INSIDE	DOOR	METAL	BROWN	INTACT	Negative	0.5	mg / cm ^2
48	INSIDE	WALL	CONCRETE	WHITE	INTACT	Negative	0	mg / cm ^2
49	INSIDE	FLOOR	CONCRETE	RED	INTACT	Negative	0	mg / cm ^2
50	INSIDE	WALL	WOOD	WHITE	INTACT	Negative	0.19	mg / cm ^2
51	INSIDE	WALL	PLASTER	BROWN	INTACT	Negative	0	mg / cm ^2
52	INSIDE	CEILING	PLASTER	BROWN	INTACT	Negative	0	mg / cm ^2
53	INSIDE	WALL	CERAMIC	WHITE	INTACT	Negative	0.06	mg / cm ^2
54	INSIDE	FLOOR	CERAMIC	WHITE	INTACT	Negative	0.01	mg / cm ^2
55	INSIDE	DOOR FRAME	METAL	GRAY	INTACT	Negative	0.24	mg / cm ^2
56	INSIDE	DOOR	METAL	GRAY	INTACT	Negative	0.4	mg / cm ^2
57	INSIDE	FLOOR	VINYL	TAN	INTACT	Negative	0	mg / cm ^2
58	INSIDE	CABINET	WOOD	RED	INTACT	Negative	0.01	mg / cm ^2
59	INSIDE	WALL	CONCRETE	WHITE	INTACT	Negative	-0.39	mg / cm ^2
60	INSIDE	LOCKERS	METAL	GRAY	INTACT	Negative	0.02	mg / cm ^2



#### Former Women's Jail 1590 Maple St., Redwood City XRF Sequential Report


Reading No	ROOM	COMPONENT	SUBSTRATE	COLOR	CONDITION	Results	PbC	Units
61	INSIDE	WALL	DRYWALL	WHITE	INTACT	Negative	0	mg / cm ^2
62	INSIDE	LOCKERS	METAL	BEIGE	INTACT	Negative	0	mg / cm ^2
63	INSIDE	LOCKERS	METAL	WHITE	INTACT	Negative	0	mg / cm ^2
64	INSIDE	STALLS	METAL	BEIGE	INTACT	Negative	0	mg / cm ^2
65	INSIDE	STALLS	METAL	RED	INTACT	Negative	0.01	mg / cm ^2
66	INSIDE	BUNK BEDS	METAL	GRAY	INTACT	Negative	0	mg / cm ^2
67	INSIDE	STALLS	METAL	BLACK	INTACT	Negative	0.01	mg / cm ^2
68	INSIDE	WALL	CERAMIC	BEIGE	INTACT	Negative	0.06	mg / cm ^2
69		CALIBRATE				Positive	1.1	mg / cm ^2
70		CALIBRATE				Positive	1.2	mg / cm ^2
72		CALIBRATE				Positive	1	mg / cm ^2
73	INSIDE	BEAM	METAL	RED	INTACT	Negative	0.02	mg / cm ^2
74	INSIDE	BEAM	METAL	RED	INTACT	Negative	0.02	mg / cm ^2
75	SITE	CURB	CONCRETE	RED	INTACT	Negative	0	mg / cm ^2
76	SITE	PARKING CURB	CONCRETE	RED	INTACT	Negative	0.01	mg / cm ^2
77	SITE	POST	METAL	RED	INTACT	Negative	0	mg / cm ^2
78	SITE	BOLLARD	CONCRETE	RED	INTACT	Negative	0.01	mg / cm ^2
79	SITE	BOLLARD	CONCRETE	RED	INTACT	Negative	0.09	mg / cm ^2
80	SITE	FLOOR STRIPE	ASPHALT	RED	INTACT	Negative	0	mg / cm ^2
81	SITE	FLOOR STRIPE	ASPHALT	WHITE	DETERIORATED	Negative	0	mg / cm ^2
82	SITE	FLOOR STRIPE	ASPHALT	WHITE	DETERIORATED	Negative	0.02	mg / cm ^2
83	SITE	FLOOR STRIPE	ASPHALT	YELLOW	DETERIORATED	Positive	3.9	mg / cm ^2
84		CALIBRATE				Positive	1	mg / cm ^2
85		CALIBRATE				Positive	1.3	mg / cm ^2
86		CALIBRATE				Positive	1	mg / cm ^2
87		SHUTTER_CAL					6.53	cps
88		CALIBRATE				Positive	1.1	mg / cm ^2
89		CALIBRATE				Positive	1.2	mg / cm ^2
90		CALIBRATE				Positive	1	mg / cm ^2
91	INSIDE MENS	WALL	CERAMIC	BEIGE	INTACT	Negative	0	mg / cm ^2



#### Former Women's Jail 1590 Maple St., Redwood City XRF Sequential Report

Reading No	ROOM	COMPONENT	SUBSTRATE	COLOR	CONDITION	Results	PbC	Units
92	INSIDE MENS	FLOOR	CERAMIC	RED	INTACT	Negative	0	mg / cm ^2
93	INSIDE MENS	DOOR FRAME	METAL	RED	INTACT	Negative	0	mg / cm ^2
94	INSIDE MENS	DOOR	WOOD	VARNISH	INTACT	Negative	0	mg / cm ^2
95	INSIDE MENS	BASEBOARD	CERAMIC	RED	INTACT	Negative	0	mg / cm ^2
96	INSIDE MENS	SINK	CERAMIC	WHITE	INTACT	Negative	0.01	mg / cm ^2
97	INSIDE MENS	TOILET	CERAMIC	WHITE	INTACT	Negative	0.03	mg / cm ^2
98	INSIDE WOMEN	DOOR FRAME	METAL	RED	INTACT	Negative	0	mg / cm ^2
99	INSIDE WOMEN	DOOR	WOOD	VARNISH	INTACT	Negative	0	mg / cm ^2
100	INSIDE WOMEN	WALL	CERAMIC	BEIGE	INTACT	Negative	0	mg / cm ^2
101	INSIDE WOMEN	BASEBOARD	CERAMIC	RED	INTACT	Negative	0	mg / cm ^2
102	INSIDE WOMEN	FLOOR	CERAMIC	RED	INTACT	Negative	0	mg / cm ^2
103	INSIDE WOMEN	SINK	CERAMIC	WHITE	INTACT	Negative	0	mg / cm ^2
104	INSIDE WOMEN	TOILET	CERAMIC	WHITE	INTACT	Negative	0.04	mg / cm ^2
105		CALIBRATE				Positive	1	mg / cm ^2
106		CALIBRATE				Positive	1.1	mg / cm ^2
107		CALIBRATE				Positive	1	mg / cm ^2

# LifeMoves Maple Street Shelter BUILDING DEPARTMENT RESUBMITTAL 09-23-16

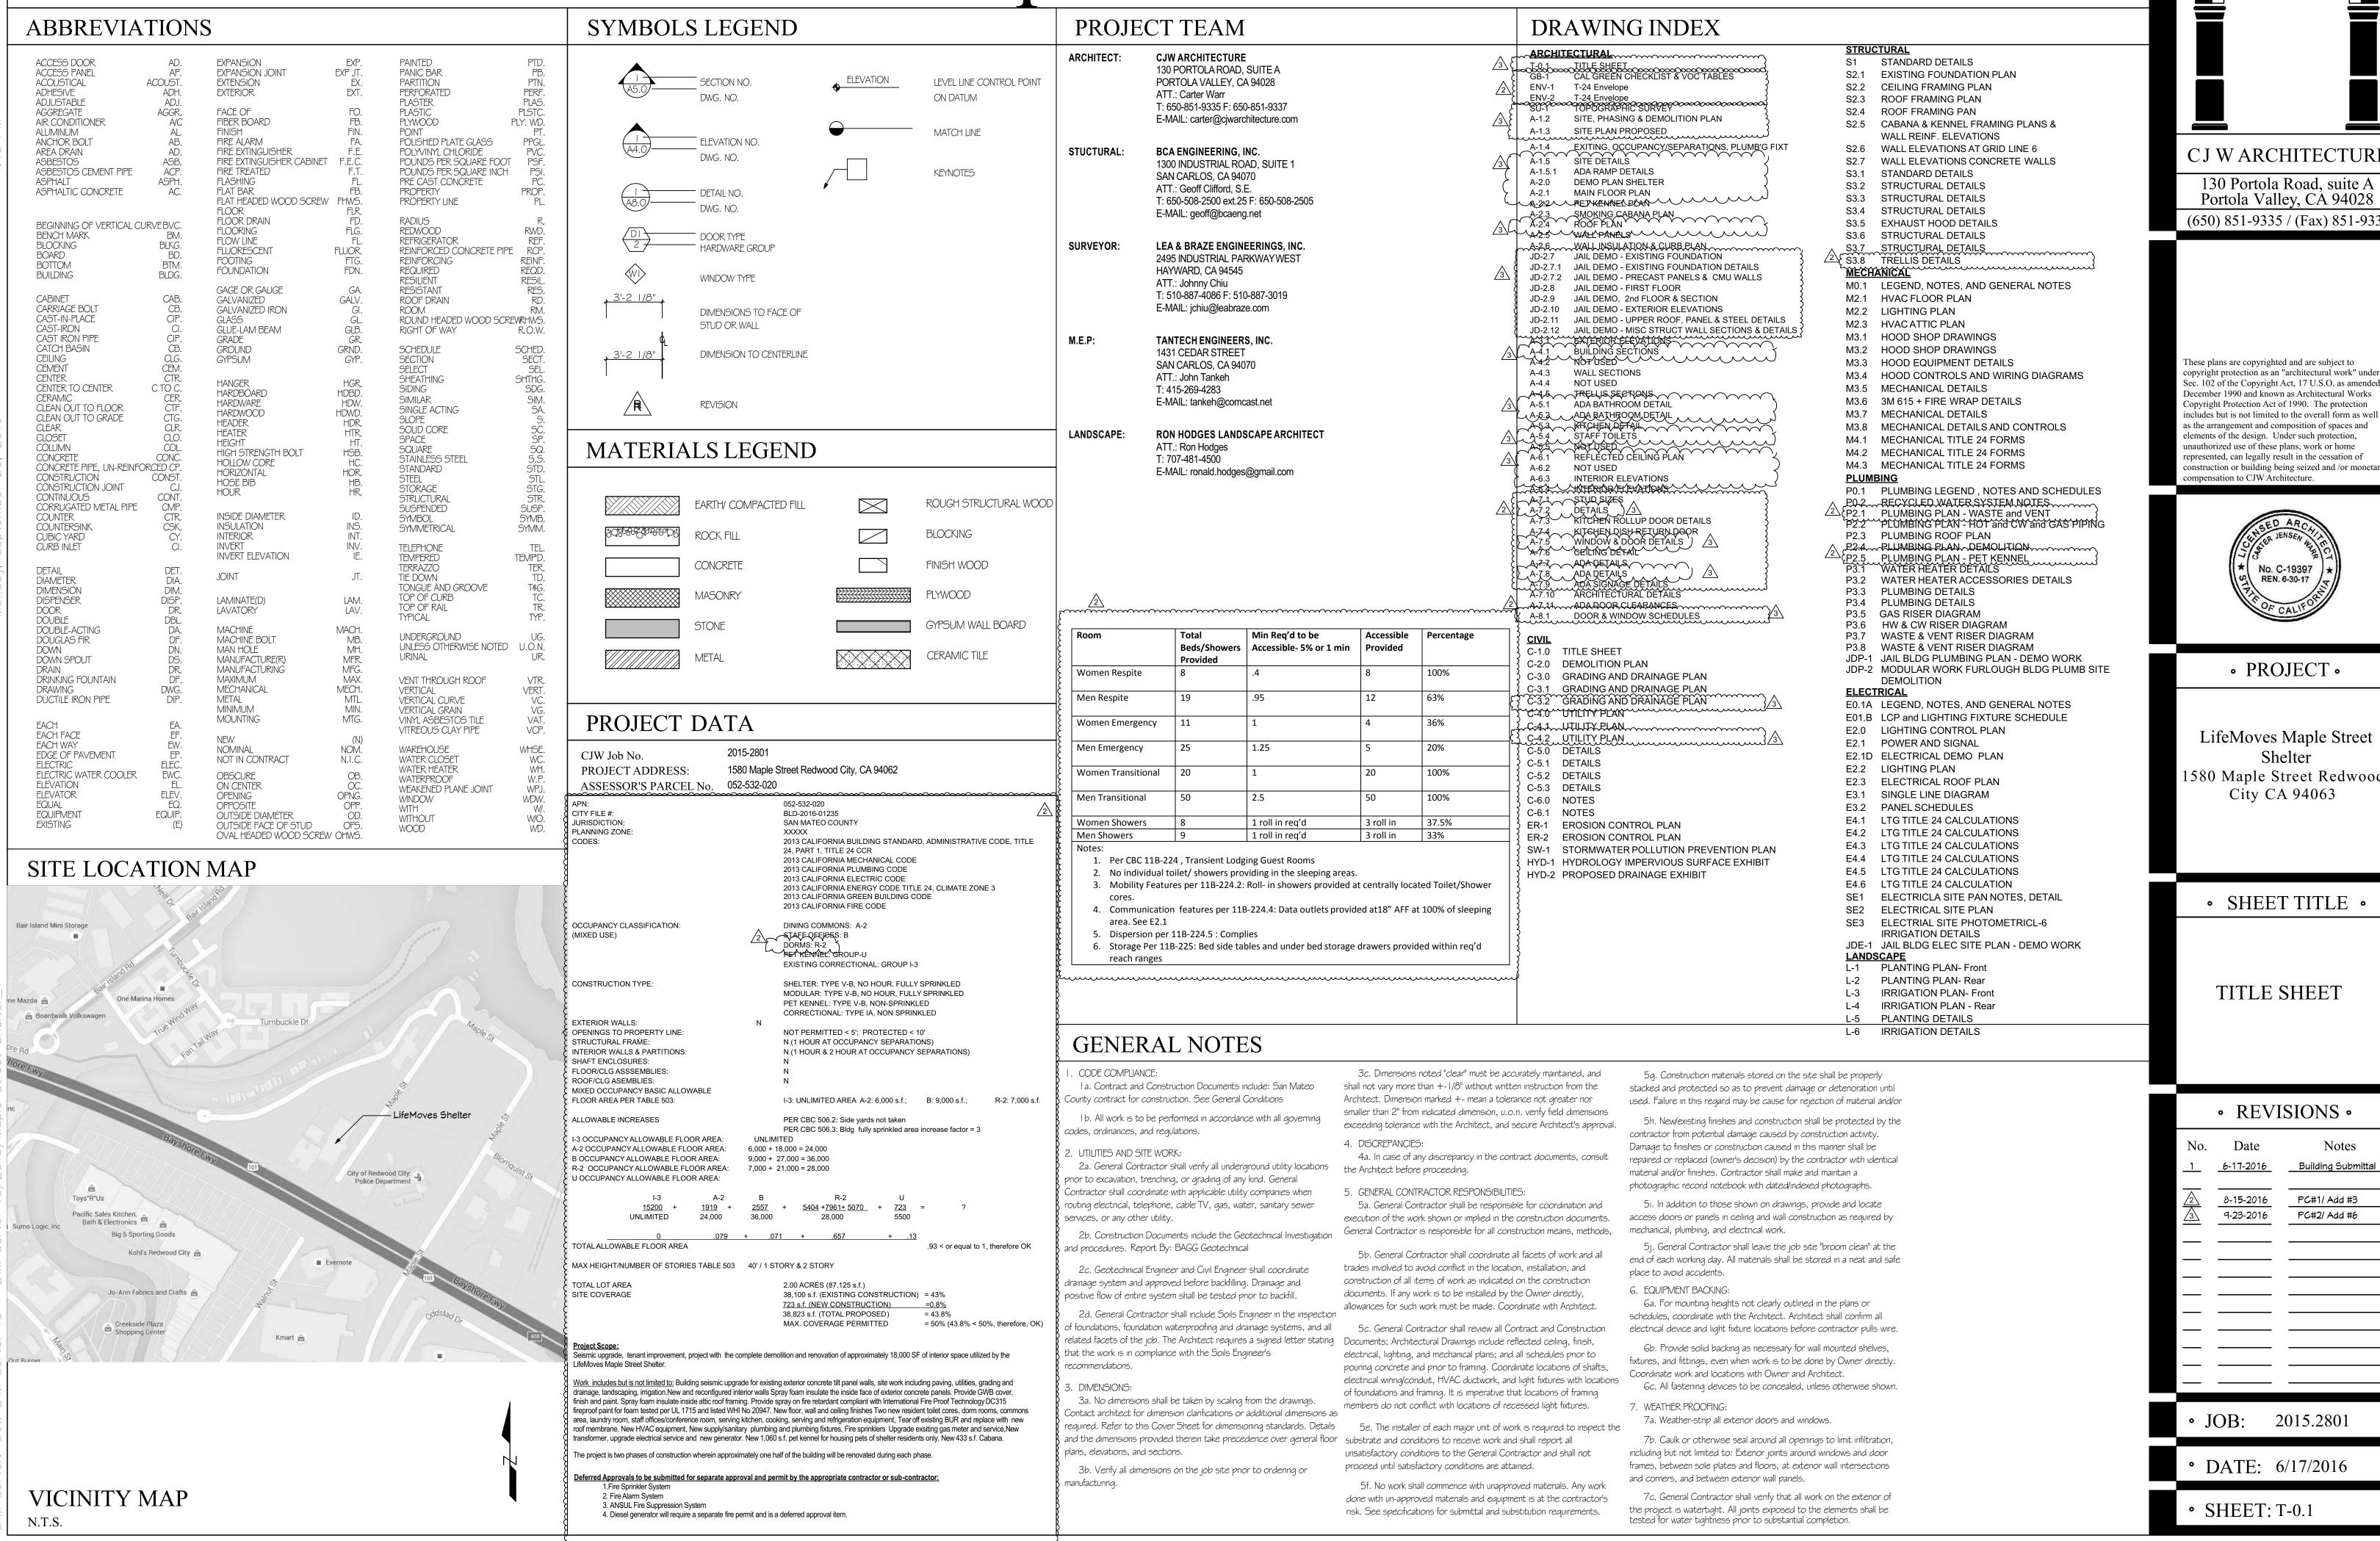

CJ W ARCHITECTURI

130 Portola Road, suite A

(650) 851-9335 / (Fax) 851-9337

These plans are copyrighted and are subject to copyright protection as an "architectural work" under 102 of the Copyright Act, 17 U.S.O. as amended December 1990 and known as Architectural Works Copyright Protection Act of 1990. The protection ncludes but is not limited to the overall form as well as the arrangement and composition of spaces and elements of the design. Under such protection, nauthorized use of these plans, work or home presented, can legally result in the cessation of nstruction or building being seized and /or monetary





LifeMoves Maple Street

580 Maple Street Redwood

SHEET TITLE

PC#1/ Add #3 PC#2/ Add #6

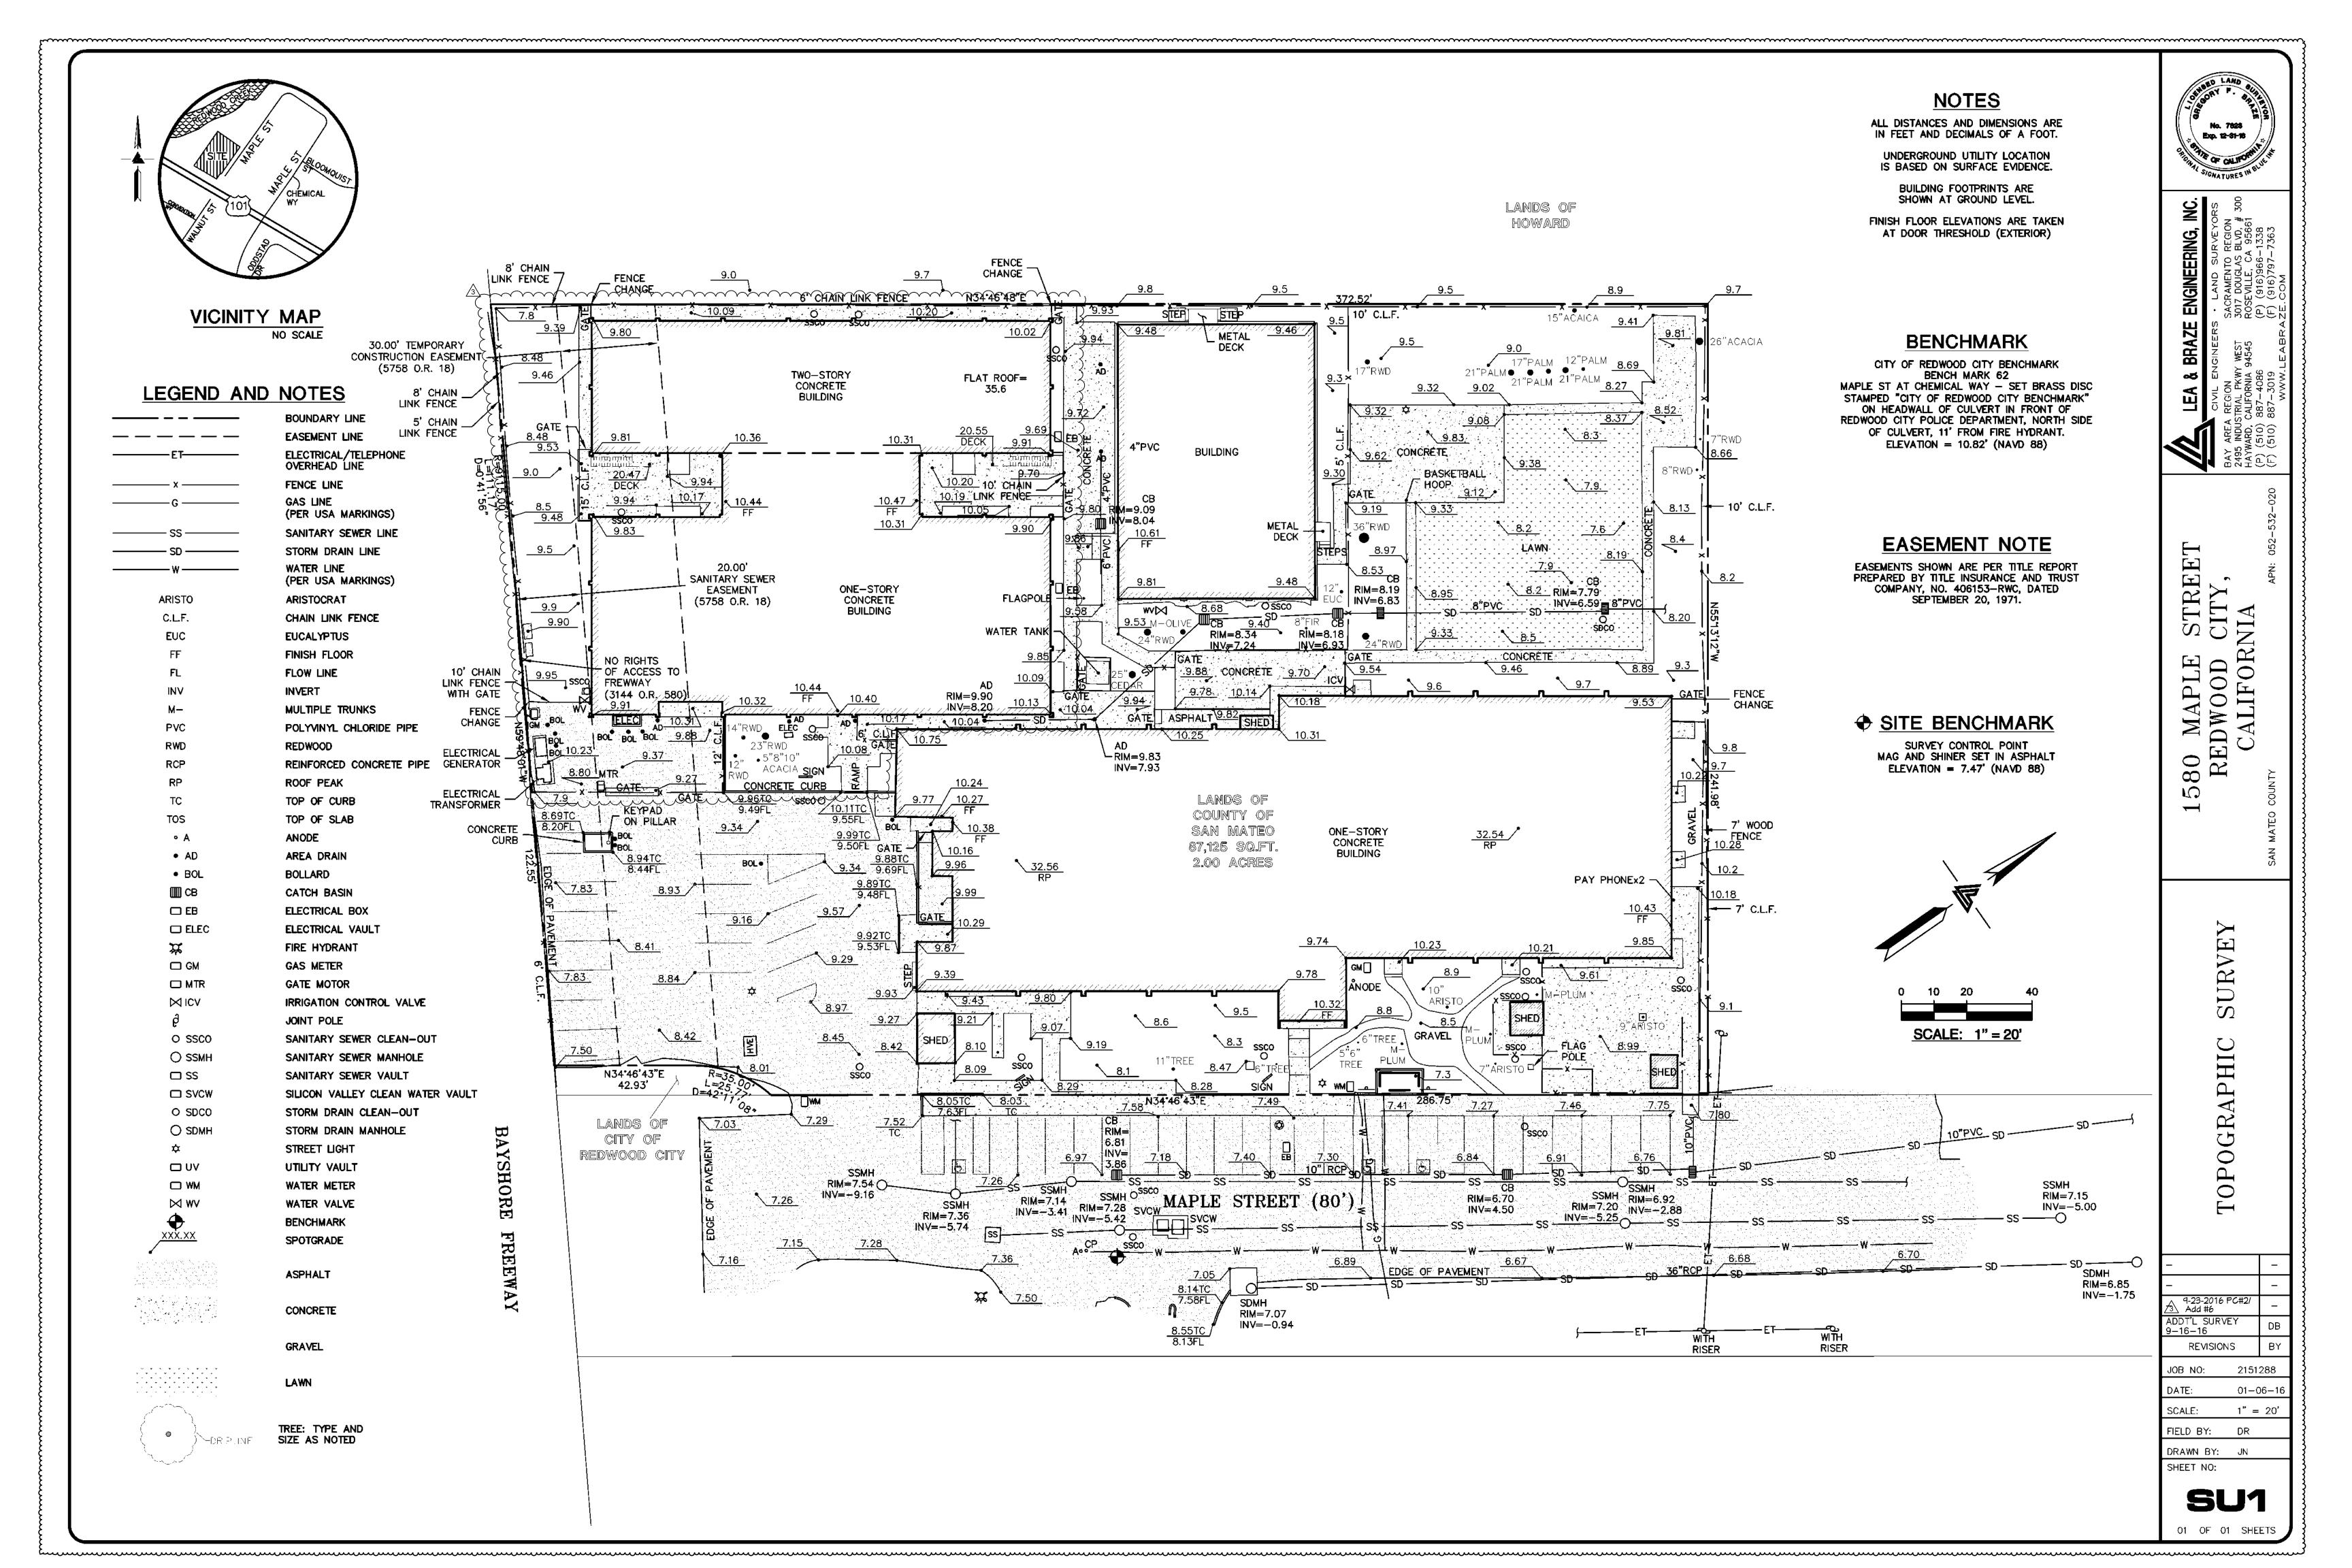

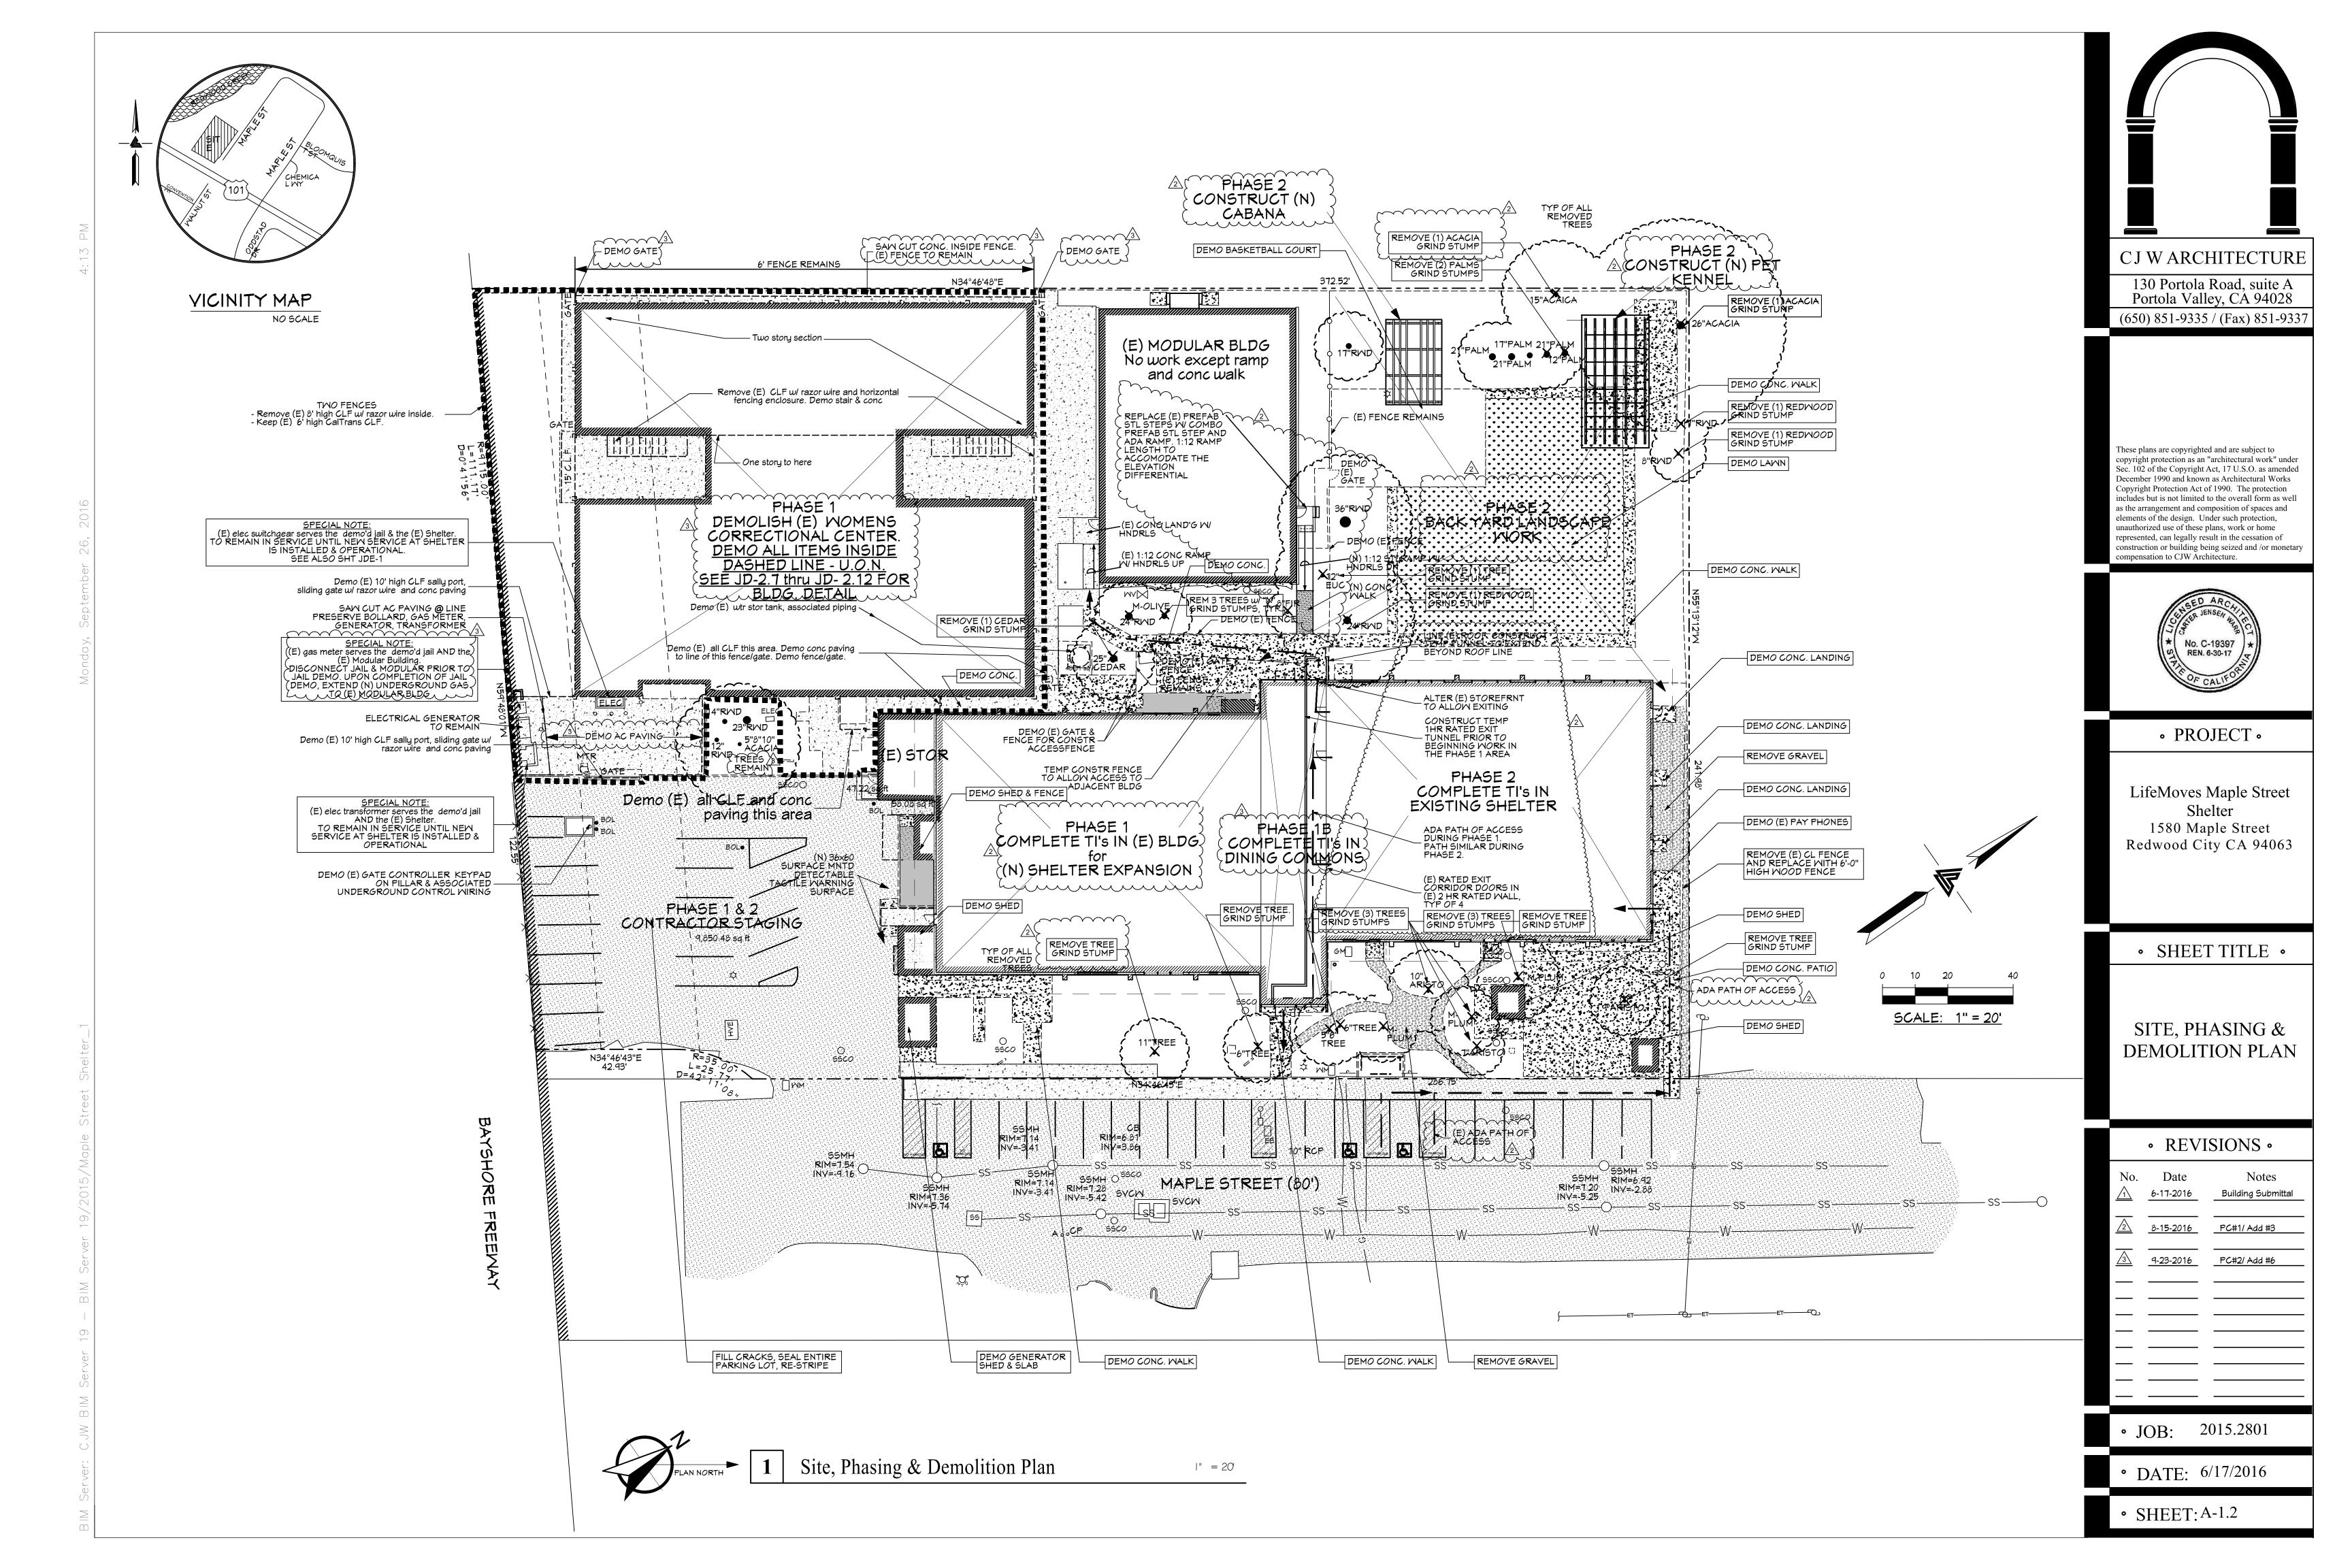

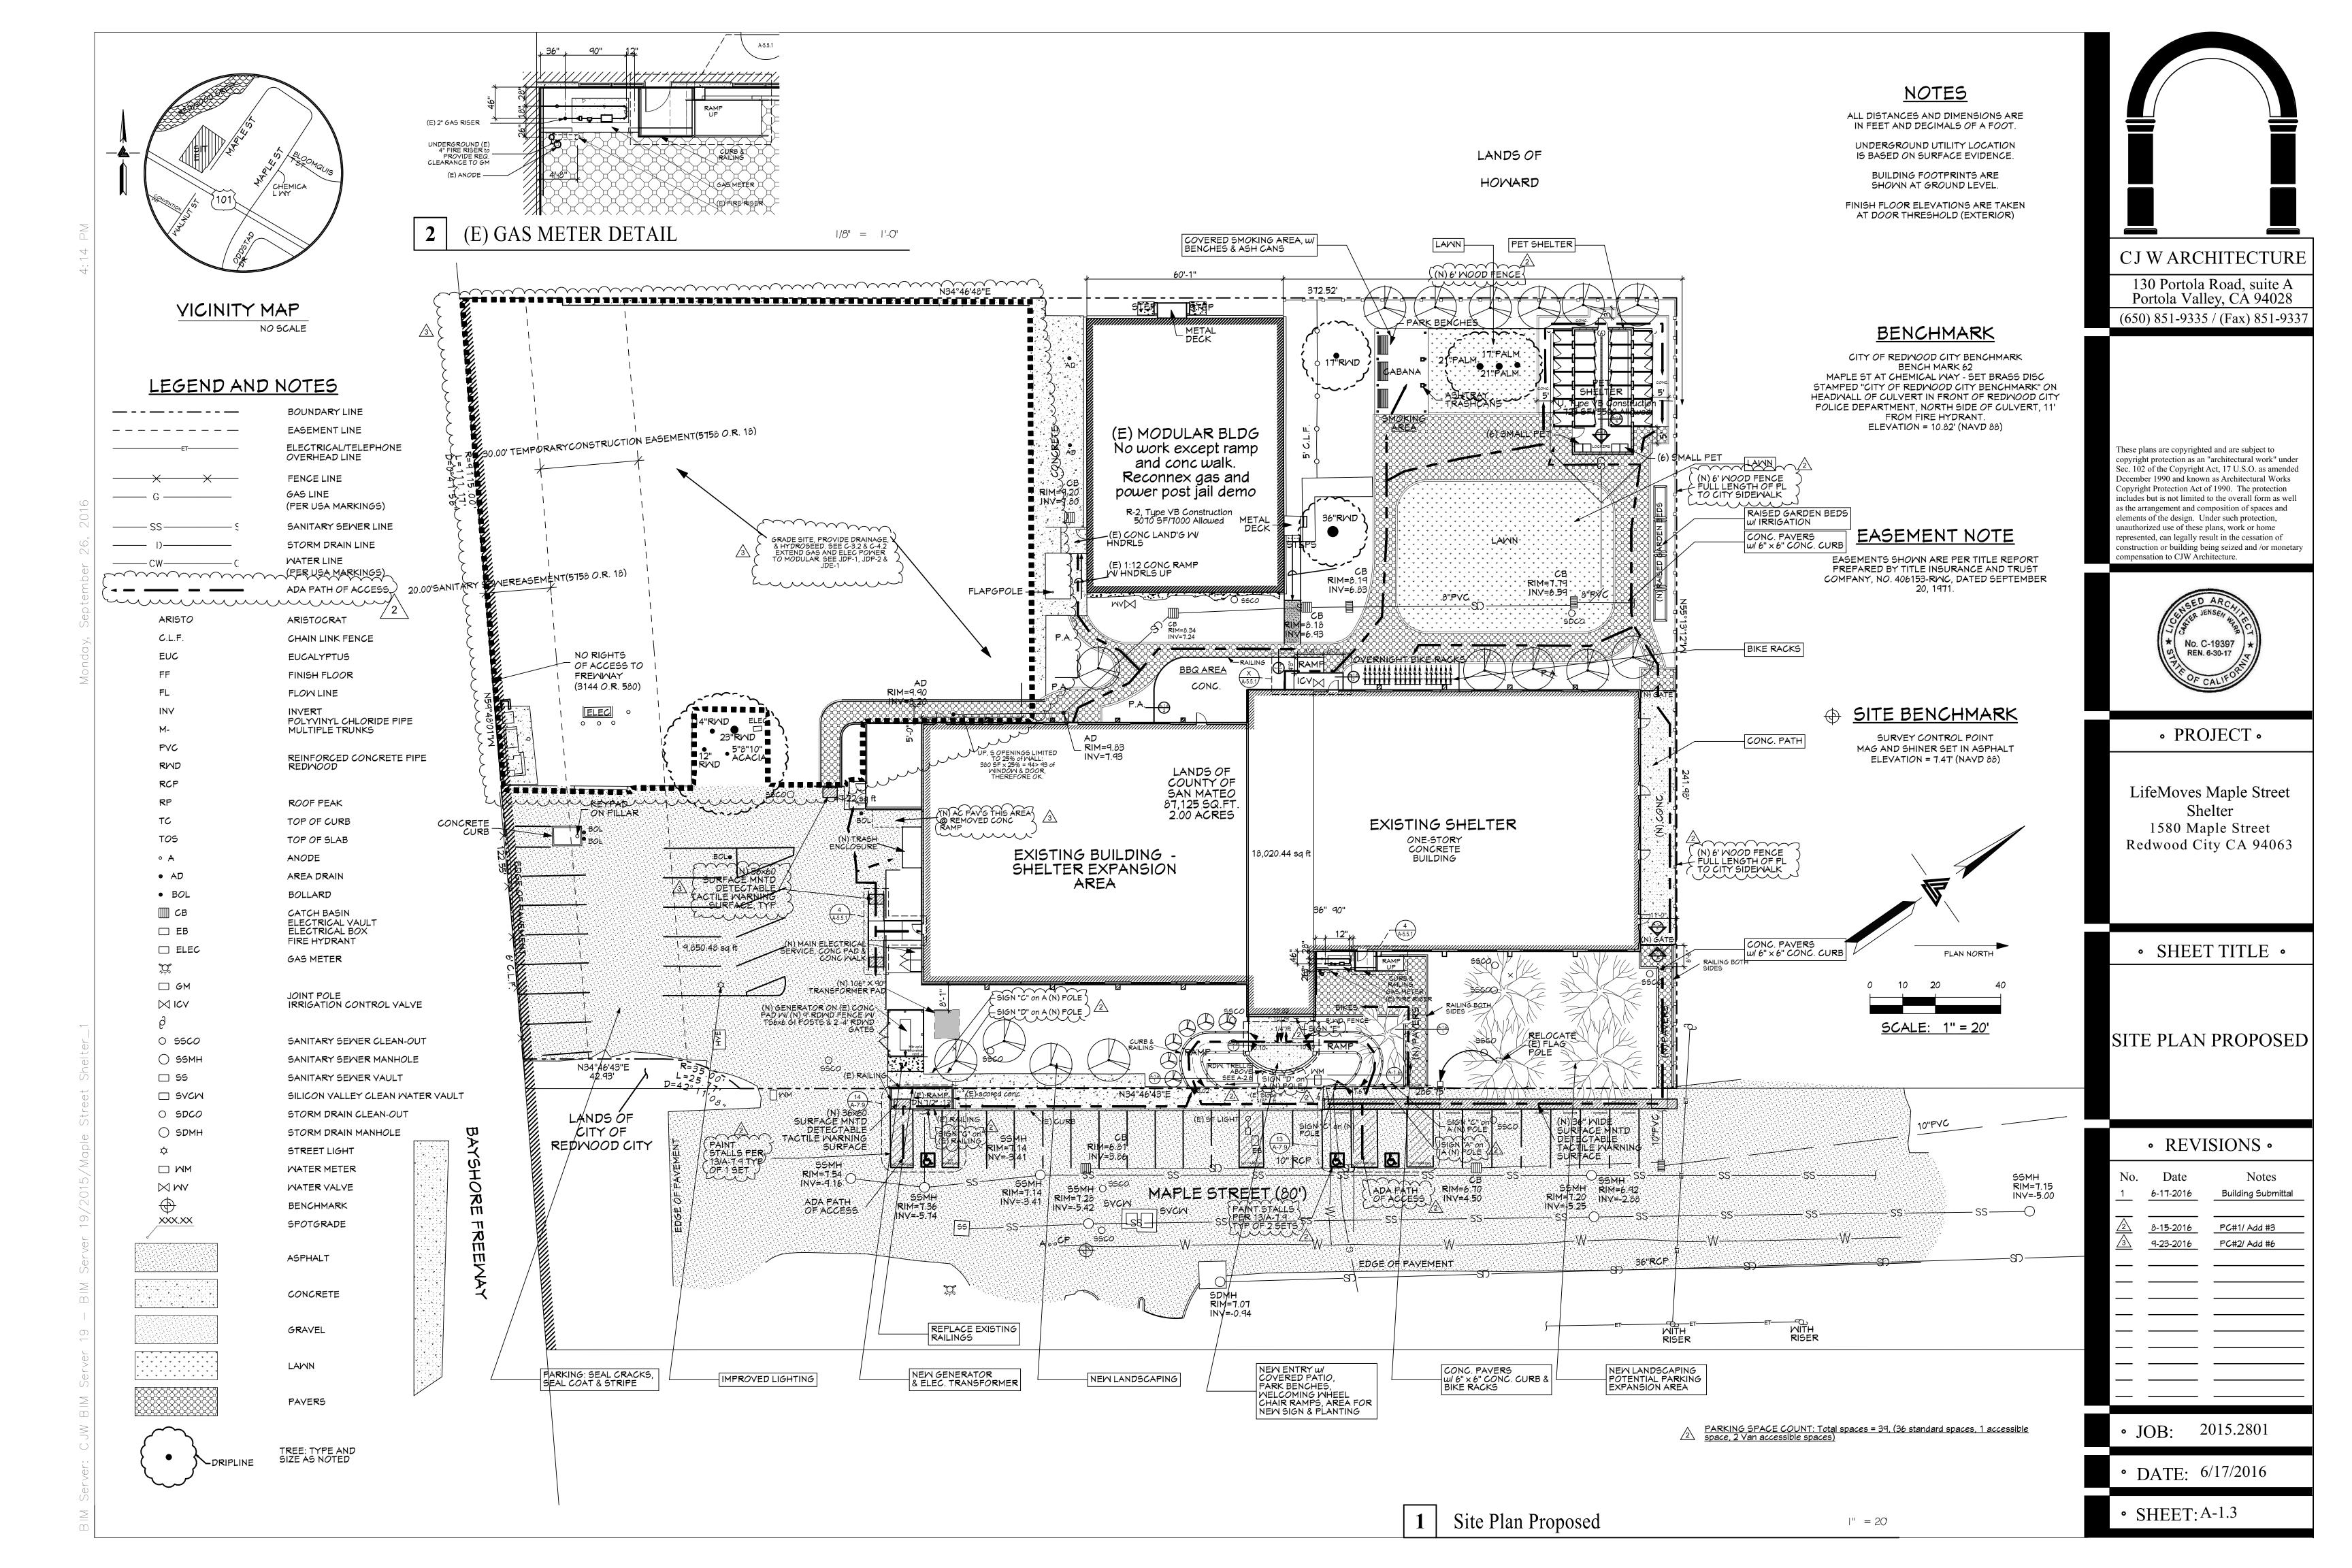


Figure 1. Forward Reach + ----High and Low Forward Reach Limits of 48" AFF and 15" AFF (Above Finished Floor)

**Forward Reach Requirement** 

Forward reach from a wheelchair is covered in Section 308.2.1 of the 2010 ADA Standards for Accessible Design published by the U.S. Department of Justice (September 15, 2010). It states: "Where a forward reach is unobstructed, the high forward reach shall be 48 inches (1220 mm) maximum and the low forward reach shall be 15 inches (380 mm) minimum above the finish floor or ground." See Figure 1.

The 48" maximum high forward reach for a shelf must be located less than 48" above the finished floor, and the 15" lower limit position for the shelf surface must be located at 15" above the finished floor.

Figure 2. Side Reach High and Low Side Reach Limits of 48" AFF and 15" AFF (Above Finished Floor) [15"] Side Reach Requirement Side reach from a wheelchair is covered in Section 308.3.1 of the same

document. It states: "Where a clear floor or ground space allows a parallel approach to an element and the side reach is unobstructed, the high side reach shall be 48 inches (1220 mm) maximum and the low side reach shall be 15 inches (380 mm) minimum above the finish floor or ground." See Figure 2.


The 48" maximum high side reach for a shelf must be located less than 48" above the finished floor, and the 15" lower limit position for the shelf surface must be located at 15" above the finished floor.

**Turning Radius Recommendation** 

Lockers should be placed in an area that allows full door swing and wheelchair turning ability. Lockers shall be placed in a location at least

Figure 3. Turning Radius 24" away from other 24" obstacle; minumum 30" x 48" floor space with a 10" minimum for door swing; 60" diameter turning circle.

24" away from any wall or other obstacle and have a minimum clear floor space of 30" x 48" with a 10" minimum for door swing. The area in front of the locker must be clear within a 60" diameter turning circle to allow for unobstructed access. See Figure 3.

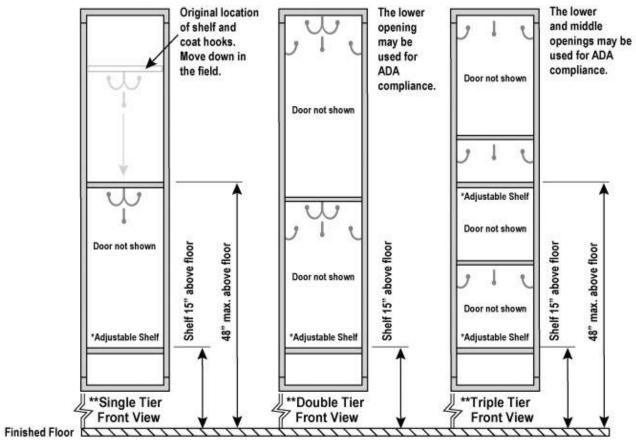

\* Locker shelves are adjustable to meed ADA guidelines.

\*\* Locker leg or base height can vary depending on installation desired. From zero (0) inches A.F.F. (metal lockers without legs or wood lockers without bases) to six (6) inches A.F.F. (metal lockers with legs).

**ADA Locker Guidelines** 

Although the Americans with Disabilities Act (ADA) does not address lockers specifically, it does refer to features that are found on or in lockers and provides guidance for the placement of lockers within a room. That guidance is as follows:

• Shall have a shape that is easy to grasp with one hand and does not require tight grasping, tight pinching, or twisting of operate." (ADA Accessibility Guideline: 4.13.9)

LOCKS No higher than 48" Limit pinching/twisting Suggested lock types:

-Padlock hasp or high security padlock hasp with user supplied ADA compliant lock

INTERIOR DESIGN Interior hooks, no higher than 48"

• Shelves: no higher than 48", there must be a shelf no lower that 15" (above finished floor)


• Clearance in front of locker must be a minimum of 24" away from the lockers and 30" in width along the lockers. Salsbury's

recommended clearance is 60", circular to allow for a wheel chair to turn

Local building officials will eventually require compliance with The Americans with Disabilities Act of 1990 which -At least one of each type of locker offered, and for double tier lockers only the bottom row be provided as ADA compliant -A clear floor space of 30"x48" minimum that allows for either forward or parallel approach by a person using a wheelchair -Storage spaces such as shelves, hooks, coat rods, etc. shall be located at a height of 15" minimum and 48" maximum

above the finished floor

-Acceptable hardware for accessible lockers are U-shaped pulls located as close to the top of the door as possible

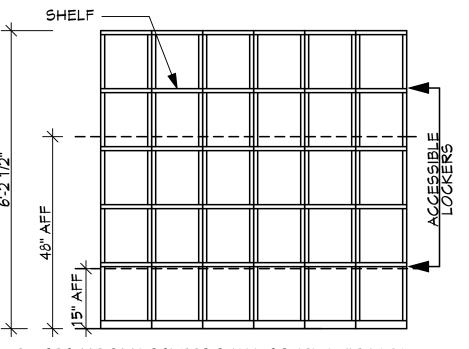

Per CBC 11B-309 LOCKERS SHALL COMPLY WITH ADA ACCESSIBILITY. AT LEAST 5% OF LOCKERS SHALL BE ACCESSIBLE; CURRENT DESIGN MAKES 60%ACCESSIBLE.


Entry Ramps

1/2'' = 1'-0''



P880-BZ 2-7/16 [61] Wide Bronze Decorative Grate

	Dimensional Data (inches and [ mm ]) are Subject to Manufacturing Tolerances and Change Without Notice						
Please	Item	Part	Item		Back to Index		
Check	No.	Number	I.D.				
$\checkmark$							
	2	64446-001	P880-BZ				

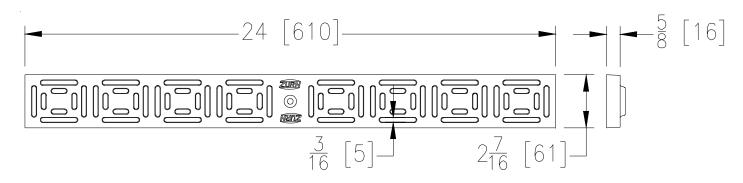

Opening in grate is max. 3/16".
Opening shall not allow passage of a sphere more than 1/2" diameter.
CBC 11B-302.3 & Figure 11B-302.3

Trench Drain Grate



CJ W ARCHITECTURE

130 Portola Road, suite A Portola Valley, CÁ 94028 (650) 851-9335 / (Fax) 851-9337

These plans are copyrighted and are subject to copyright protection as an "architectural work" under Sec. 102 of the Copyright Act, 17 U.S.O. as amended December 1990 and known as Architectural Works Copyright Protection Act of 1990. The protection includes but is not limited to the overall form as well as the arrangement and composition of spaces and elements of the design. Under such protection, unauthorized use of these plans, work or home represented, can legally result in the cessation of construction or building being seized and /or monetary compensation to CJW Architecture.



• PROJECT •

LifeMoves Maple Street 1580 Maple Street Redwood City CA 94063

• SHEET TITLE •

SITE DETAILS

• REVISIONS •

6-17-2016

8-1**5**-2016


9-23-2016

Notes

Building Submittal

PC#1/ Add #3

PCC & Add #6

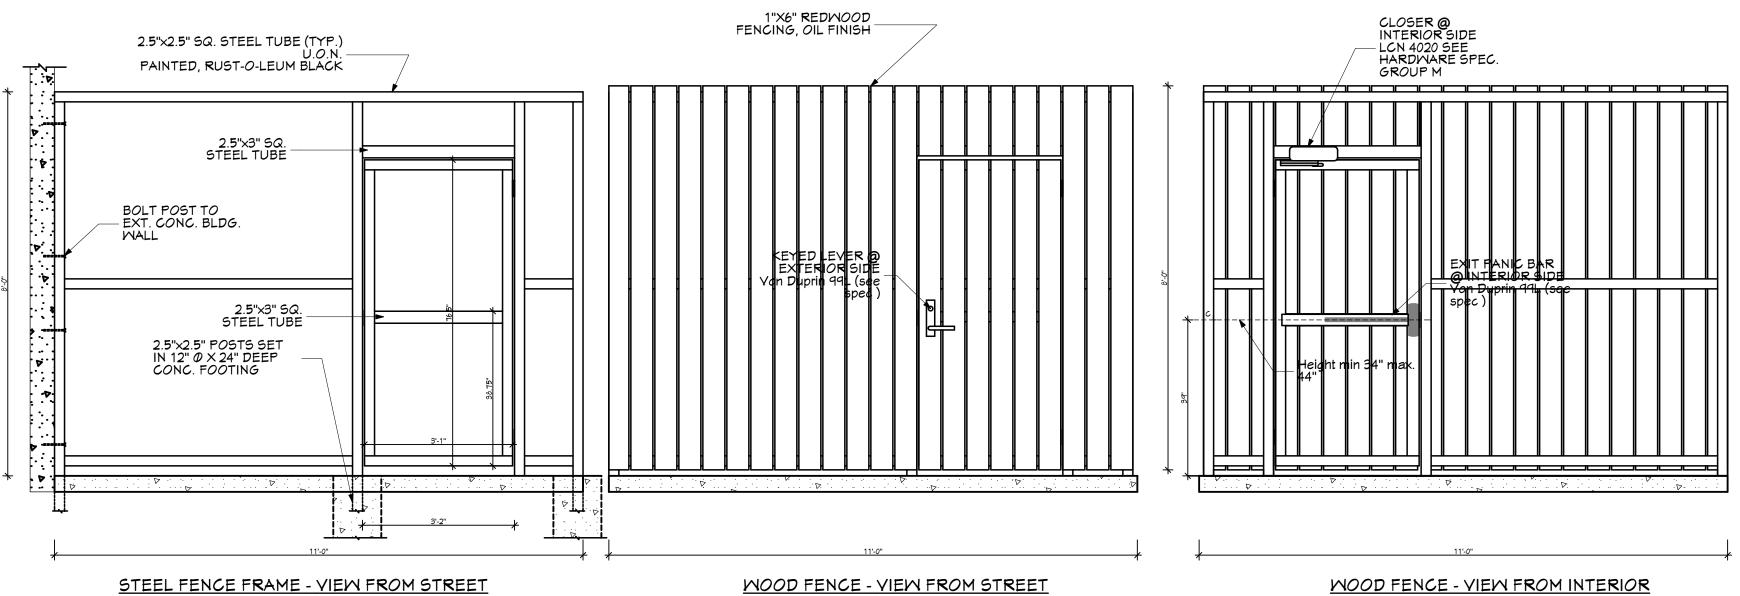

\_\_\_1×1 RDMD -2×4 RDMD -2X8 PTDF • JOB: 2015.2801 

-2X6 RDMD

—2X4 RDMD

—1×1 RDWD

\_\_\_1X6 RDMD

6' HIGH WOOD FENCE DETAIL

-4X4 PTDF POST


• DATE: 6/17/2016


• SHEET: A-1.5


Gate & Fence - West

1/2" = 1'-0"




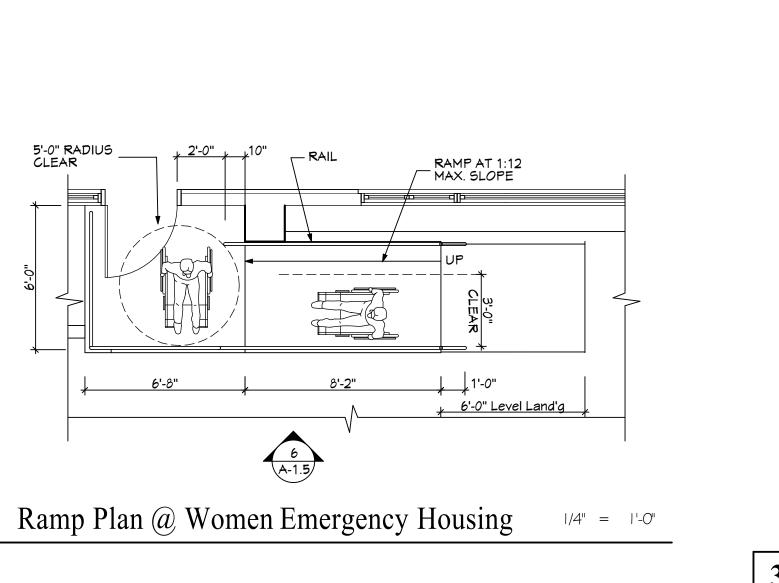


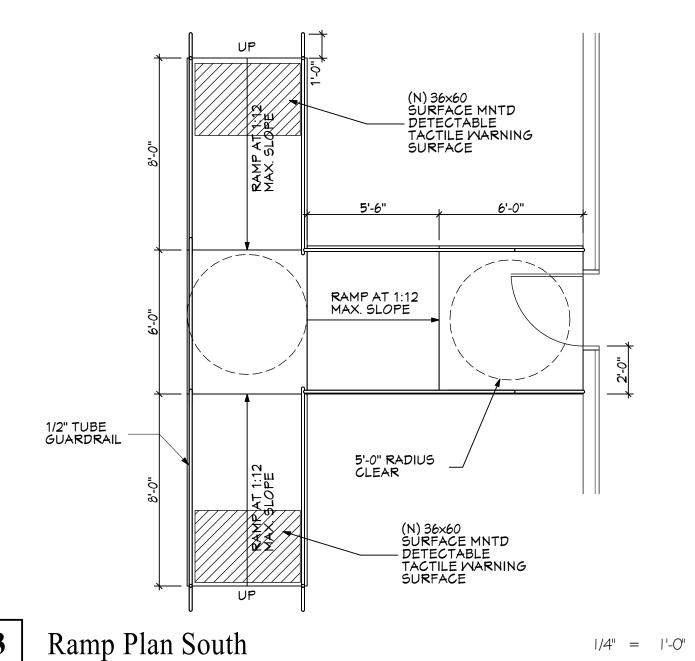


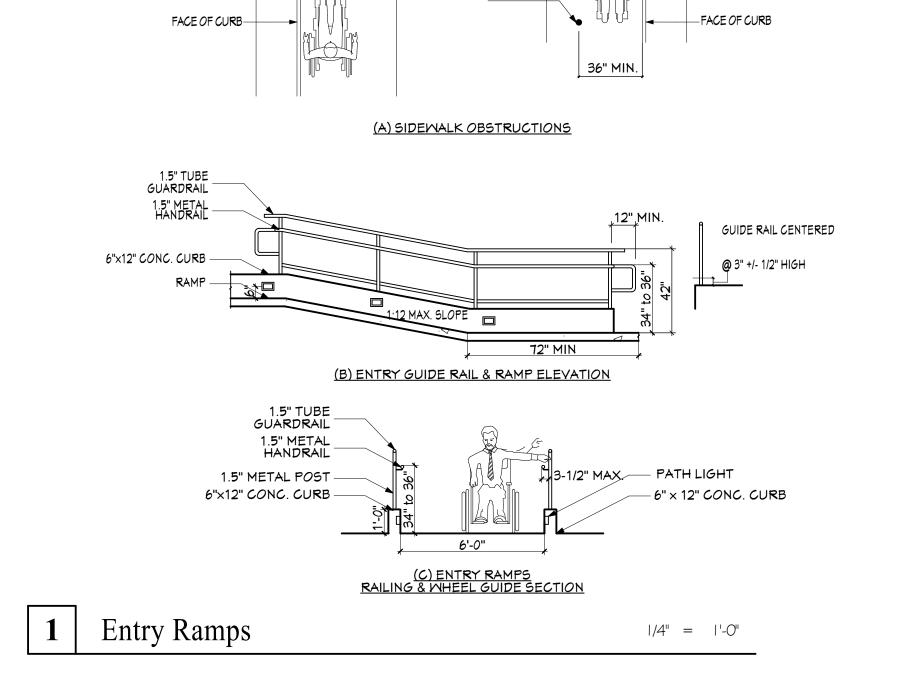



48" MIN.SIDEWAĻK

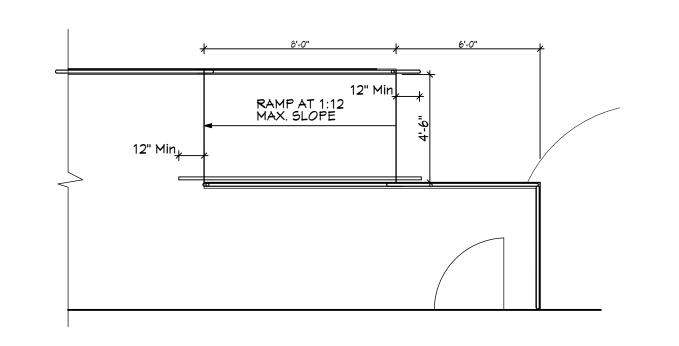

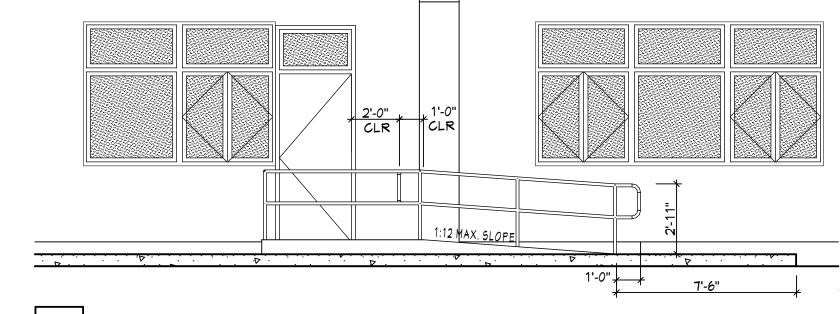


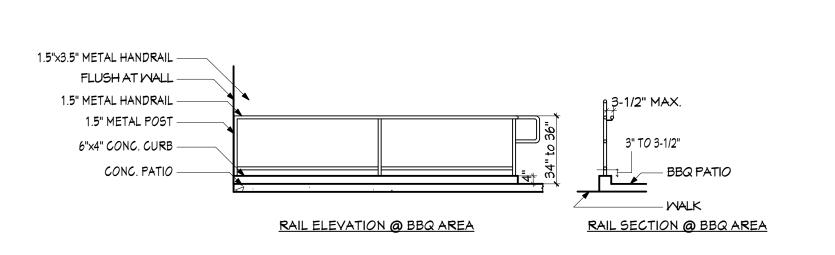


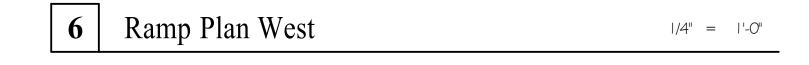

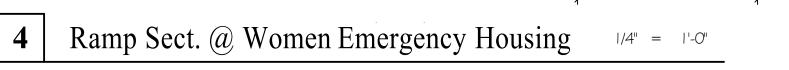



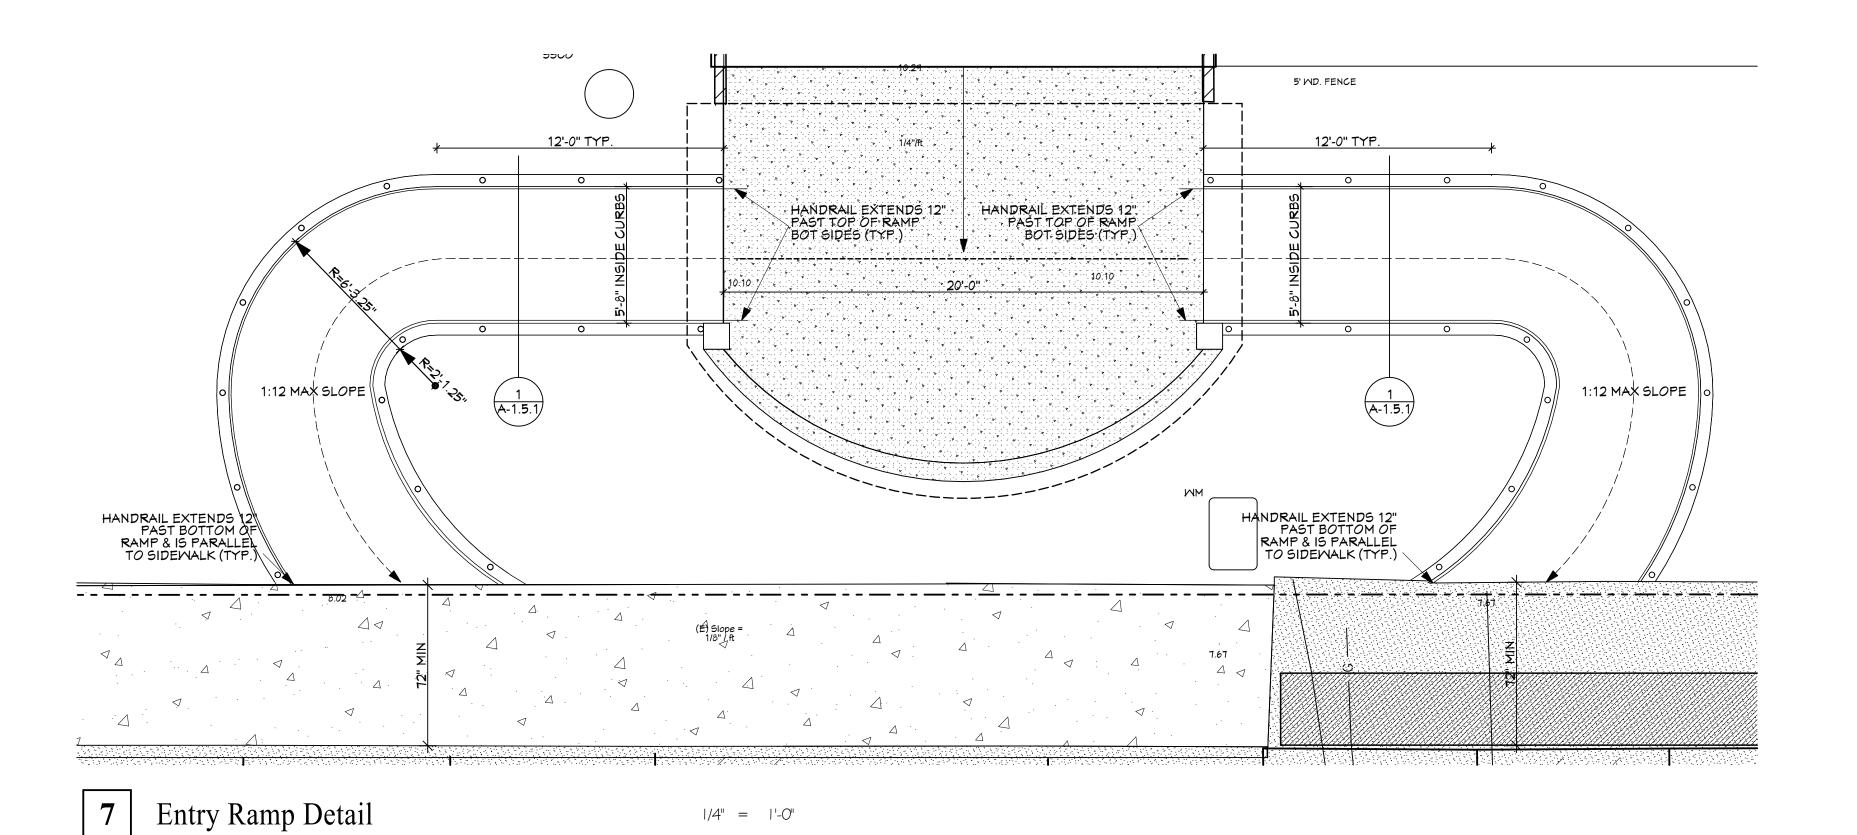

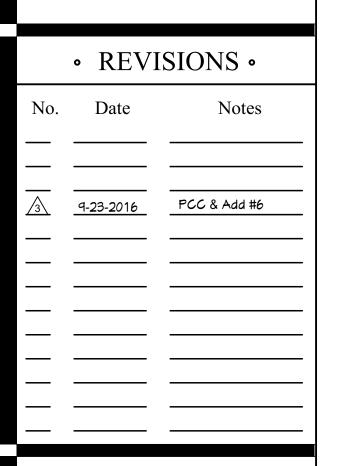

**CJWARCHITECTURE** 

130 Portola Road, suite A Portola Valley, CA 94028

(650) 851-9335 / (Fax) 851-9337

These plans are copyrighted and are subject to copyright protection as an "architectural work" under Sec. 102 of the Copyright Act, 17 U.S.O. as amended December 1990 and known and the Copyright Act, 17 U.S.O. as The Copyright Act, 15 1000.

Copyright Protection Act of 1990. The protection includes but is not limited to the overall form as well

represented, can legally result in the cessation of construction or building being seized and /or monetary compensation to CJW Architecture.

• PROJECT •

LifeMoves Maple Street

1580 Maple Street Redwood City CA 94063

• SHEET TITLE •


ADA RAMP DETAILS


as the arrangement and composition of spaces and elements of the design. Under such protection, unauthorized use of these plans, work or home


• JOB: 2015.2801


• DATE: 6/17/2016

• SHEET: A-1.5.1

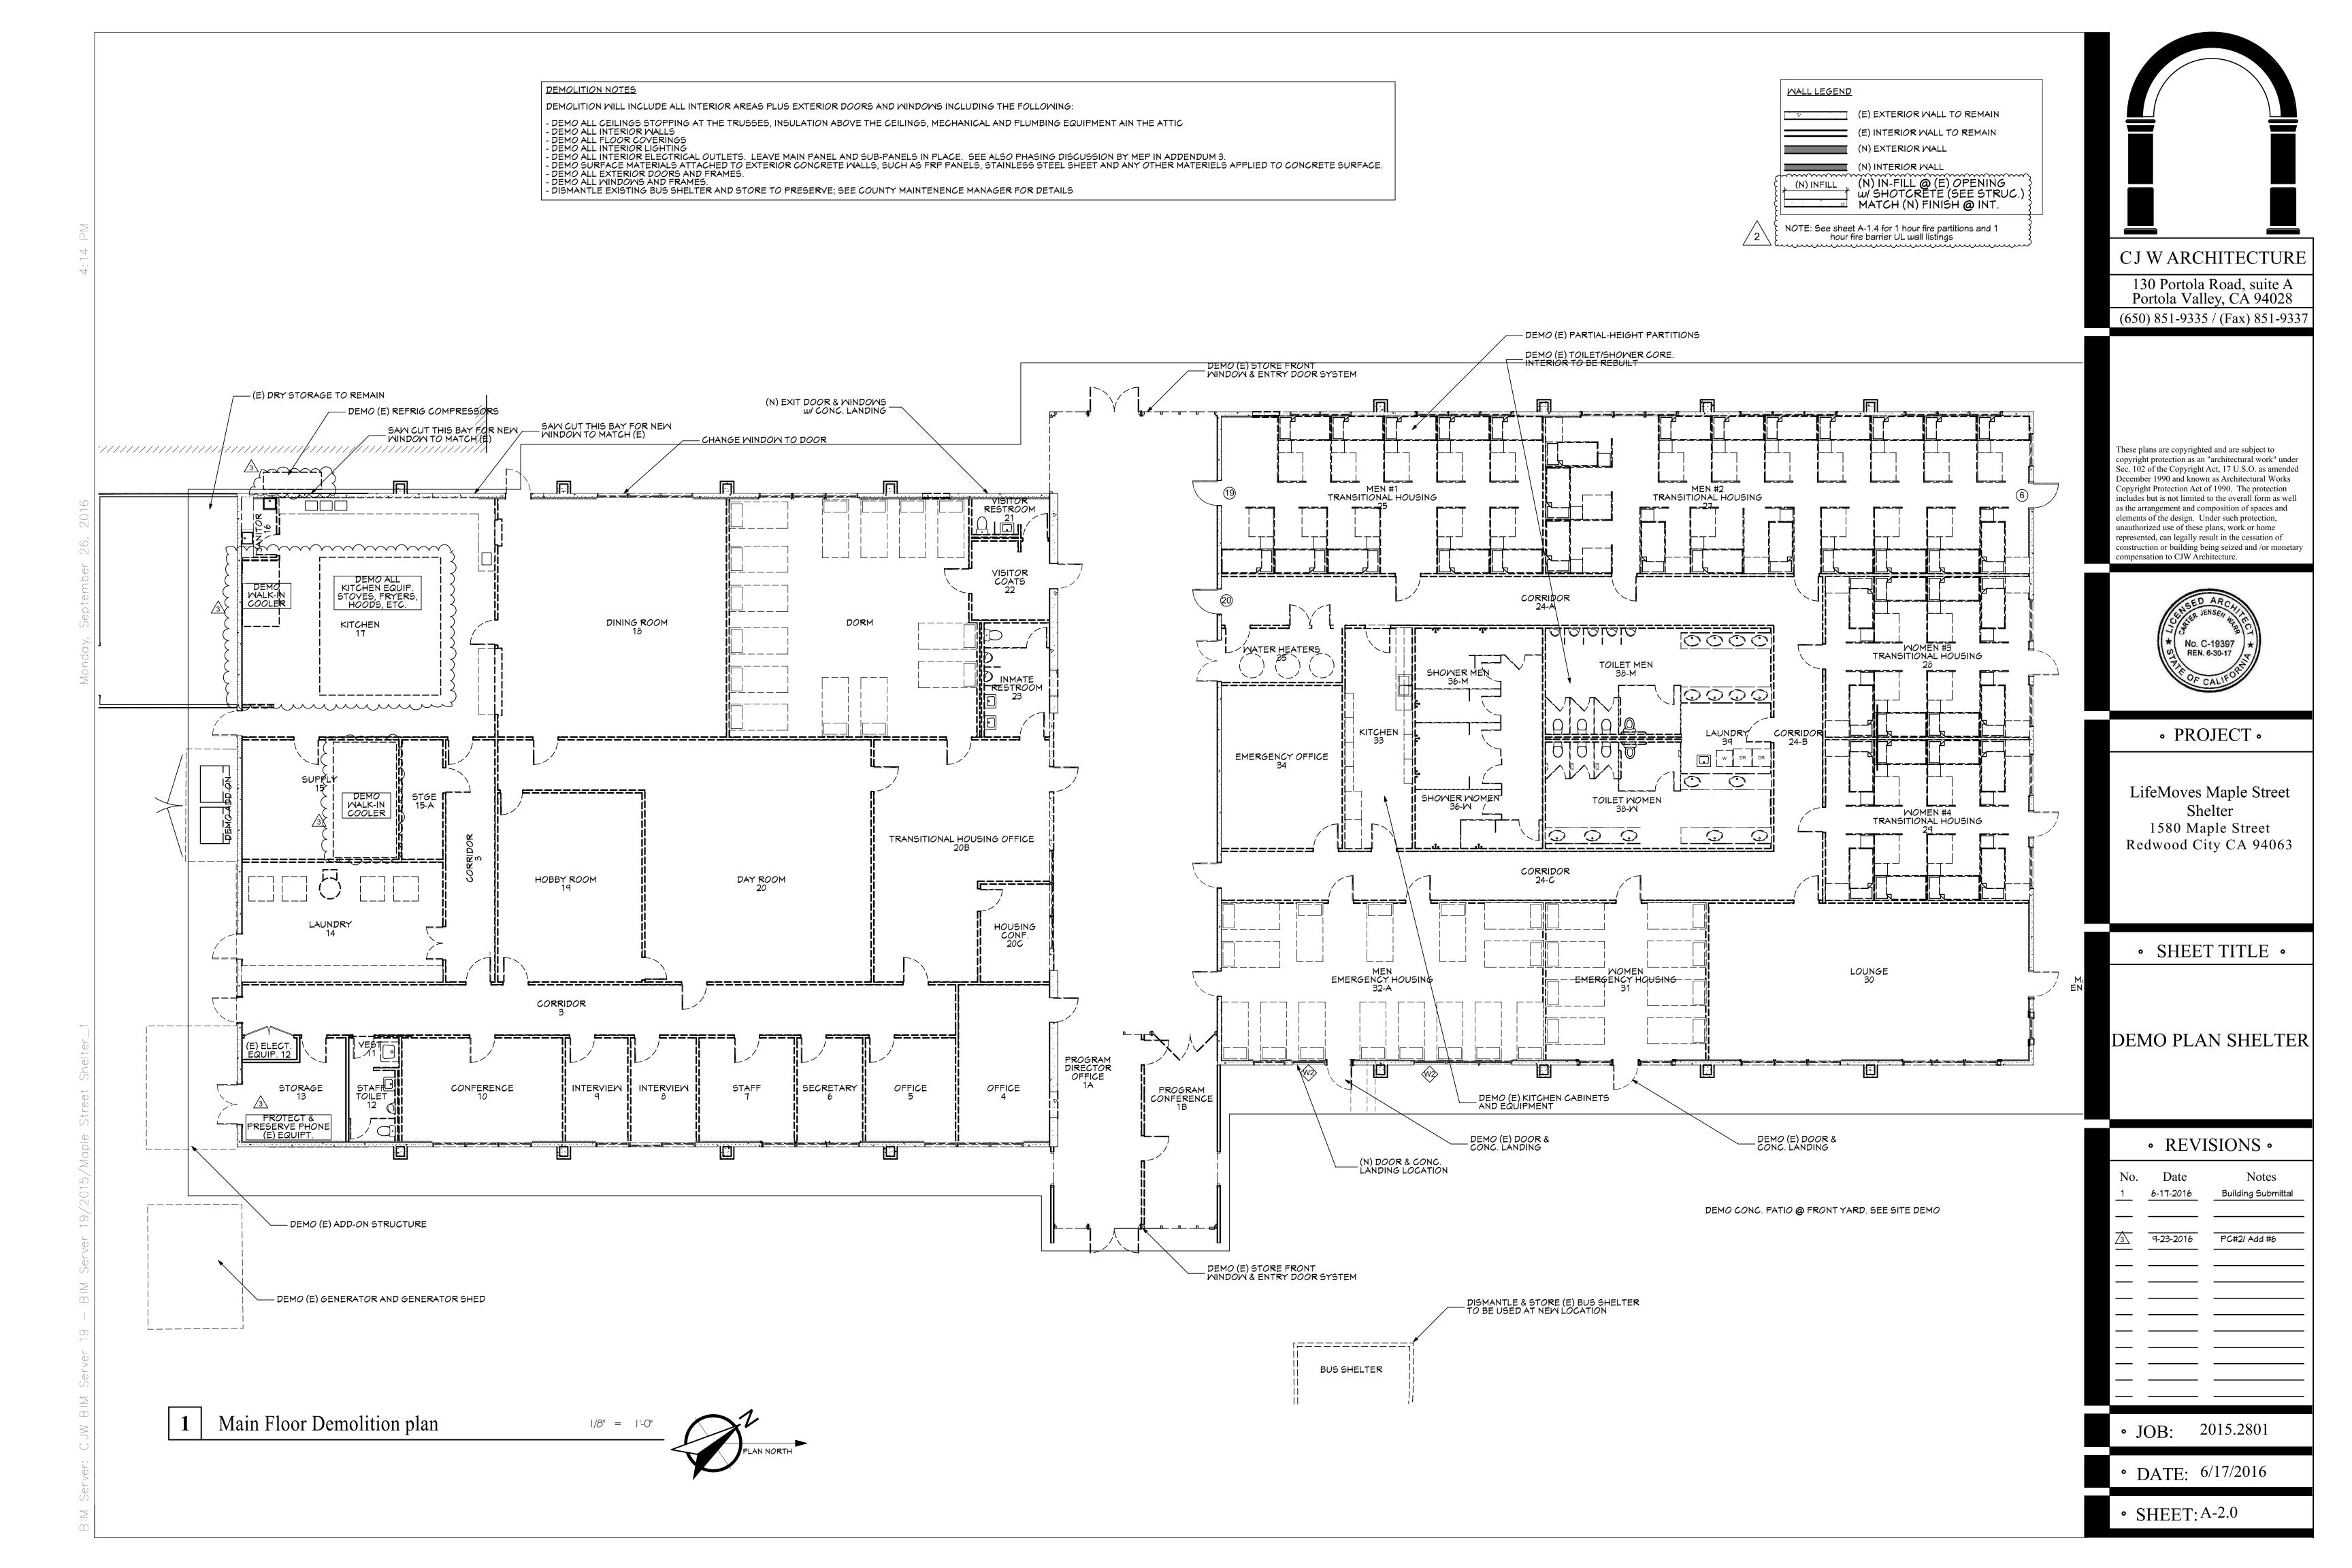


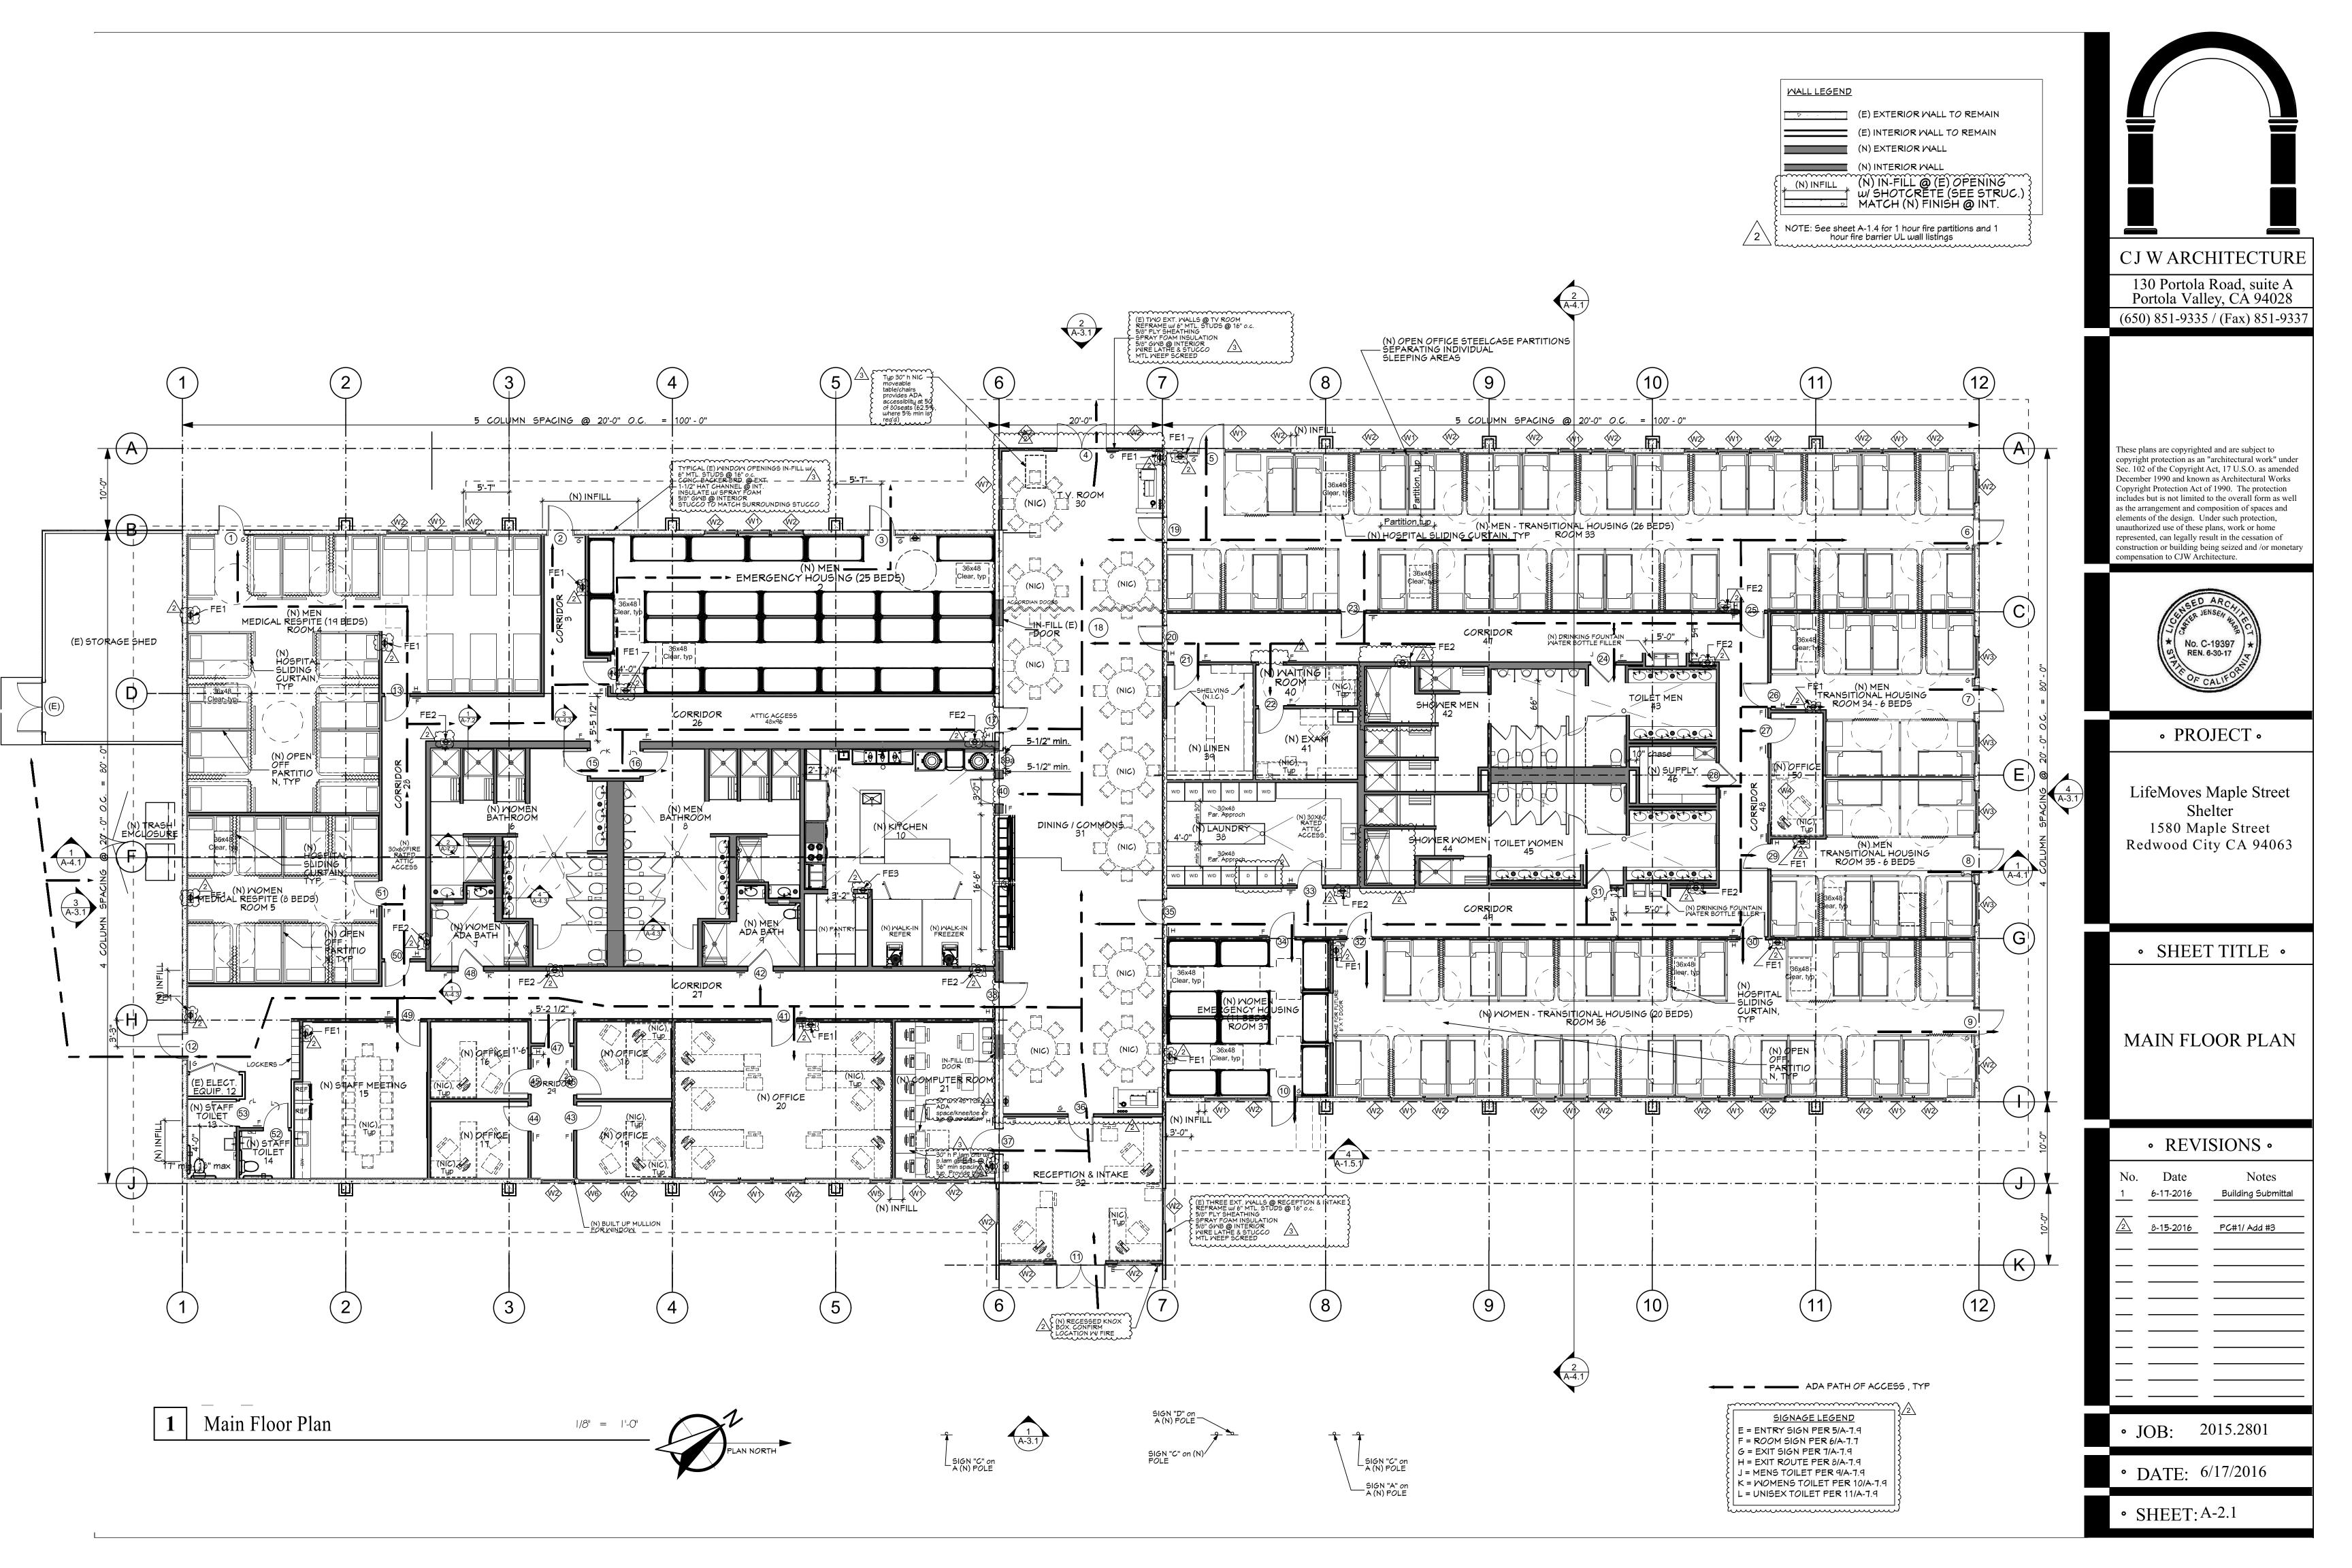

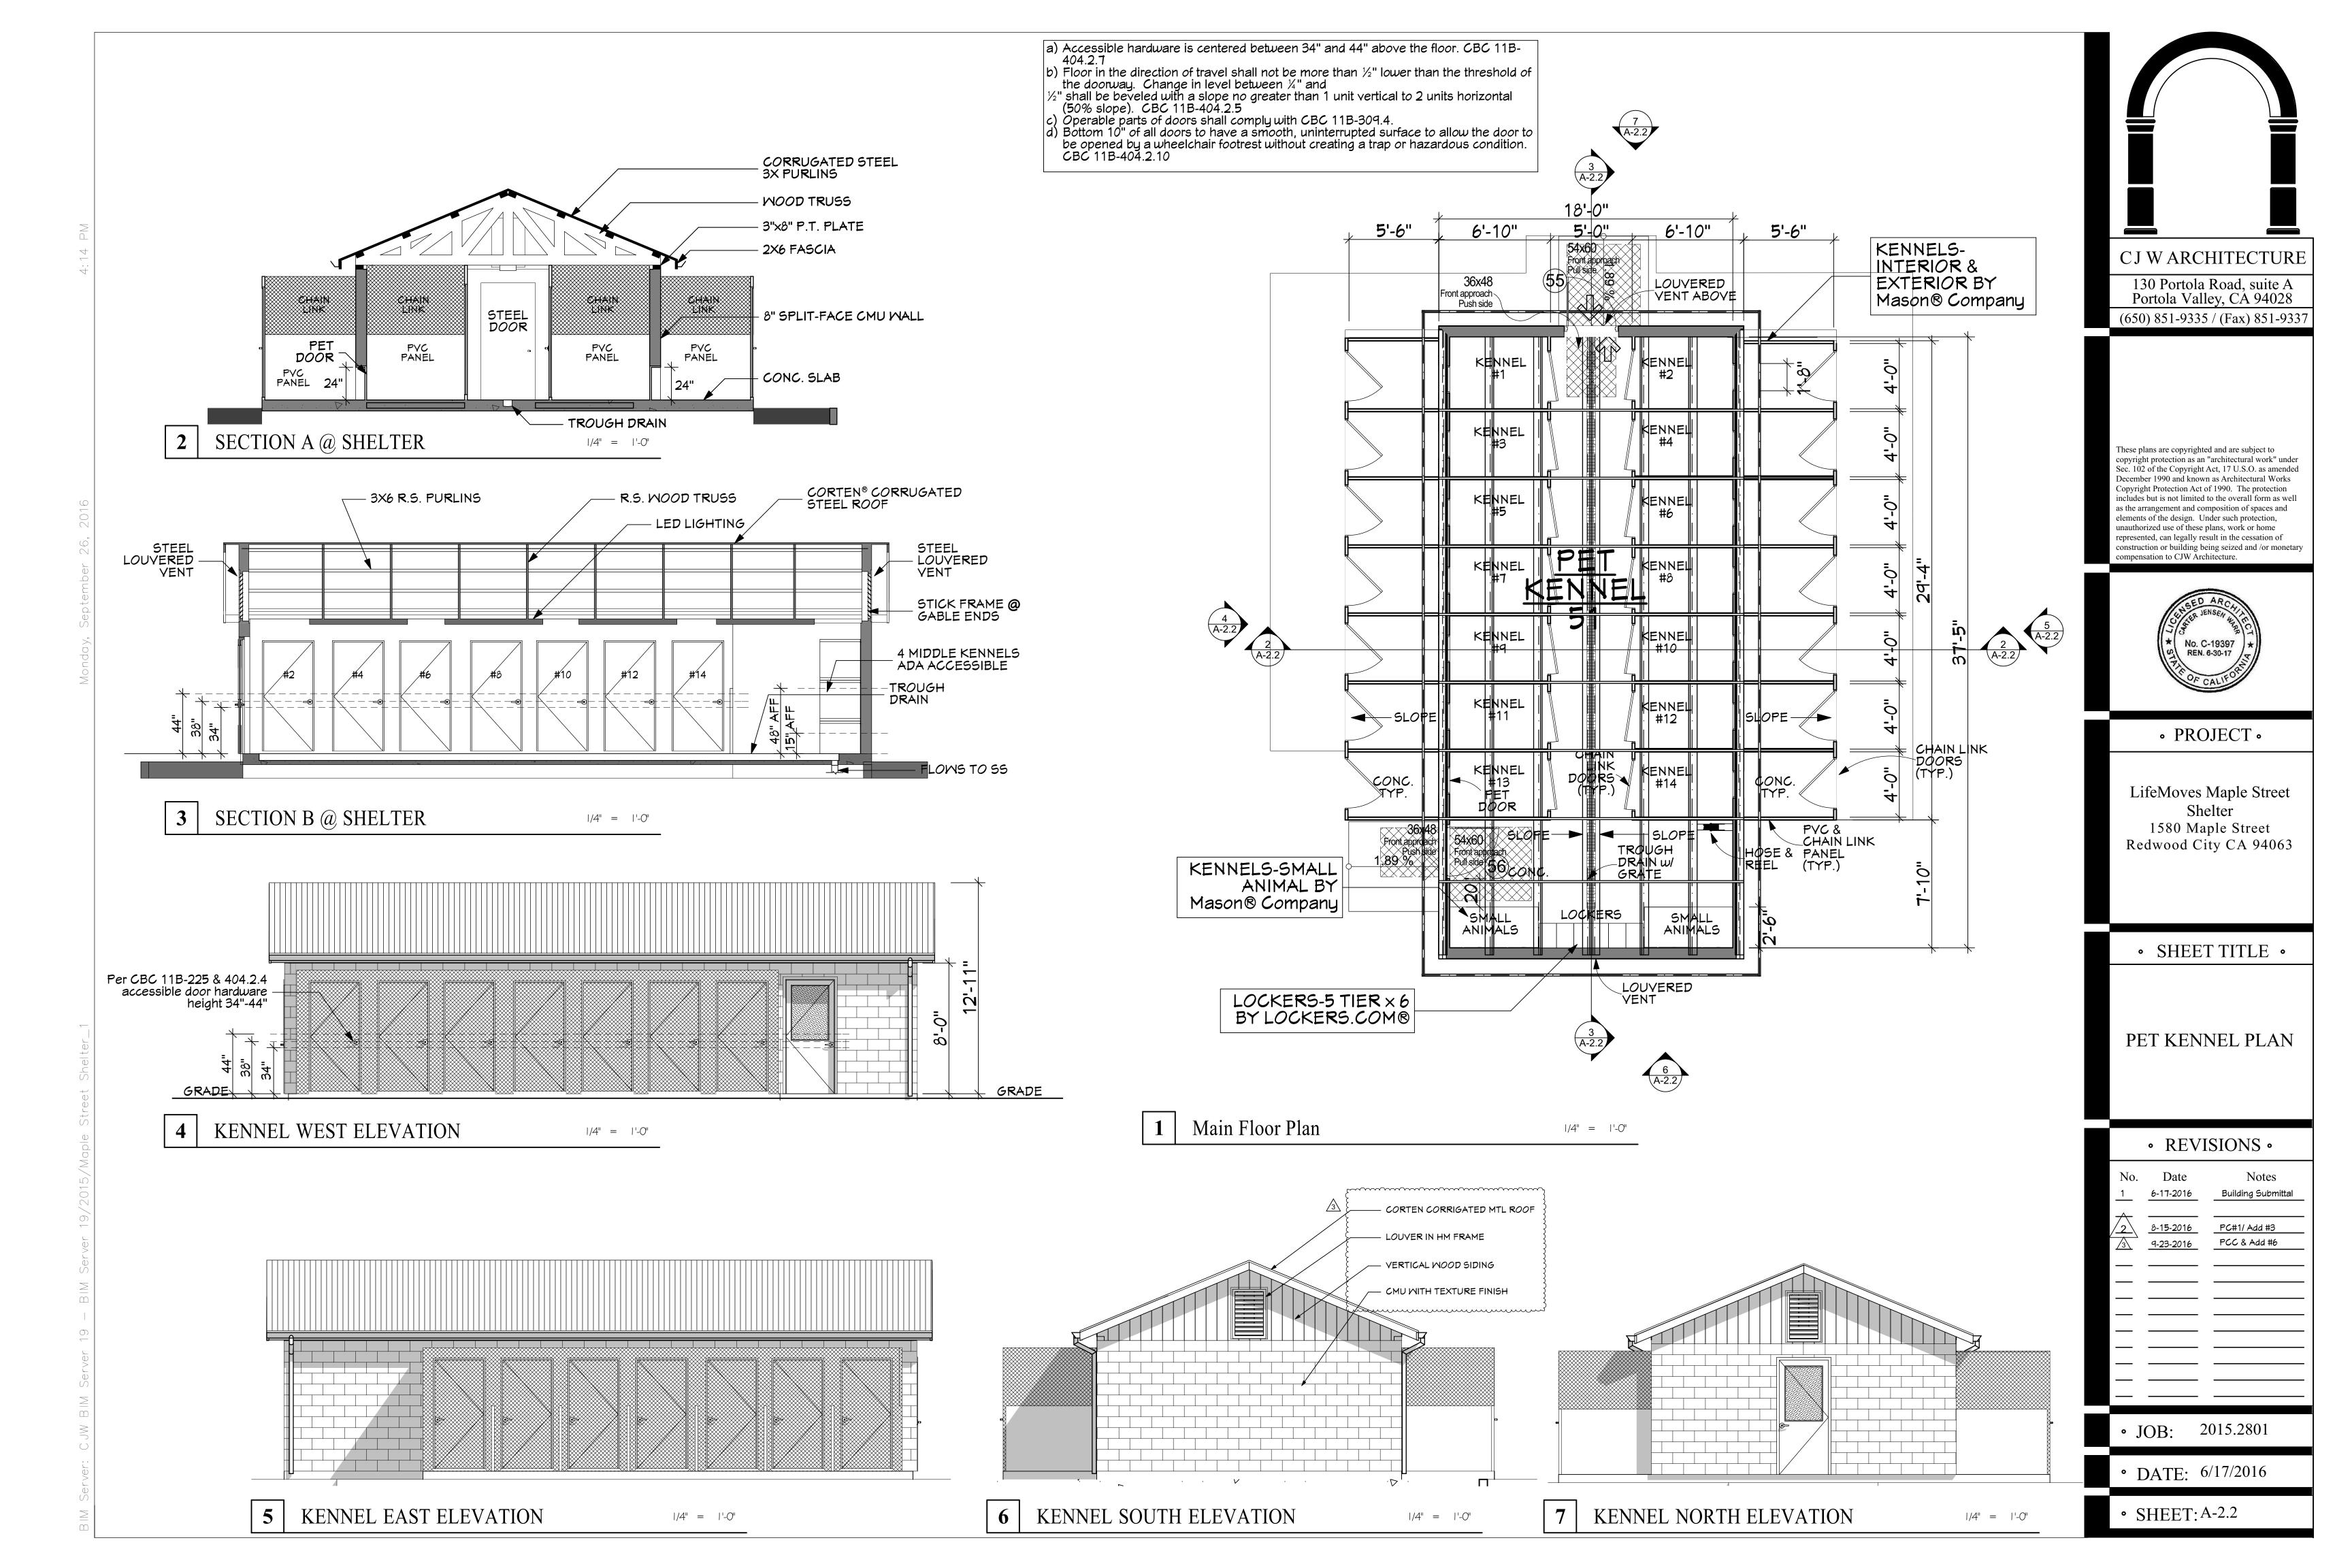

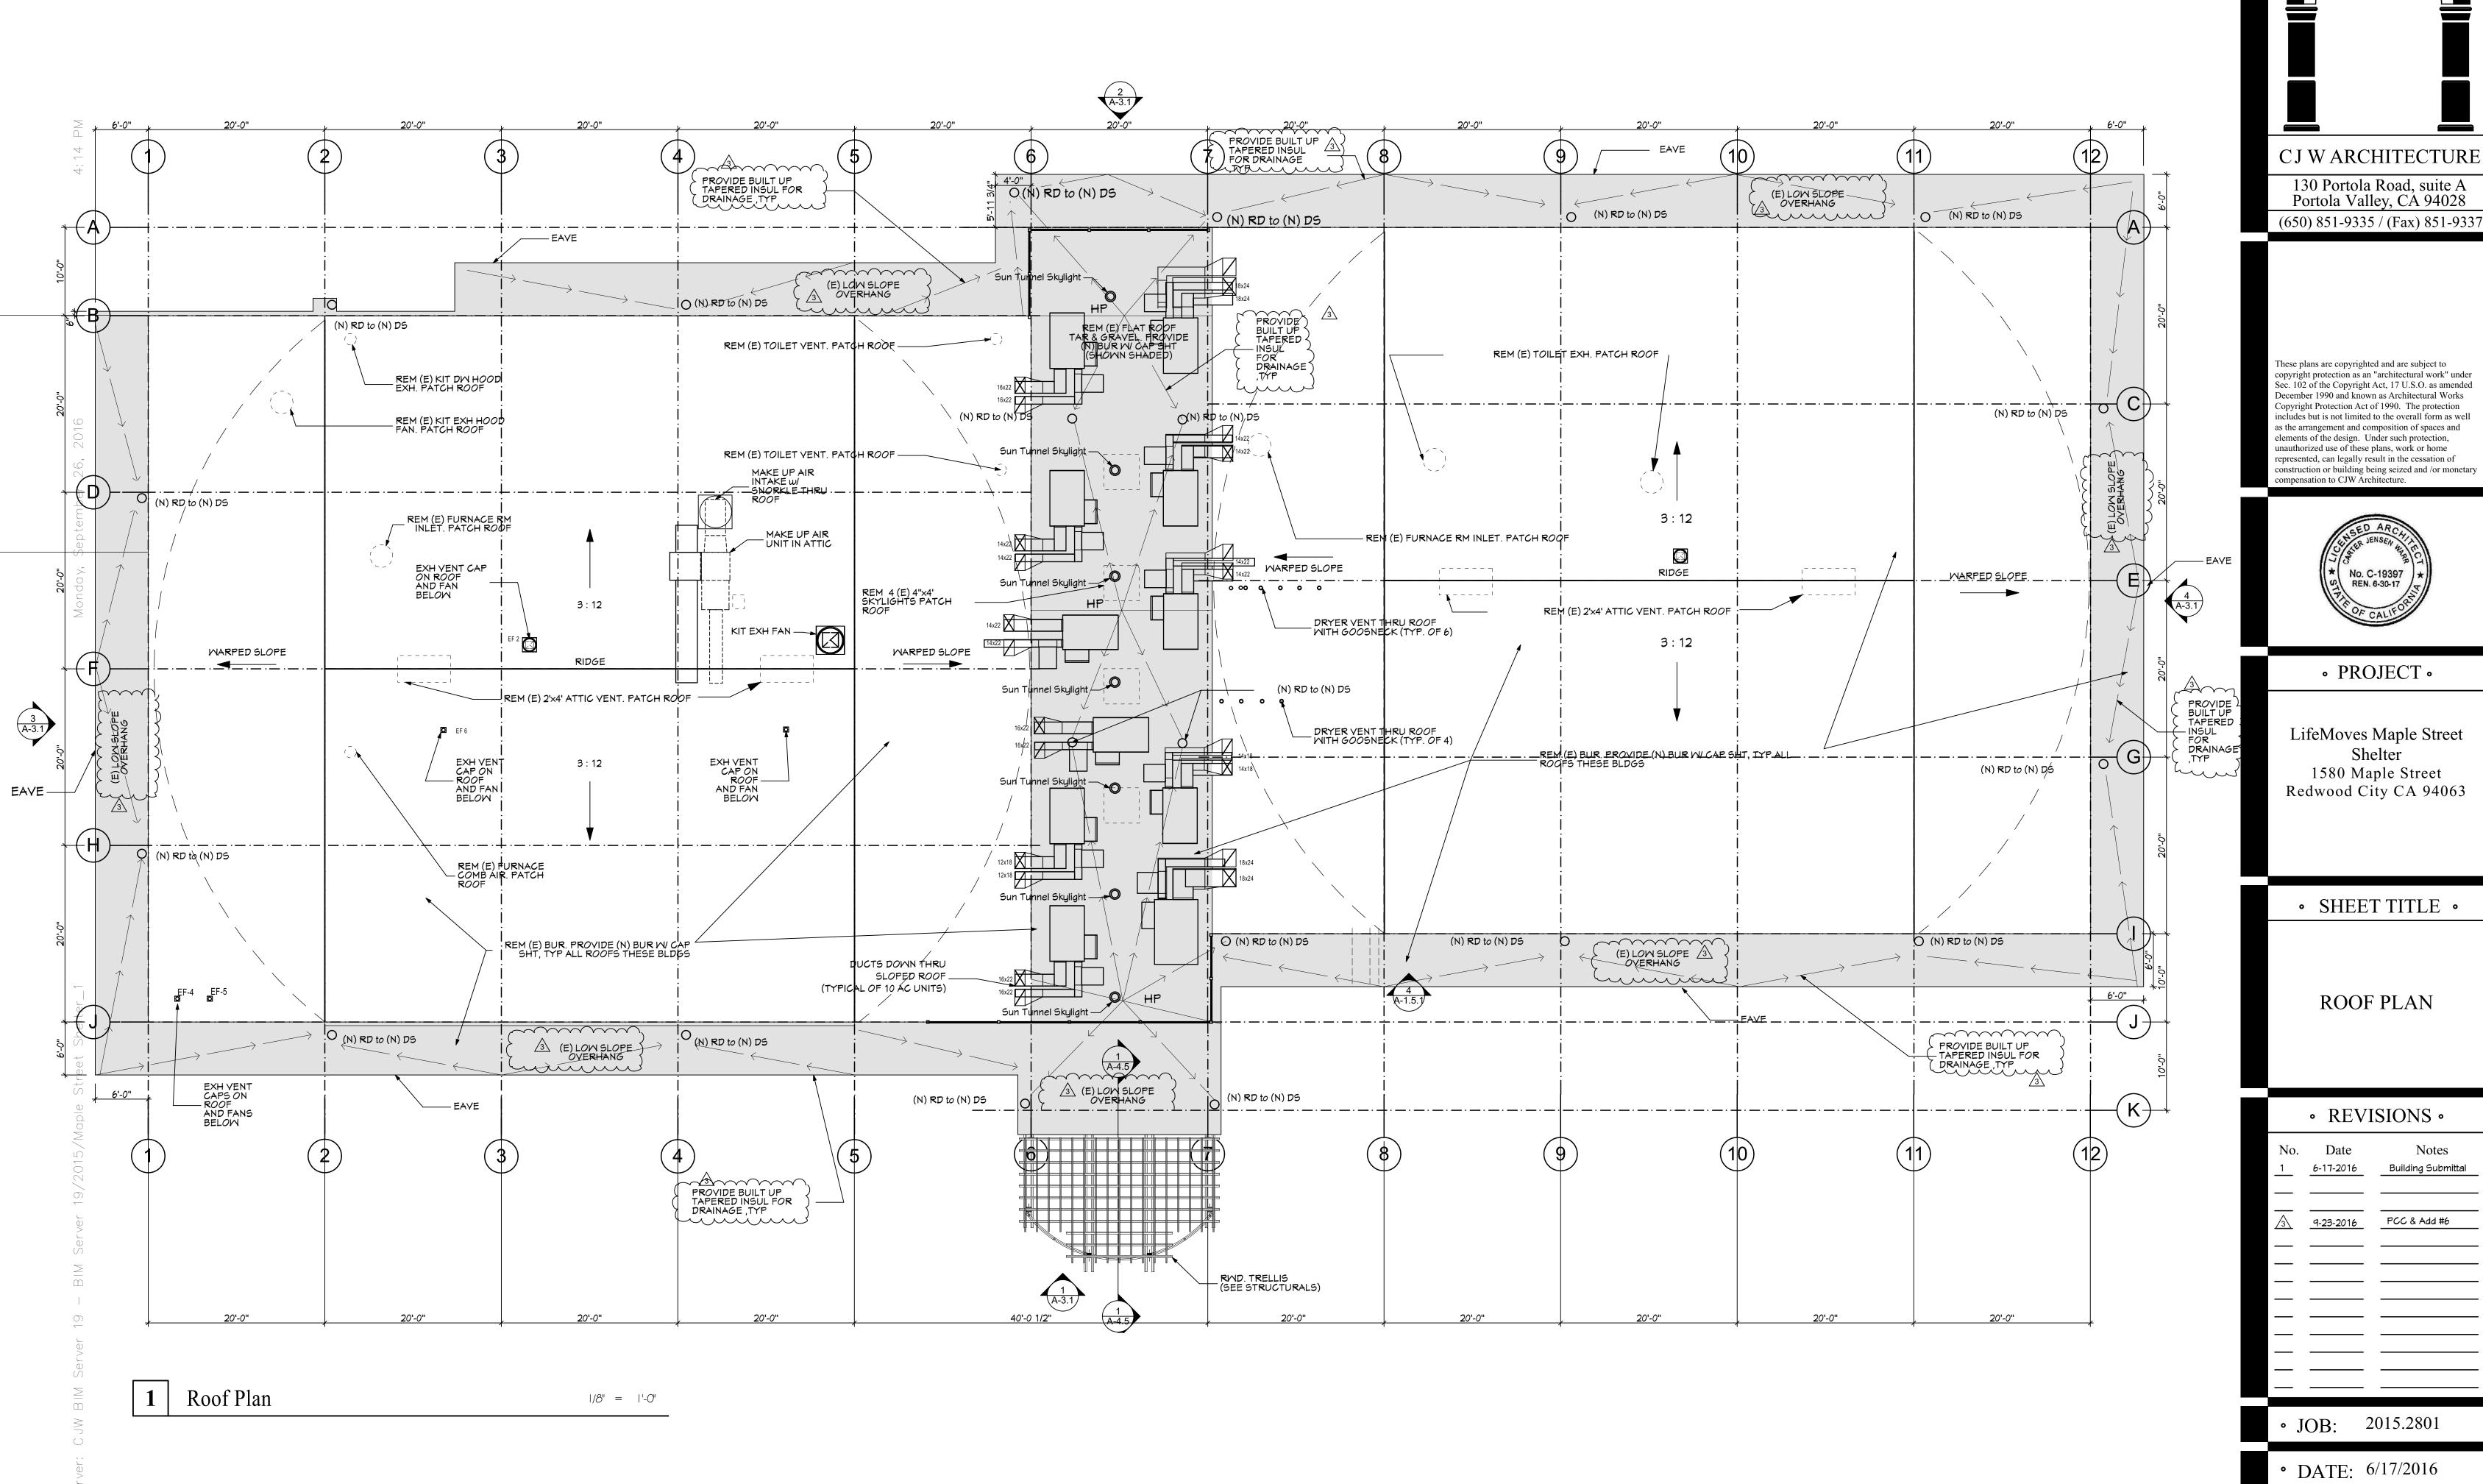

• SHEET: A-2.4

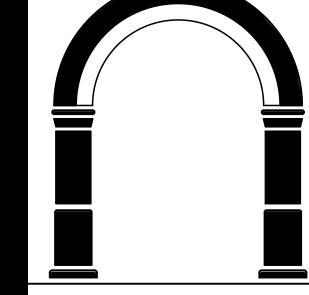

130 Portola Road, suite A Portola Valley, CA 94028 (650) 851-9335 / (Fax) 851-9337

These plans are copyrighted and are subject to copyright protection as an "architectural work" under Sec. 102 of the Copyright Act, 17 U.S.O. as amended December 1990 and known as Architectural Works Copyright Protection Act of 1990. The protection includes but is not limited to the overall form as well as the arrangement and composition of spaces and elements of the design. Under such protection, unauthorized use of these plans, work or home represented, can legally result in the cessation of construction or building being seized and /or monetary

pensation to CJW Architecture.



• PROJECT •

LifeMoves Maple Street
Shelter

1580 Maple Street Redwood City CA 94063

• SHEET TITLE •


JAIL DEMO - EXISTING FOUNDATION

• REVISIONS •

No.	Date	Notes
—		
—		
<u></u>	9-23-2016	PC#2/ Add #6

• JOB: 2015.2801

• DATE: 6/17/2016

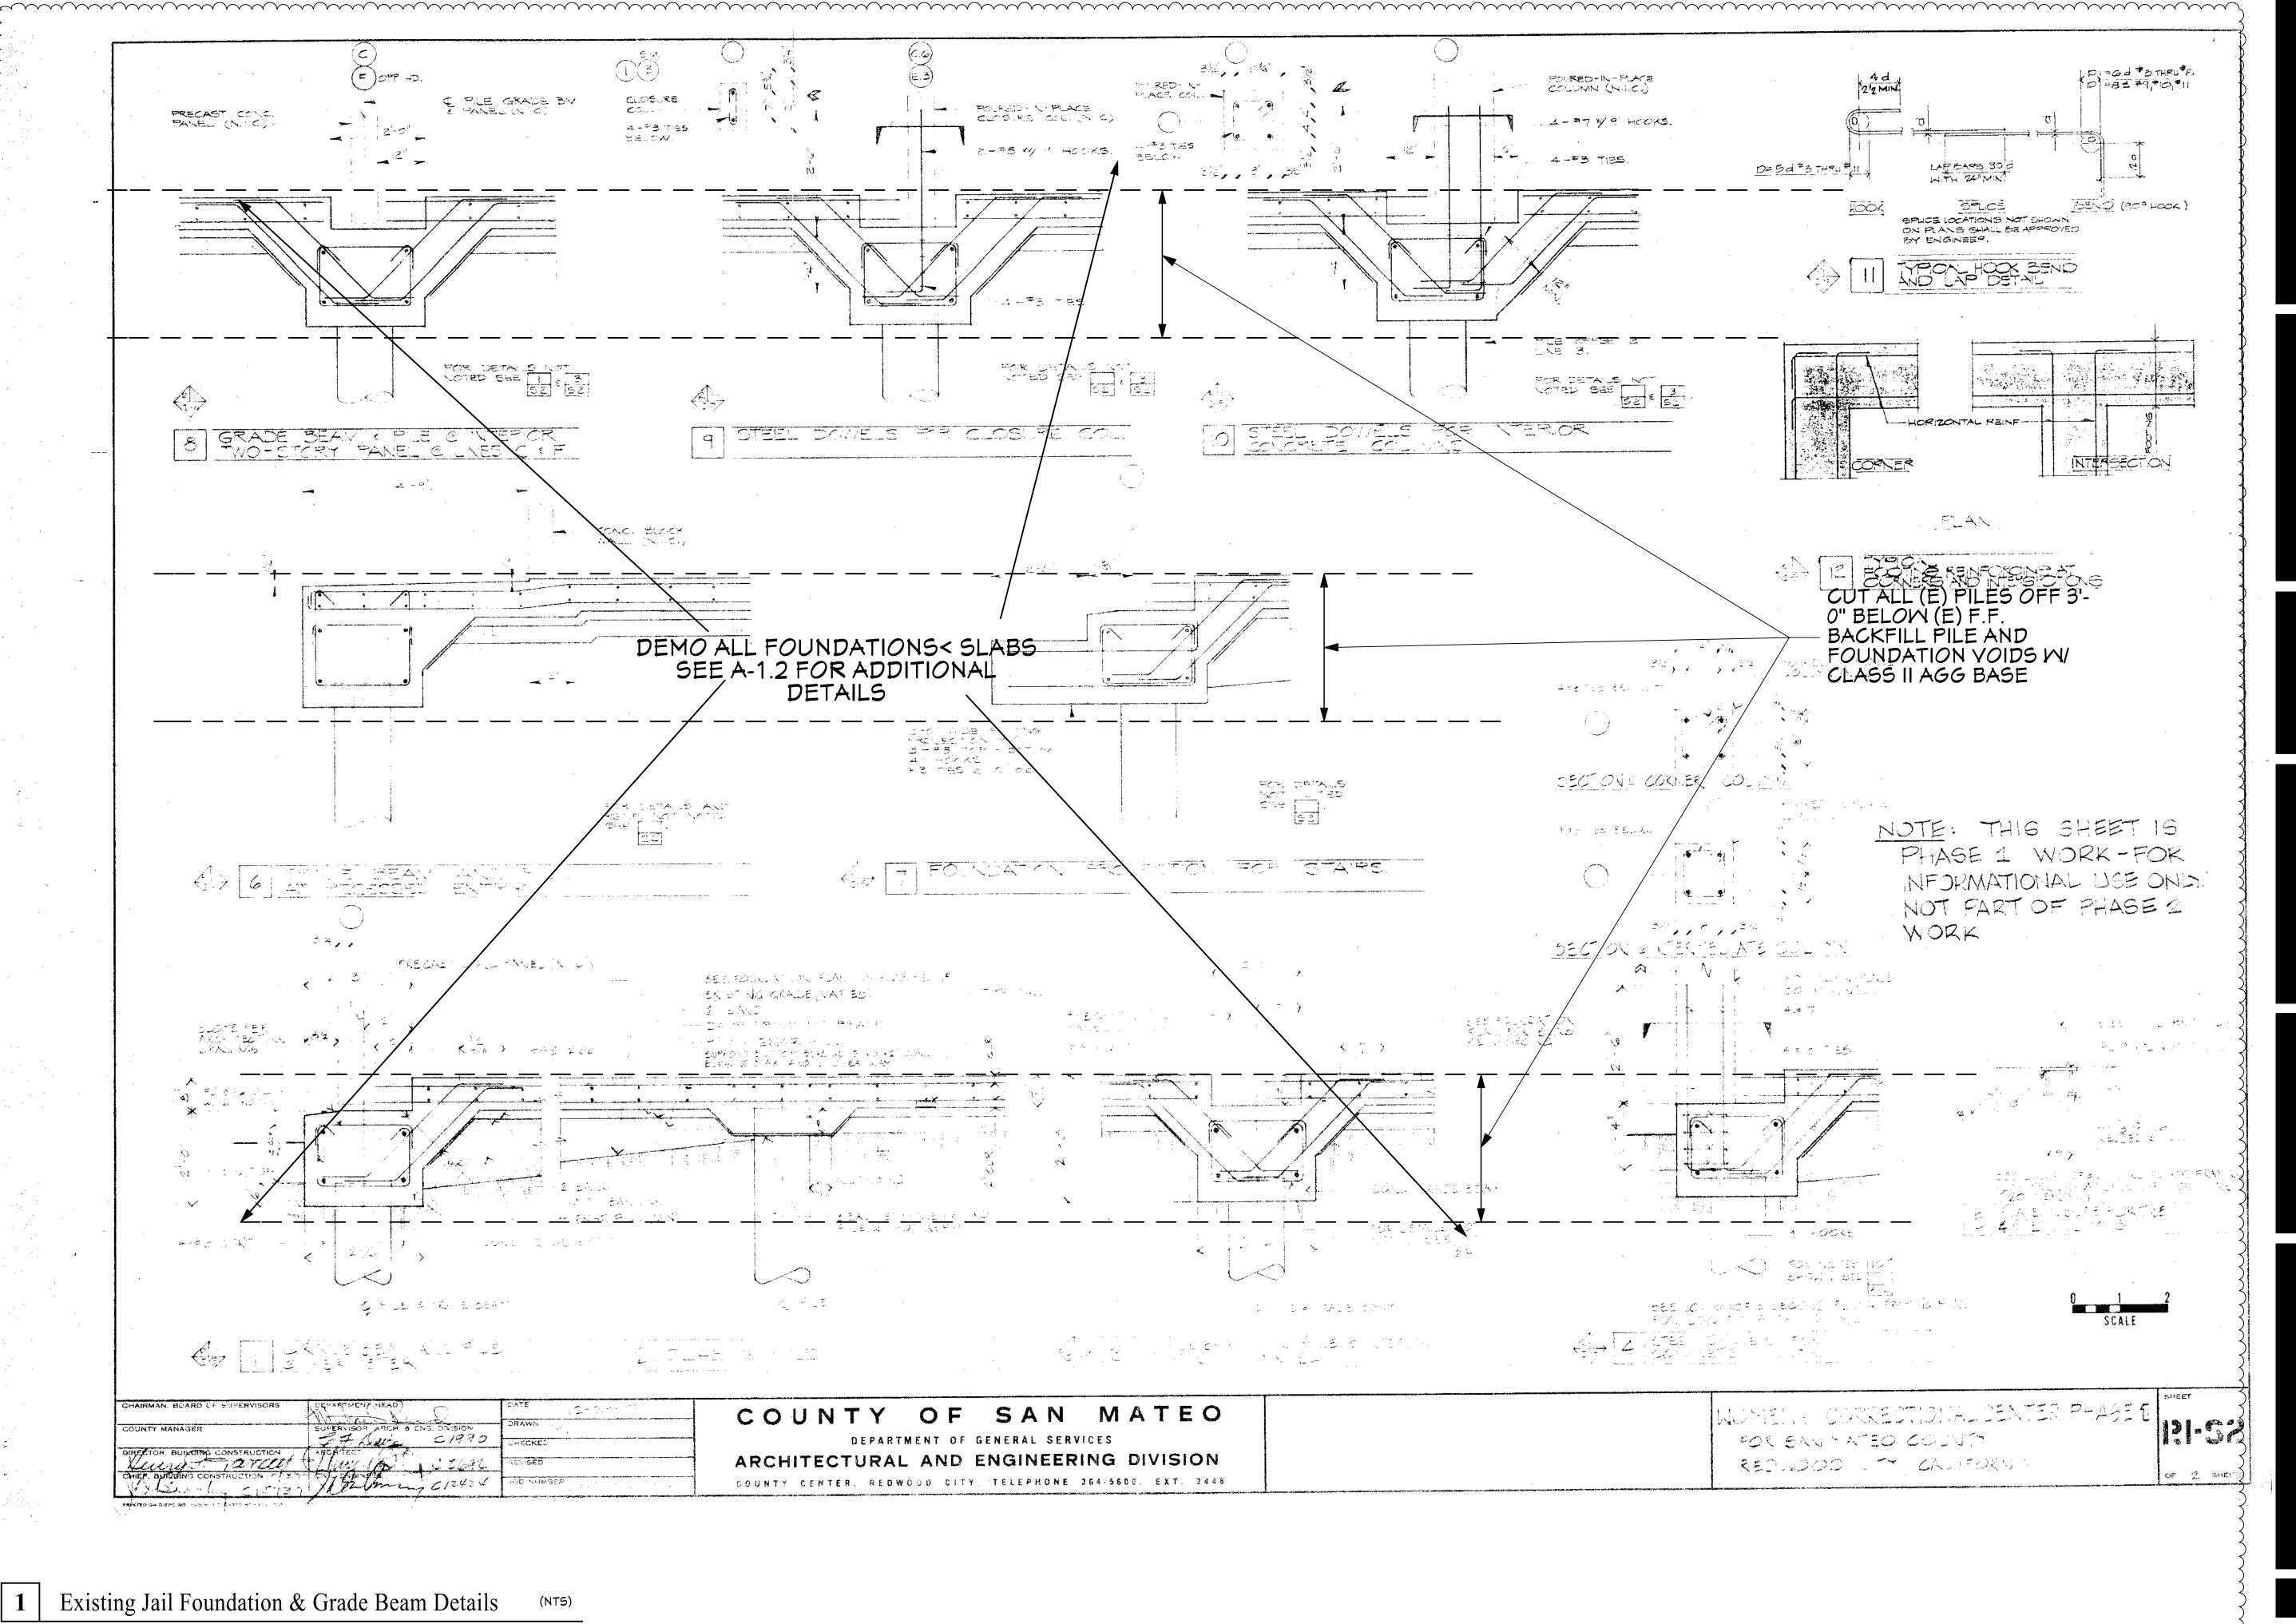

130 Portola Road, suite A Portola Valley, CA 94028 (650) 851-9335 / (Fax) 851-9337

These plans are copyrighted and are subject to copyright protection as an "architectural work" under Sec. 102 of the Copyright Act, 17 U.S.O. as amended December 1990 and known as Architectural Works Copyright Protection Act of 1990. The protection includes but is not limited to the overall form as well as the arrangement and composition of spaces and elements of the design. Under such protection, unauthorized use of these plans, work or home represented, can legally result in the cessation of construction or building being seized and /or monetary compensation to CJW Architecture.



• PROJECT •

LifeMoves Maple Street
Shelter
1580 Maple Street
Redwood City CA 94063

• SHEET TITLE •


JAIL DEMO - EXISTING FOUNDATION DETAILS


• REVISIONS •


No.	Date	Notes
_		
—		
<u></u>	9-23-2016	PC#2/ Add #6
_		


• JOB: 2015.2801

• DATE: 6/17/2016

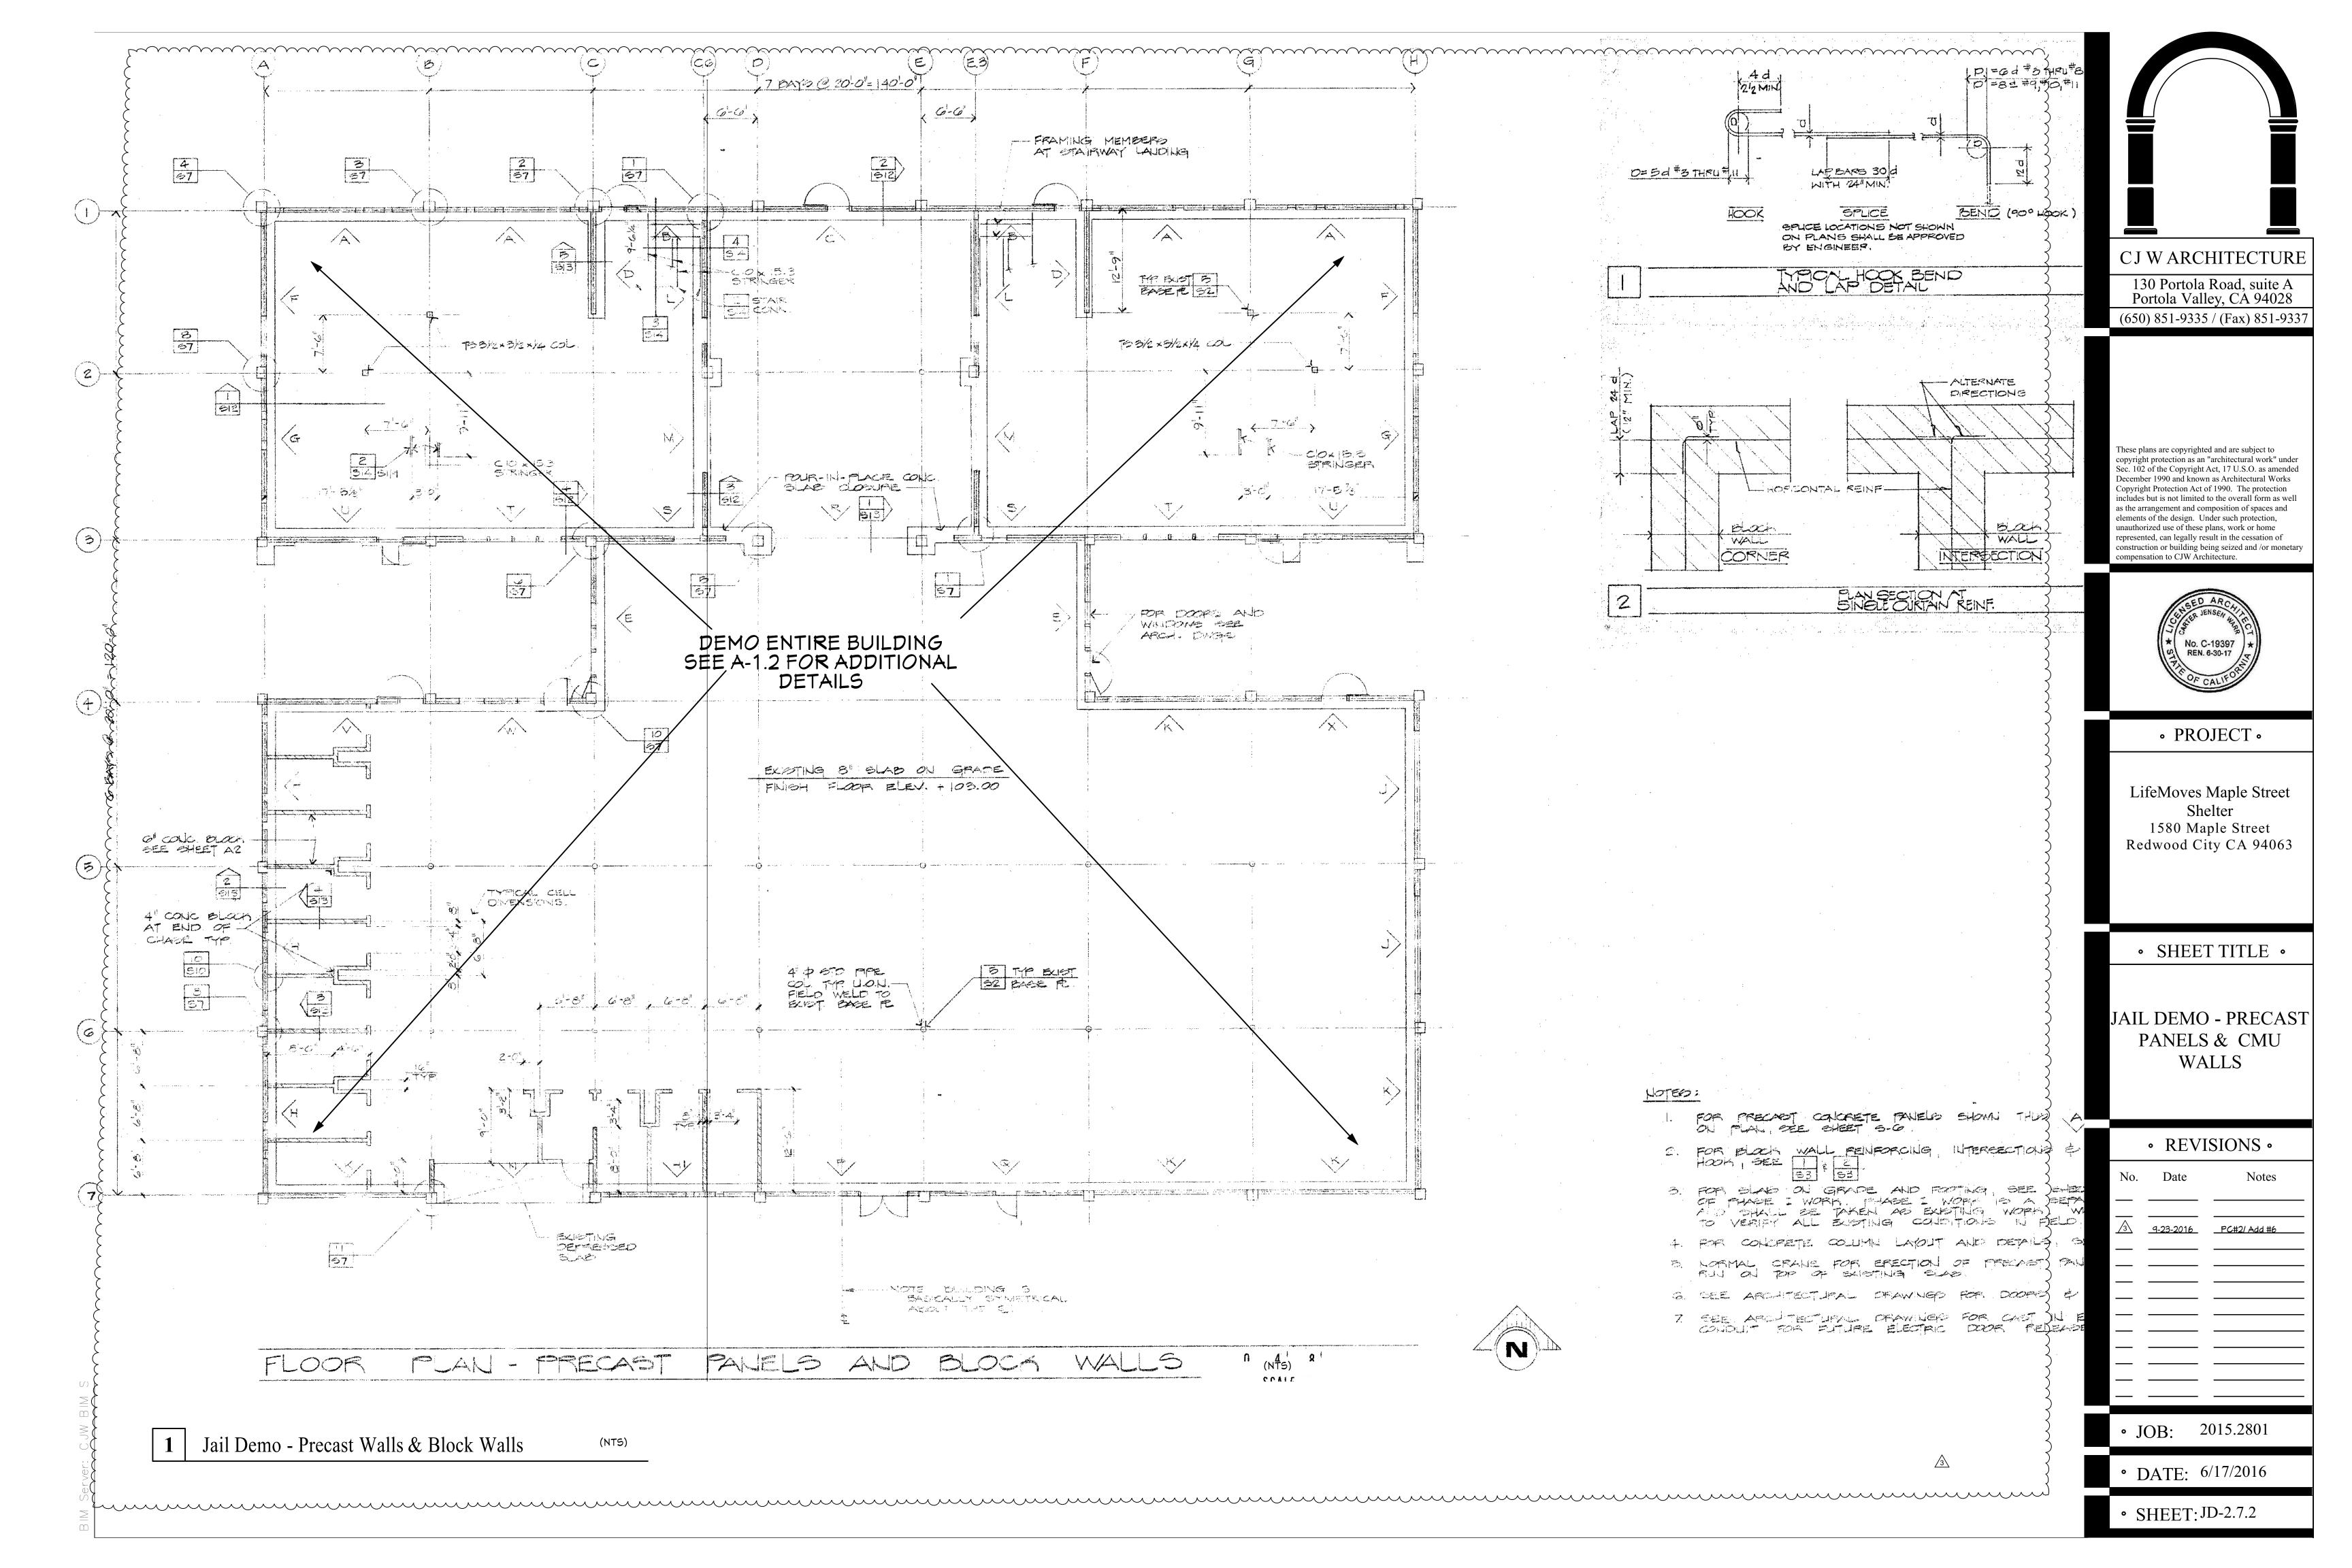

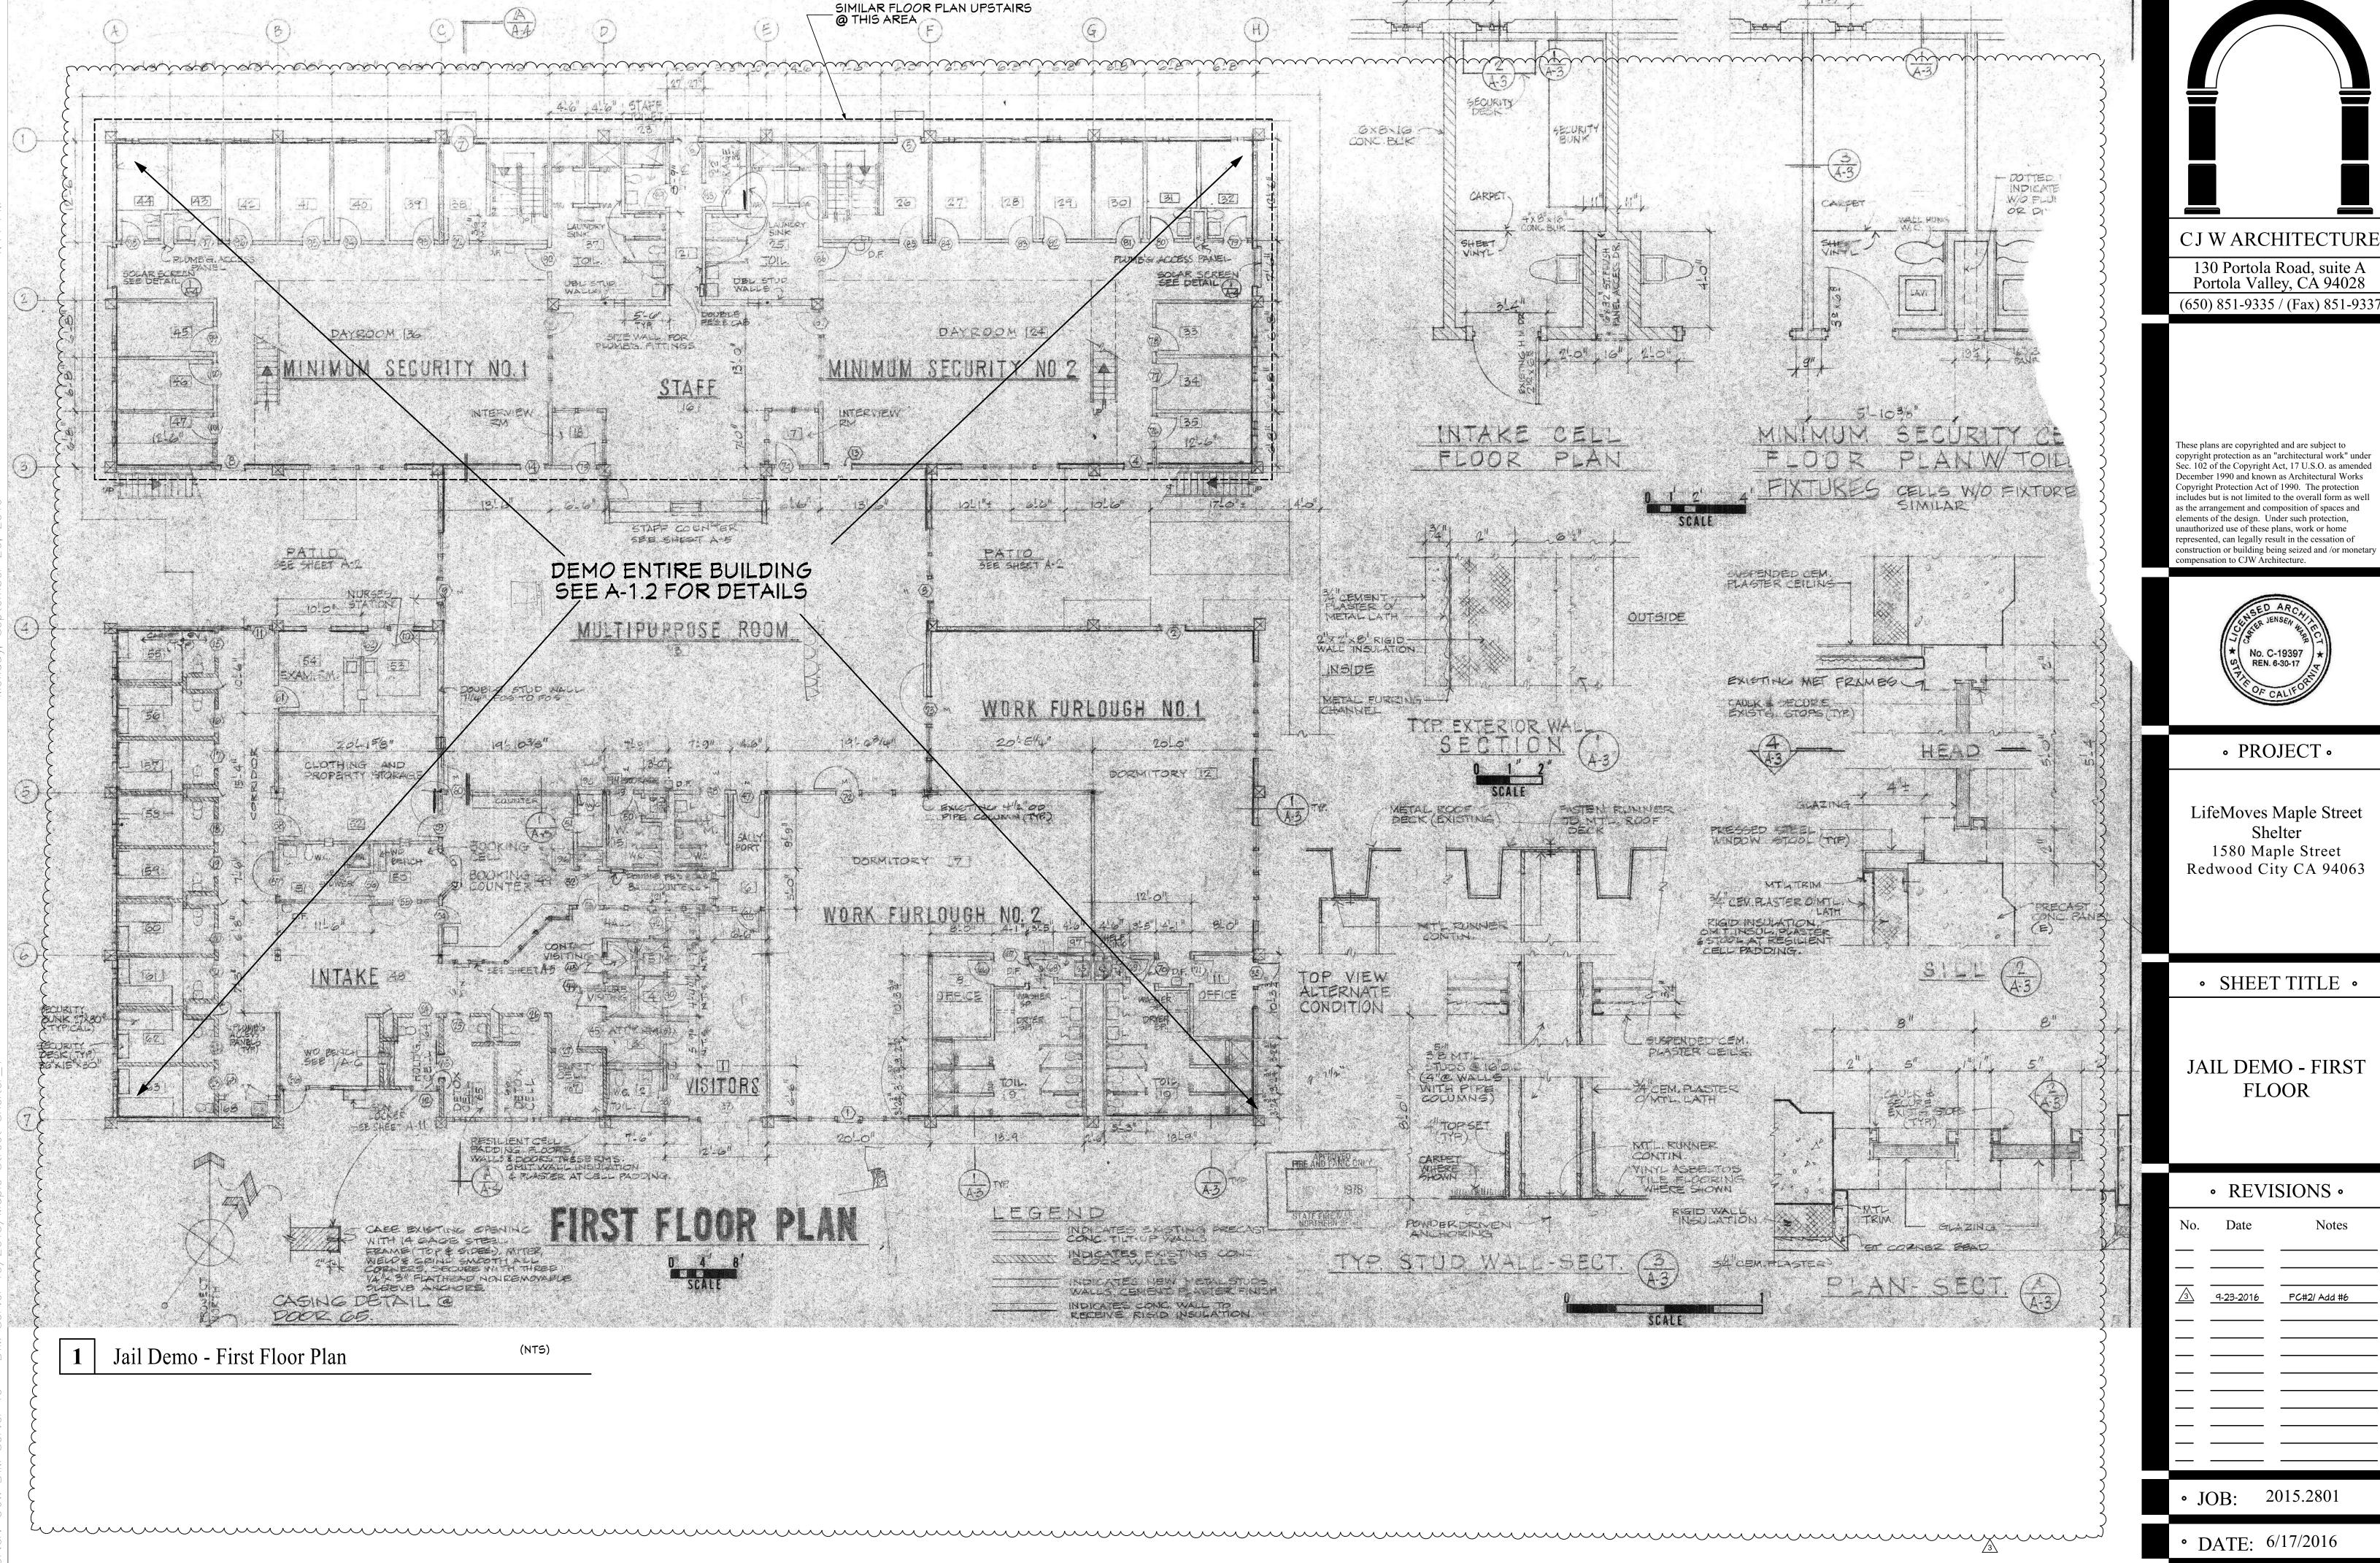

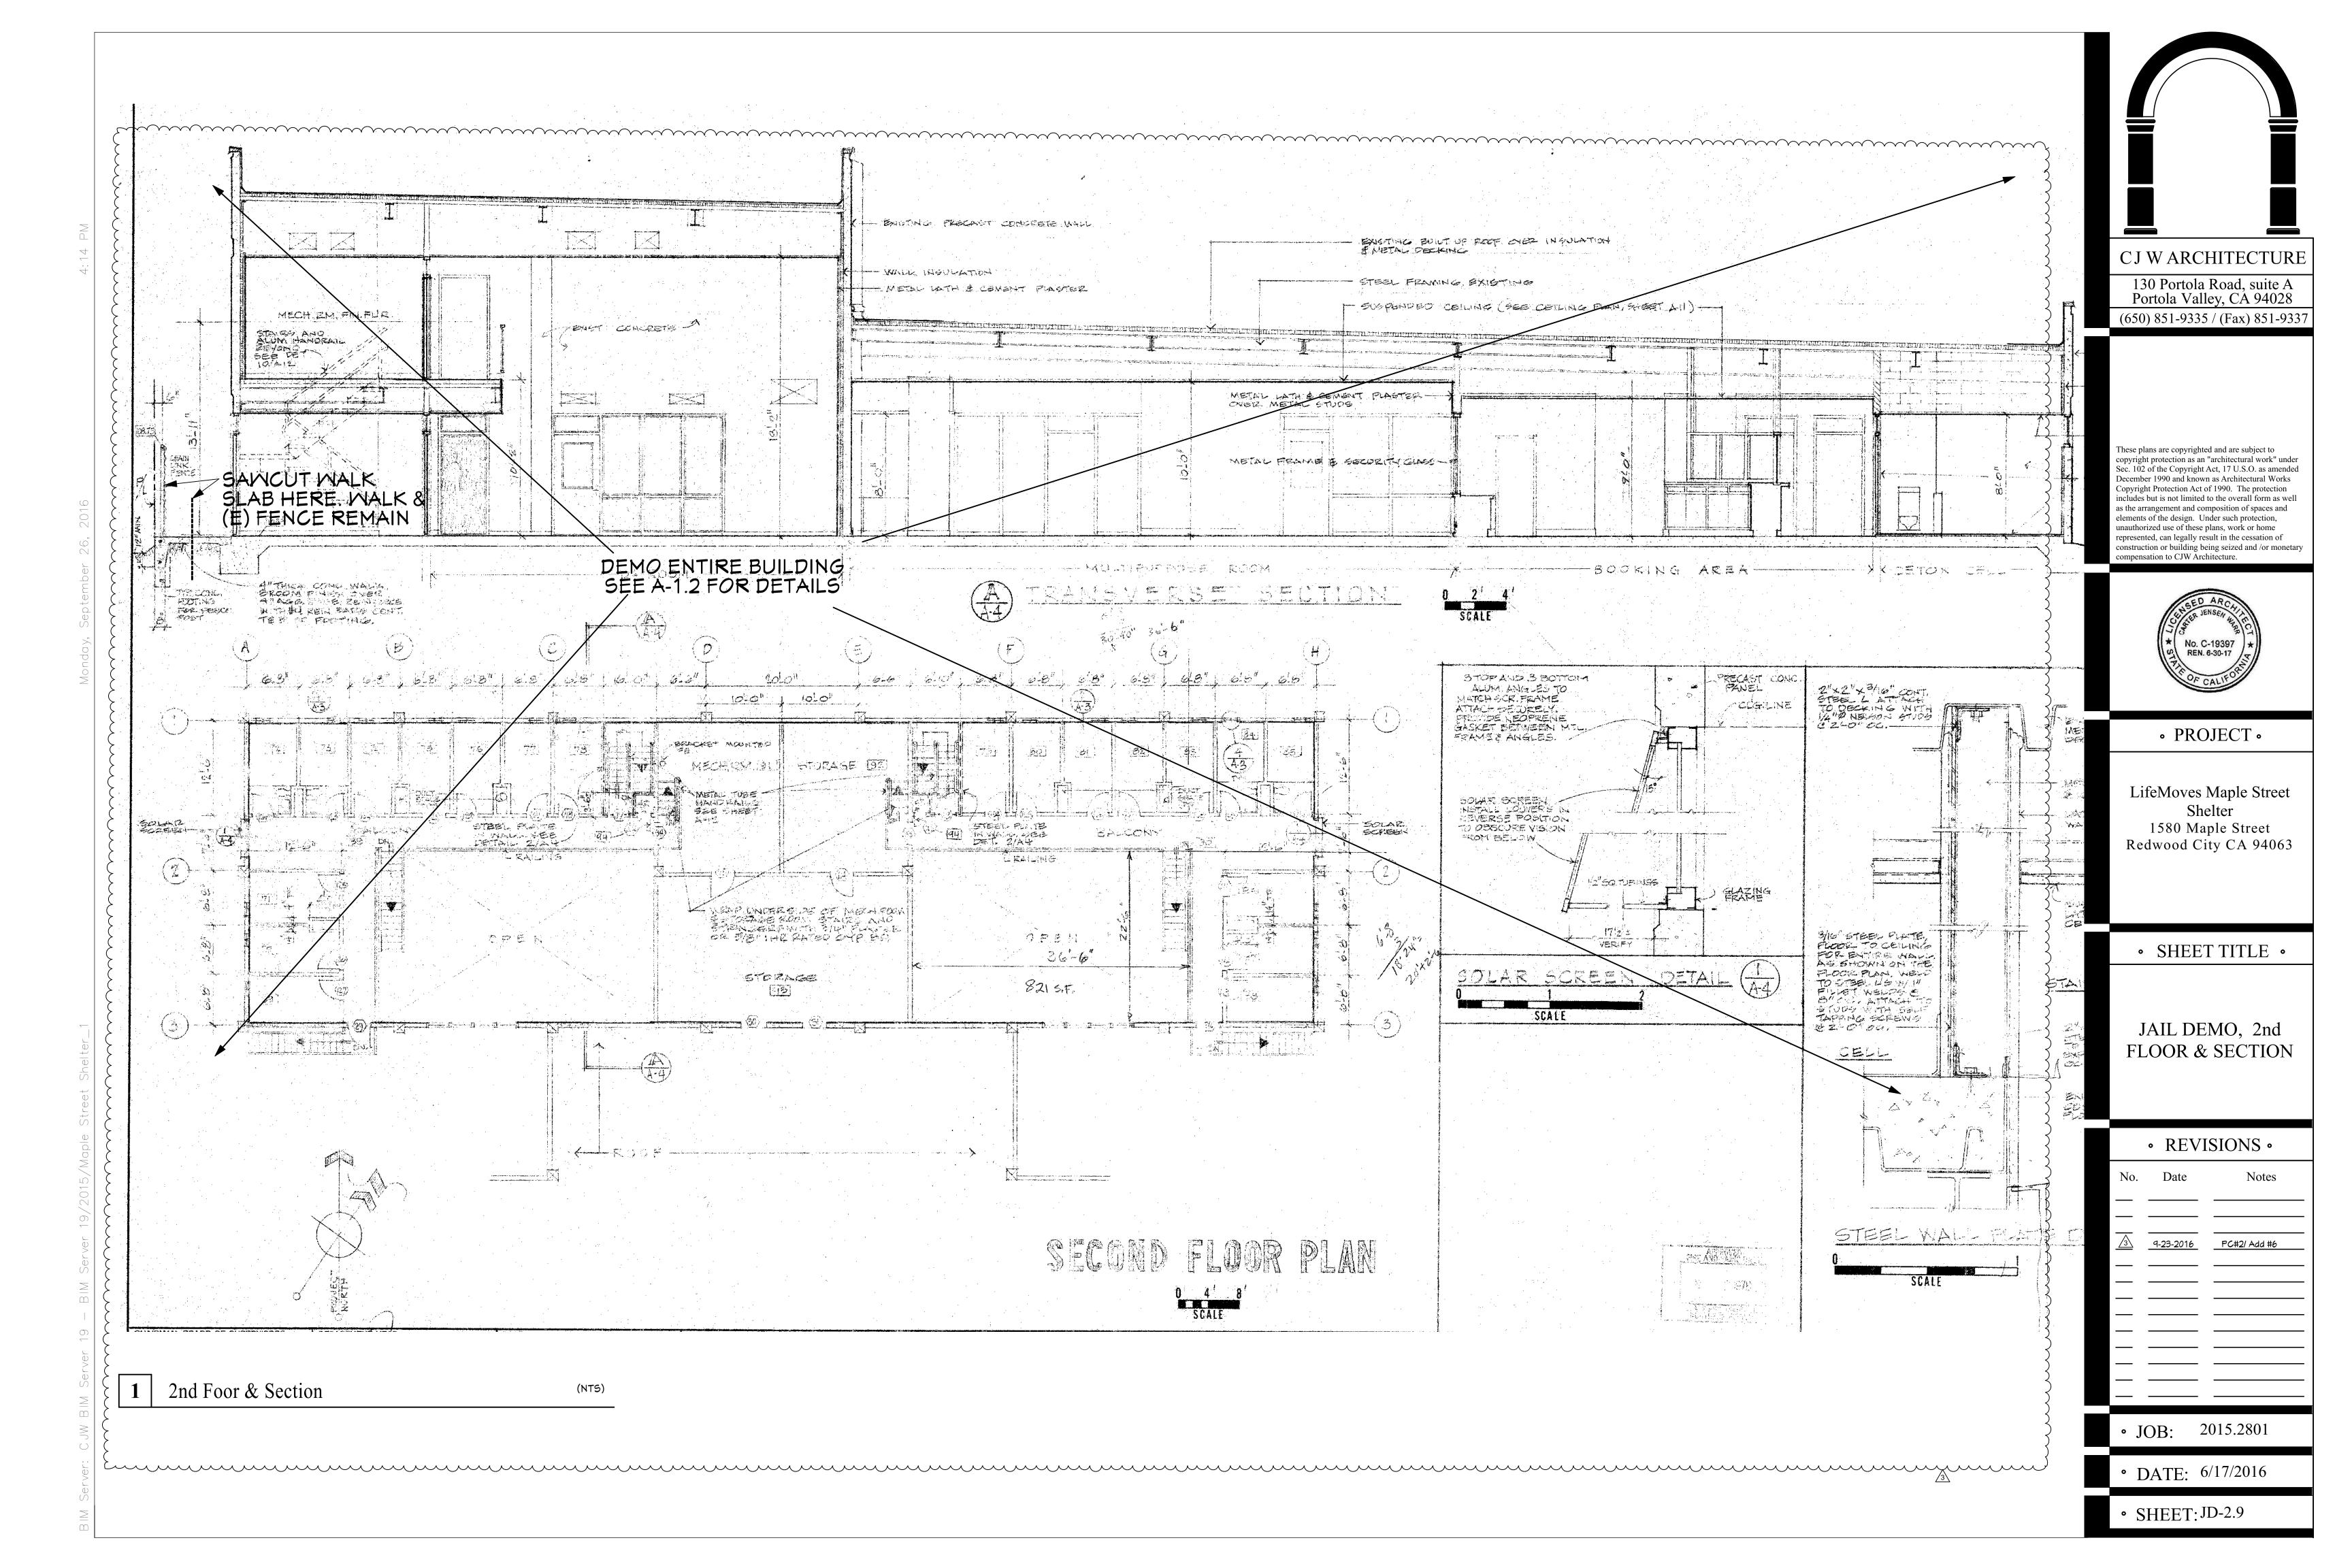

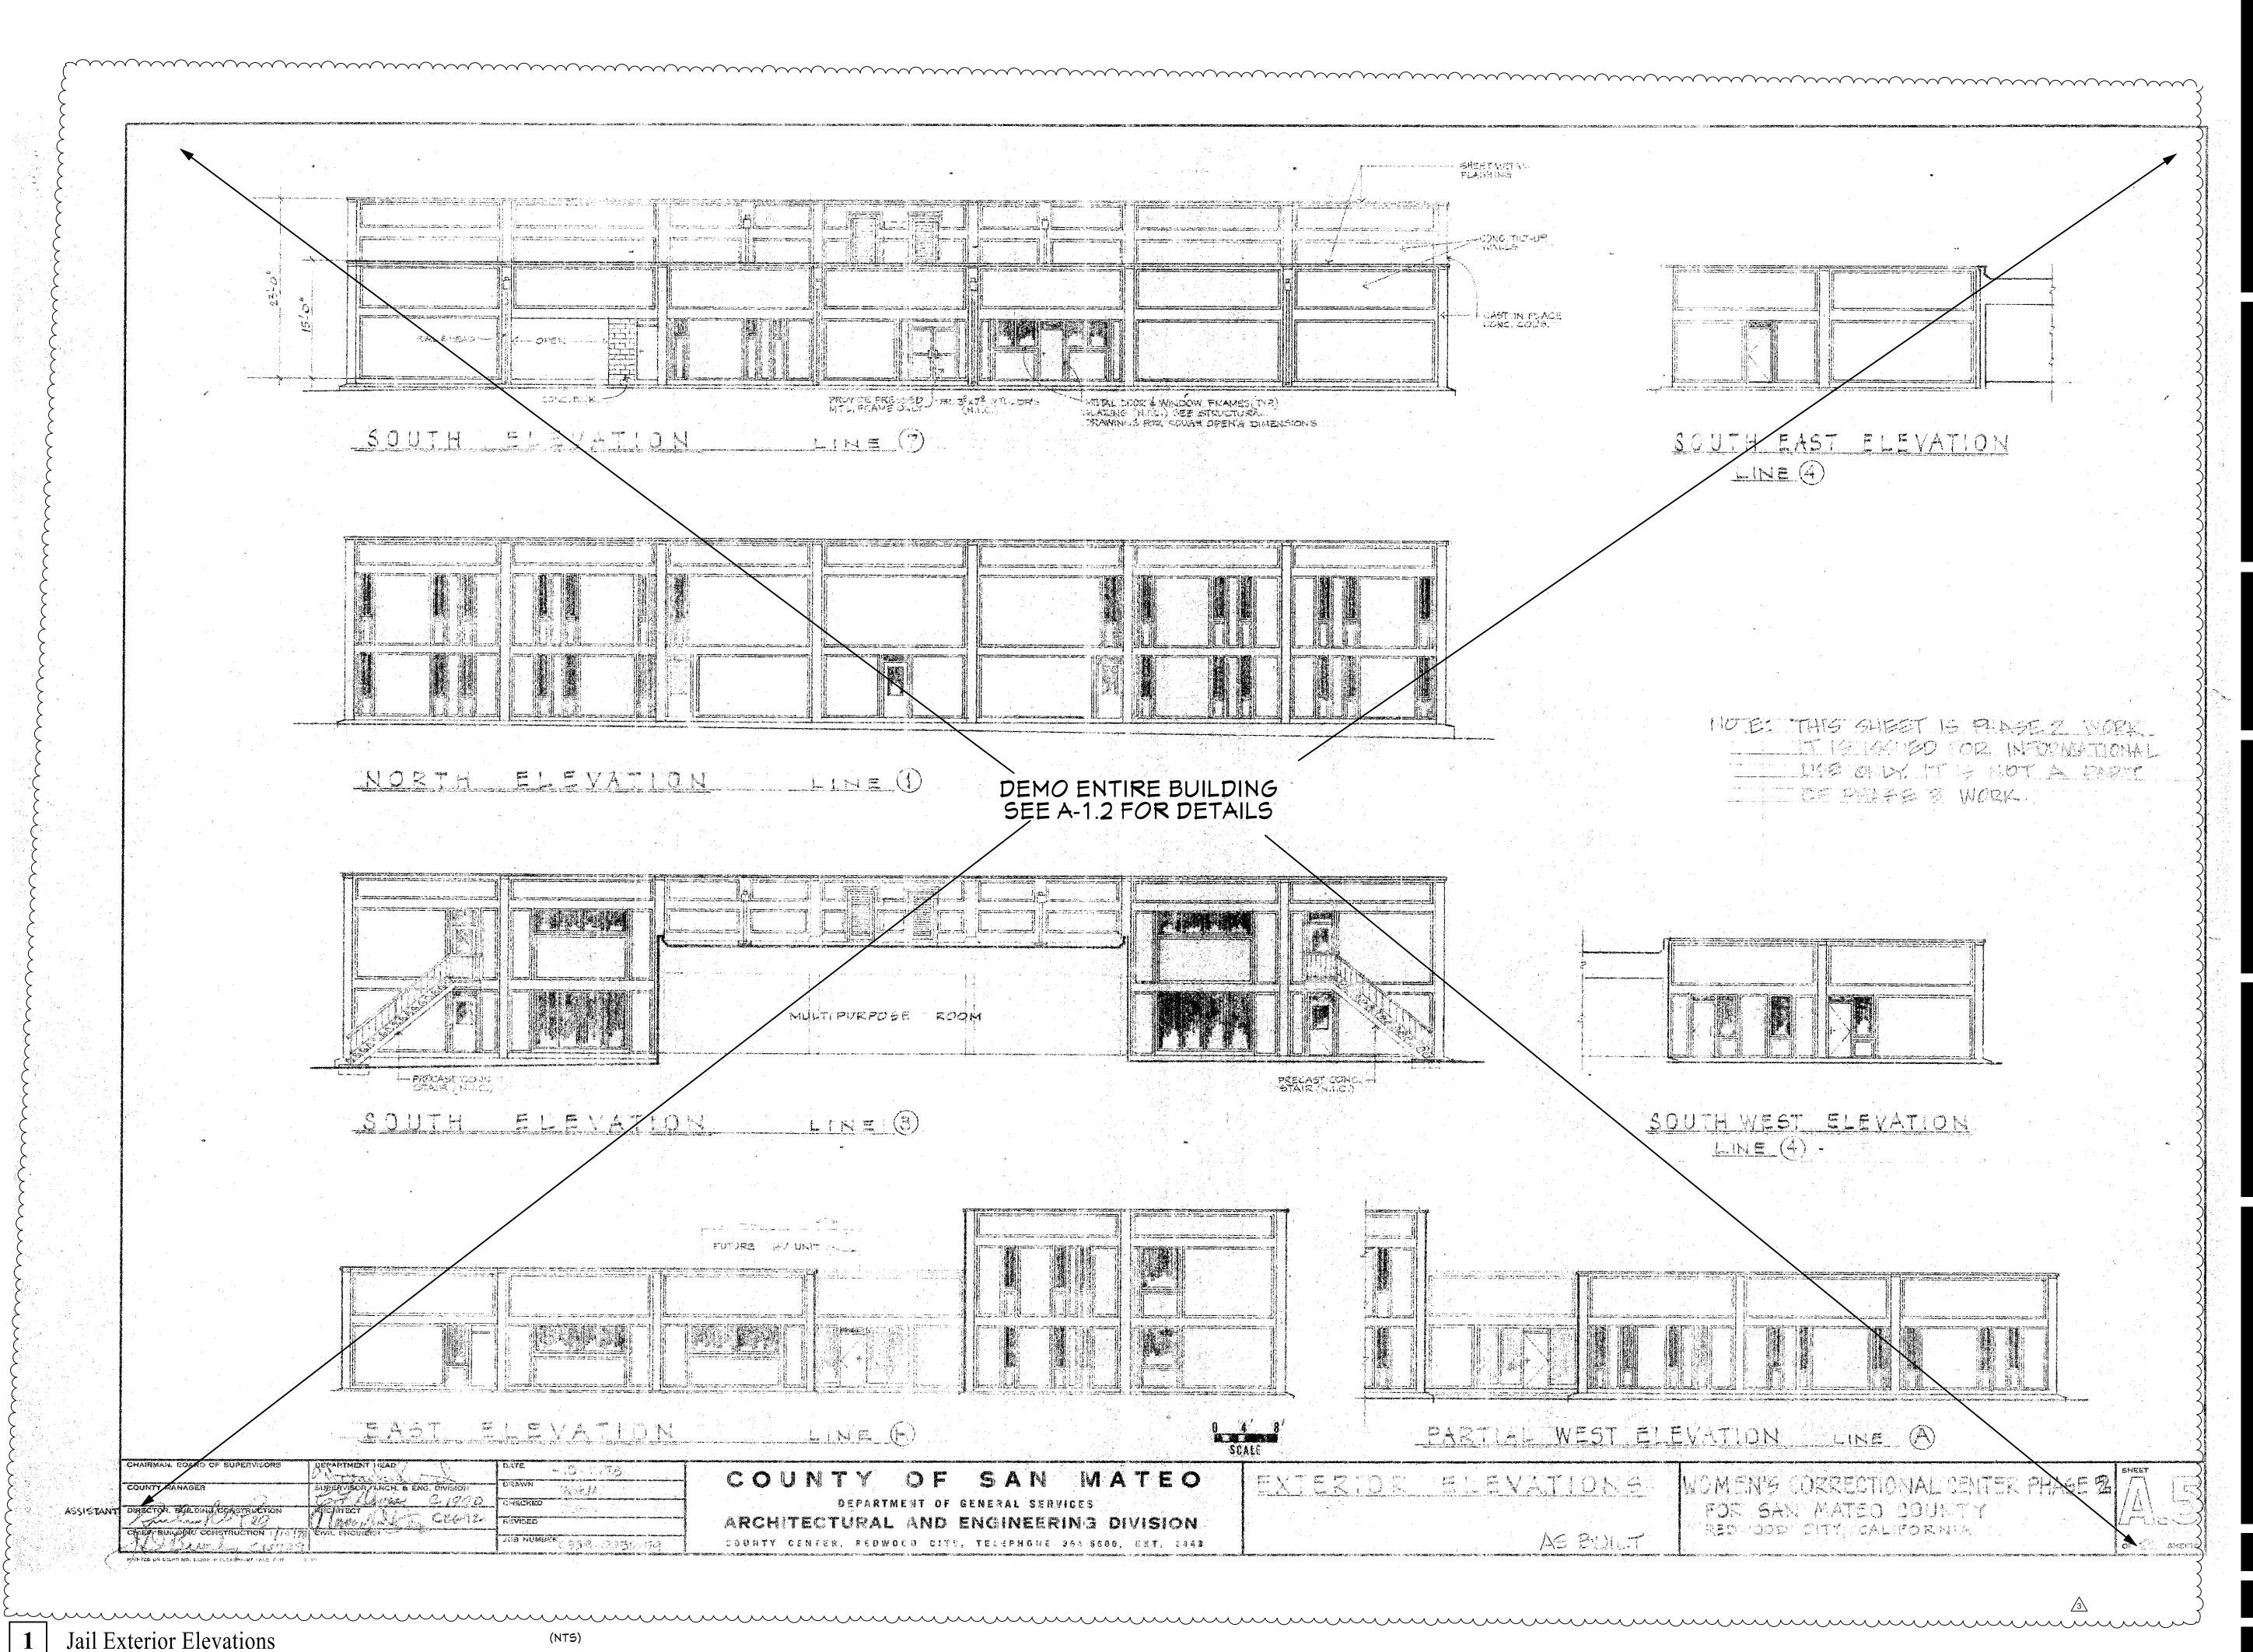

130 Portola Road, suite A Portola Valley, CA 94028 (650) 851-9335 / (Fax) 851-9337

These plans are copyrighted and are subject to copyright protection as an "architectural work" under Sec. 102 of the Copyright Act, 17 U.S.O. as amended December 1990 and known as Architectural Works Copyright Protection Act of 1990. The protection includes but is not limited to the overall form as well as the arrangement and composition of spaces and elements of the design. Under such protection, unauthorized use of these plans, work or home represented, can legally result in the cessation of construction or building being seized and /or monetary compensation to CJW Architecture.



• PROJECT •

LifeMoves Maple Street
Shelter
1580 Maple Street
Redwood City CA 94063

• SHEET TITLE •


JAIL DEMO -EXTERIOR ELEVATIONS


• REVISIONS •


No. Date Notes			
9-23-2016 PC#2/ Add #6	No.	Date	Notes
9-23-2016 PC#2/ Add #6	_		
	3	9-23-2016	PC#2/ Add #6
	_		
	_		
	—		
	_		
			-

• JOB: 2015.2801

• DATE: 6/17/2016

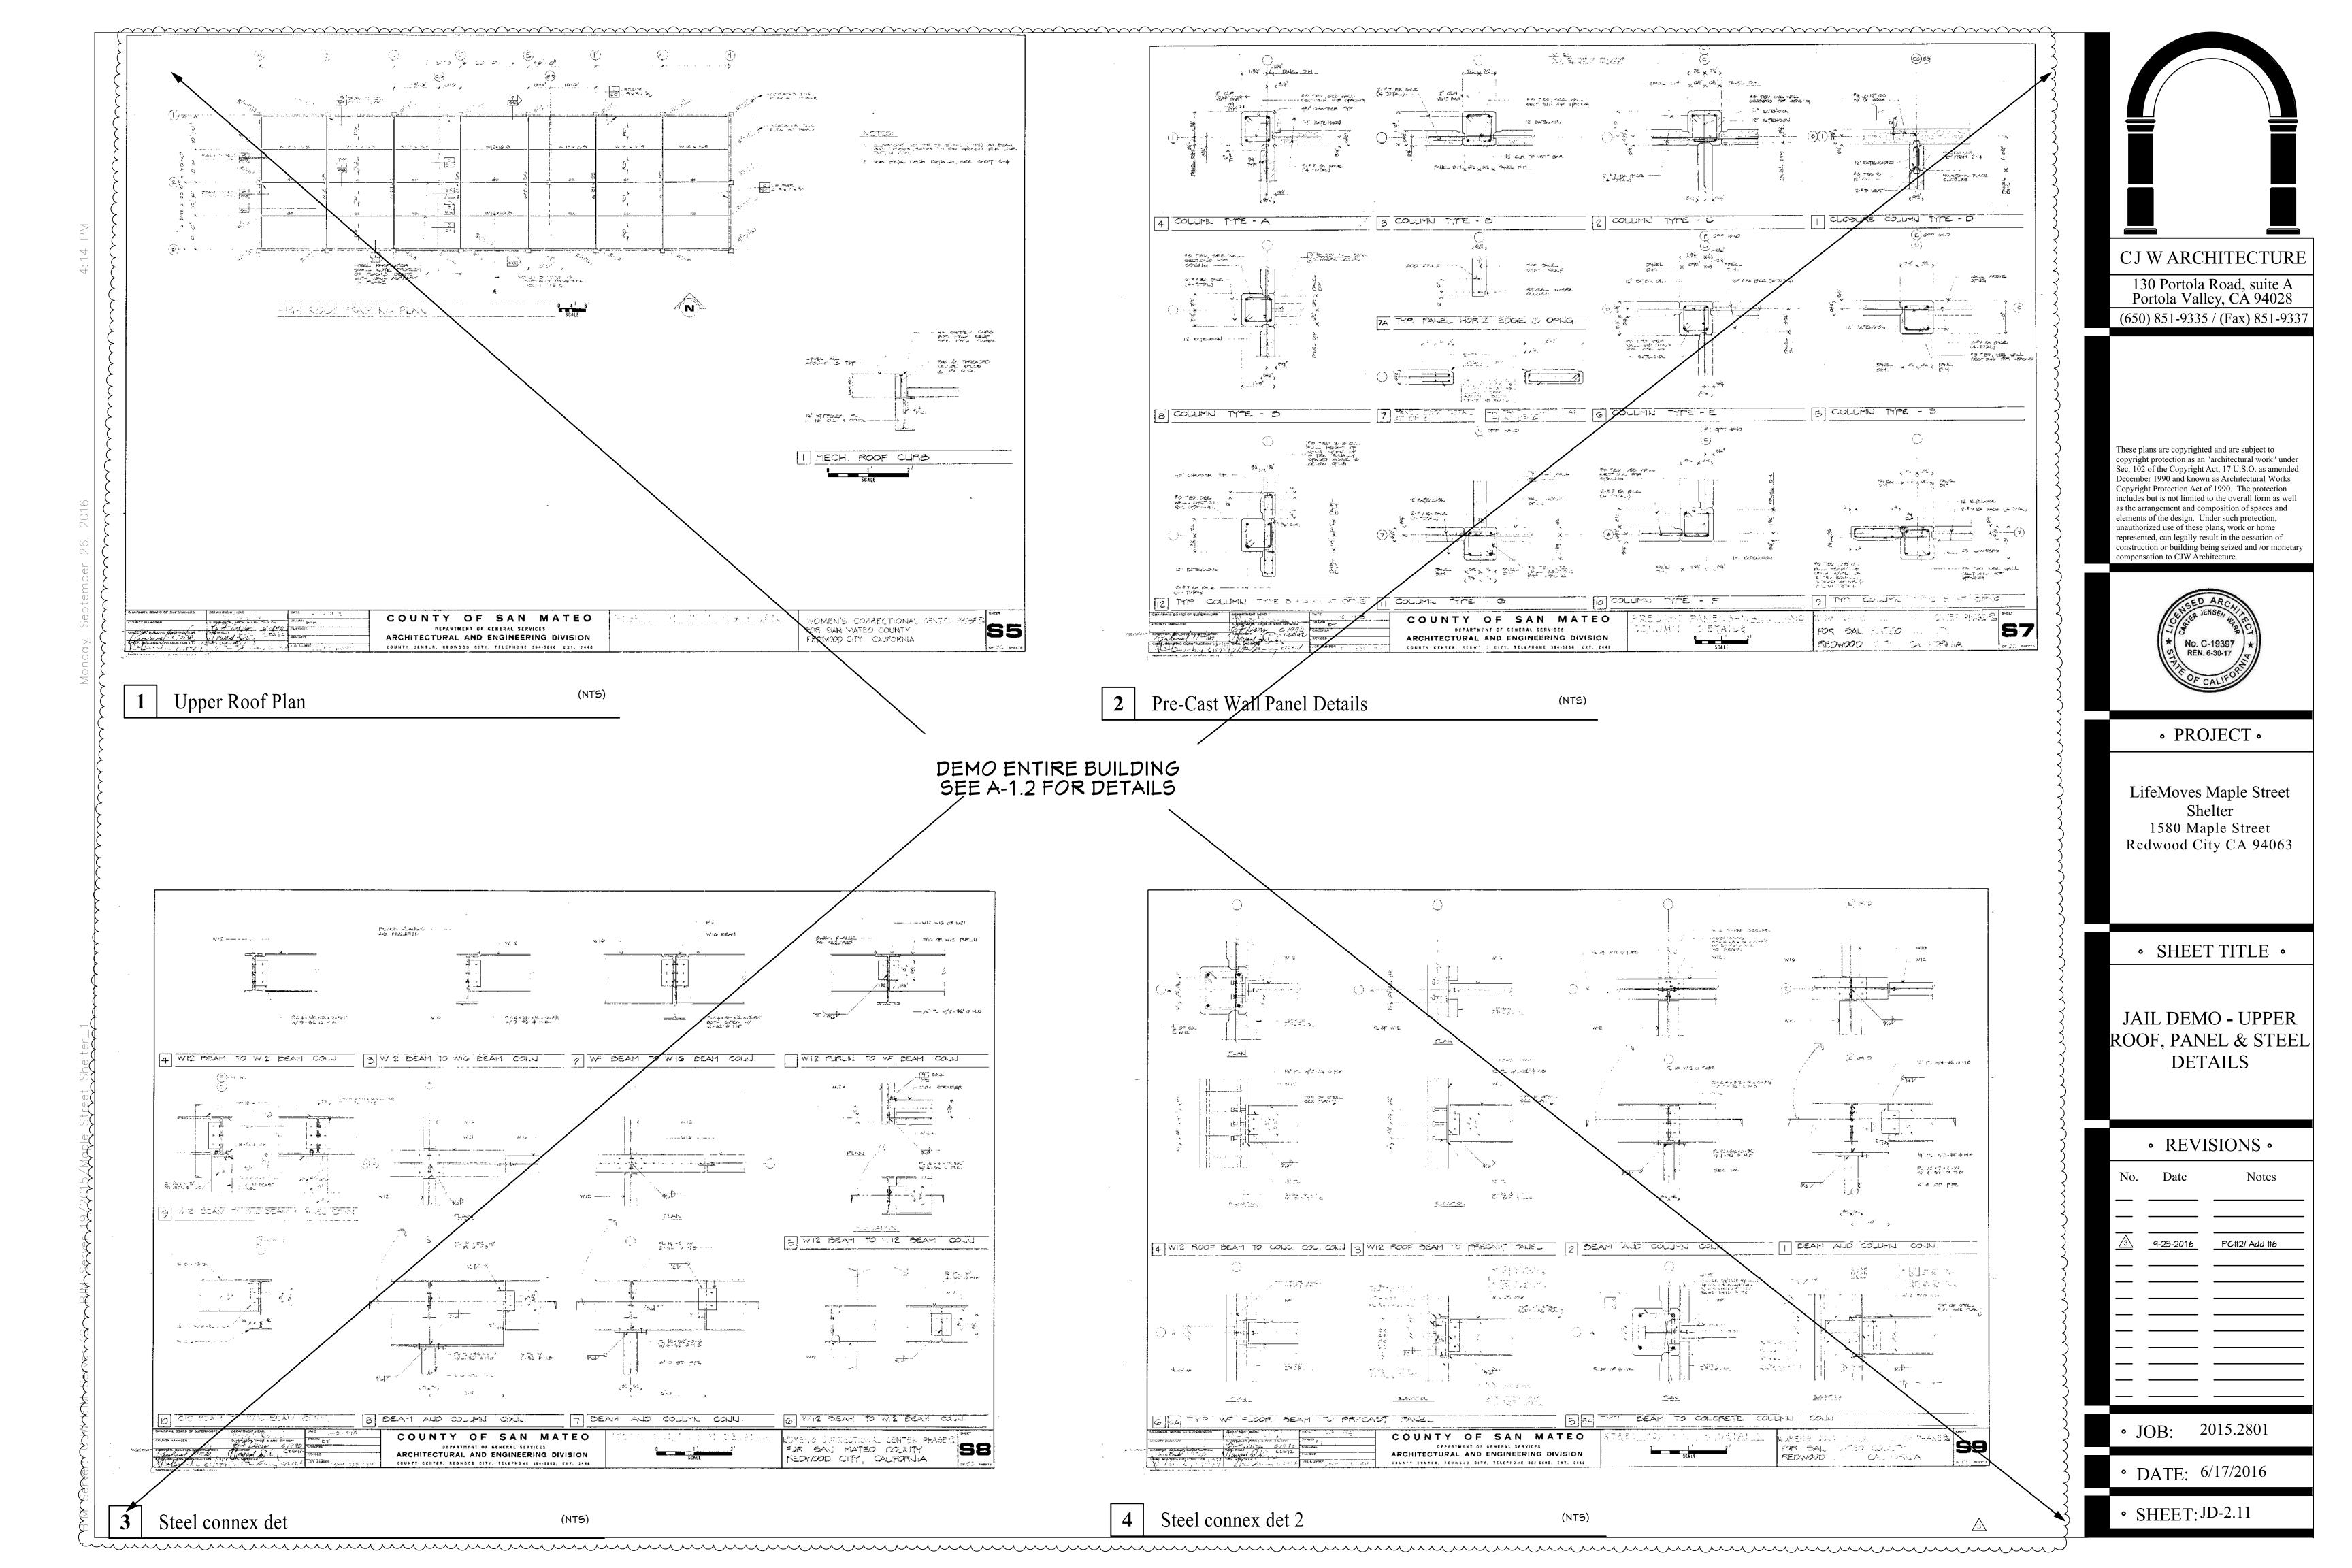

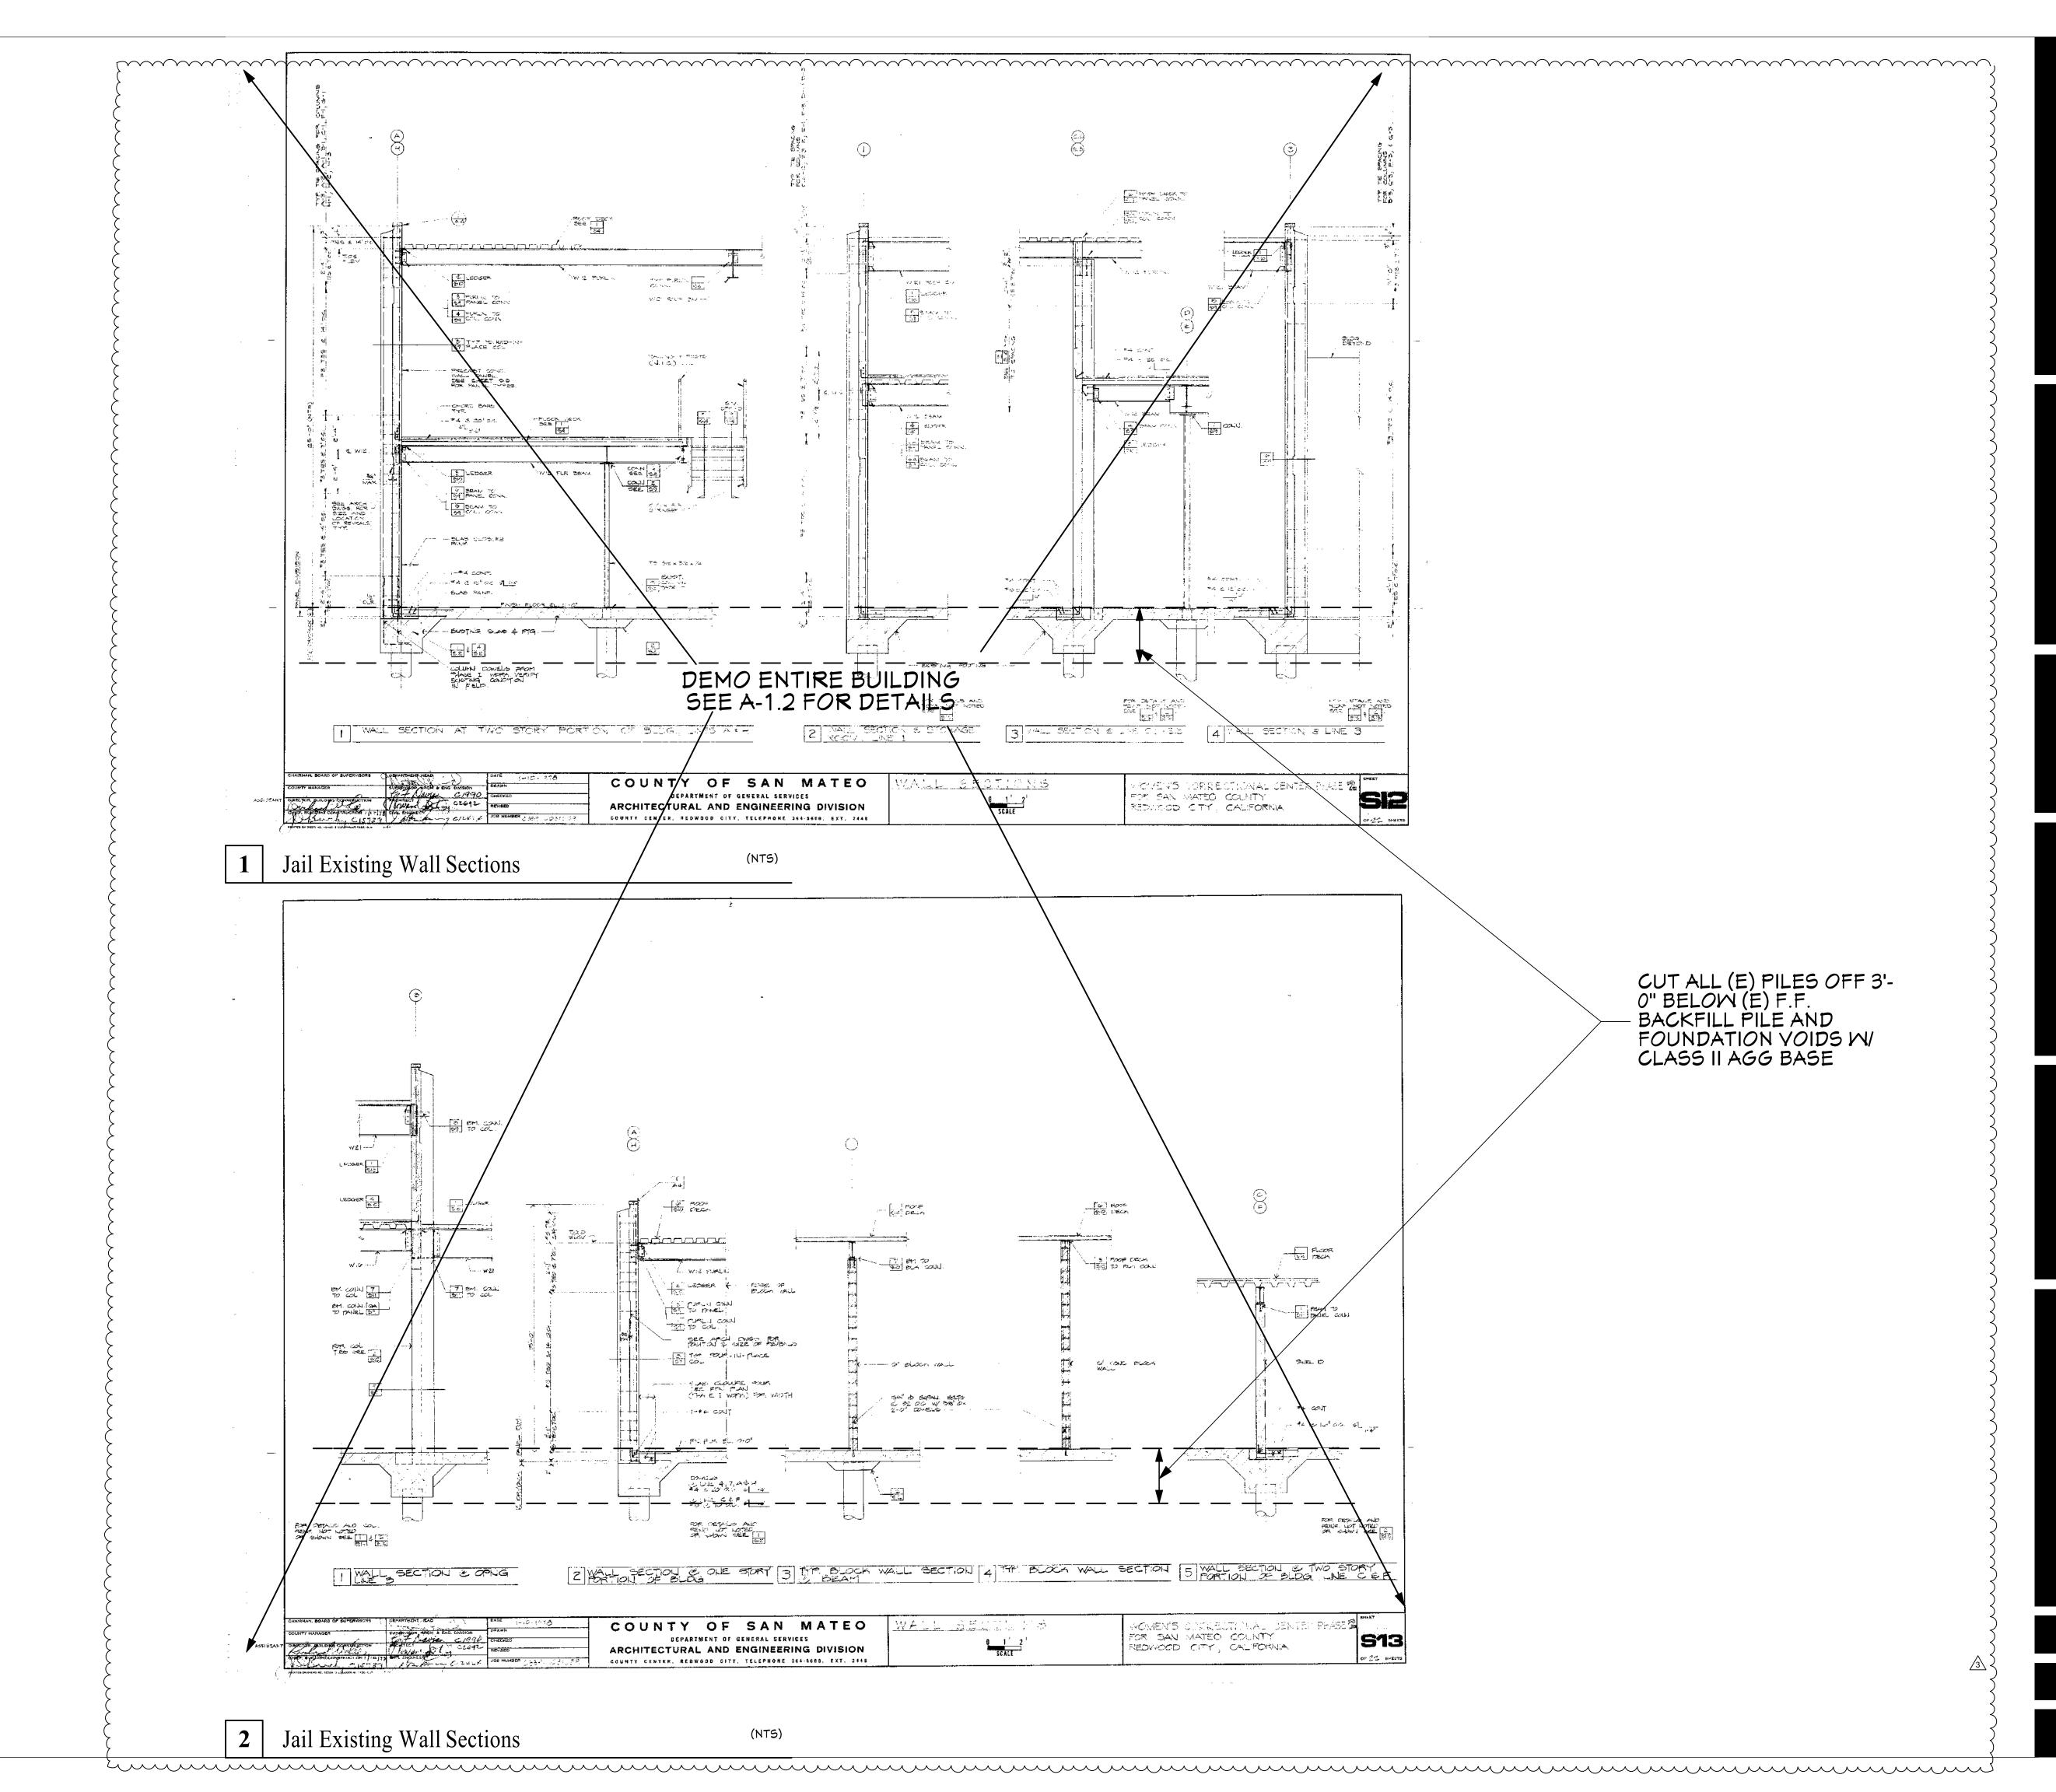

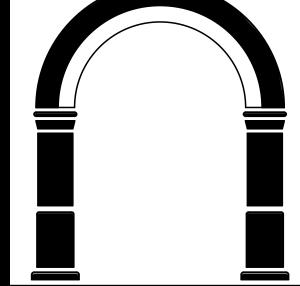

130 Portola Road, suite A Portola Valley, CA 94028 (650) 851-9335 / (Fax) 851-9337

These plans are copyrighted and are subject to copyright protection as an "architectural work" under Sec. 102 of the Copyright Act, 17 U.S.O. as amended December 1990 and known as Architectural Works Copyright Protection Act of 1990. The protection includes but is not limited to the overall form as well as the arrangement and composition of spaces and elements of the design. Under such protection, unauthorized use of these plans, work or home represented, can legally result in the cessation of construction or building being seized and /or monetary compensation to CJW Architecture.



• PROJECT •

LifeMoves Maple Street
Shelter
1580 Maple Street
Redwood City CA 94063


• SHEET TITLE •

JAIL DEMO - MISC STRUCT WALL SECTIONS & DETAILS

• REVISIONS •						
No.	Date	Notes				
—						
—						
<u></u>	9-23-2016	PC#2/ Add #6				
—						
—						
_						
—						

• JOB: 2015.2801

• DATE: 6/17/2016

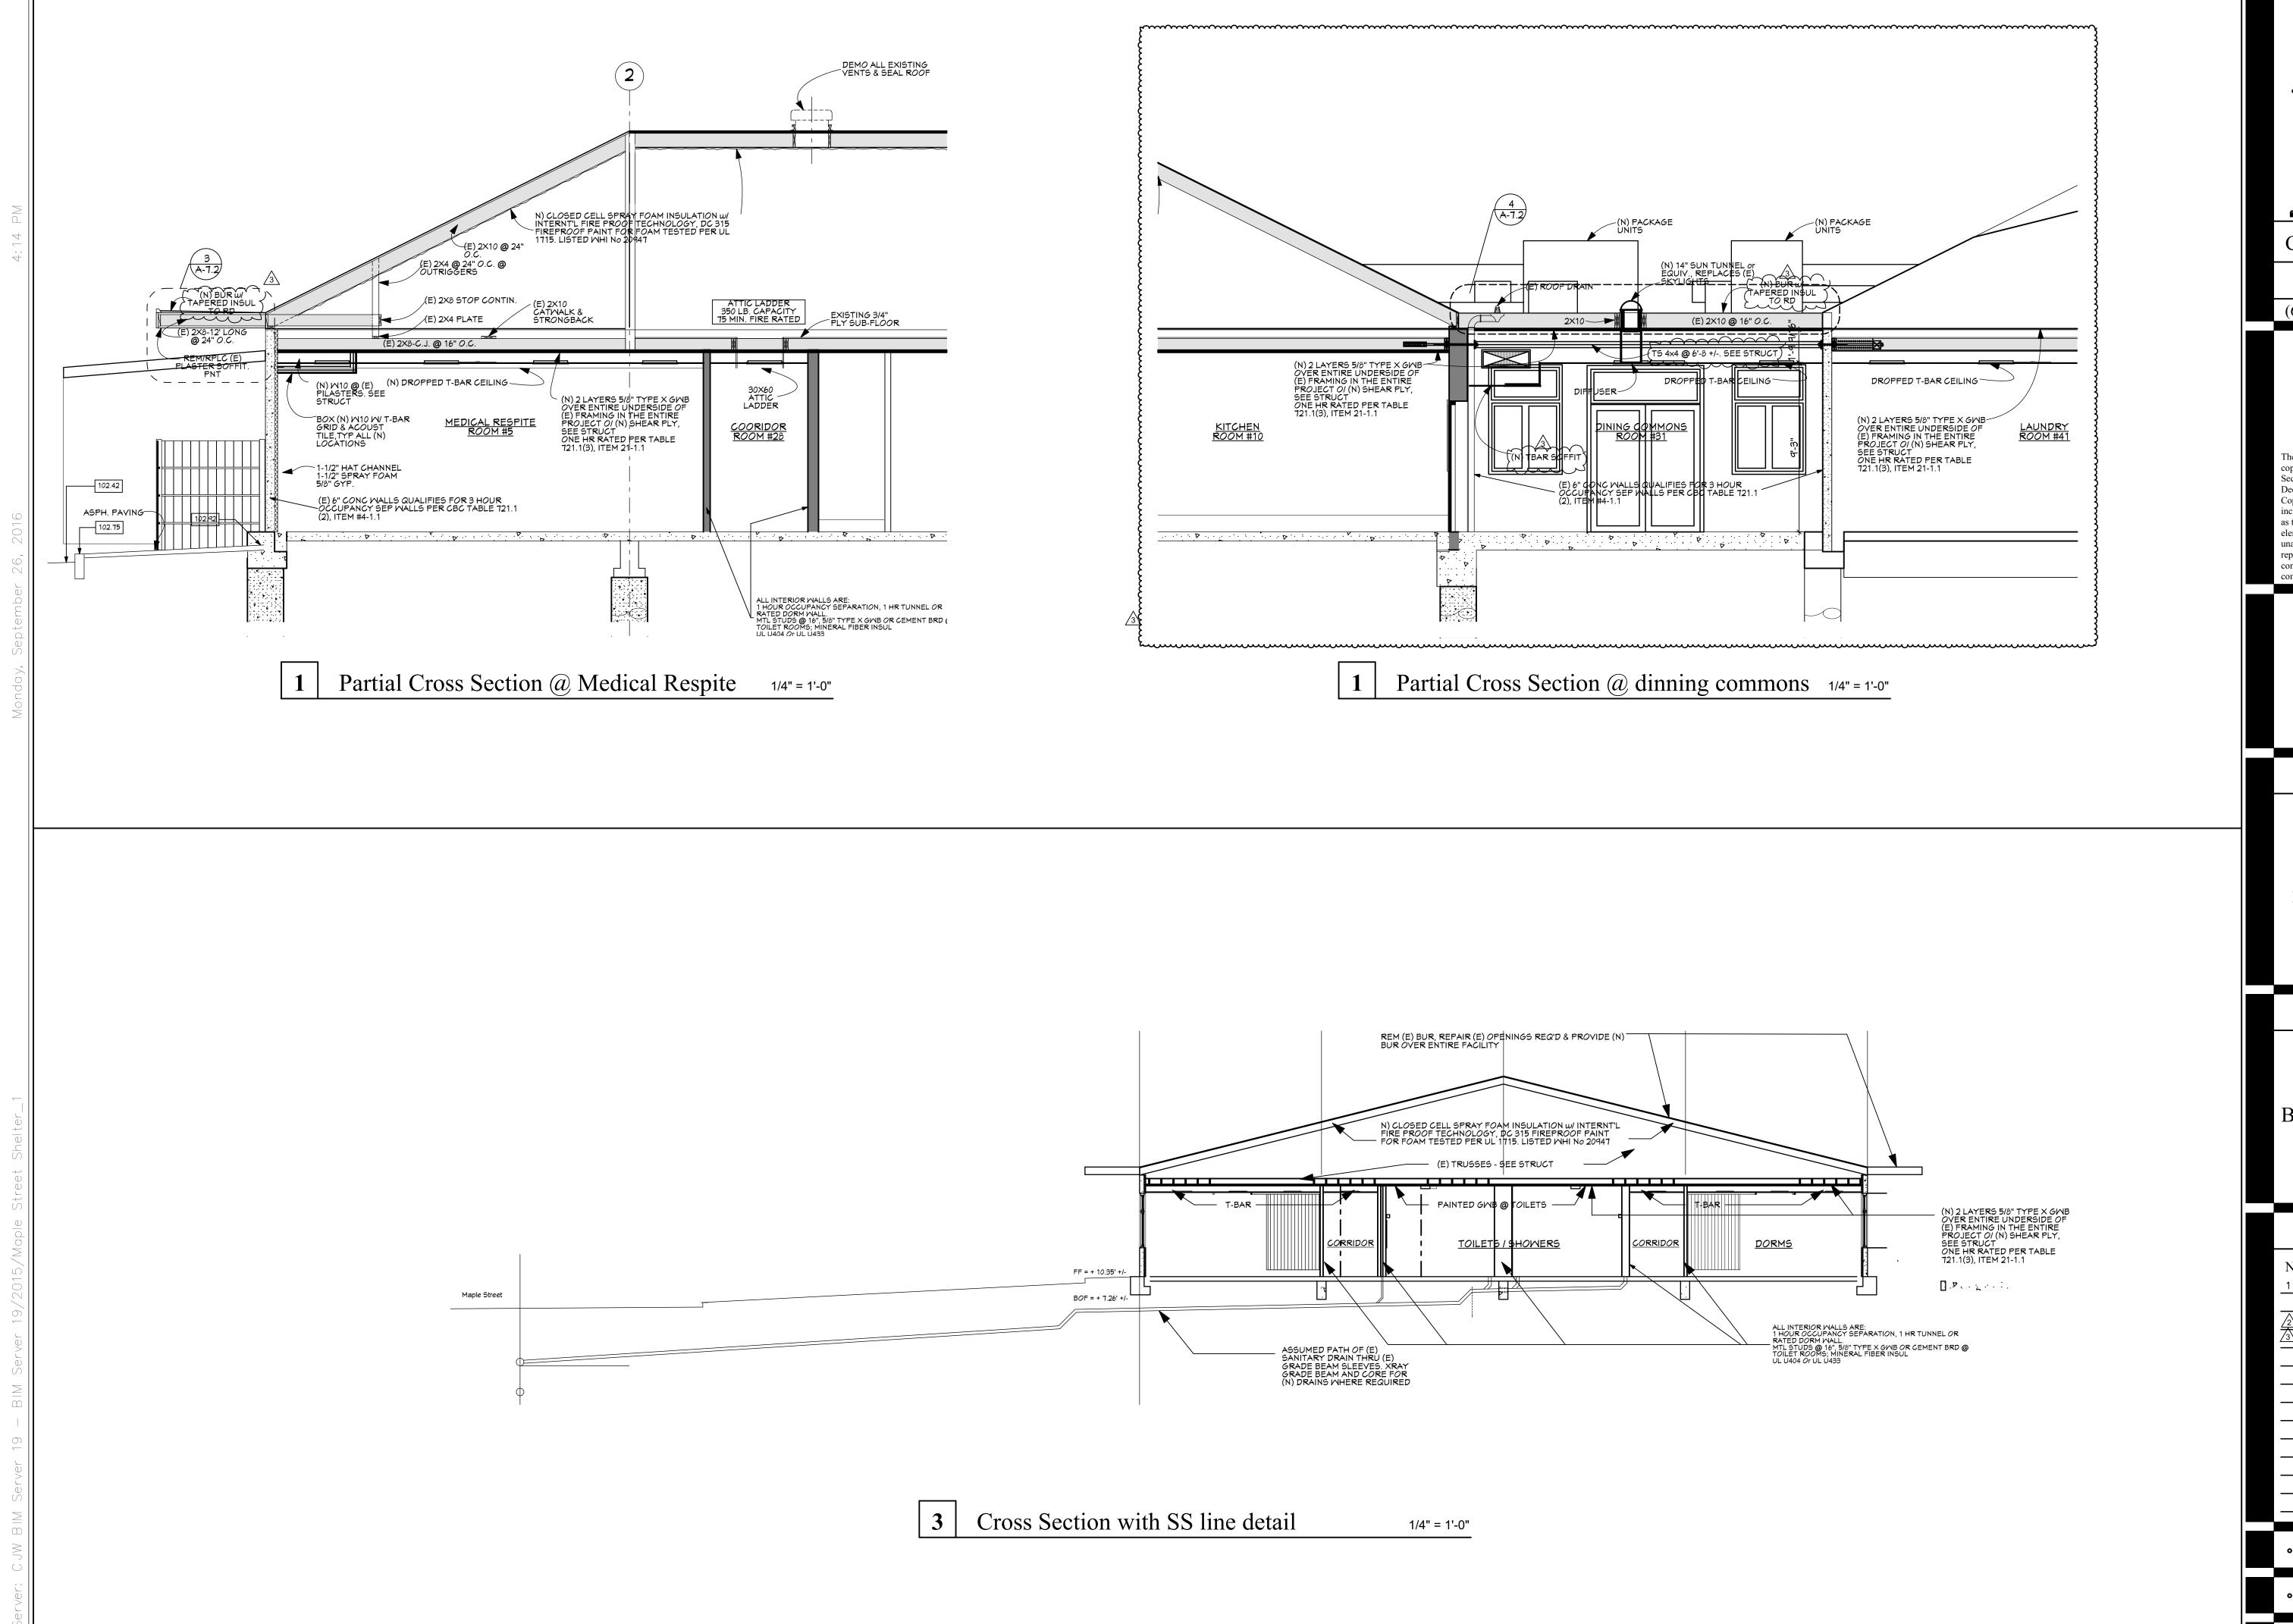

130 Portola Road, suite A Portola Valley, CA 94028 (650) 851-9335 / (Fax) 851-9337

These plans are copyrighted and are subject to copyright protection as an "architectural work" under Sec. 102 of the Copyright Act, 17 U.S.O. as amended December 1990 and known as Architectural Works Copyright Protection Act of 1990. The protection includes but is not limited to the overall form as well as the arrangement and composition of spaces and elements of the design. Under such protection, unauthorized use of these plans, work or home represented, can legally result in the cessation of construction or building being seized and /or monetary compensation to CJW Architecture.



• PROJECT •

LifeMoves Maple Street
Shelter
1580 Maple Street
Redwood City CA 94063

• SHEET TITLE •

BUILDING SECTIONS


• REVISIONS •

Notes

• JOB: 2015.2801

• DATE: 6/17/2016

• SHEET: A-4.1

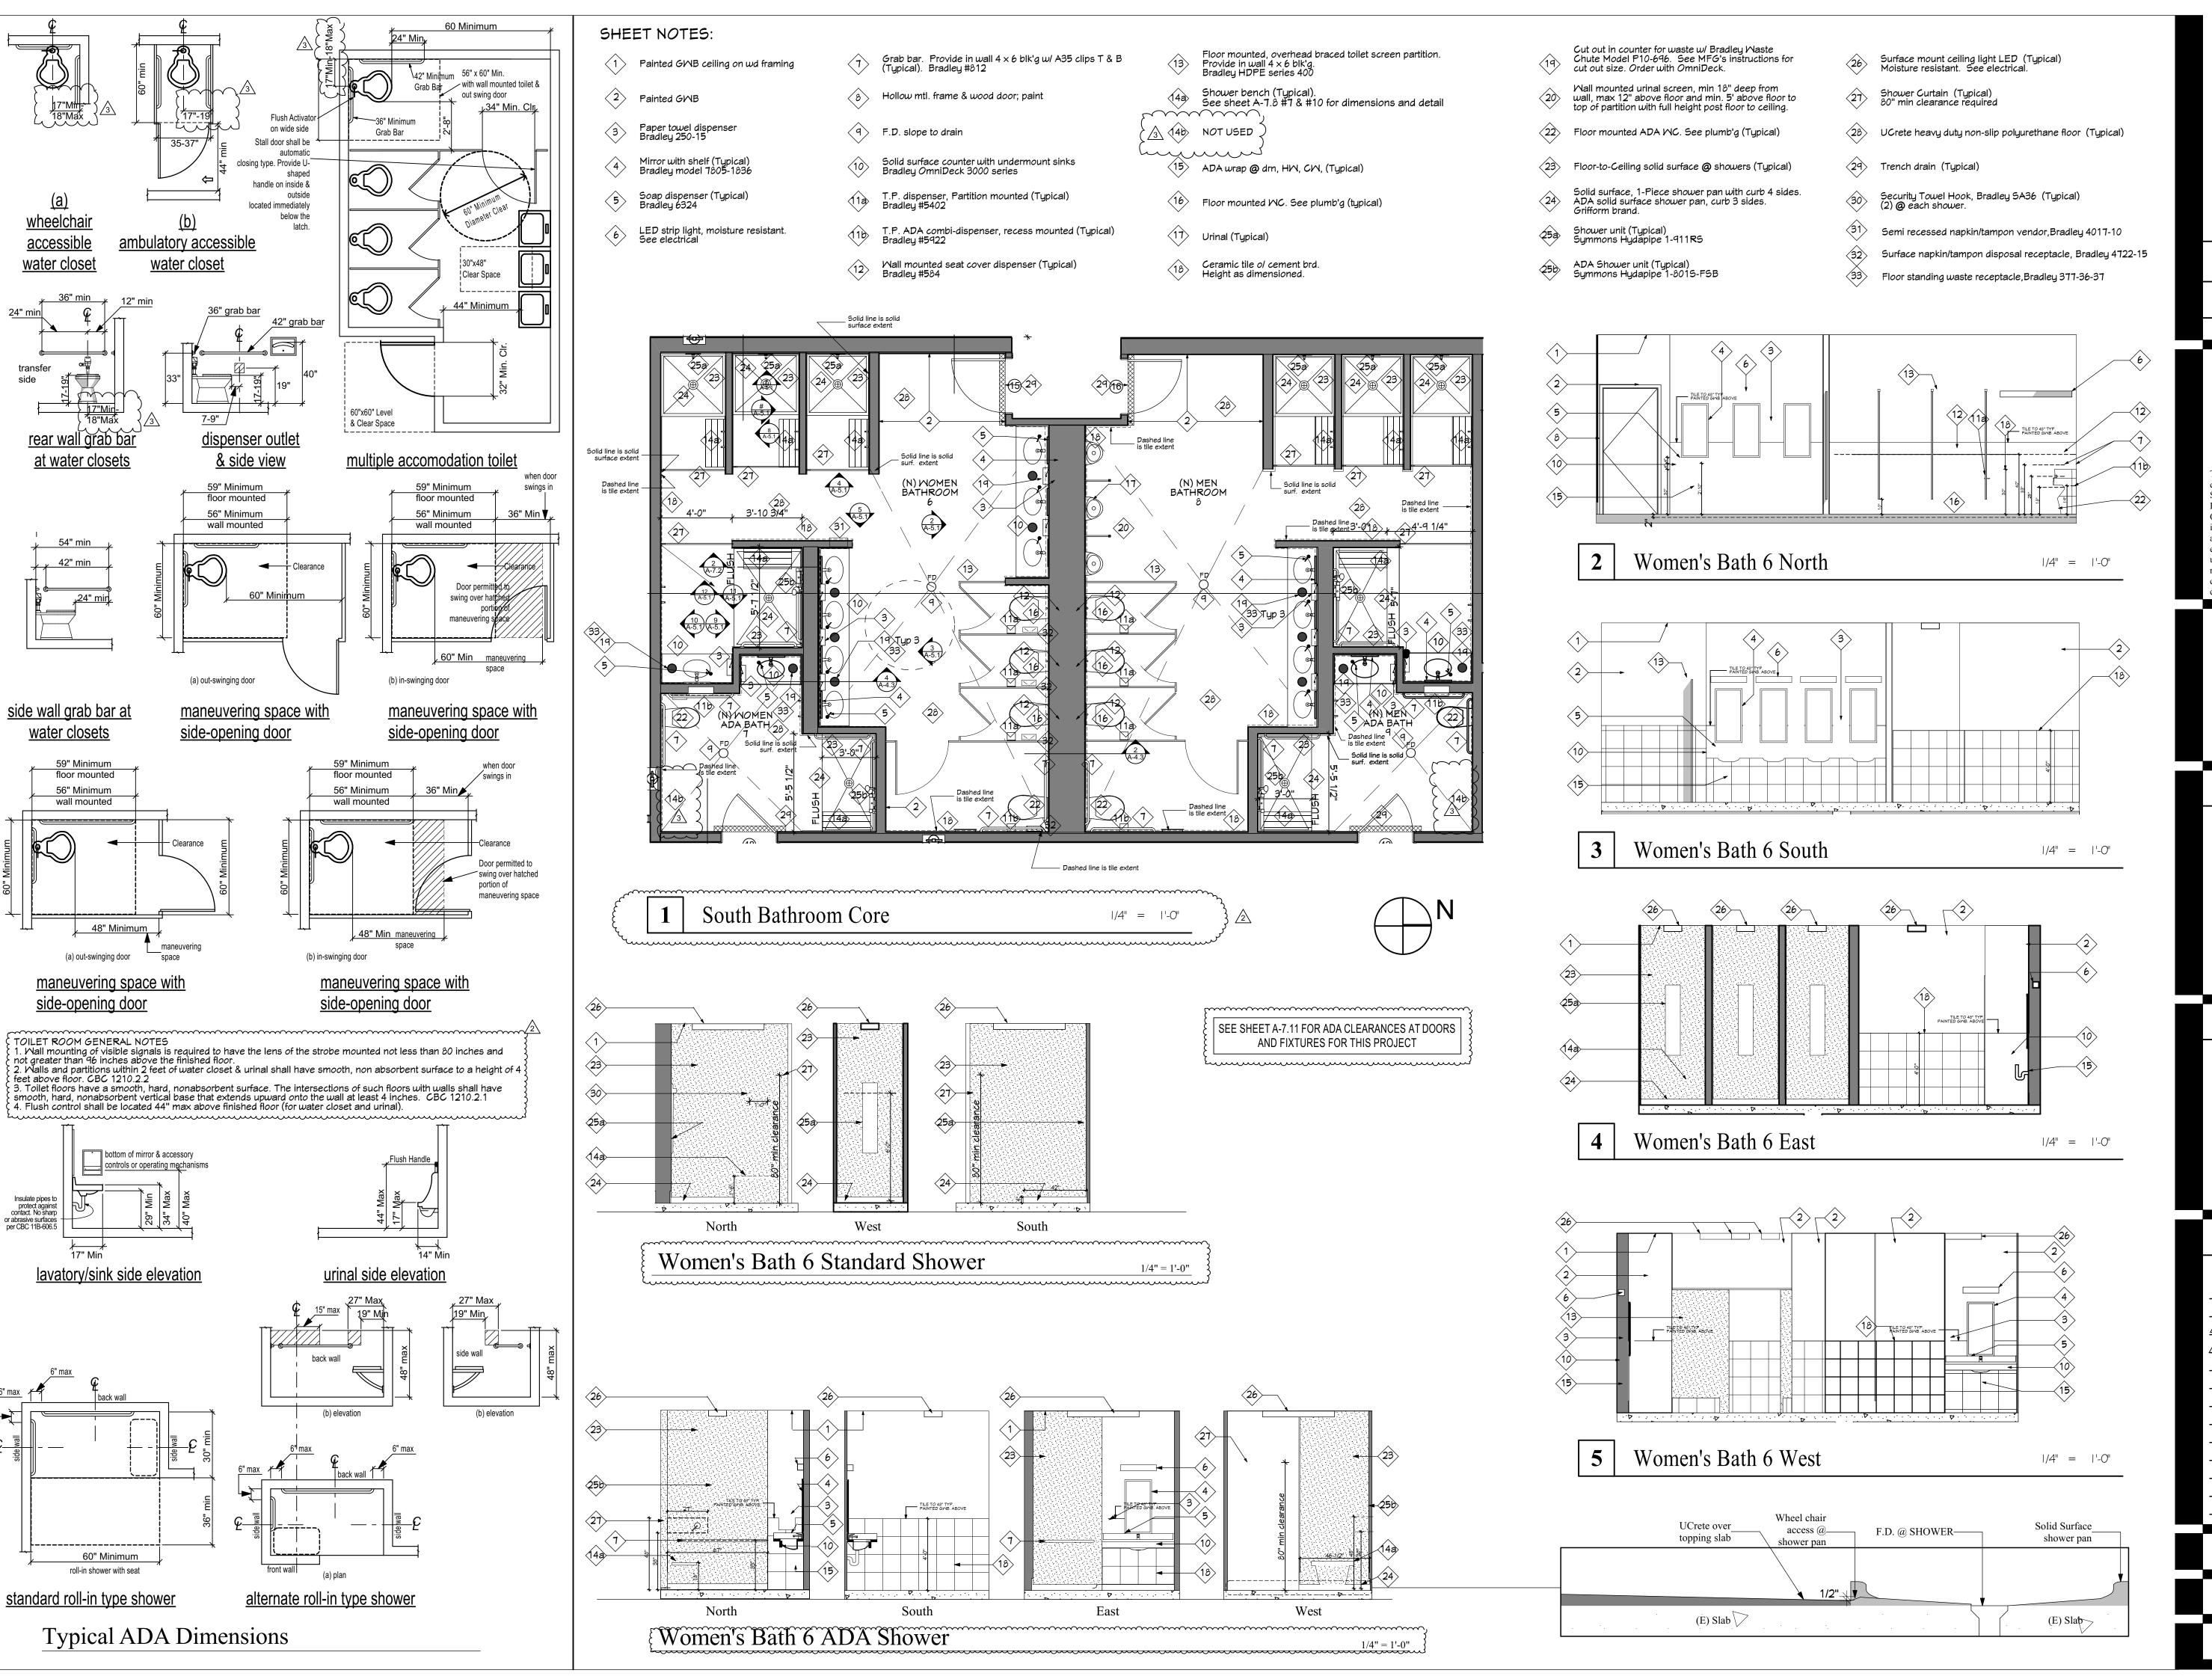

130 Portola Road, suite A Portola Valley, CA 94028 (650) 851-9335 / (Fax) 851-9337

These plans are copyrighted and are subject to copyright protection as an "architectural work" under Sec. 102 of the Copyright Act, 17 U.S.O. as amended December 1990 and known as Architectural Works Copyright Protection Act of 1990. The protection includes but is not limited to the overall form as well as the arrangement and composition of spaces and elements of the design. Under such protection, unauthorized use of these plans, work or home represented, can legally result in the cessation of construction or building being seized and /or monetary compensation to CJW Architecture.



• PROJECT •

LifeMoves Maple Street
Shelter
1580 Maple Street
Redwood City CA 94063

• SHEET TITLE •

ADA BATHROOM DETAIL

 No.
 Date
 Notes

 1
 6-17-2016
 Building Submittal


 2
 8-15-2016
 PC#1/ Add #3


 3
 9-23-2016
 PC#2/ Add #6

JOB: 2015.2801

• DATE: 6/17/2016

• SHEET: A-5.1

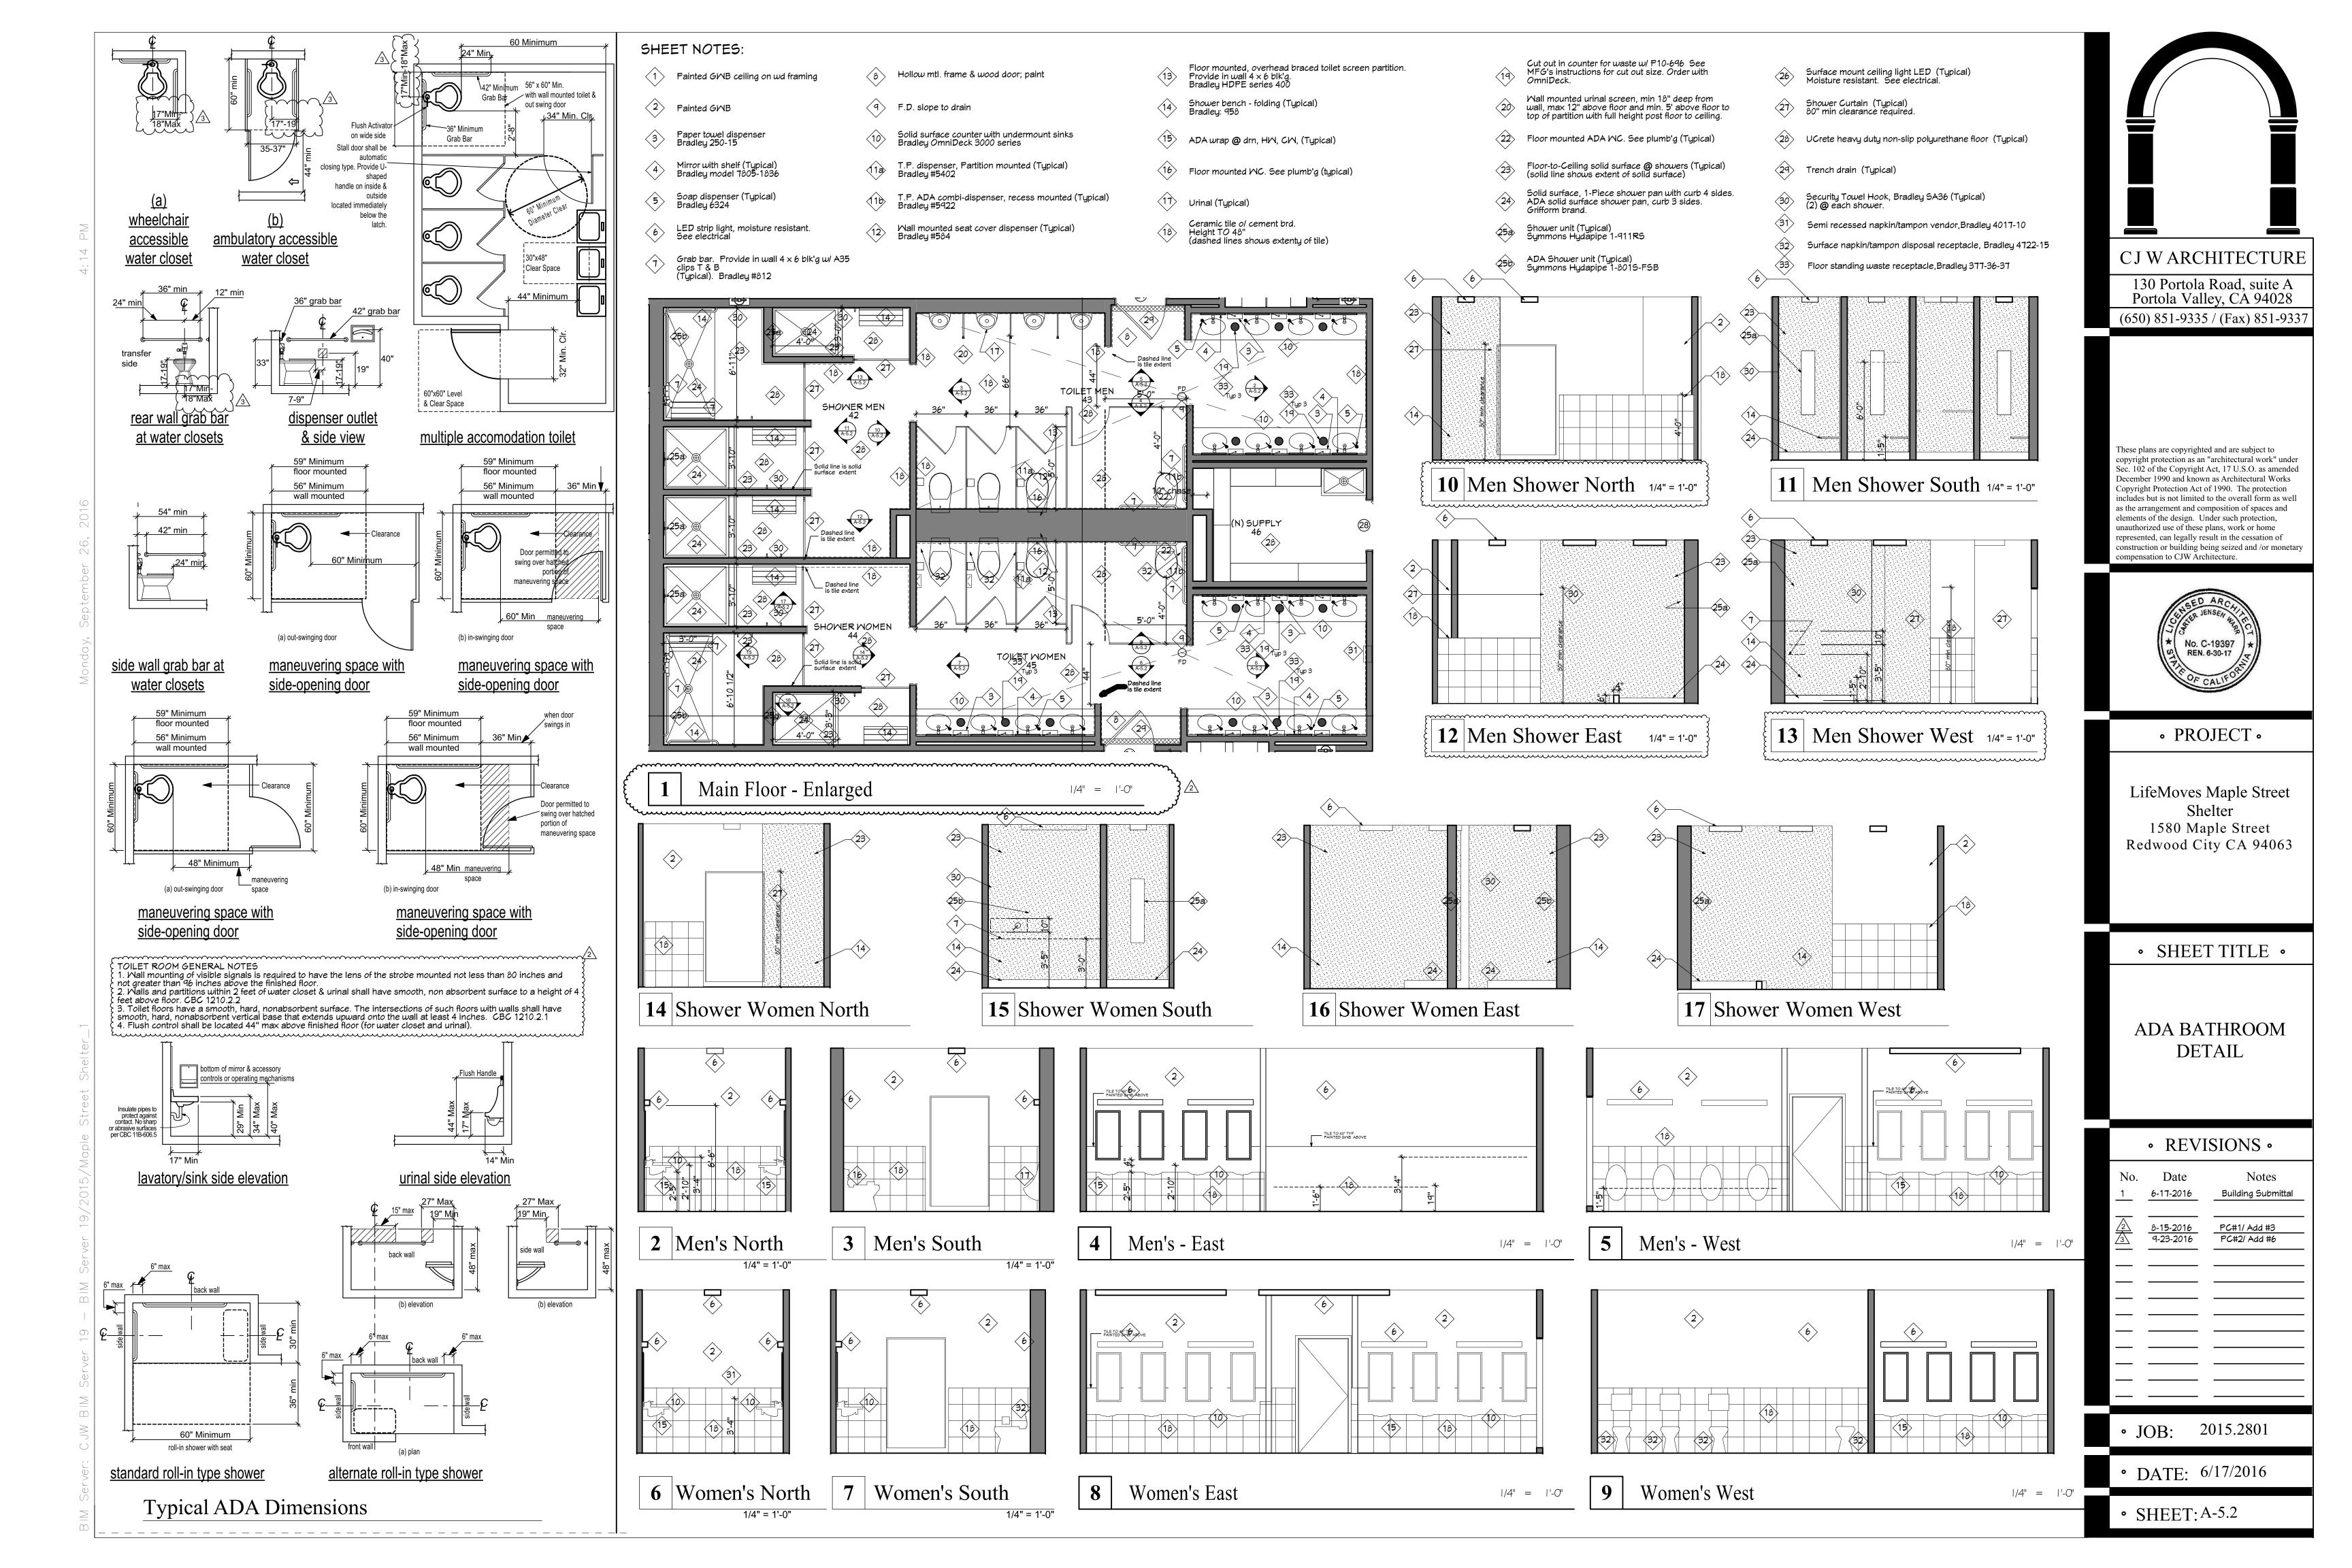

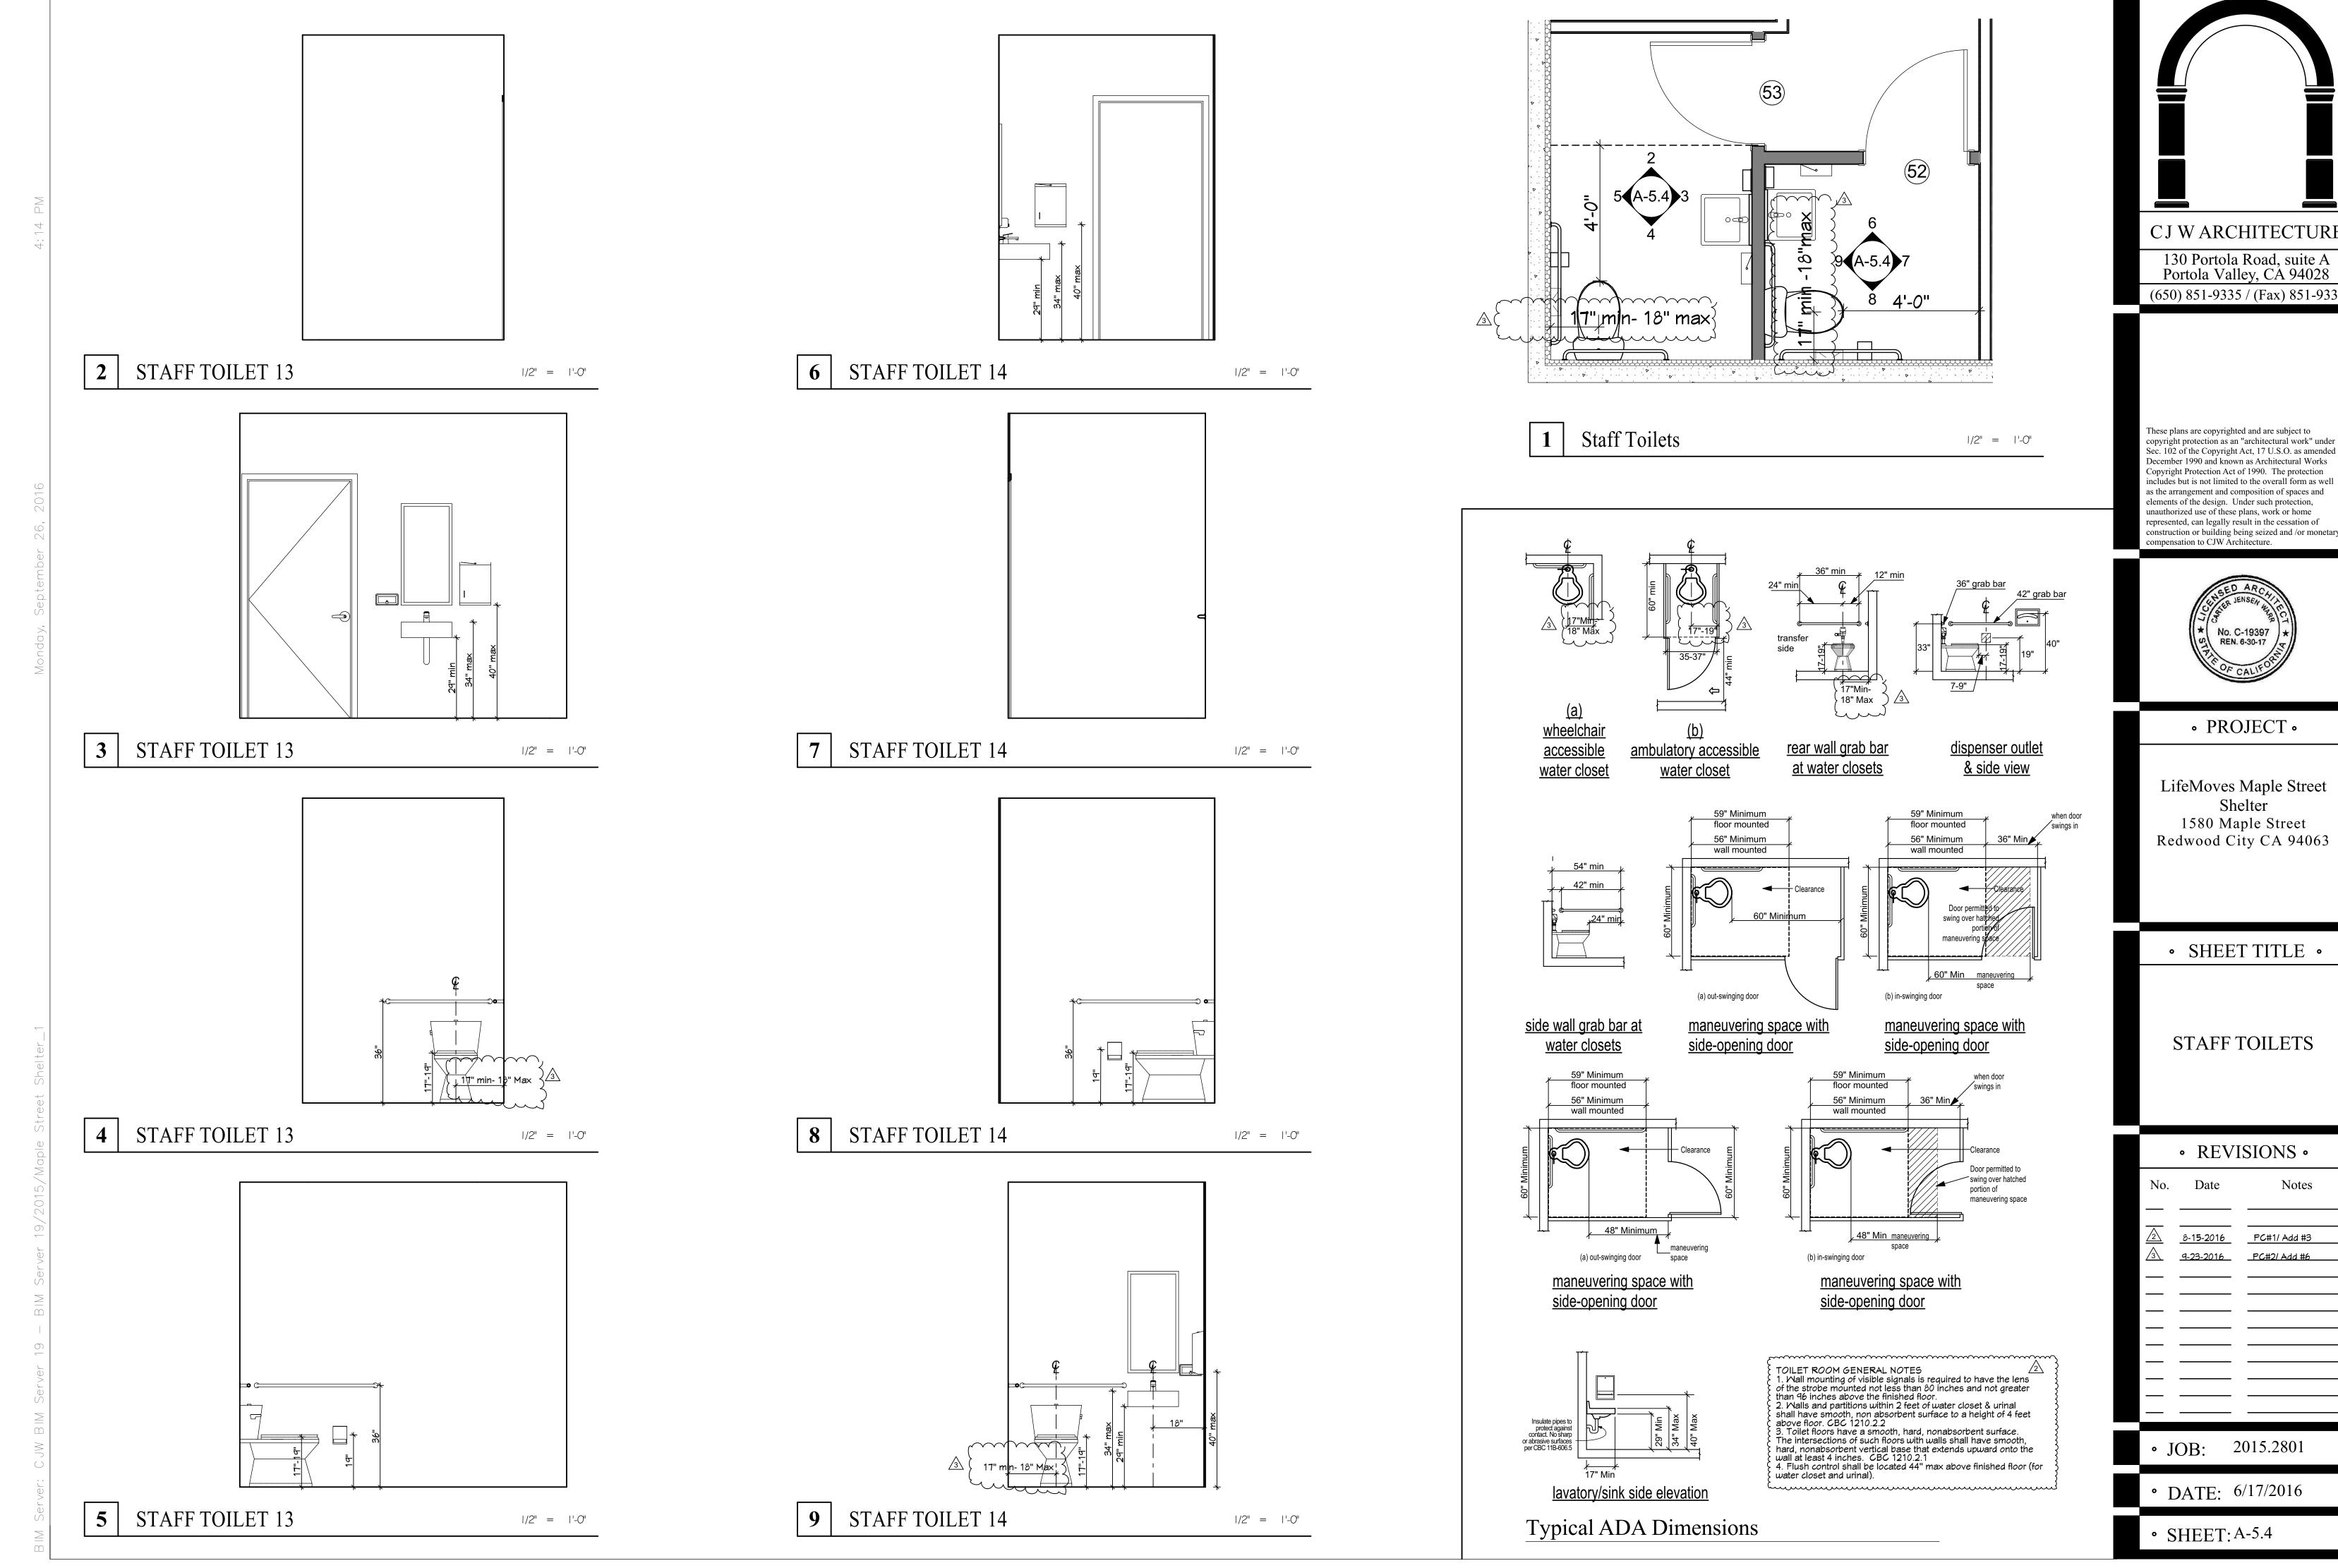

(650) 851-9335 / (Fax) 851-9337


These plans are copyrighted and are subject to copyright protection as an "architectural work" under Sec. 102 of the Copyright Act, 17 U.S.O. as amended December 1990 and known as Architectural Works Copyright Protection Act of 1990. The protection includes but is not limited to the overall form as well as the arrangement and composition of spaces and elements of the design. Under such protection, unauthorized use of these plans, work or home represented, can legally result in the cessation of construction or building being seized and /or monetary compensation to CJW Architecture.




LifeMoves Maple Street

1580 Maple Street Redwood City CA 94063

	112 / 12101 (2						
No.	Date	Notes					
—							
<u>2</u>	8-15-2016 9-23-2016	PC#1/ Add #3 PC#2/ Add #6					
—							
—							
_							
—							

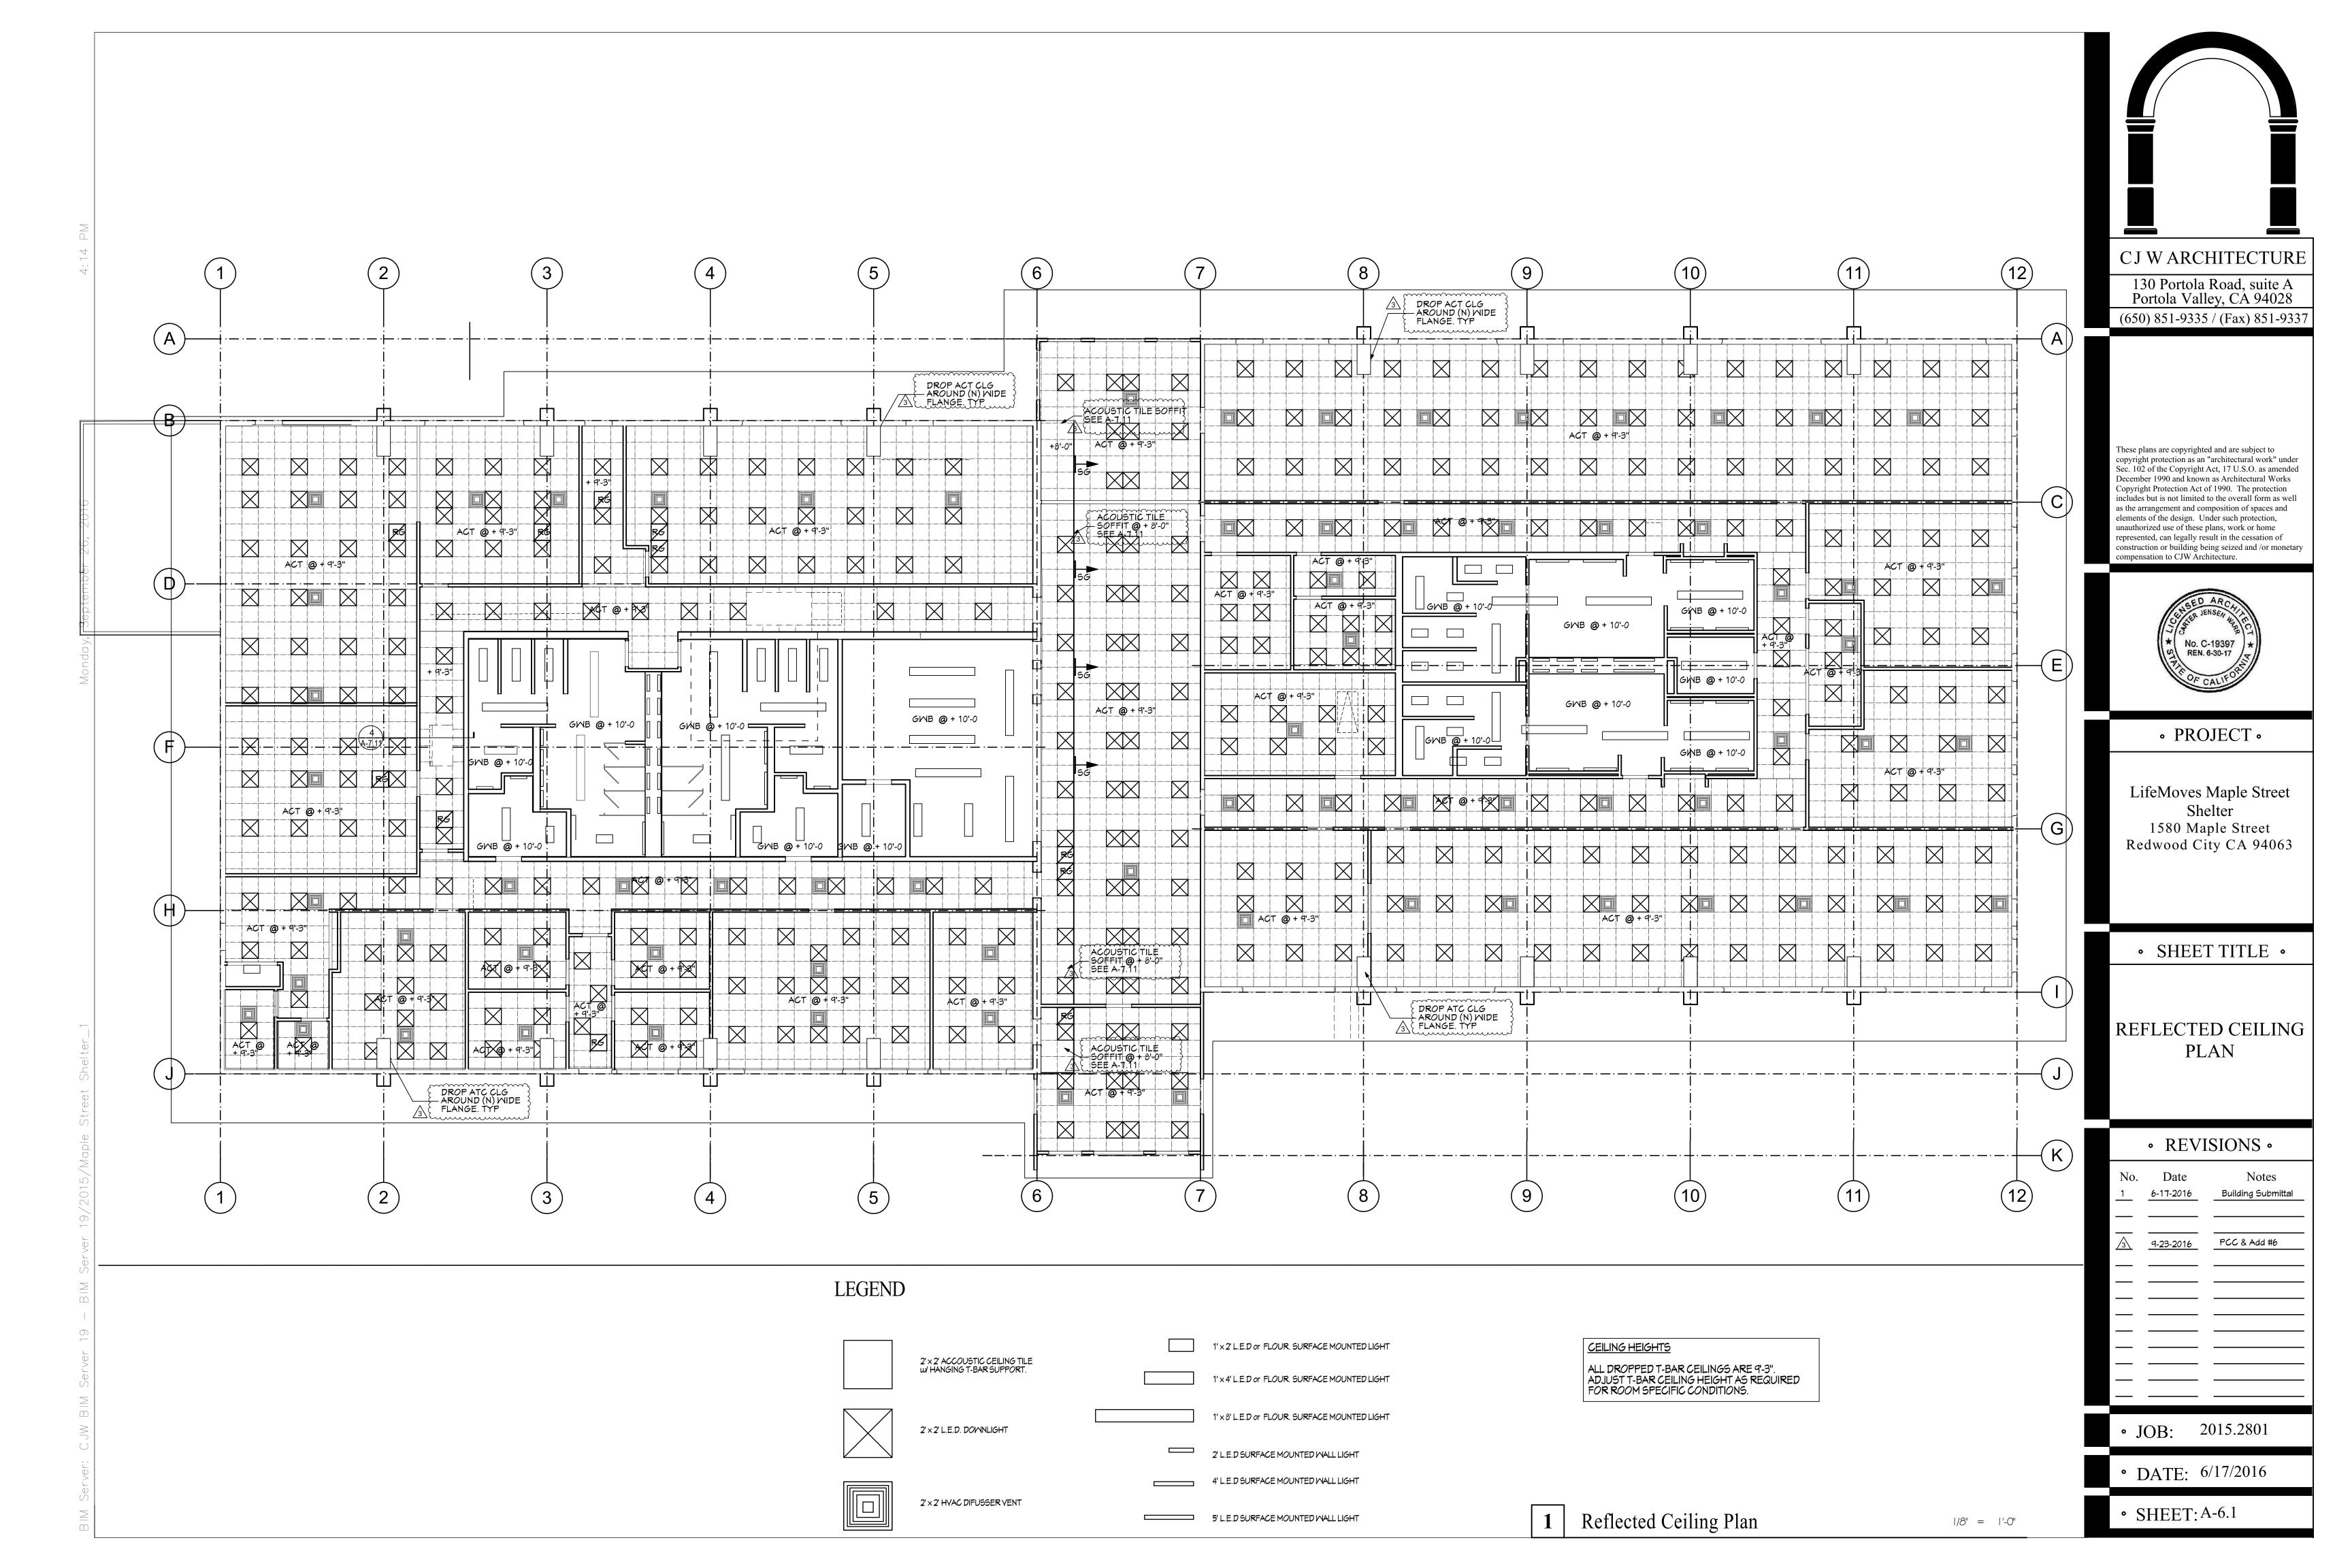

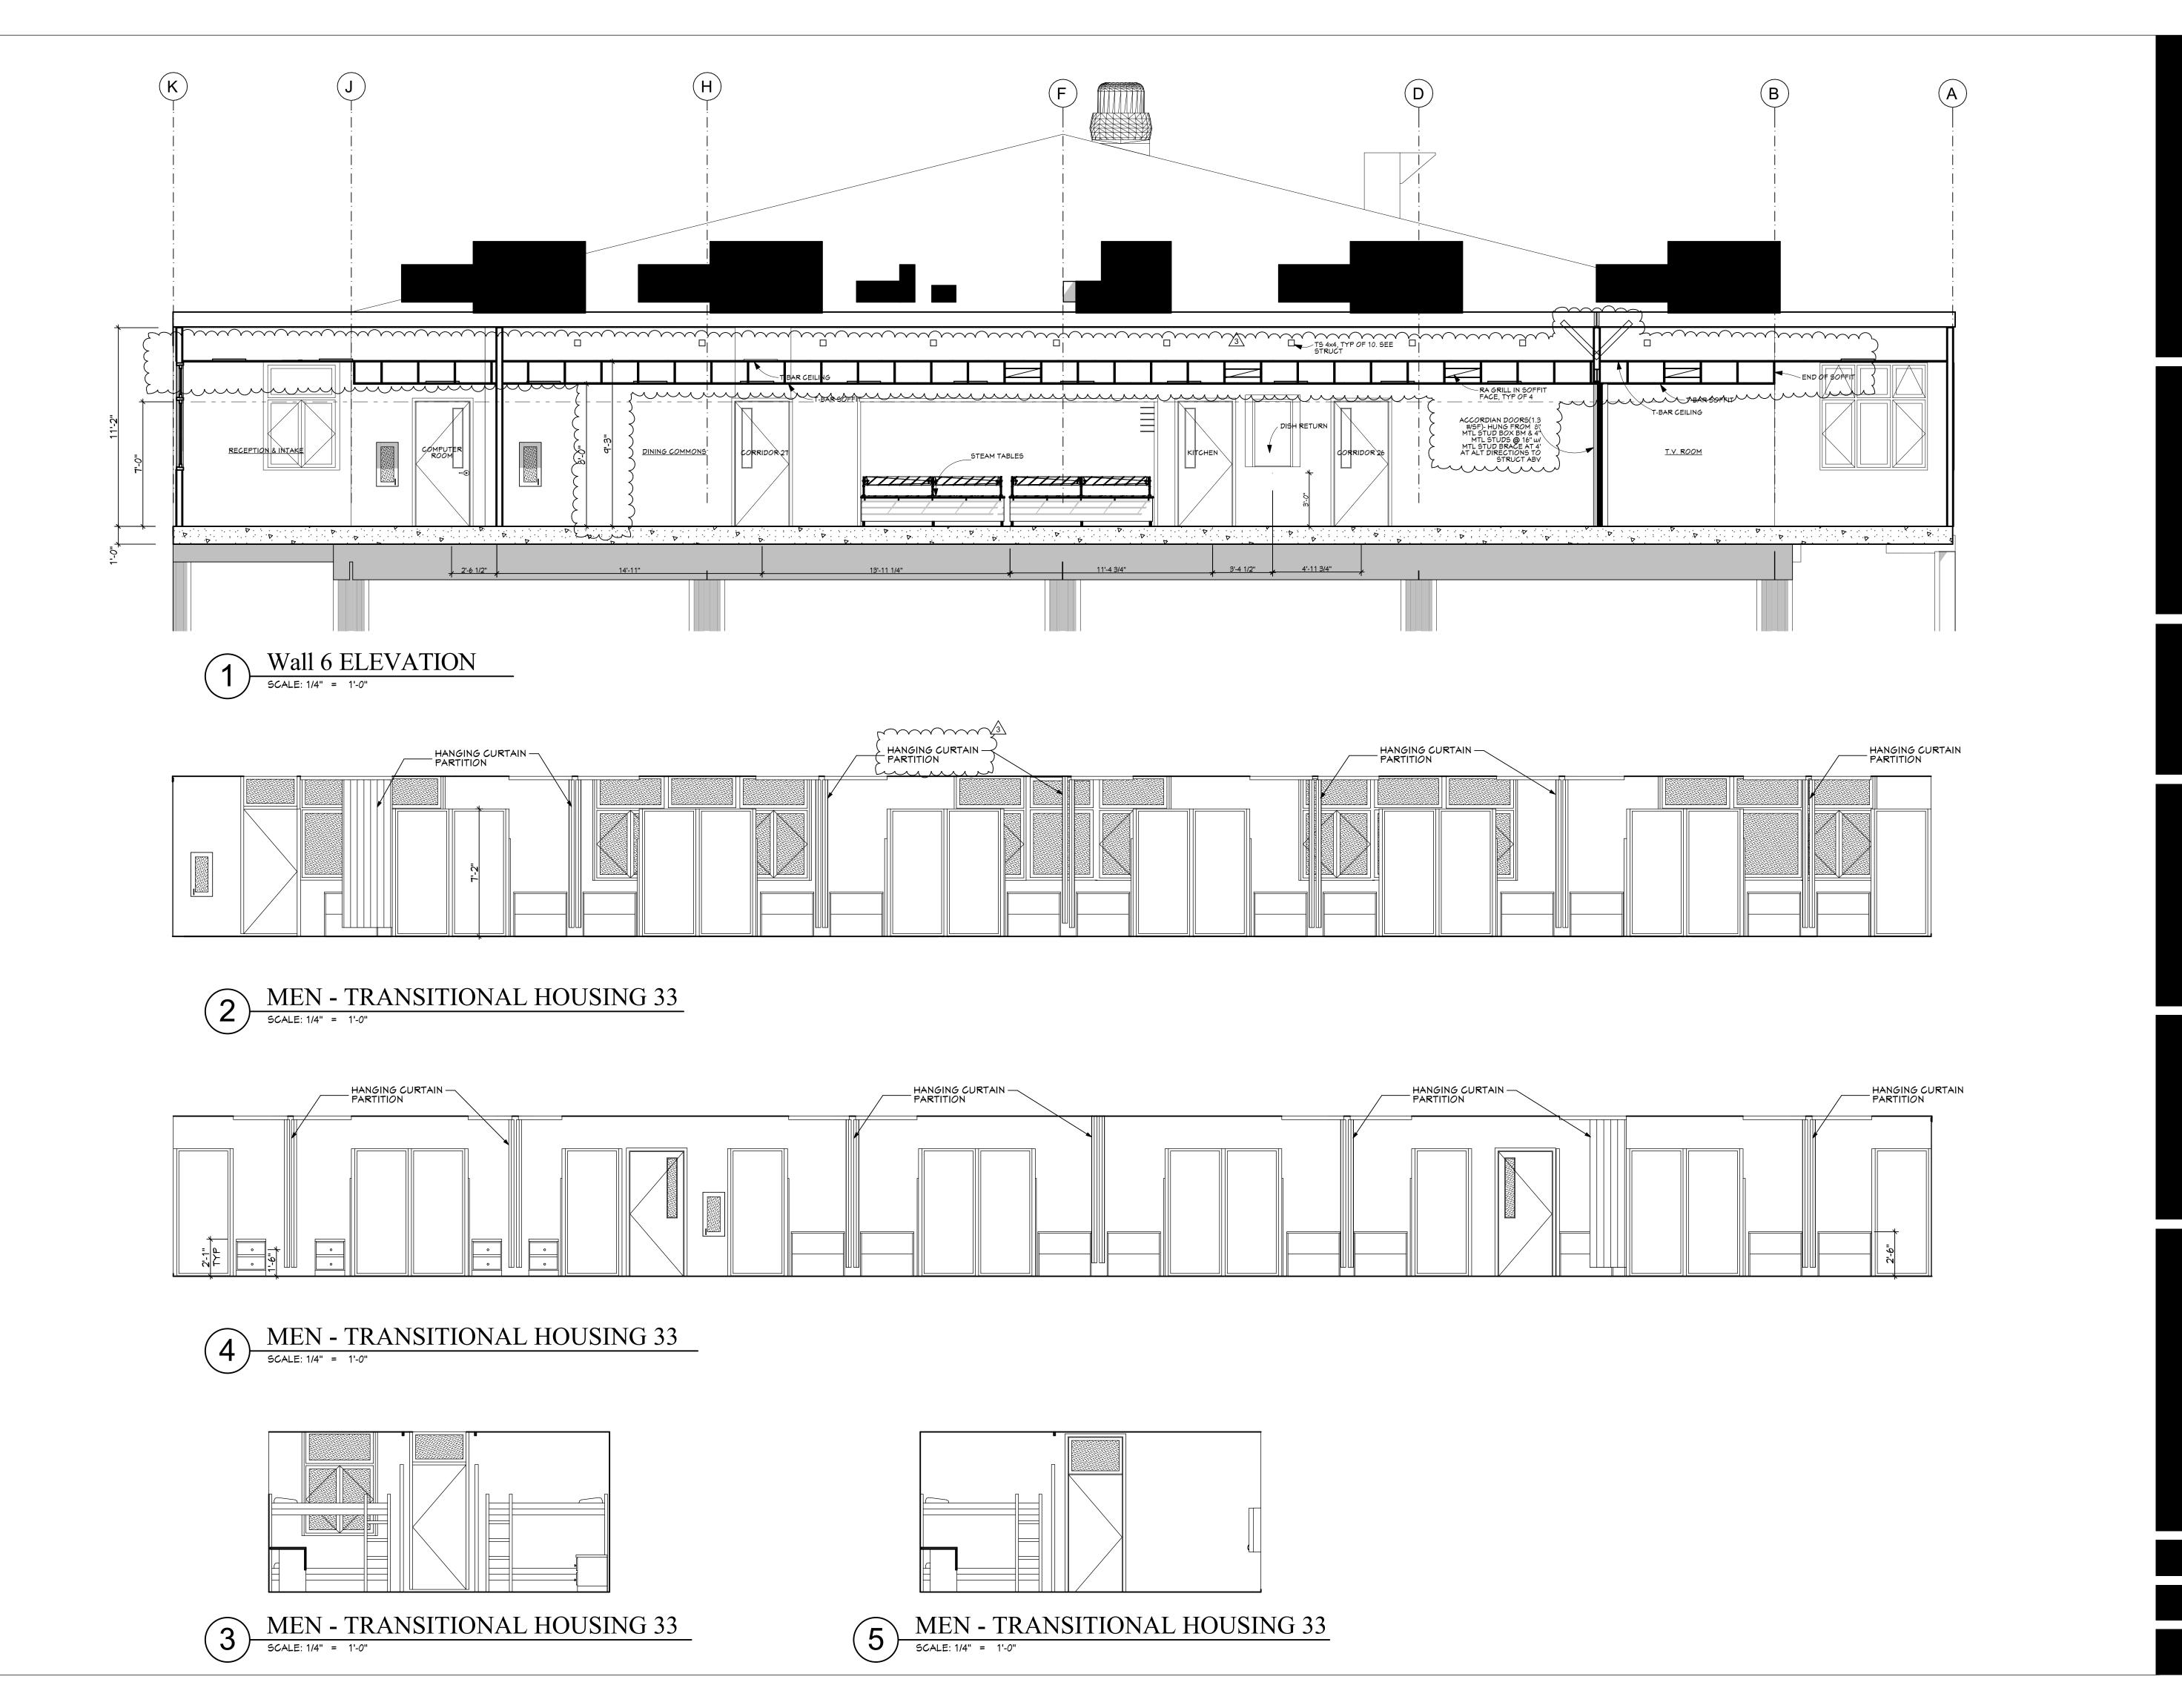

130 Portola Road, suite A Portola Valley, CA 94028 (650) 851-9335 / (Fax) 851-9337

These plans are copyrighted and are subject to copyright protection as an "architectural work" under Sec. 102 of the Copyright Act, 17 U.S.O. as amended December 1990 and known as Architectural Works Copyright Protection Act of 1990. The protection includes but is not limited to the overall form as well as the arrangement and composition of spaces and elements of the design. Under such protection, unauthorized use of these plans, work or home represented, can legally result in the cessation of construction or building being seized and /or monetary compensation to CJW Architecture.



• PROJECT •

LifeMoves Maple Street
Shelter
1580 Maple Street
Redwood City CA 94063

• SHEET TITLE •


INTERIOR ELEVATIONS


	•	REVISIO	NS •
•		Date	Notes


• JOB: 2015.2801


• DATE: 6/17/2016

• SHEET: A-6.3

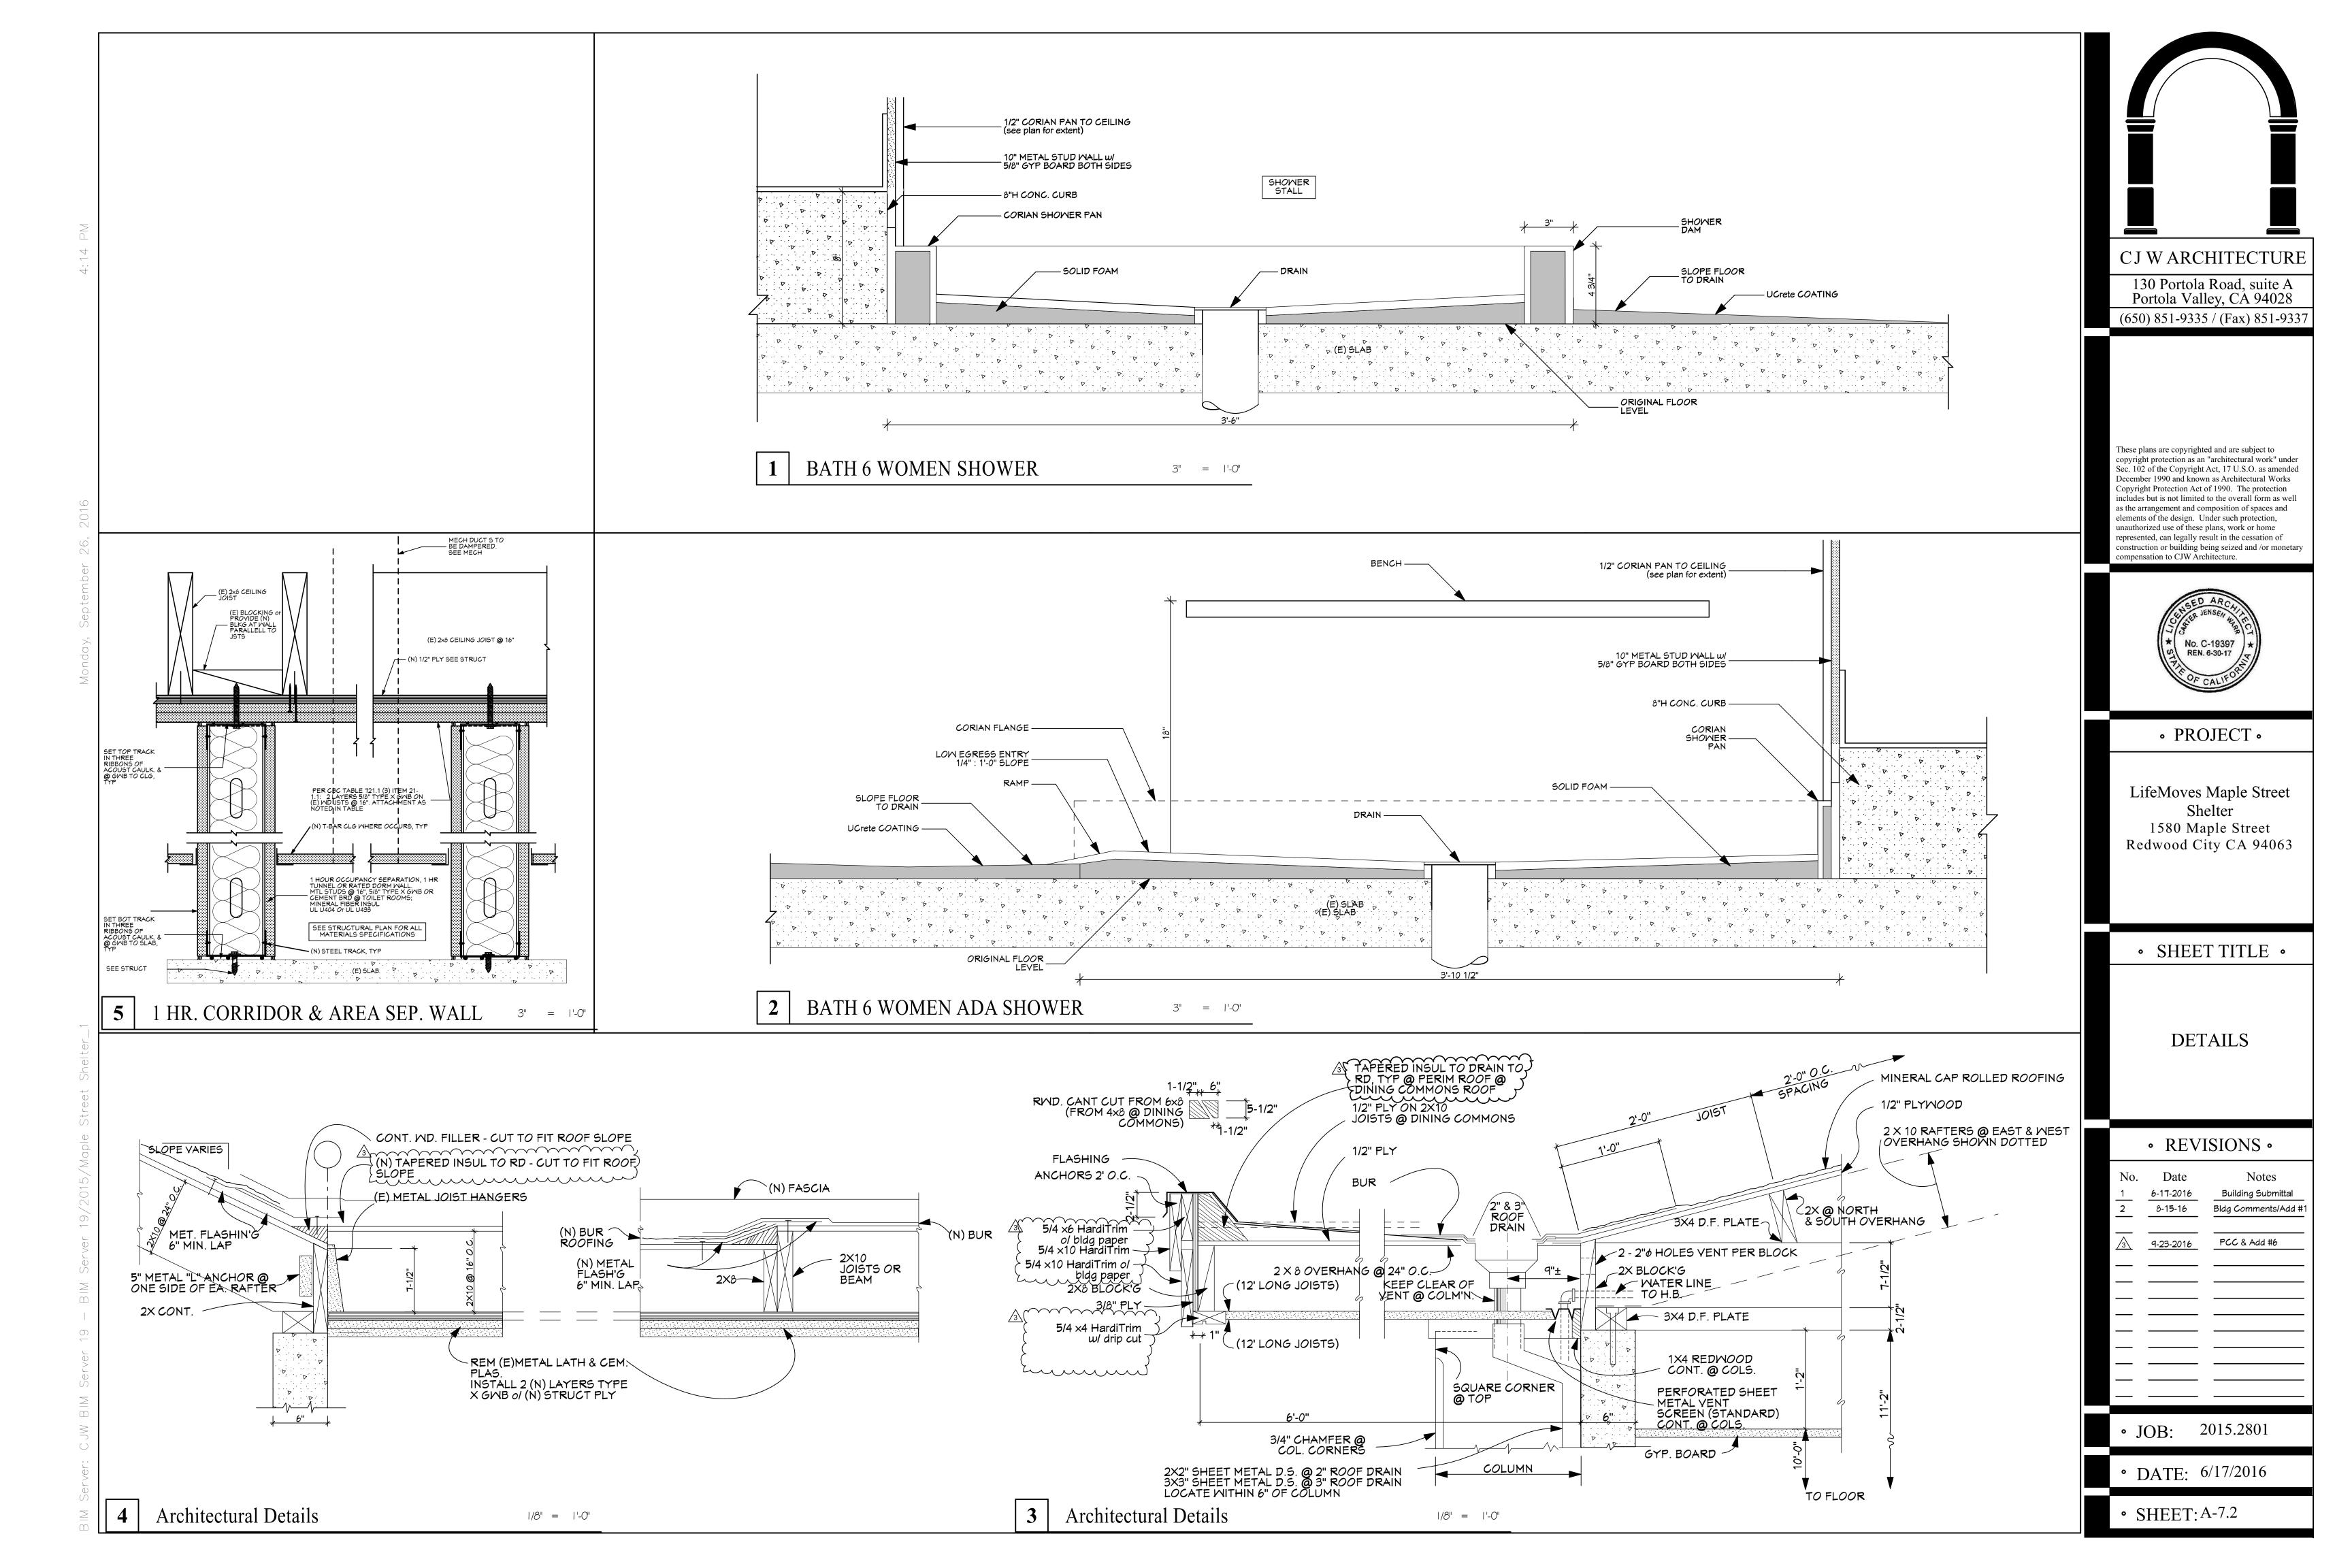

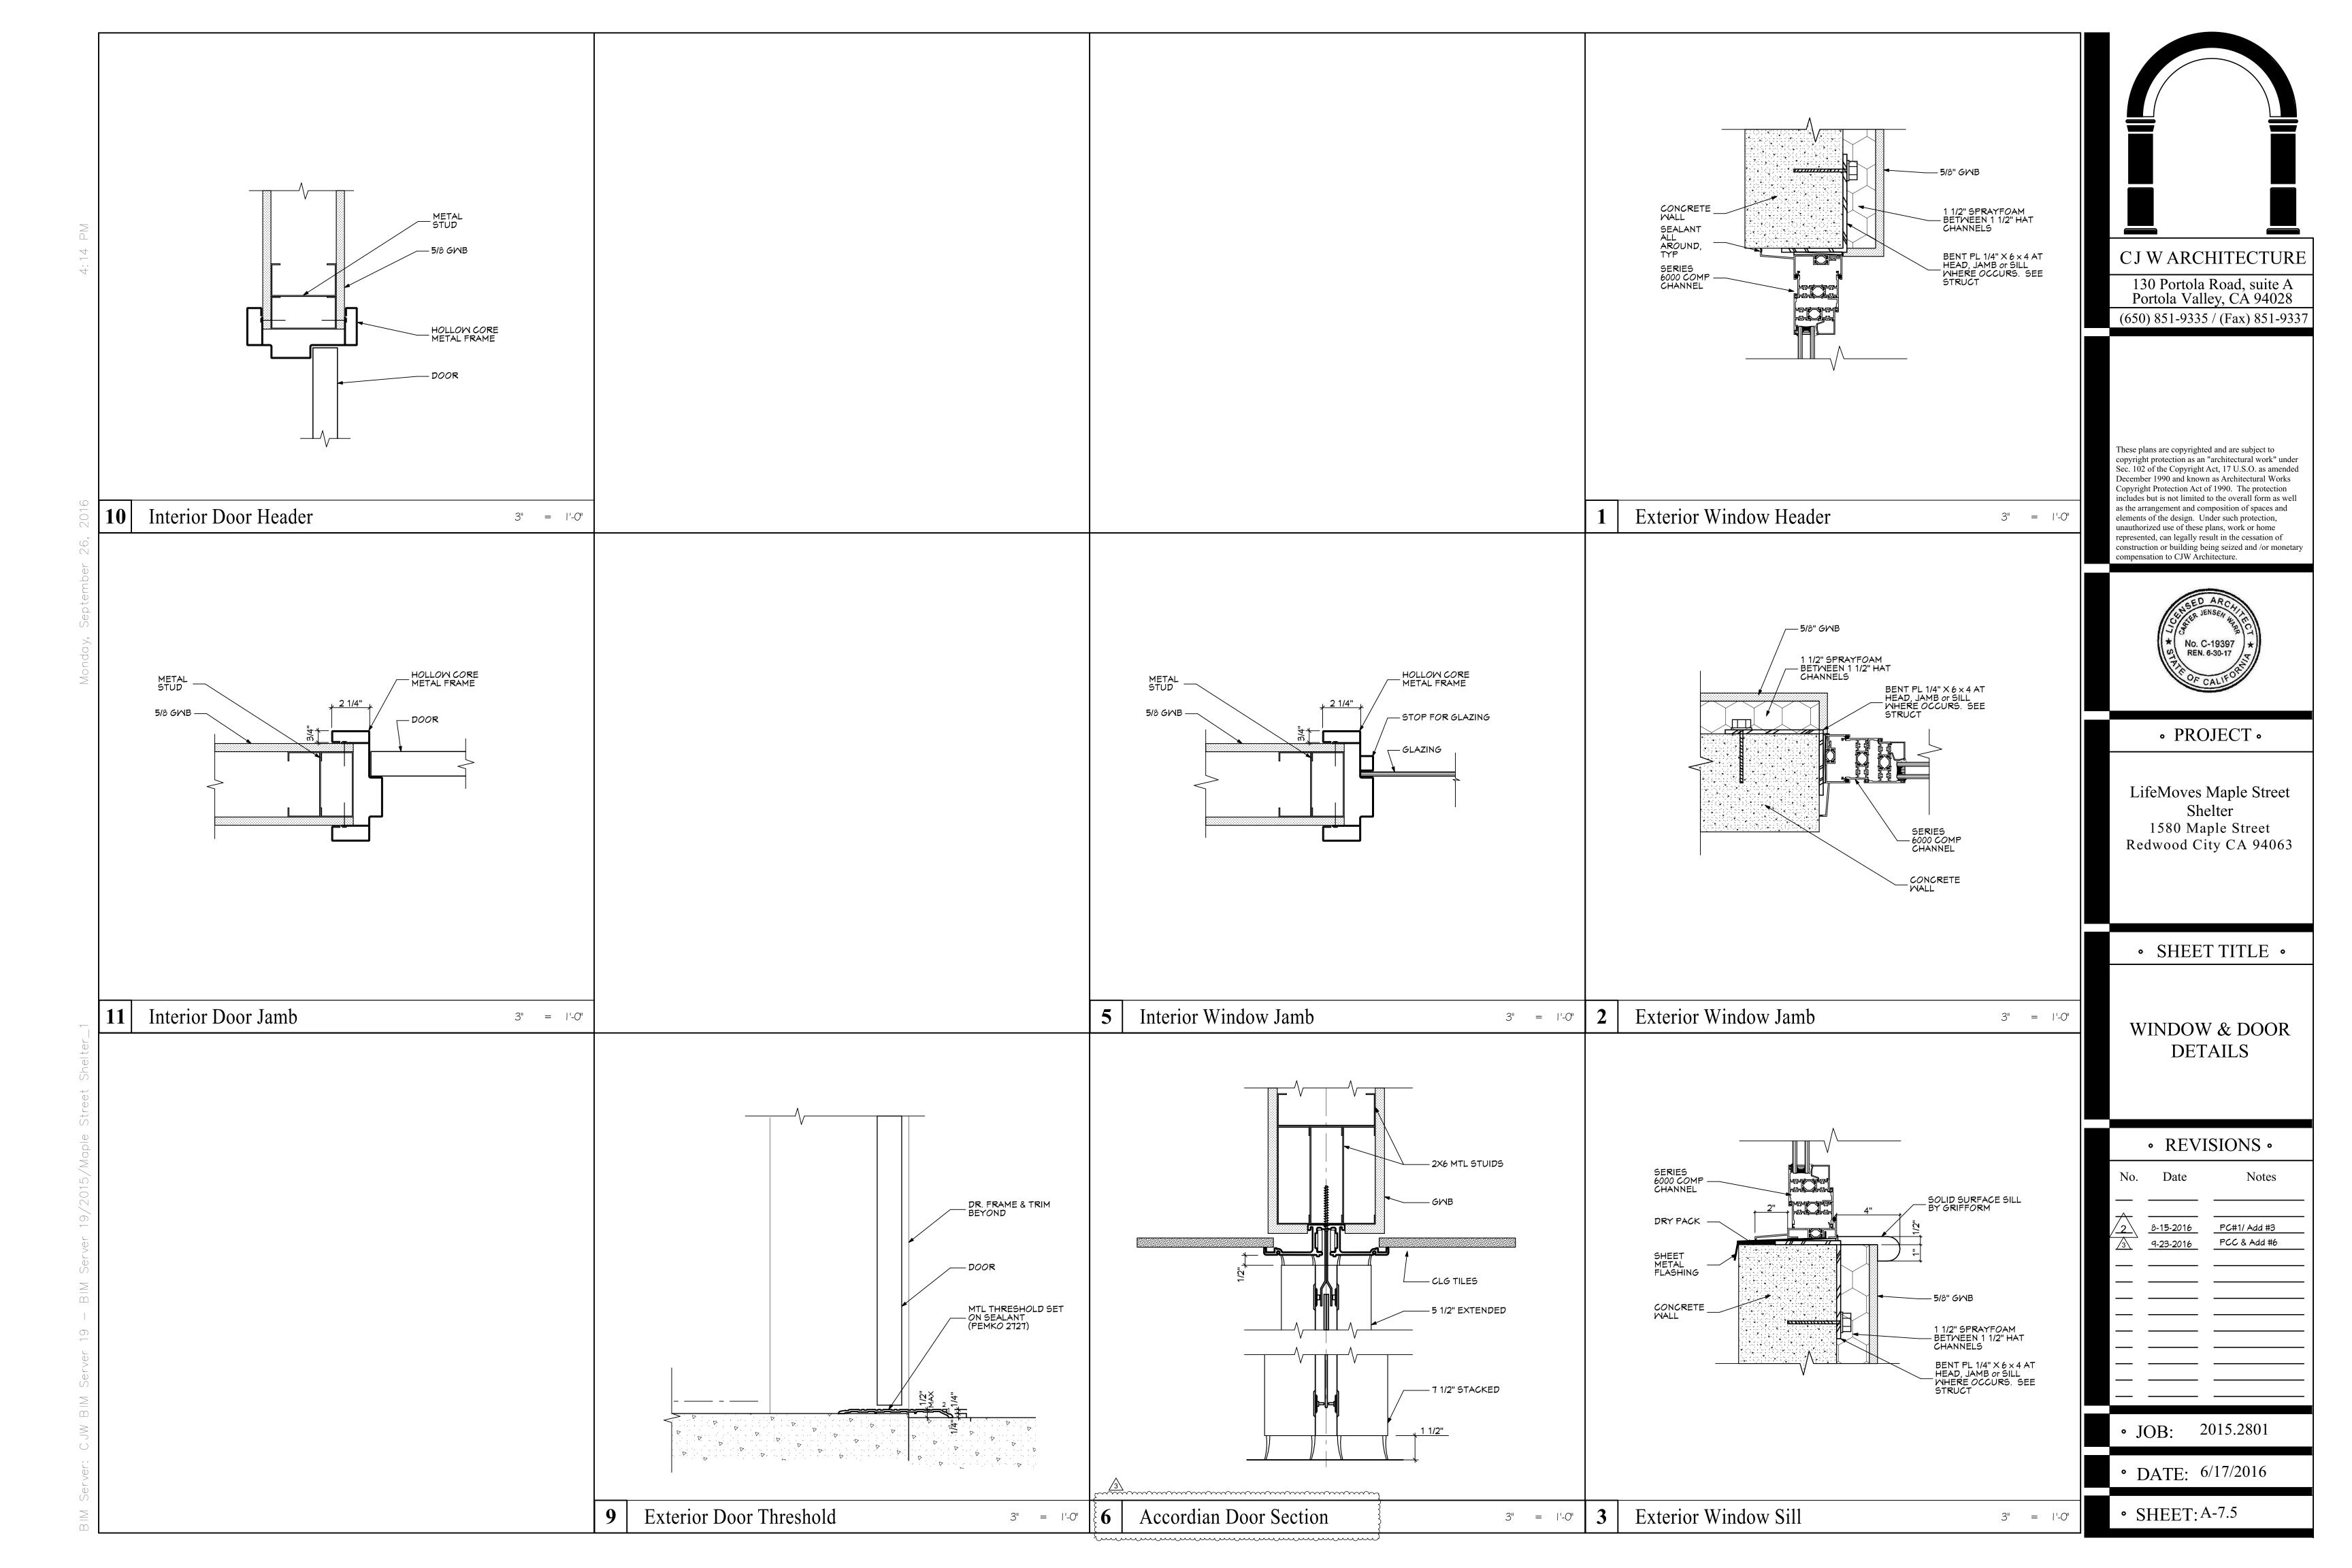

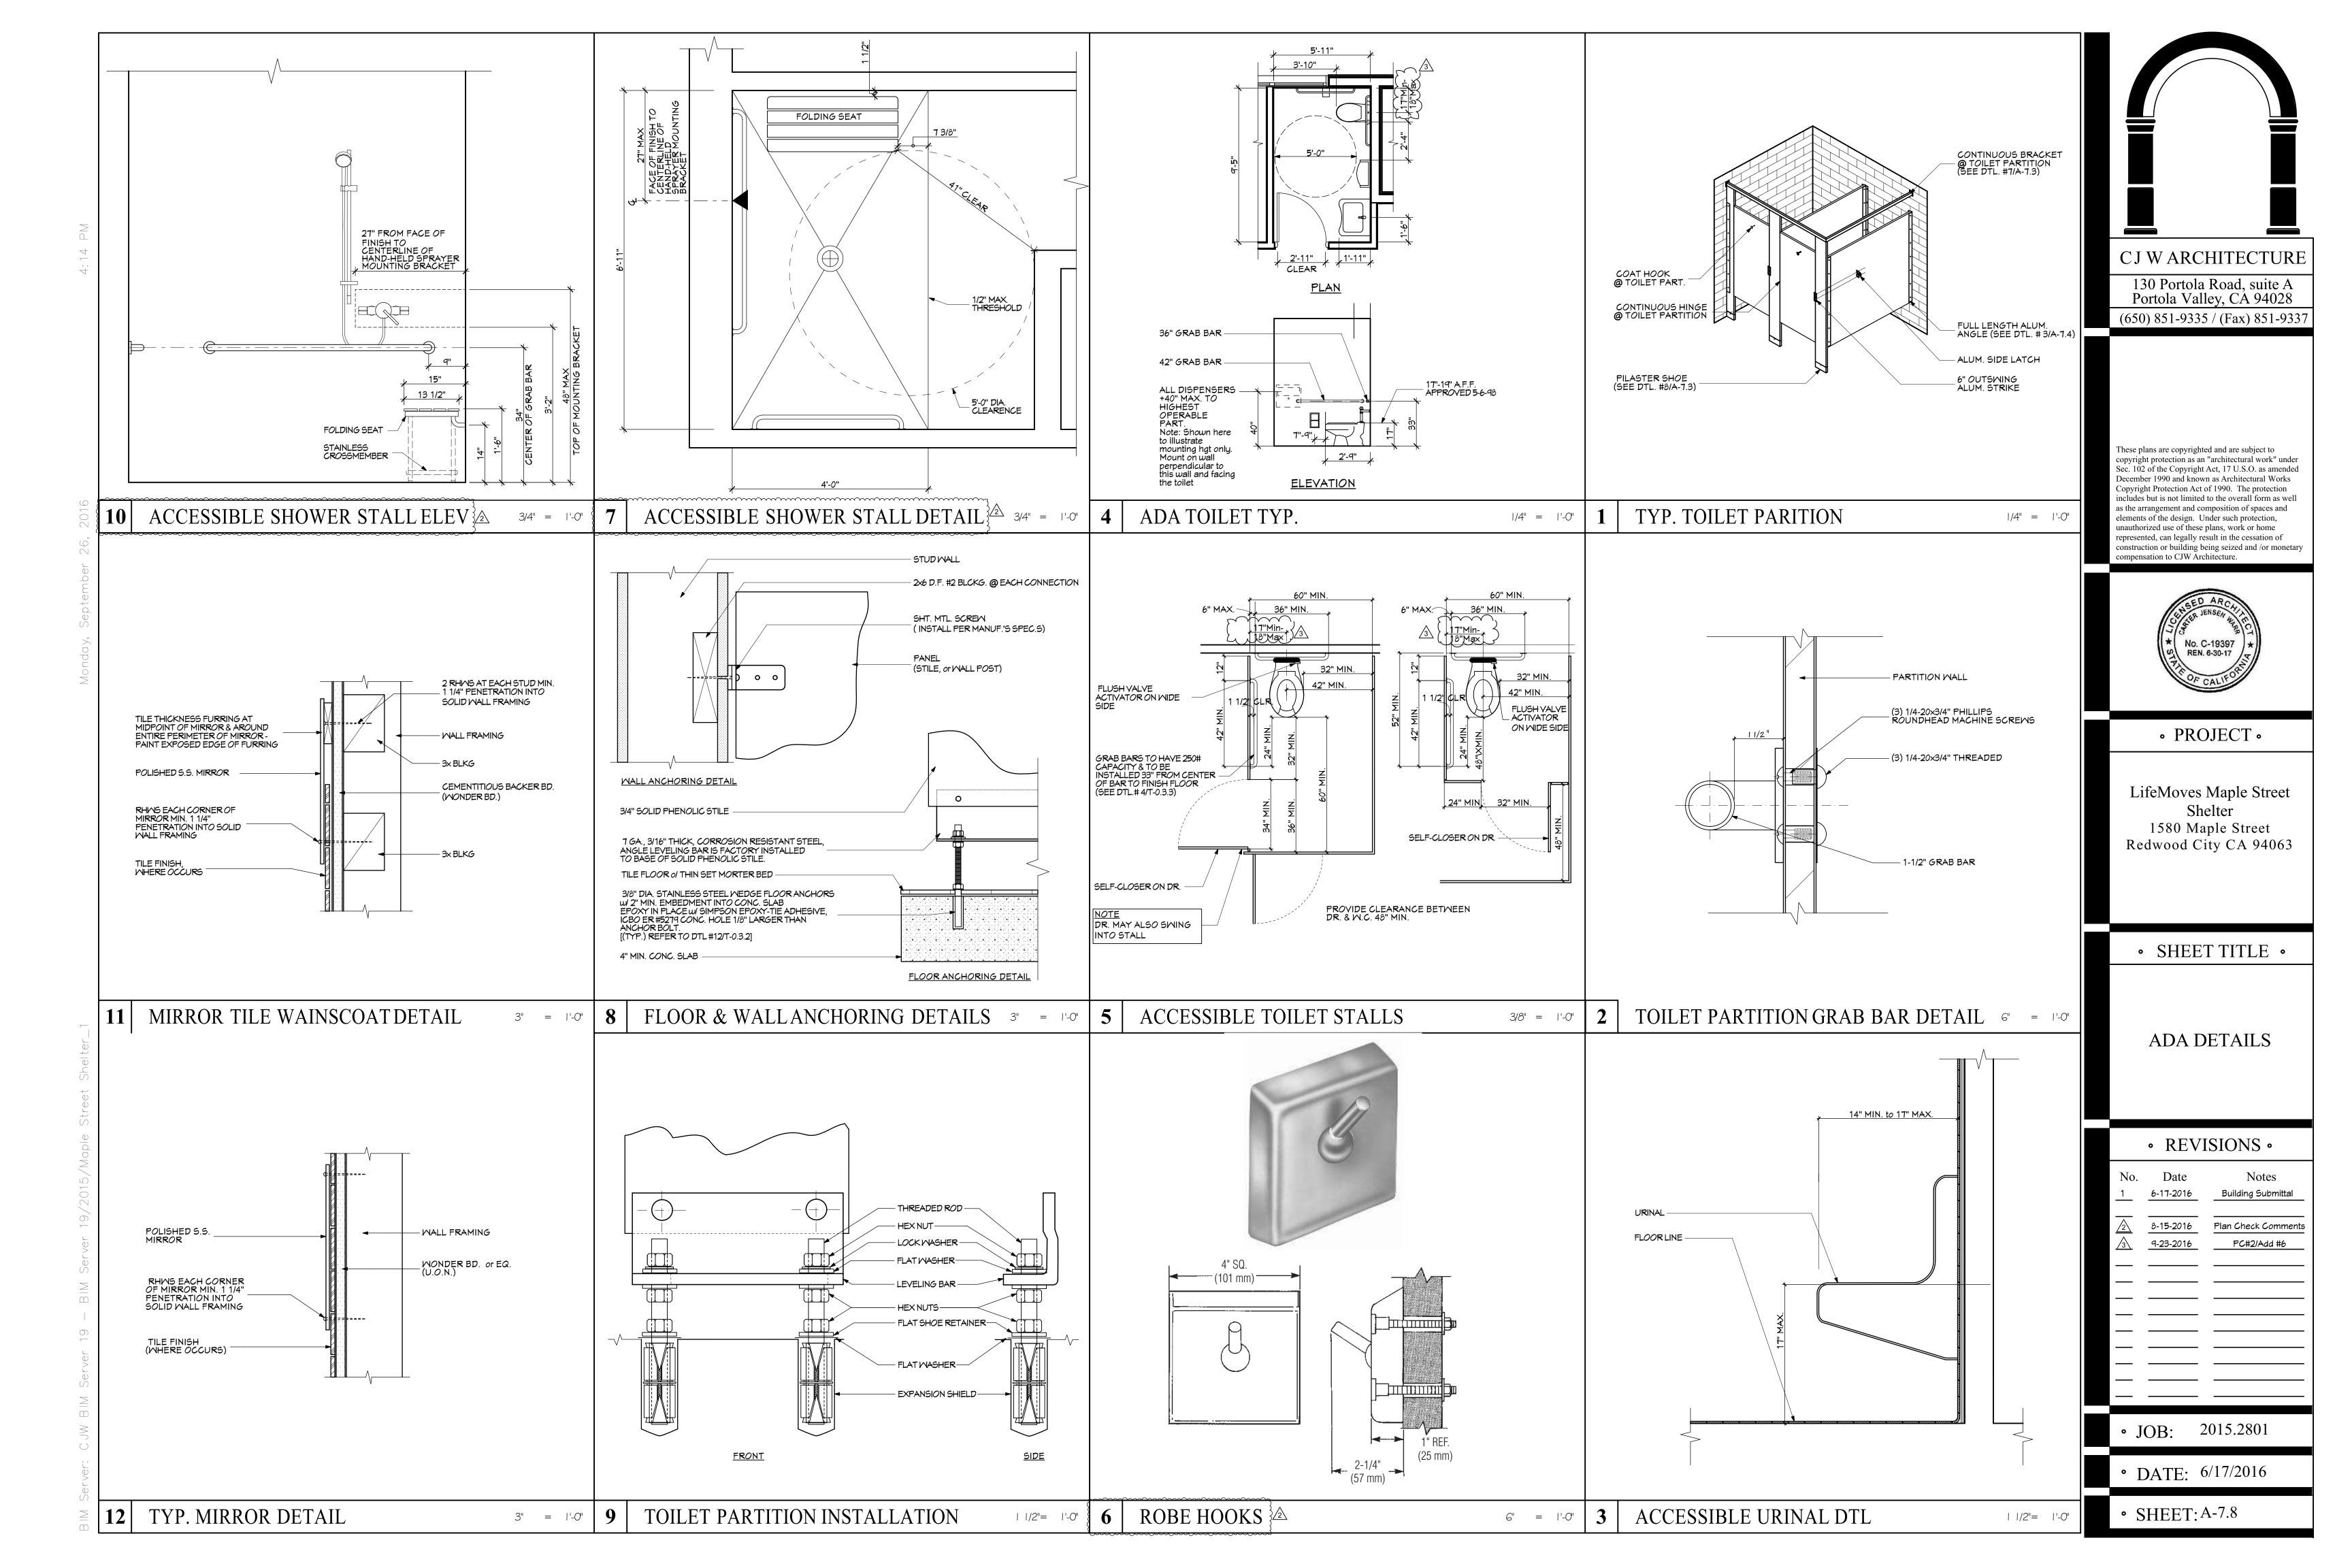

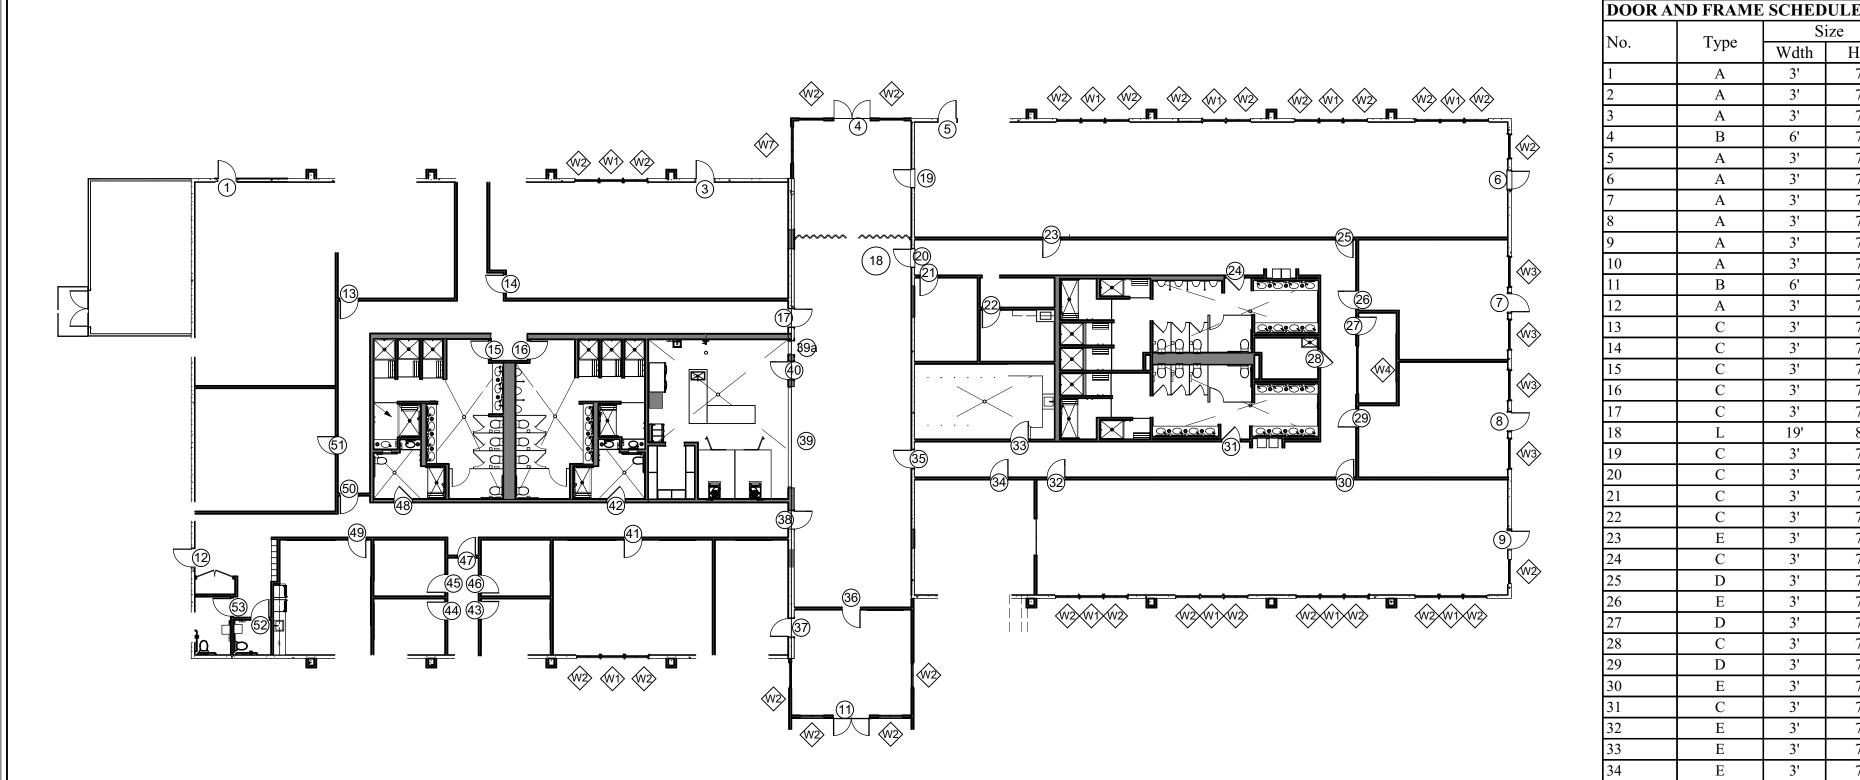


Door Frame Dr Mtrl. Fire Rtg. | Swing | Notes Hdwr Grp Matl Head Jamb Threshold Wdth R TEMPERED LIGHT ABV. R TEMPERED LIGHT ABV. HMHMHMR TEMPERED LIGHT ABV. Α HMR TEMPERED LIGHT ABV. HM HM HM R TEMPERED LIGHT ABV. R TEMPERED LIGHT ABV. HM HMHMR TEMPERED LIGHT ABV. HM HM R TEMPERED LIGHT ABV. HM R TEMPERED LIGHT ABV. R TEMPERED LIGHT ABV. A HMHM HM TEMPERED LIGHT ABV. 7' 6' HMR TEMPERED LIGHT ABV. HM MD 20 MIN R D 20 MIN R MD HM D MD 20 MIN 20 MIN R MD HMMD HM90 MIN FOLDING PARTITION ACCORDIAN PARTITION None 90 MIN HMMD D MD HM90 MIN MD HM20 MIN MD HM20 MIN L HM20 MIN MD 20 MIN L MD HMMD HM20 MIN R HM 20 MIN R MD MD HM20 MIN L MD HM20 MIN R G HM20 MIN R MD MD HM 20 MIN L MD HM20 MIN R MD HM20 MIN MD HM20 MIN HM MD 90 MIN HM MD MD 90 MIN L HM90 MIN MD HMSTEEL 90 MIN 16'-6" STEEL HM90 MIN G STEEL 90 MIN 90 MIN R MD HMHMC G MD 20 MIN R MD HM45 MIN HM MD MD HMMD MD HMMD HM 20 MIN R 45 MIN R 7' MD 20 MIN R MD HM45 MIN L MD 3' | 7' | D MD 20 MIN L 20 MIN R MD 20 MIN R MD 20 MIN L MD 6' 7' A HM

Door/Wdw Reference Plan

1/16" = 1'-0"

#### **GENERAL NOTES:**

- A) Accessible hardware is centered between 34" and 44" above the floor. CBC 11B-404.2.7 B) Provide and reference detail on floor plan to show that floor in the direction of travel shall not be more than  $\frac{1}{2}$ " lower than the threshold of the doorway. Change in level between  $\frac{1}{4}$ " and 1/2" shall be beveled with a slope no greater than 1 unit vertical to 2 units horizontal (50% slope). CBC 11B-404.2.5
- C) Operable parts of doors shall comply with CBC 11B-309.4. D) Specify that the bottom 10" of all doors to have a smooth, uninterrupted surface to allow the door to be opened by a wheelchair footrest without creating a trap or hazardous condition. CBC 11B-404.2.10

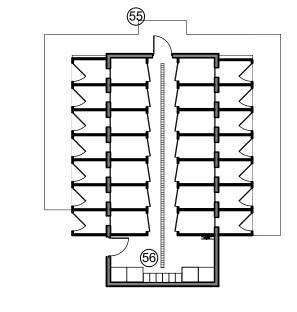



WINDOW SCHEDULE

ID	Siz	ze	Material	Head	Iomb	Sill	Tyma	Head Ht	Quantity	Notes
ID	Width	Hgt	Material	пеац	Jamb	SIII	Туре	nead ni	Qualitity	Notes
W1	4'	6'	Aluminum					9'-1 3/4"	1	
W1	4'	6'	Aluminum					9'-2"	13	
W2	4'	6'	Aluminum					9'-1 3/4"	11	
W2	4'	6'	Aluminum					9'-2"	25	
W3	5'	6'	Aluminum					9'-2"	4	
W4	8'	4'	HM				20 MIN. RATED	9'-2"	1	** SEE COMMENT BELOW
W5	2'-6"	6'	Aluminum					9'-2"	1	
W6	3'-6"	6'	Aluminum					9'-2"	1	
W7	6'	6'	Aluminum					9'-2"	1	

\*ALLOWABLE SF = 33.75 SF > 32 SF 'UAL, THUS OK. GLAZING = D-20 MARK

·	•	•	•	•		
INDOW TY	PES					A
ID	W1	W2	W3	W4	W5	
Style						
Quantity	14	. 36	4	1	1	
W x H Size	4'-0"x6'-0"	4'-0"x6'-0"	5'-0"x6'-0"	8'-0"x4'-0"	2'-6"x6'-0"	3'-
WINDOW TY	PES			20 MIN. RATED		
ID	W6	V	V7 XLouv V			
Style						
Quantity	1		1			
W x H Size	'x6'-0"	6'-0"x6'-	·0" 2'-0"x3'-			

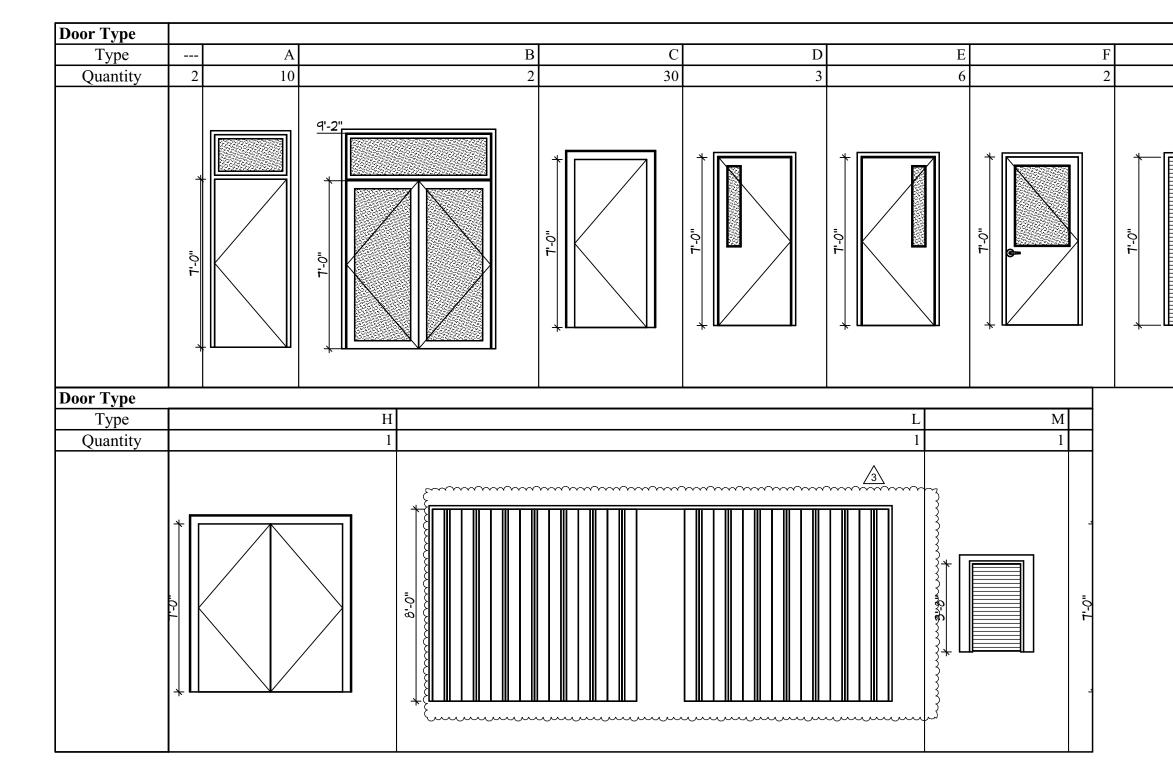

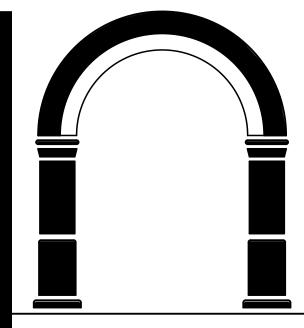

CJ W ARCHITECTURE

130 Portola Road, suite A Portola Valley, CA 94028 (650) 851-9335 / (Fax) 851-9337

These plans are copyrighted and are subject to copyright protection as an "architectural work" under Sec. 102 of the Copyright Act, 17 U.S.O. as amended December 1990 and known as Architectural Works Copyright Protection Act of 1990. The protection includes but is not limited to the overall form as well as the arrangement and composition of spaces and elements of the design. Under such protection, unauthorized use of these plans, work or home represented, can legally result in the cessation of construction or building being seized and /or monetary compensation to CJW Architecture.



• PROJECT •

LifeMoves Maple Street 1580 Maple Street Redwood City CA 94063

• SHEET TITLE •

DOOR & WINDOW SCHEDULES

• REVISIONS •

No.	Date	Notes
1_	6-17-2016	Building Submittal
2	8-15-2016	Plan Check Comments
3	9-23-2016	PCC & Add #6

• JOB: 2015.2801

• DATE: 6/17/2016

• SHEET: A-8.1

## IMPROVEMENT PLANS LIFEMOVES MAPLE STREET SHELTER 1580 MAPLE STREET

REDWOOD CITY, CALIFORNIA

**LEGEND** 

**PROPOSED** 

~~>· ~~> · ~>>

**ABBREVIATIONS** 

AB	AGGREGATE BASE	ᄕ
AC	ASPHALT CONCRETE	MAX
ACC	ACCESSIBLE	MH
AD	AREA DRAIN	MIN
BC	BEGINNING OF CURVE	MON.
3 & D	BEARING & DISTANCE	(N)
ЗМ	BENCHMARK	ŇÓ.
BW/FG	BOTTOM OF WALL/FINISH	NTS
GRADE		0.C.
CB	CATCH BASIN	
) # C	CURB AND GUTTER	0/
Č&G DPP		(PA)
<u> </u>	CENTER LINE	PED
SPP	CORRUGATED PLASTIC PIPE	PIV
	(SMOOTH INTERIOR)	PSS
00	CLEANOUT	P
COTG	CLEANOUT TO GRADE	Ρ̈́P
CONC	CONCRETE	PUE
CONST	CONSTRUCT or -TION	PVC
CONC COR	CONCRETE CORNER	R
>> 00110 001X	CUBIC YARD	
CONC COR CY OI	DIAMETER	RCP
, ,	DROP INLET	RIM
)IP	DUCTILE IRON PIPE	RW
		R/W
EA EC EG EL EP	EACH	S
<u>:C</u>	END OF CURVE	S.A.D.
<u>.</u> G	EXISTING GRADE	SAN
<u>.</u>	ELEVATIONS	SD
P	EDGE OF PAVEMENT	SDMH
Q W	EQUIPMENT	SHT
EW	EACH WAY	S.L.D.
E)	EXISTING	SPEC
<sup>‡</sup> Ć	FACE OF CURB	SS
न	FINISHED FLOOR	SSCO
Ġ	FINISHED GRADE	SSMH
Ή	FIRE HYDRANT	ST.
i.	FLOW LINE	
รัร	FINISHED SURFACE	STA
	GAS	STD
3 3A		STRUC
<del>2</del> A	GAGE OR GAUGE	Ţ
38	GRADE BREAK	TC
1DPE	HIGH DENSITY CORRUGATED	TEMP
	POLYETHYLENE PIPE	TP
IORIZ	HORIZONTAL	TW/FG
II PT	HIGH POINT	TYĖ
<del>1</del> &⊤	HUB & TACK	VC
D	INSIDE DIAMETER	VCP
NV	INVERT ELEVATION	VERT
IB	JUNCTION BOX	w/
JT	JOINT TRENCH	w w
		48 W

JOINT UTILITY POLE

LENGTH

**LANDING** 

LNDG

### DESCRIPTION

BOUNDARY FLUSH CURB PROPERTY LINE

RETAINING WALL RAINWATER TIGHTLINE SUBDRAIN LINE

TIGHTLINE STORM DRAIN LINE

SANITARY SEWER LINE WATER LINE

GAS LINE PRESSURE LINE JOINT TRENCH

SET BACK LINE CONCRETE VALLEY GUTTER

**EARTHEN SWALE** CATCH BASIN

JUNCTION BOX AREA DRAIN

CURB INLET

STORM DRAIN MANHOLE FIRE HYDRANT

SANITARY SEWER MANHOLE

SPOT ELEVATION

FLOW DIRECTION

**DEMOLISH/REMOVE** BENCHMARK

**CONTOURS** 

LINEAR FEET

MAXIMUM

MANHOLE

MINIMUM

NUMBER

MONUMENT

NOT TO SCALE

PLANTING AREA

PROPERTY LINE

POWER POLE

RIM ELEVATION

RIGHT OF WAY

RAINWATER

SANITARY

STREET

STATION

STANDARD

STRUCTURAL

TELEPHONE

TOP OF CURE

TOP OF PAVEMENT

VERTICAL CURVE

VITRIFIED CLAY PIPE

WELDED WIRE FABRIC

**TEMPORARY** 

**TYPICAL** 

VERTICAL

WATER LINE

WATER METER

STORM DRAIN

SPECIFICATION

SANITARY SEWER

RADIUS

POST INDICATOR VALVE

PUBLIC SERVICES EASEMENT

REINFORCED CONCRETE PIPE

SEE ARCHITECTURAL DRAWINGS

STORM DRAIN MANHOLE

SEE LANDSCAPE DRAWINGS

SANITARY SEWER CLEANOUT

SANITARY SEWER MANHOLE

TOP OF WALL/FINISH GRADE

PUBLIC UTILITY EASEMENT

POLYVINYL CHLORIDE

ON CENTER

PEDESTRIAN

TREE TO BE REMOVED

## **EASEMENT NOTE**

EASEMENTS SHOWN ARE PER TITLE REPORT PREPARED BY TITLE INSURANCE AND TRUST COMPANY, NO. 406153-RWC, DATED SEPTEMBER 20, 1971.

#### UTILITIES / SERVICES

SEWER **ELECTRICITY** TELEPHONE

CITY OF REDWOOD CITY PUBLIC UTILITY COMPANY CITY OF REDWOOD CITY SANITARY DISTRICT PACIFIC GAS AND ELECTRIC (PG&E) PACIFIC GAS AND ELECTRIC (PG&E) FIRE PROTECTION CITY OF REDWOOD CITY

ESTIMATED	EARTHWO	RK QUAN	NTITIES
CUBIC YARDS	СИТ	FILL	TOTAL CUBIC YARDS
BUILDING / GARAGE	30	-	30
DRIVEWAY / PARKING	-	1	_
HARDSCAPE	160	ı	160
LANDSCAPE	60	ı	60
SUBTOTAL	250		250
	250		

GRADING QUANTITIES REPRESENT BANK YARDAGE. IT DOES NOT INCLUDE ANY SWELLING OR SHRINKAGE FACTORS AND IS INTENDED TO REPRESENT IN-SITU CONDITIONS. QUANTITIES DO NOT INCLUDE OVER-EXCAVATION. TRENCHING, STRUCTURAL FOUNDATIONS OR PIERS, OR POOL EXCAVATION (IF ANY), NOTE ADDITIONAL EARTHWORKS, SUCH AS KEYWAYS OR BENCHING MAY BE REQUIRED BY THE GEOTECHNICAL ENGINEER IN THE FIELD AT TIME OF CONSTRUCTION. CONTRACTOR TO VERIFY QUANTITIES.

### **NOTES**

MAPLE STREET (80)

KEY MAP

ALL DISTANCES AND DIMENSIONS ARE IN FEET AND DECIMALS OF A FOOT.

UNDERGROUND UTILITY LOCATION IS BASED ON SURFACE EVIDENCE.

> **BUILDING FOOTPRINTS ARE** SHOWN AT GROUND LEVEL.

FINISH FLOOR ELEVATIONS ARE TAKEN AT DOOR THRESHOLD (EXTERIOR)

#### SITE BENCHMARK

SURVEY CONTROL POINT MAG AND SHINER SET IN ASPHALT ELEVATION = 7.47' (NAVD 88)

#### **BENCHMARK**

CITY OF REDWOOD CITY BENCHMARK BENCH MARK 62 MAPLE ST AT CHEMICAL WAY - SET BRASS DISC STAMPED "CITY OF REDWOOD CITY BENCHMARK" ON HEADWALL OF CULVERT IN FRONT OF REDWOOD CITY POLICE DEPARTMENT, NORTH SIDE OF CULVERT, 11' FROM FIRE HYDRANT. ELEVATION = 10.82 (NAVD 88)

## OWNER'S INFORMATION

COUNTY OF SAN MATEO 55 COUNTY CENTER-5TH FL REDWOOD CITY, CA 94063

APN: 052-532-020

#### REFERENCES

THIS GRADING AND DRAINAGE PLAN IS SUPPLEMENTAL TO: 1. TOPOGRAPHIC SURVEY BY LEA & BRAZE ENGINEERING INC., ENTITLED; "TOPOGRAPHIC SURVEY" 1580 MAPLE STREET REDWOOD CITY, CA DATED: 01-06-16 JOB#2151288

- 2. SITE PLAN BY CJW ARCHITECTURE ENTITLED: "SITE PLAN" 1580 MAPLE STREET REDWOOD CITY, CA 94063
- 3. SOIL REPORT BY XXX. ENTITLED: "XXXX" 123 MAIN ST ANYTOWN, USA JOB# XXX DATË: XXX

THE CONTRACTOR SHALL REFER TO THE ABOVE NOTED SURVEY AND PLAN, AND SHALL VERIFY BOTH EXISTING AND PROPOSED ITEMS ACCORDING TO THEM.

**NOTE:** 

FOR CONSTRUCTION STAKING

**SCHEDULING OR QUOTATIONS** 

PLEASE CONTACT ALEX ABAYA

AT LEA & BRAZE ENGINEERING

(510)887-4086 EXT 116.

aabaya@leabraze.com

#### 2. ALL APPLICABLE WORK SHALL BE DONE IN

CONTRACTOR PRIOR TO START OF ANY CONSTRUCTION AFFECTING SAID LINES.

**GENERAL NOTES** 

1. ELEVATIONS AND LOCATIONS OF ALL EXISTING UTILITY CROSSINGS SHALL BE VERIFIED BY THE

CONTACT USA AT (800) 642-2444 AT LEAST TWO WORKING DAYS PRIOR TO EXCAVATION.

ACCORDANCE WITH THE COUNTY STANDARD TECHNICAL SPECIFICATIONS AND DETAILS,

3. THE CONTRACTOR SHALL RESTORE ALL DAMAGED, REMOVED OR OTHERWISE DISTURBED

IMPROVEMENTS OR FEATURES OF WHATEVER

AND STRUCTURES TO BE SET TO GRADE IN

5. ALL STREET MONUMENTS AND OTHER

PROCESS OF CONSTRUCTION SHALL BE

WORK WITH THE INSTALLATION OF FACILITIES BY

WALLS, FENCES, SERVICES, UTILITIES,

CONCRETE AFTER PAVING.

NATURE, DUE TO CONTRACTOR'S WORK.

#### PREPARED IN THE OFFICE OF THE ENGINEERING "GRADING CERTIFICATE" (TO BE DIVISION, INCLUDING MODIFICATIONS CONTAINED

(TO BE SIGNED AT PROJECT COMPLETION) PRIOR TO OCCUPANCY, A LICENSED CIVIL ENGINEER SHALL CERTIFY TO THE COUNTY THAT THE SITE HAS BEEN GRADED TO THE ELEVATIONS SHOWN ON THE PLAN, AND THAT THE SITE WILL

PG&E. PACIFIC BELL, AND CABLE T.V. INSTALLATION. VALVE BOXES AND MANHOLES, RCE# 63127

6. THE CONTRACTOR SHALL GIVE THE CITY ISPECTOR TWO WORKING DAYS ADVANCE

NOTICE FOR INSPECTION. (650) 780-7380

7. FOR LANE CLOSURES, THE CONTRACTOR SHALL PREPARE A TRAFFIC CONTROL PLAN AND OBTAIN APPROVAL OF THE CITY ENGINEER BEFORE COMMENCING WORK. THE CONTRACTOR SHALL PROVIDE FLAGMEN, CONES OR BARRICADES, AS NECESSARY TO CONTROL TRAFFIC AND PREVENT HAZARDOUS CONDITIONS PER THE WORK AREA TRAFFIC CONTROL

8. PEDESTRIAN, PUBLIC ACCESSES, WHEELCHAIR ACCESSES SHALL BE MAINTAINED DURING THE CONSTRUCTION TO THE SATISFACTION OF THE CITY ENGINEER.

9. NO TRENCHES OR HOLES SHALL BE LEFT OPEN OVERNIGHT; USE STEEL PLATING OR HOT-MIX ASPHALT AS REQUIRED TO PROTECT OPEN TRENCHES OVERNIGHT.

10. THE CONTRACTOR SHALL CONTROL DUST AT ALL TIMES AND SWEEP STREETS AS OFTEN AS NECESSARY DURING CONSTRUCTION AS REQUIRED BY THE COUNTY ENGINEER.

11. ALL REVISIONS TO THIS PLAN MUST BE REVIEWED AND APPROVED BY THE CITY ENGINEER PRIOR TO CONSTRUCTION AND SHALL BE ACCURATELY SHOWN ON REVISED PLANS STAMPED AND SIGNED BY COUNTY ENGINEER PRIOR TO THE INSTALLATION OF THE IMPROVEMENTS.

12. ALL CONSTRUCTION STAKING FOR CURB, GUTTER, SIDEWALK, SANITARY SEWERS, STORM DRAINS, WATER LINES, FIRE HYDRANTS, ELECTROLIERS, ECT., SHALL BE DONE BY A REGISTERED CIVIL ENGINEER OF LICENSED LAND SURVEYOR.

13. IT IS THE CONTRACTOR'S RESPONSIBILITY TO OBTAIN THE MOST CURRENT VERSION OF THE DETAILS AND SPECIFICATIONS FROM THE CITY OF REDWOOD CITY AND COUNTY.

## SIGNED AT PROJECT COMPLETION)

VICINITY MAP

LICENSE EXPIRES 06-30-18 LEA & BRAZE ENGINEERING PERMANENT MONUMENTS DISTURBED DURING THE

## **"GEOTECHNICAL ENGINEER'S**

**CERTIFICATE** "REVIEWED AND APPROVED FOR CONFORMANCE WITH SOILS REPORT REQUIREMENTS".

ANNMARIE LUCCHESI GEOTECHNICAL ENGINEER

DATE

DATE

### RECORD DRAWINGS (TO BE SIGNED AT PROJECT COMPLETION)

(TO BE SIGNED AT PROJECT COMPLETION) THESE RECORD DRAWINGS ARE BASED ON LIMITED FIELD REVIEW AND FIELD SURVEYS, AS NECESSARY BY LEA AND BRAZE ENGINEERING, AND WE ASSUME NO LIABILITY FOR THE ACCURACY OF THE INFORMATION.

RCE# 63127 LICENSE EXPIRES 06-30-18 LEA & BRAZE ENGINEERING

#### SHEET INDEX TITLE SHEET C-1.0

C - 2.0DEMOLITION PLAN C - 3.0GRADING & DRAINAGE PLAN C - 3.1GRADING & DRAINAGE PLAN GRADING & DRAINAGE PLAN C - 4.0UTILITY PLAN UTILITY PLAN UTILITY PLAN **DETAILS** DETAILS **DETAILS** 

C - 6.1

DETAILS **NOTES** NOTES EROSION CONTROL PLAN EROSION CONTROL DETAILS HYDROLOGY IMPERVIOUS SURFACE EXHIBIT HYD-1 HYD-2 PROPOSED DRAINAGE EXHIBIT STORMWATER POLLUTION PREVENTION PLAN

CONSTRUC

 $\mathbf{O}$ 


1 COUNTY COMMENTS MH PC#2/ADD#6 09-23-16

REVISIONS 2151287 JOB NO: 06-17-16 DATE: SCALE: AS NOTED DESIGN BY: MH

SHEET NO:

OF 19 SHEETS

DRAWN BY: WM

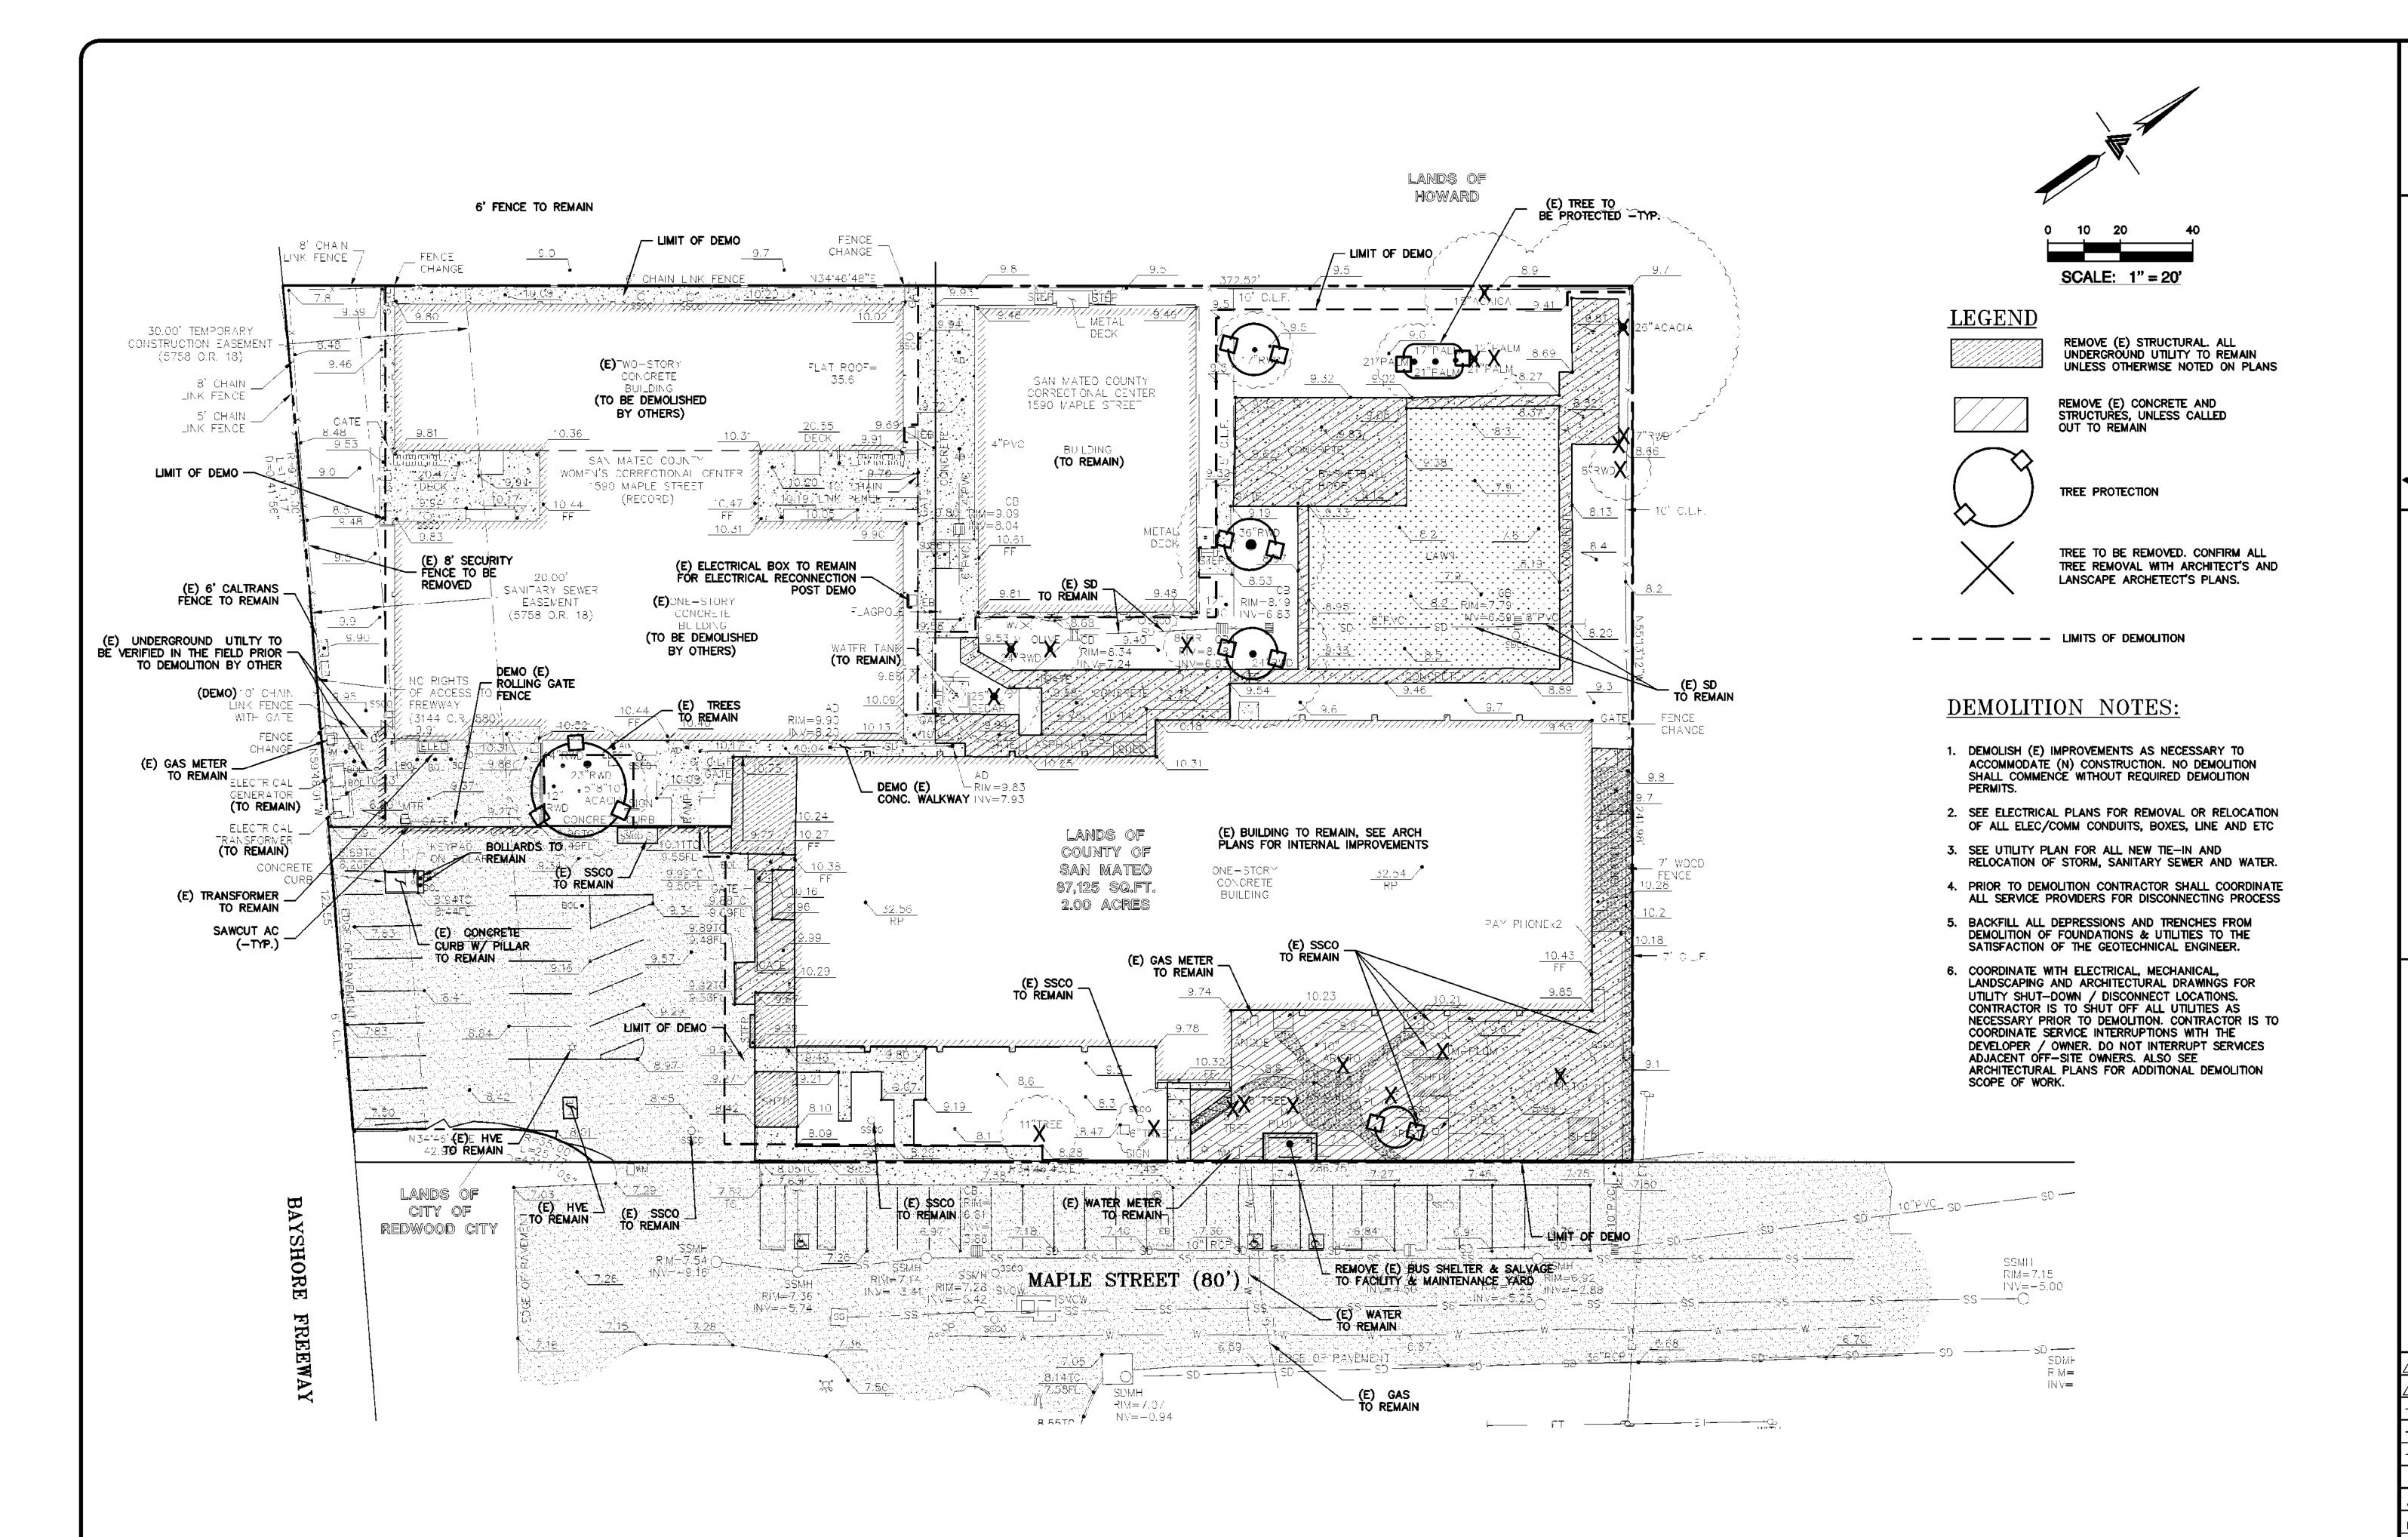



IMPROVEMENT PLANS VES MAPLE STREET SHELTER 1580 MAPLE STREET

0 0 田


1 COUNTY COMMENTS PC#2/ADD#6 09-23-16 REVISIONS JOB NO: 2151287 DATE: 06-17-16 SCALE: AS NOTED

2 OF 19 SHEETS

DESIGN BY: MH

DRAWN BY: WM

SHEET NO:

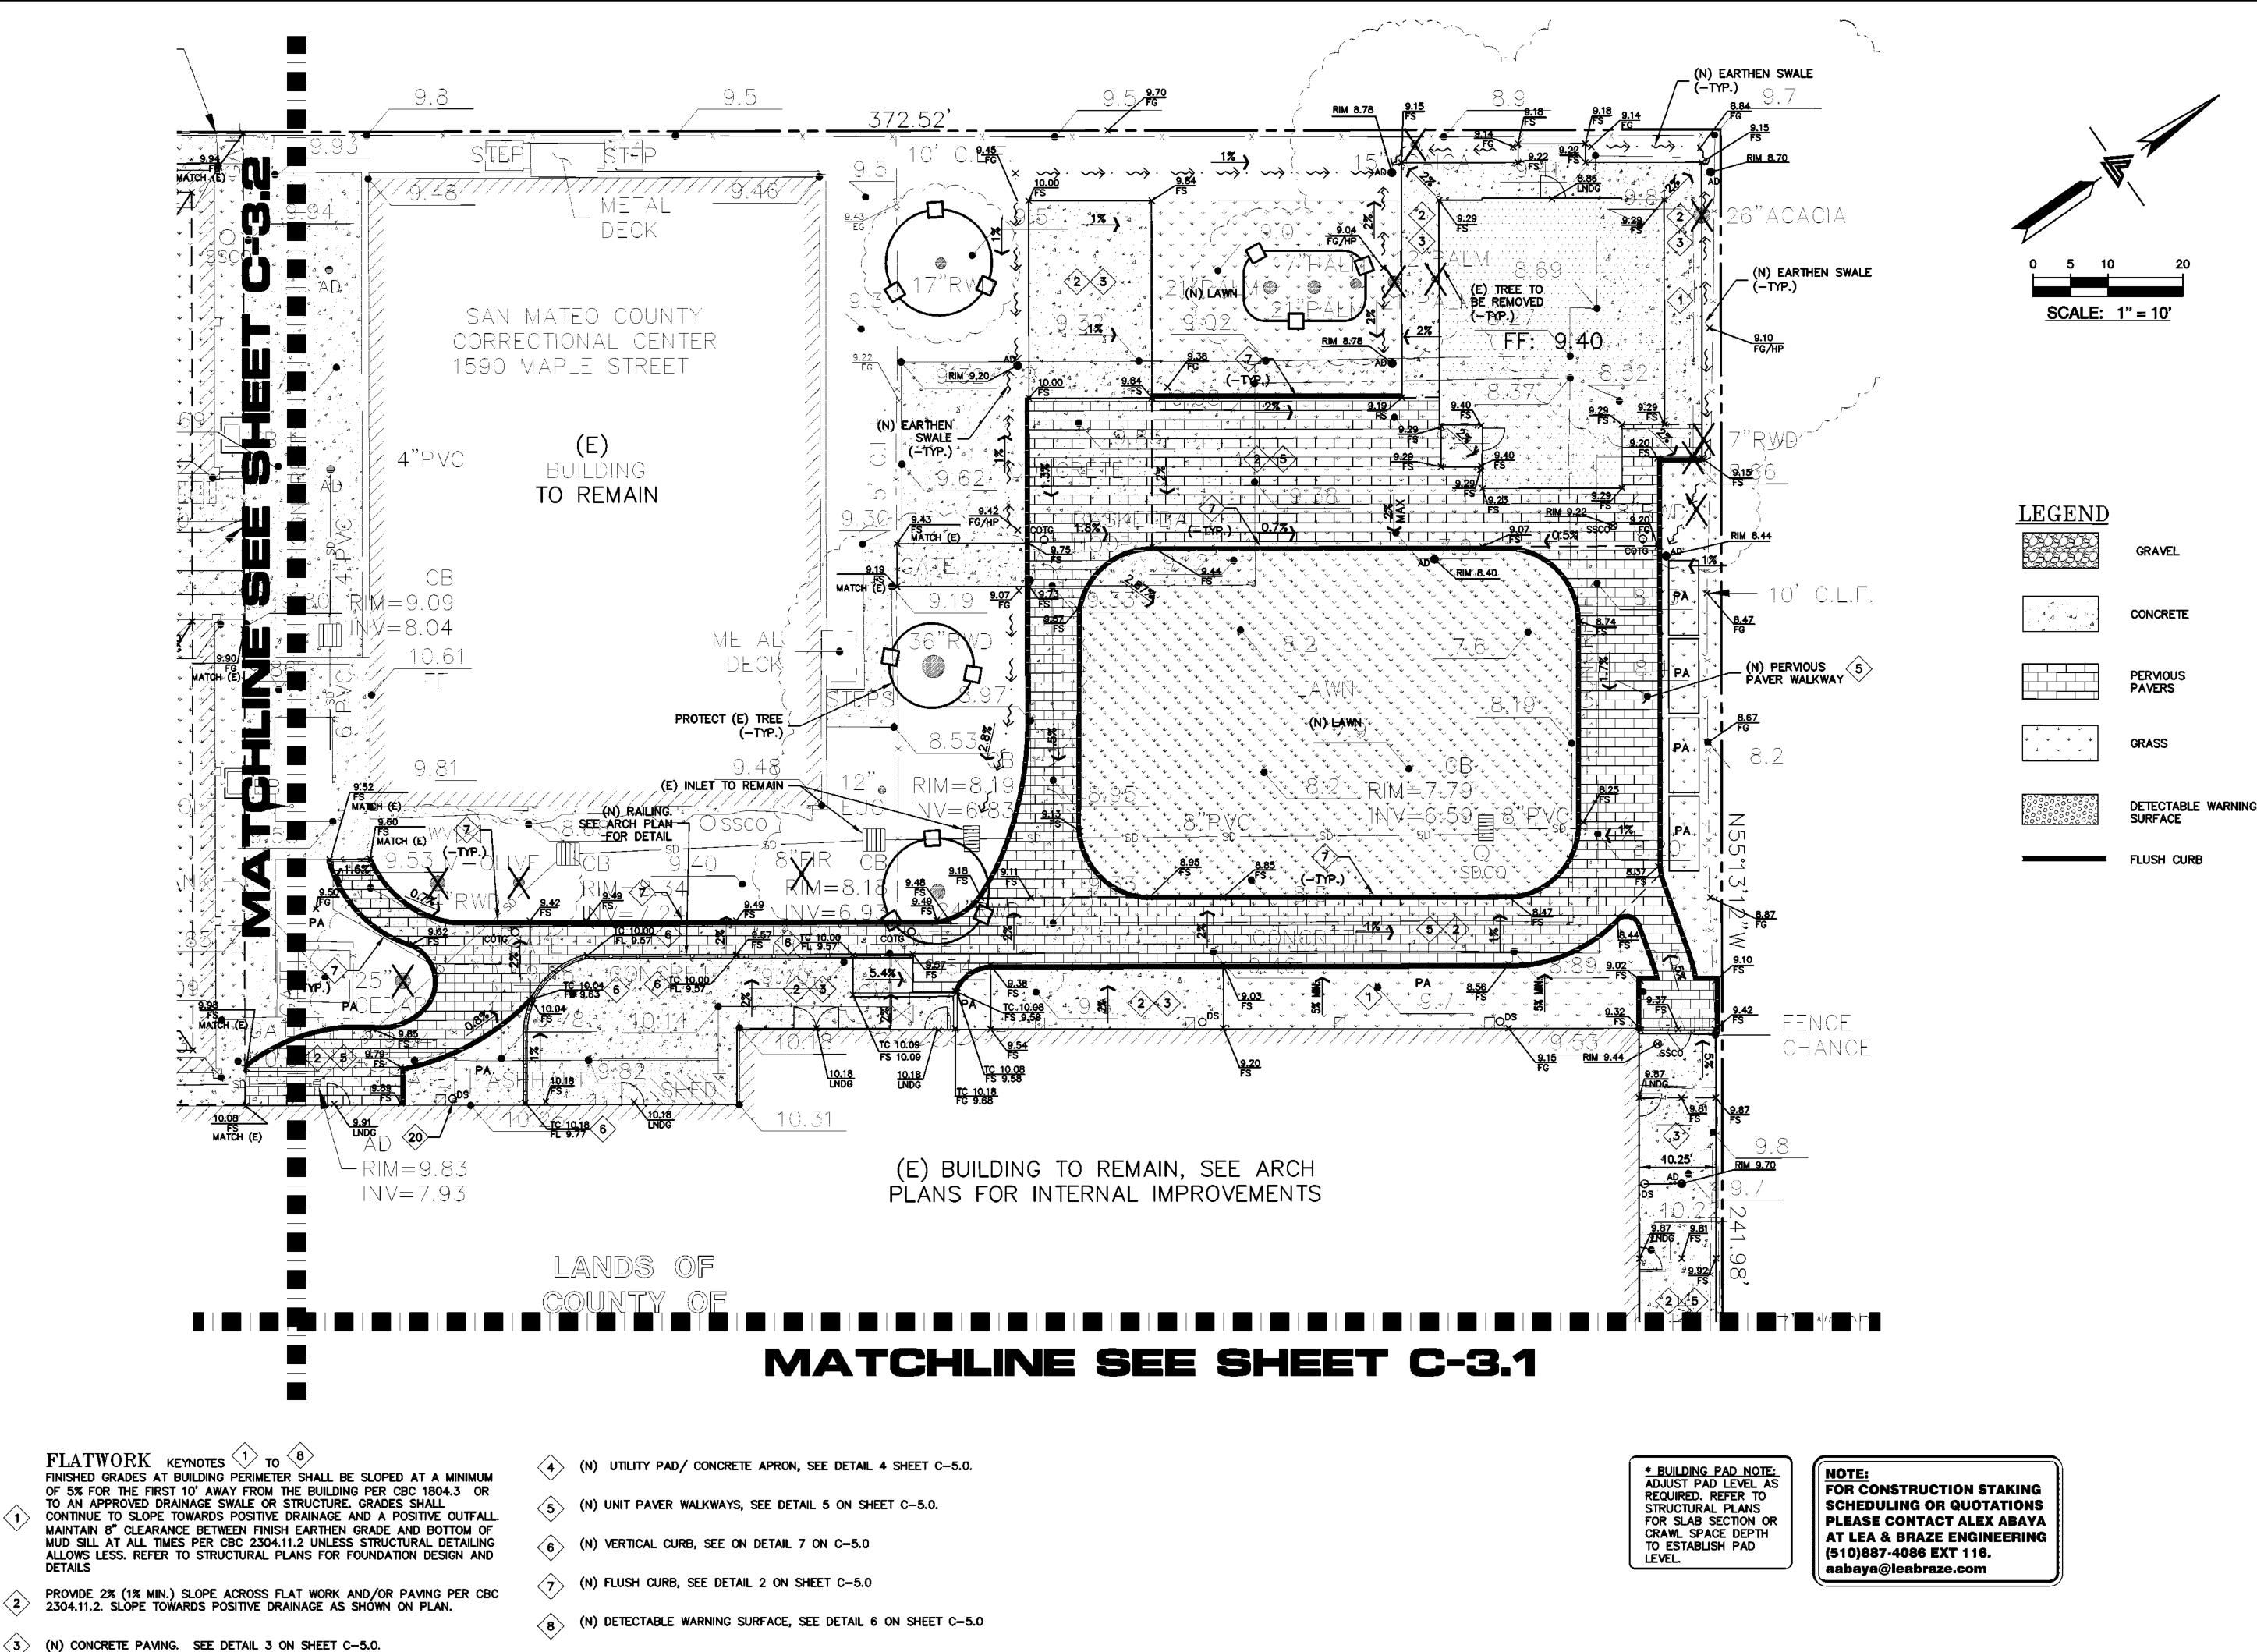

IMPROVEMENT PLANS VES MAPLE STREET SHELTER 1580 MAPLE STREET

GRADING DRAINAGE


1 COUNTY COMMENTS PC#2/ADD#6 09-23-16 REVISIONS JOB NO: 2151287 DATE: 06-17-16 SCALE: AS NOTED


SHEET NO:


3 OF 19 SHEETS

DESIGN BY: MH

DRAWN BY: WM

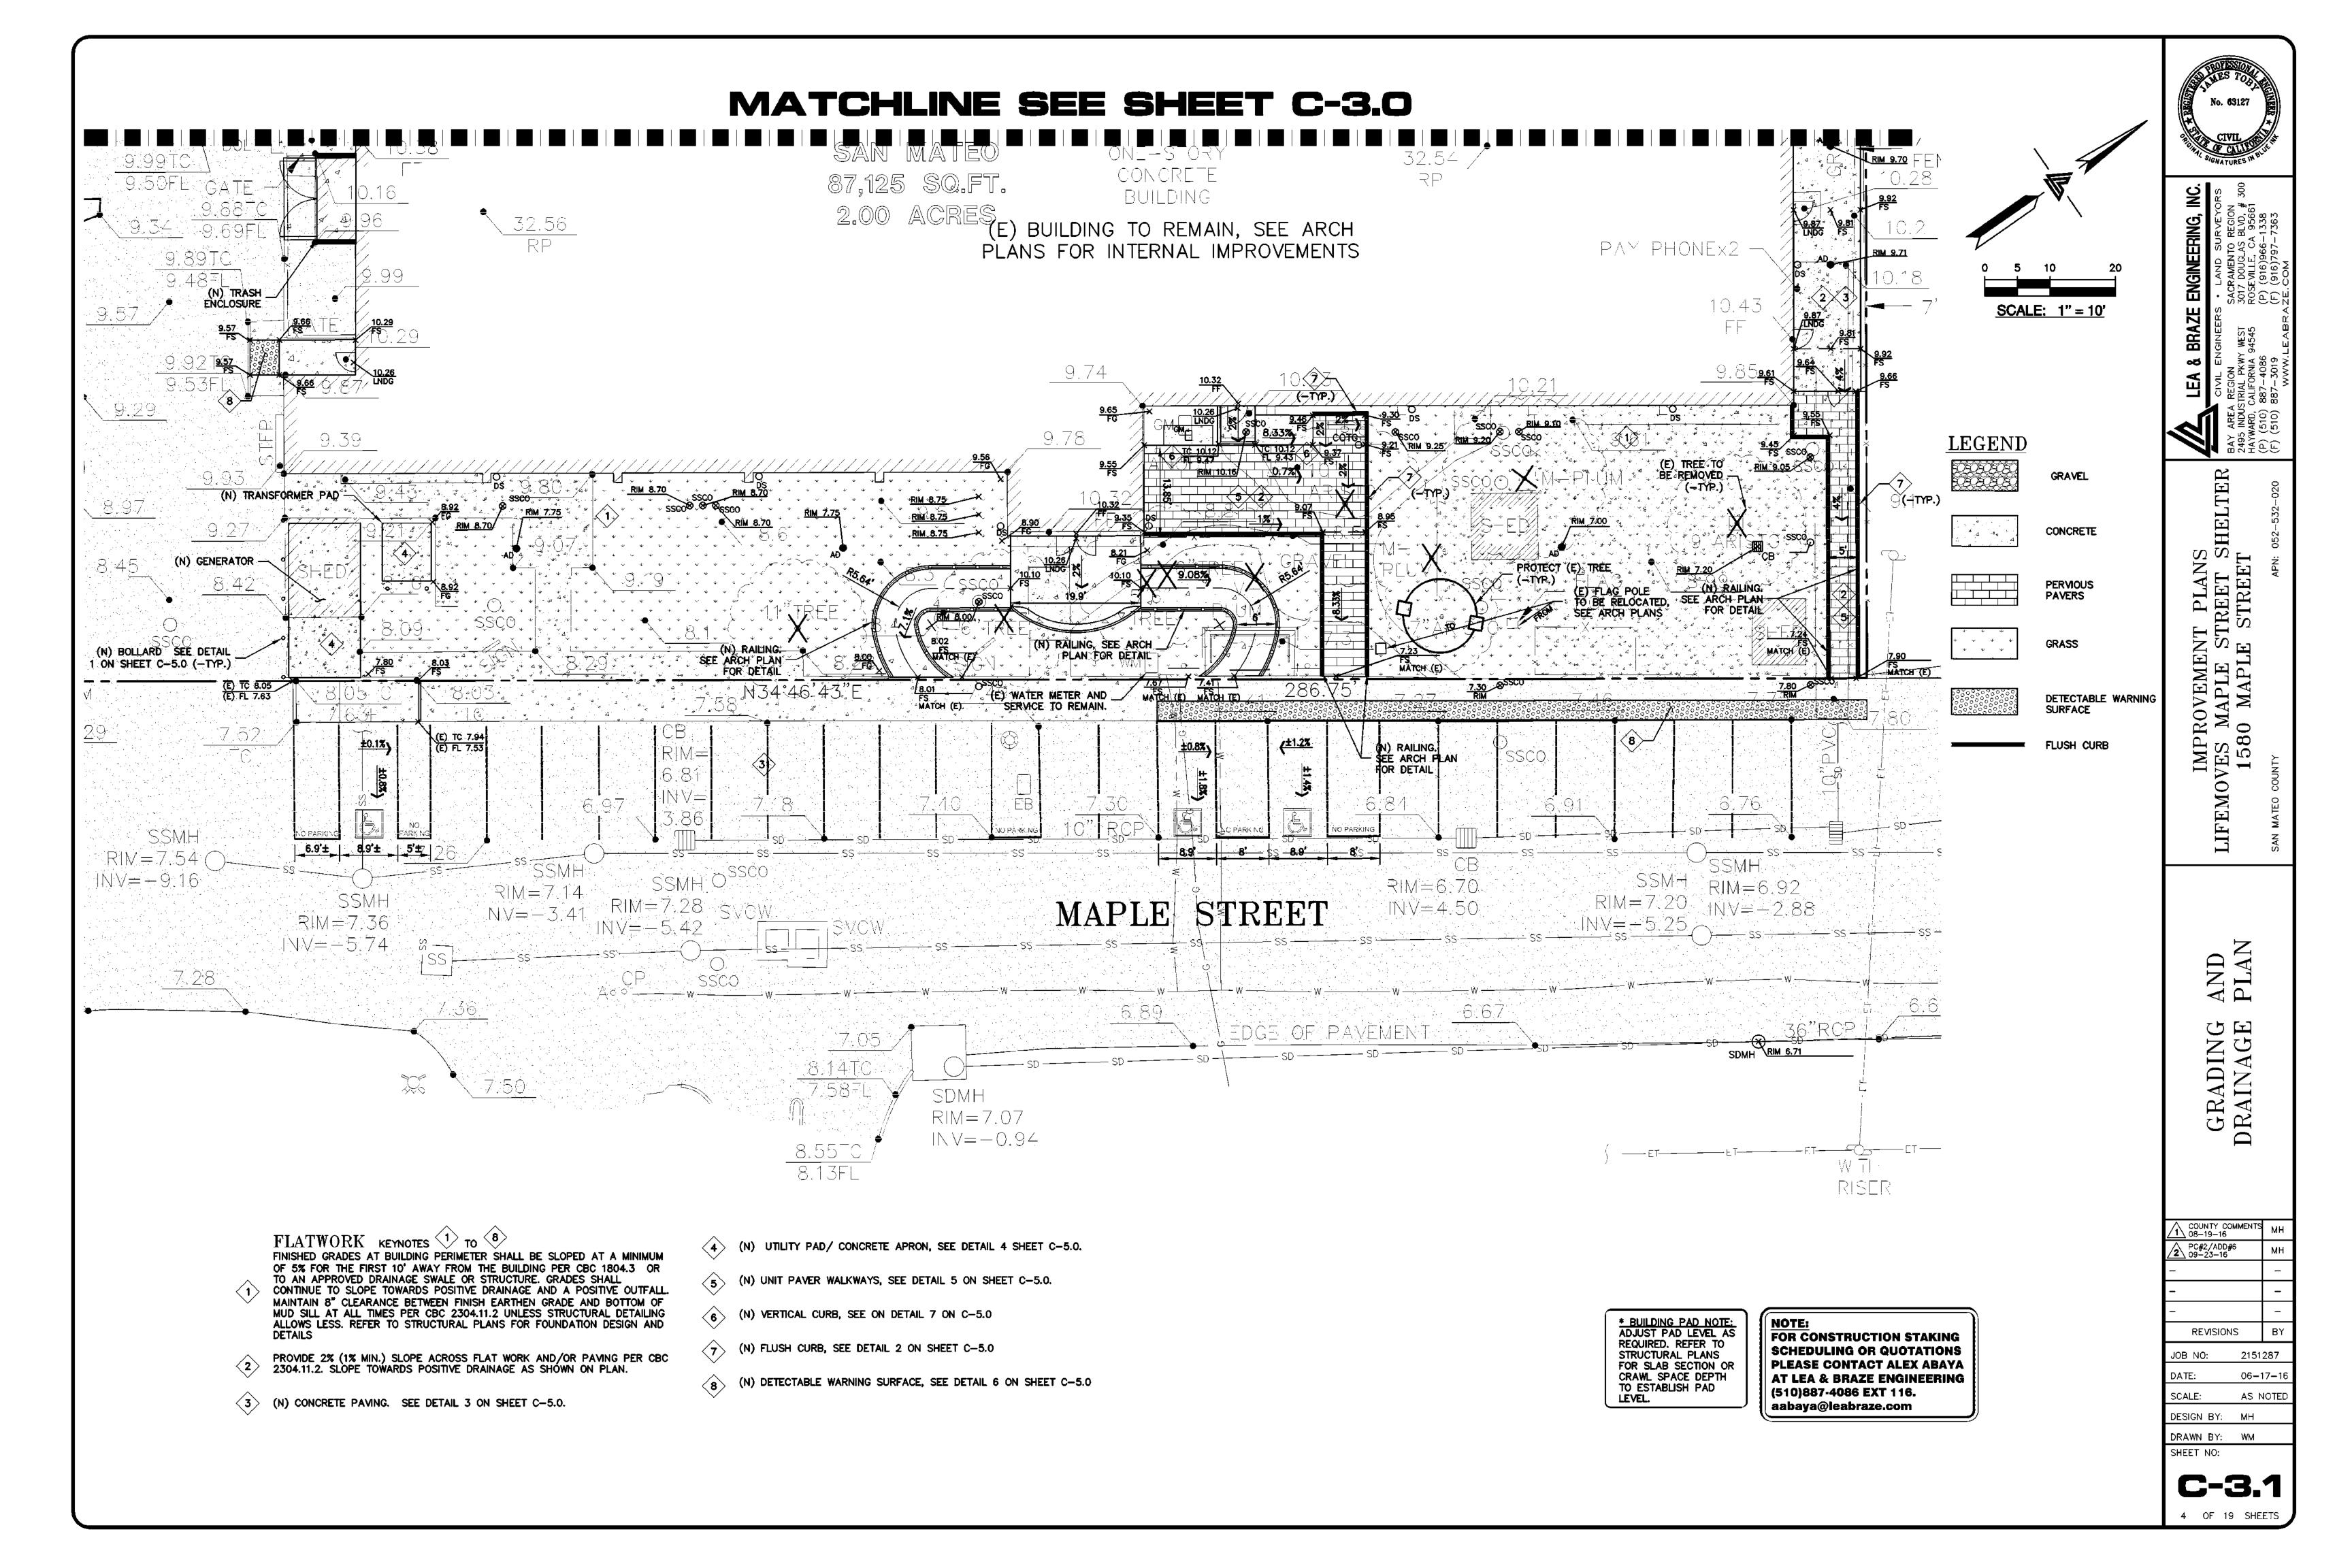

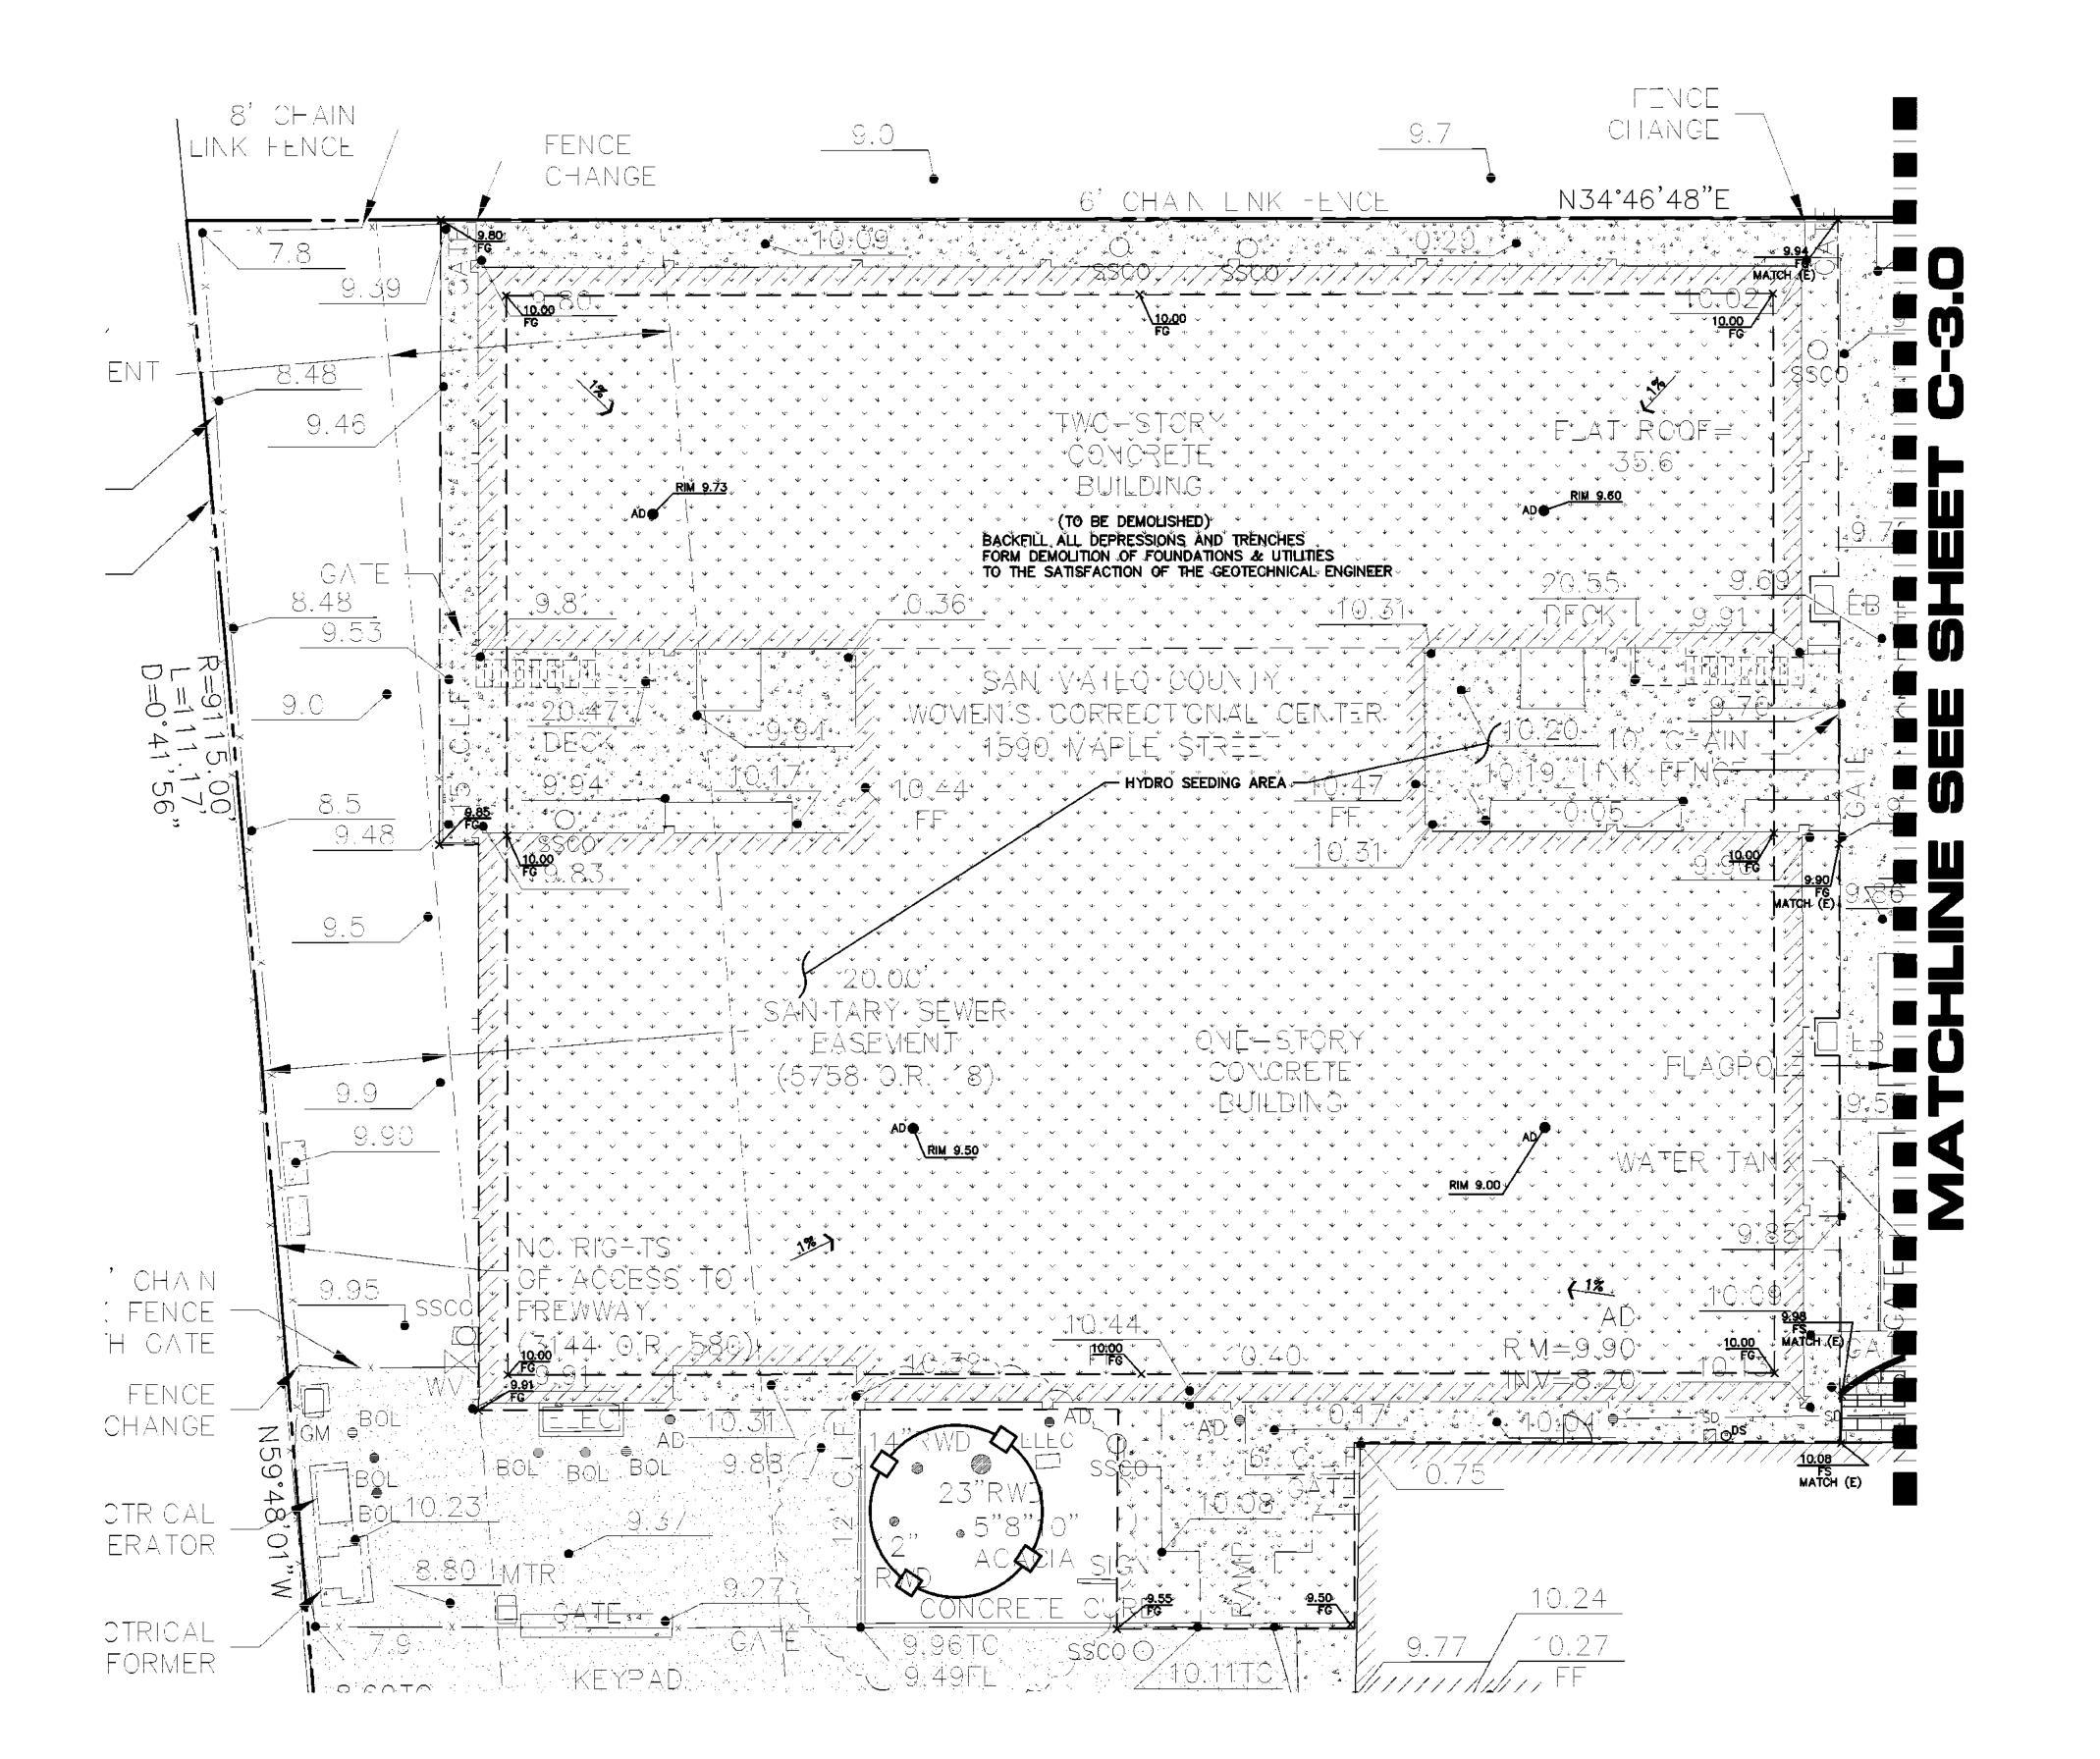

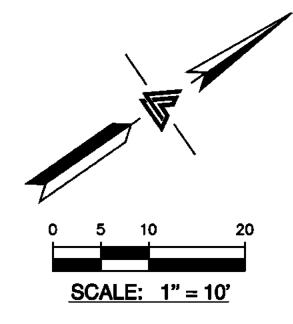

**LEGEND** 

CONCRETE

PERMOUS **PAVERS** 

DETECTABLE WARNING SURFACE

FLATWORK KEYNOTES TO 8 FINISHED GRADES AT BUILDING PERIMETER SHALL BE SLOPED AT A MINIMUM OF 5% FOR THE FIRST 10' AWAY FROM THE BUILDING PER CBC 1804.3 OR TO AN APPROVED DRAINAGE SWALE OR STRUCTURE. GRADES SHALL CONTINUE TO SLOPE TOWARDS POSITIVE DRAINAGE AND A POSITIVE OUTFALL. MAINTAIN 8" CLEARANCE BETWEEN FINISH EARTHEN GRADE AND BOTTOM OF MUD SILL AT ALL TIMES PER CBC 2304.11.2 UNLESS STRUCTURAL DETAILING ALLOWS LESS. REFER TO STRUCTURAL PLANS FOR FOUNDATION DESIGN AND

- PROVIDE 2% (1% MIN.) SLOPE ACROSS FLAT WORK AND/OR PAVING PER CBC 2304.11.2. SLOPE TOWARDS POSITIVE DRAINAGE AS SHOWN ON PLAN.
- (3) (N) CONCRETE PAVING. SEE DETAIL 3 ON SHEET C-5.0.
- (N) UTILITY PAD/ CONCRETE APRON, SEE DETAIL 4 SHEET C-5.0.
- (N) UNIT PAVER WALKWAYS, SEE DETAIL 5 ON SHEET C-5.0.
- (N) VERTICAL CURB, SEE ON DETAIL 7 ON C-5.0
- (N) FLUSH CURB, SEE DETAIL 2 ON SHEET C-5.0
- (N) DETECTABLE WARNING SURFACE, SEE DETAIL 6 ON SHEET C-5.0

\* BUILDING PAD NOTE: ADJUST PAD LEVEL AS REQUIRED. REFER TO STRUCTURAL PLANS FOR SLAB SECTION OR CRAWL SPACE DEPTH TO ESTABLISH PAD LEVEL.

FOR CONSTRUCTION STAKING **SCHEDULING OR QUOTATIONS** PLEASE CONTACT ALEX ABAYA AT LEA & BRAZE ENGINEERING (510)887-4086 EXT 116. aabaya@leabraze.com




GRADING DRAINAGE

1 COUNTY COMMENTS PC#2/ADD#6 09-23-16 REVISIONS JOB NO: 2151287

DATE: 06-17-16 SCALE: AS NOTED DESIGN BY: MH

DRAWN BY: WM SHEET NO:

5 OF 19 SHEETS

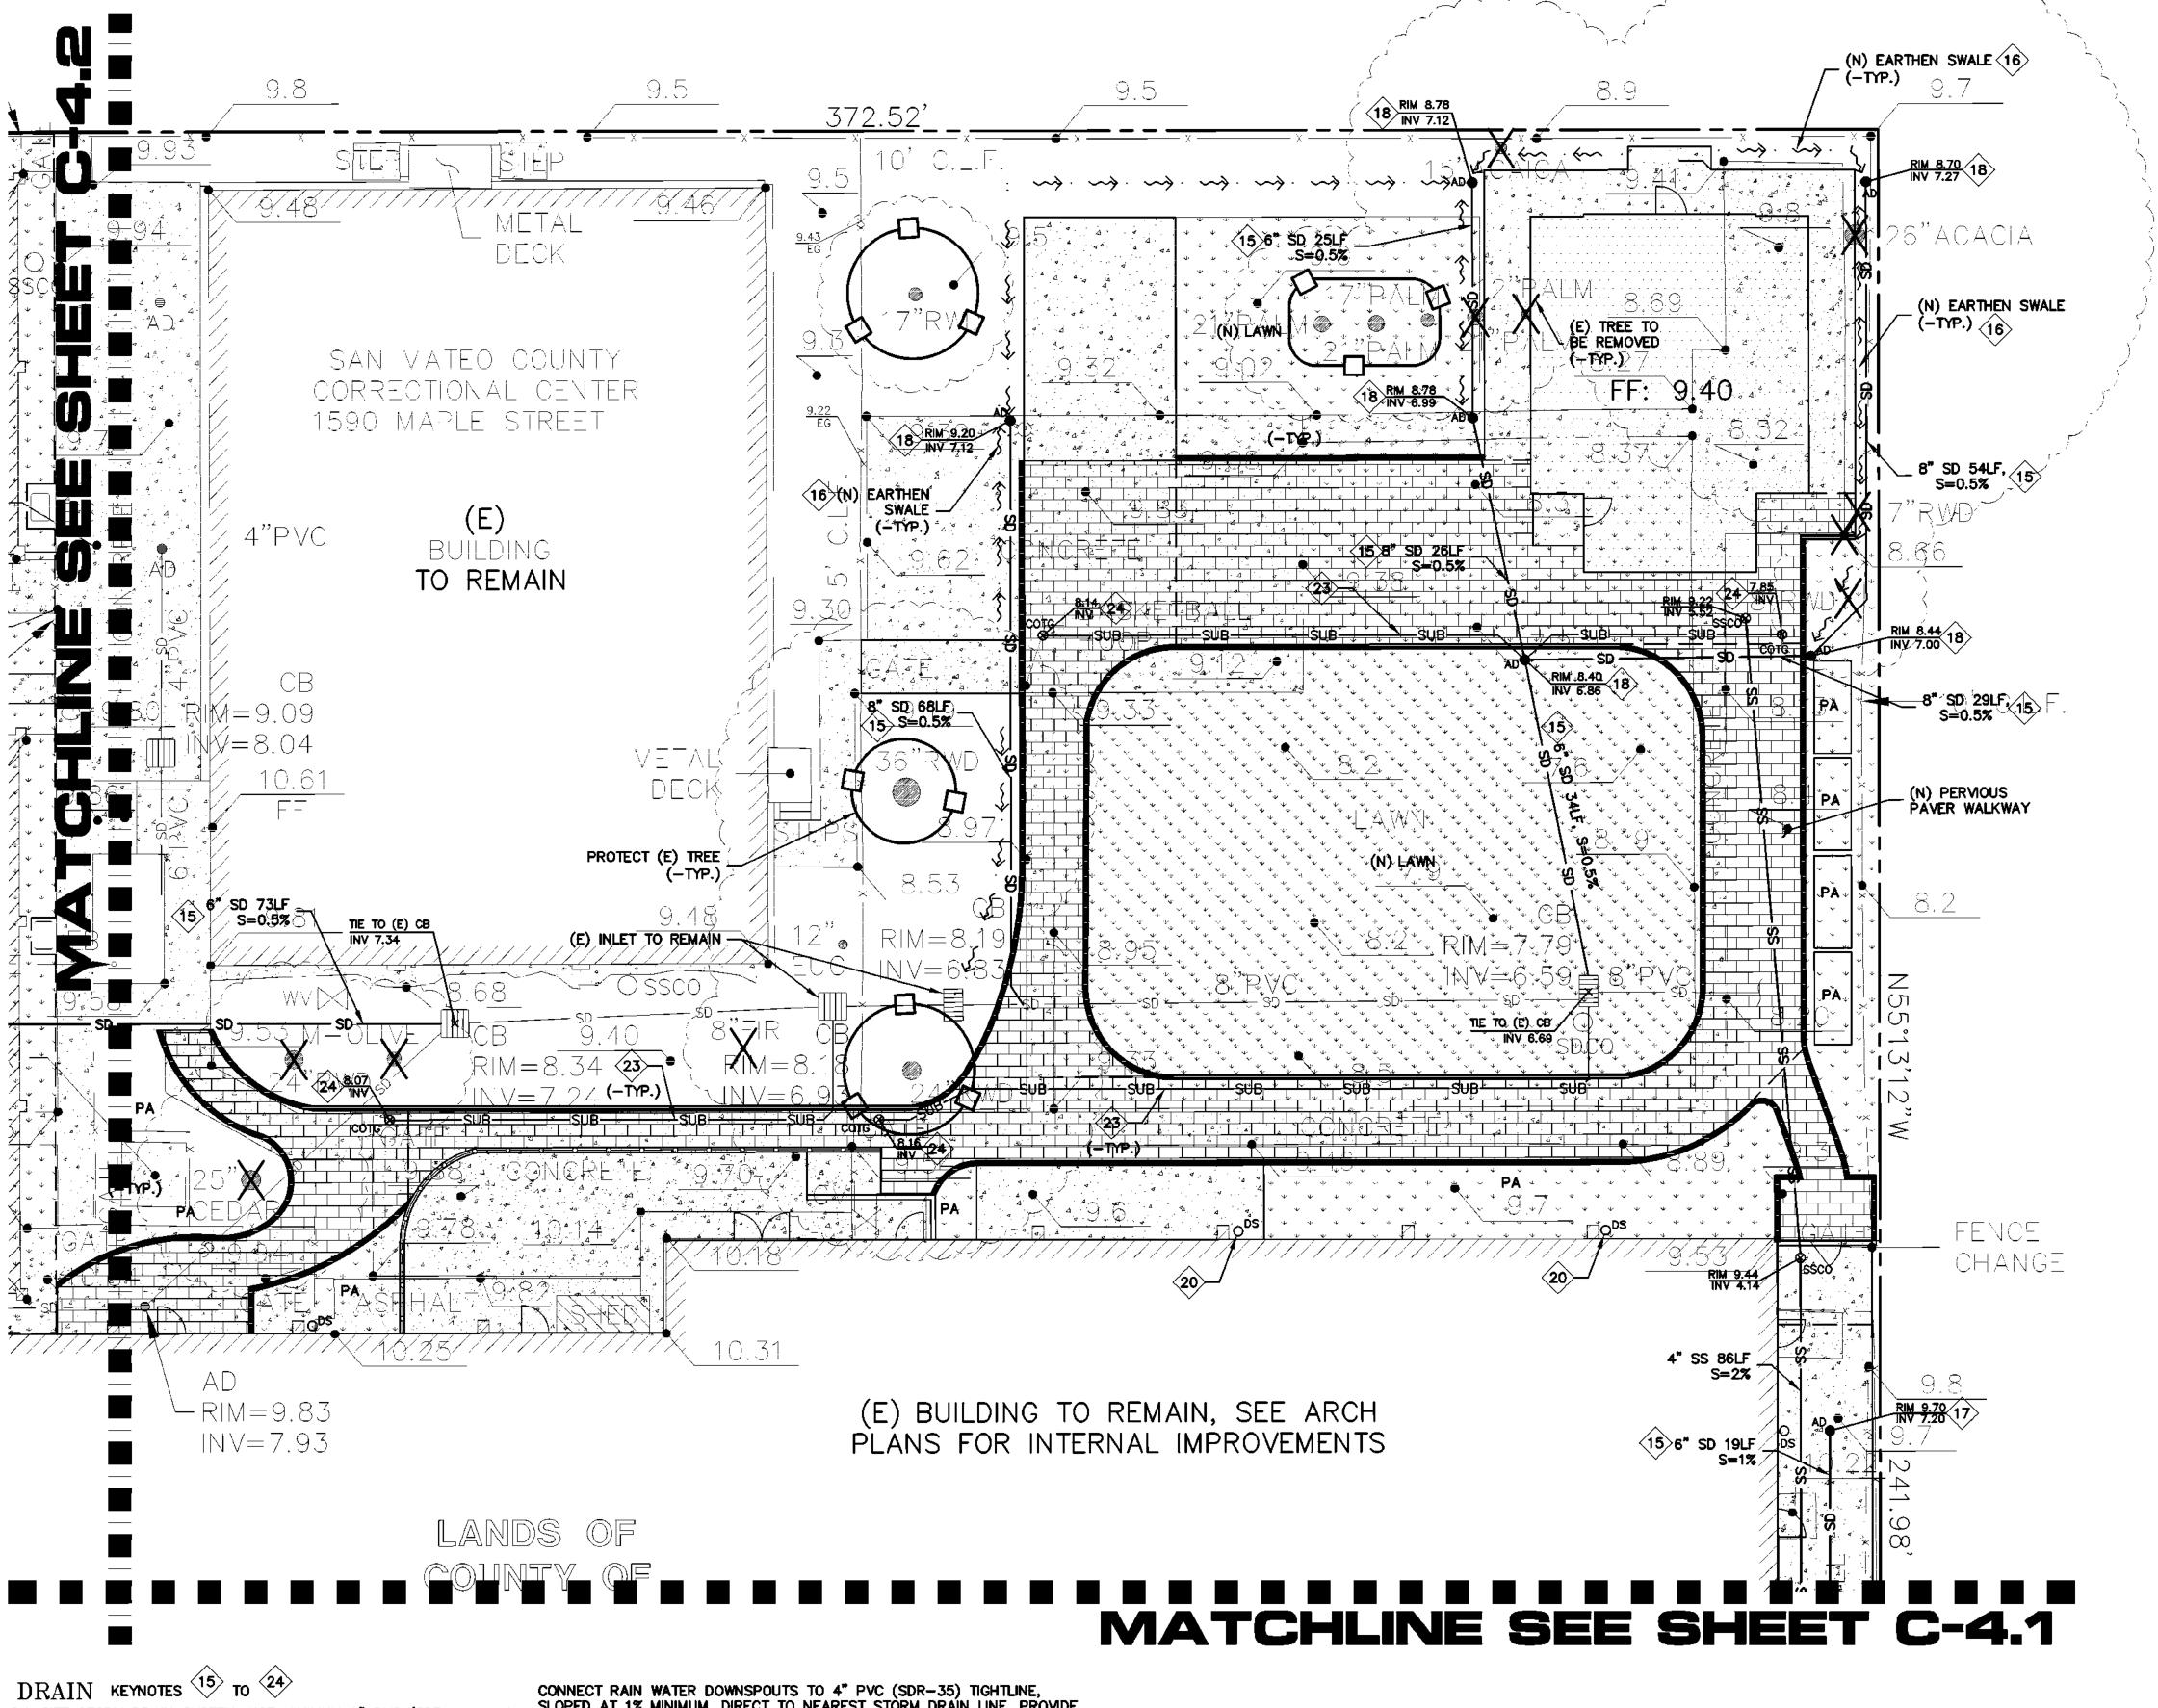

STORM DRAIN KEYNOTES (15) TO (24)

INSTALL (N) ON-SITE STORM DRAIN SYSTEM. USE MINIMUM 6" PVC (SDR 35) OR HDPE (ADS N-12 W/ SMOOTH INTERIOR WALLS). MAINTAIN 24"

MINIMUM COVER AND SLOPED AT 1% MINIMUM AT ALL TIMES UNLESS OTHERWISE NOTED. PROVIDE CLEAN OUT TO GRADE AT MAJOR CHANGES IN DIRECTION. AVOID USING 90° BENDS AND INSTEAD USE (2) 45° BENDS AND WYE CONNECTIONS.

- CONSTRUCT (N) EARTHEN SWALE SLOPED AT 1% MINIMUM TOWARDS POSITIVE OUTFALL. SEE DETAIL 1 ON SHEET C-5.1.
- INSTALL (N) 4" DIAMETER BRASS AREA DRAIN (AD) IN HARDSCAPE AREAS (NDS PART 90C). SEE DETAIL 2 ON C-5.1.
- INSTALL (N) 4" DIAMETER BRASS ATRIUM GRATE IN LANDSCAPE OR (18) PLANTER AREAS (NDS PART 78B OR 90B FOR 6" DIAMETER BRASS ATRIUM GRATE). DO NOT USE PLASTIC GRATES. SEE DETAIL 3 ON C-5.1.
- INSTALL (N) "CENTRAL PRECAST CP2424". SEE DETAIL 5 & 6 SHEET 19 C-5.1. PER CITY STANDARD DETAIL D-2 ON SHEET C-5.2
- OR OTHER HARD SURFACE, DIRECT AWAY FROM ANY STRUCTURE AND DIRECT DOWNSPOUTS TO 24" LONG PRECAST CONCRETE SPLASHBLOCKS TOWARDS POSITIVE DRAINAGE. SEE DETAIL 4A ON SHEET C-5.1

CONNECT RAIN WATER DOWNSPOUTS TO 4" PVC (SDR-35) TIGHTLINE, SLOPED AT 1% MINIMUM. DIRECT TO NEAREST STORM DRAIN LINE. PROVIDE CLEAN OUT TO GRADE AT MAJOR CHANGES IN DIRECTION. AVOID USING 90° BENDS AND INSTEAD USE (2) 45° BENDS. TIGHTLINE MAY BE PLACED IN COMMON TRENCH WITH SUBDRAIN LINES, HOWEVER, NOT CONNECT TO SUBDRAIN LINES. CONNECT TO NEAREST STORM DRAIN LINE AS SHOWN ON PLAN. SEE DETAIL 4B ON SHEET C-4.1.

INSTALL (N) STORM DRAIN MANHOLE PER CITY STANDARD DETAIL M-3 ON SHEET C-5.2.

INSTALL (N) SUBDRAIN. USE PERFORATED 4" PVC (SDR-35) WITH HOLES DOWN AND SLOPED AT 1% MINIMUM SURROUND WITH 3/4" DRAIN ROCK WRAPPED IN FILTER FABRIC (MIRAFI 140N). MIRADRAIN OR OTHER LEA &

- BRAZE PREAPPROVED DRAINAGE SYSTEM MAY ALSO BE USED. AVOID USING 90° BENDS AND INSTEAD USE (2) 45° BENDS AND WYE CONNECTIONS. PROVIDE CLEANOUT TO GRADE AT MAJOR CHANGES IN DIRECTION AND AT 100' MAXIMUM INTERVALS. SUBDRAIN SHALL REMAIN A DEDICATED SEPARATE SYSTEM UNTIL IT CONNECTS TO STORM DRAIN SYSTEM OR OUTFALL AS SHOWN. SEE DETAIL 5 ON C-5.0.
- (24) INSTALL (N) CLEANOUT. SEE DETAIL 5 ON SHEET C-5.1.

UTILITIES KEYNOTES (31) TO (32)

- > INSTALL (N) SANITARY SEWER LATERALS PER CITY STANDARD DETAILS S-1 & S-4 ON SHEET C-5.2.
- INSTALL (N) UTILITY TRENCH PER CITY STANDARD DETAIL UT-1 ON SHEET C-5.3


\* BUILDING PAD NOTE: ADJUST PAD LEVEL AS REQUIRED. REFER TO STRUCTURAL PLANS FOR SLAB SECTION OR CRAWL SPACE DEPTH TO ESTABLISH PAD LEVEL.

NOTE: FOR CONSTRUCTION STAKING SCHEDULING OR QUOTATIONS PLEASE CONTACT ALEX ABAYA AT LEA & BRAZE ENGINEERING (510)887-4086 EXT 116. aabaya@leabraze.com

**SCALE: 1" = 10'** 

**LEGEND** 

CONCRETE

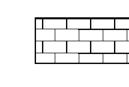

PERMOUS PAVERS



DETECTABLE WARNING SURFACE

FLUSH CURB


IMPROVEMENT PLANS MOVES MAPLE STREET SHELTER 1580 MAPLE STREET


1 COUNTY COMMENTS PC#2/ADD#6 09-23-16 REVISIONS JOB NO: 2151287 DATE: 06-17-16 SCALE: AS NOTED

SHEET NO: 6 OF 19 SHEETS

DESIGN BY: MH

DRAWN BY: WM

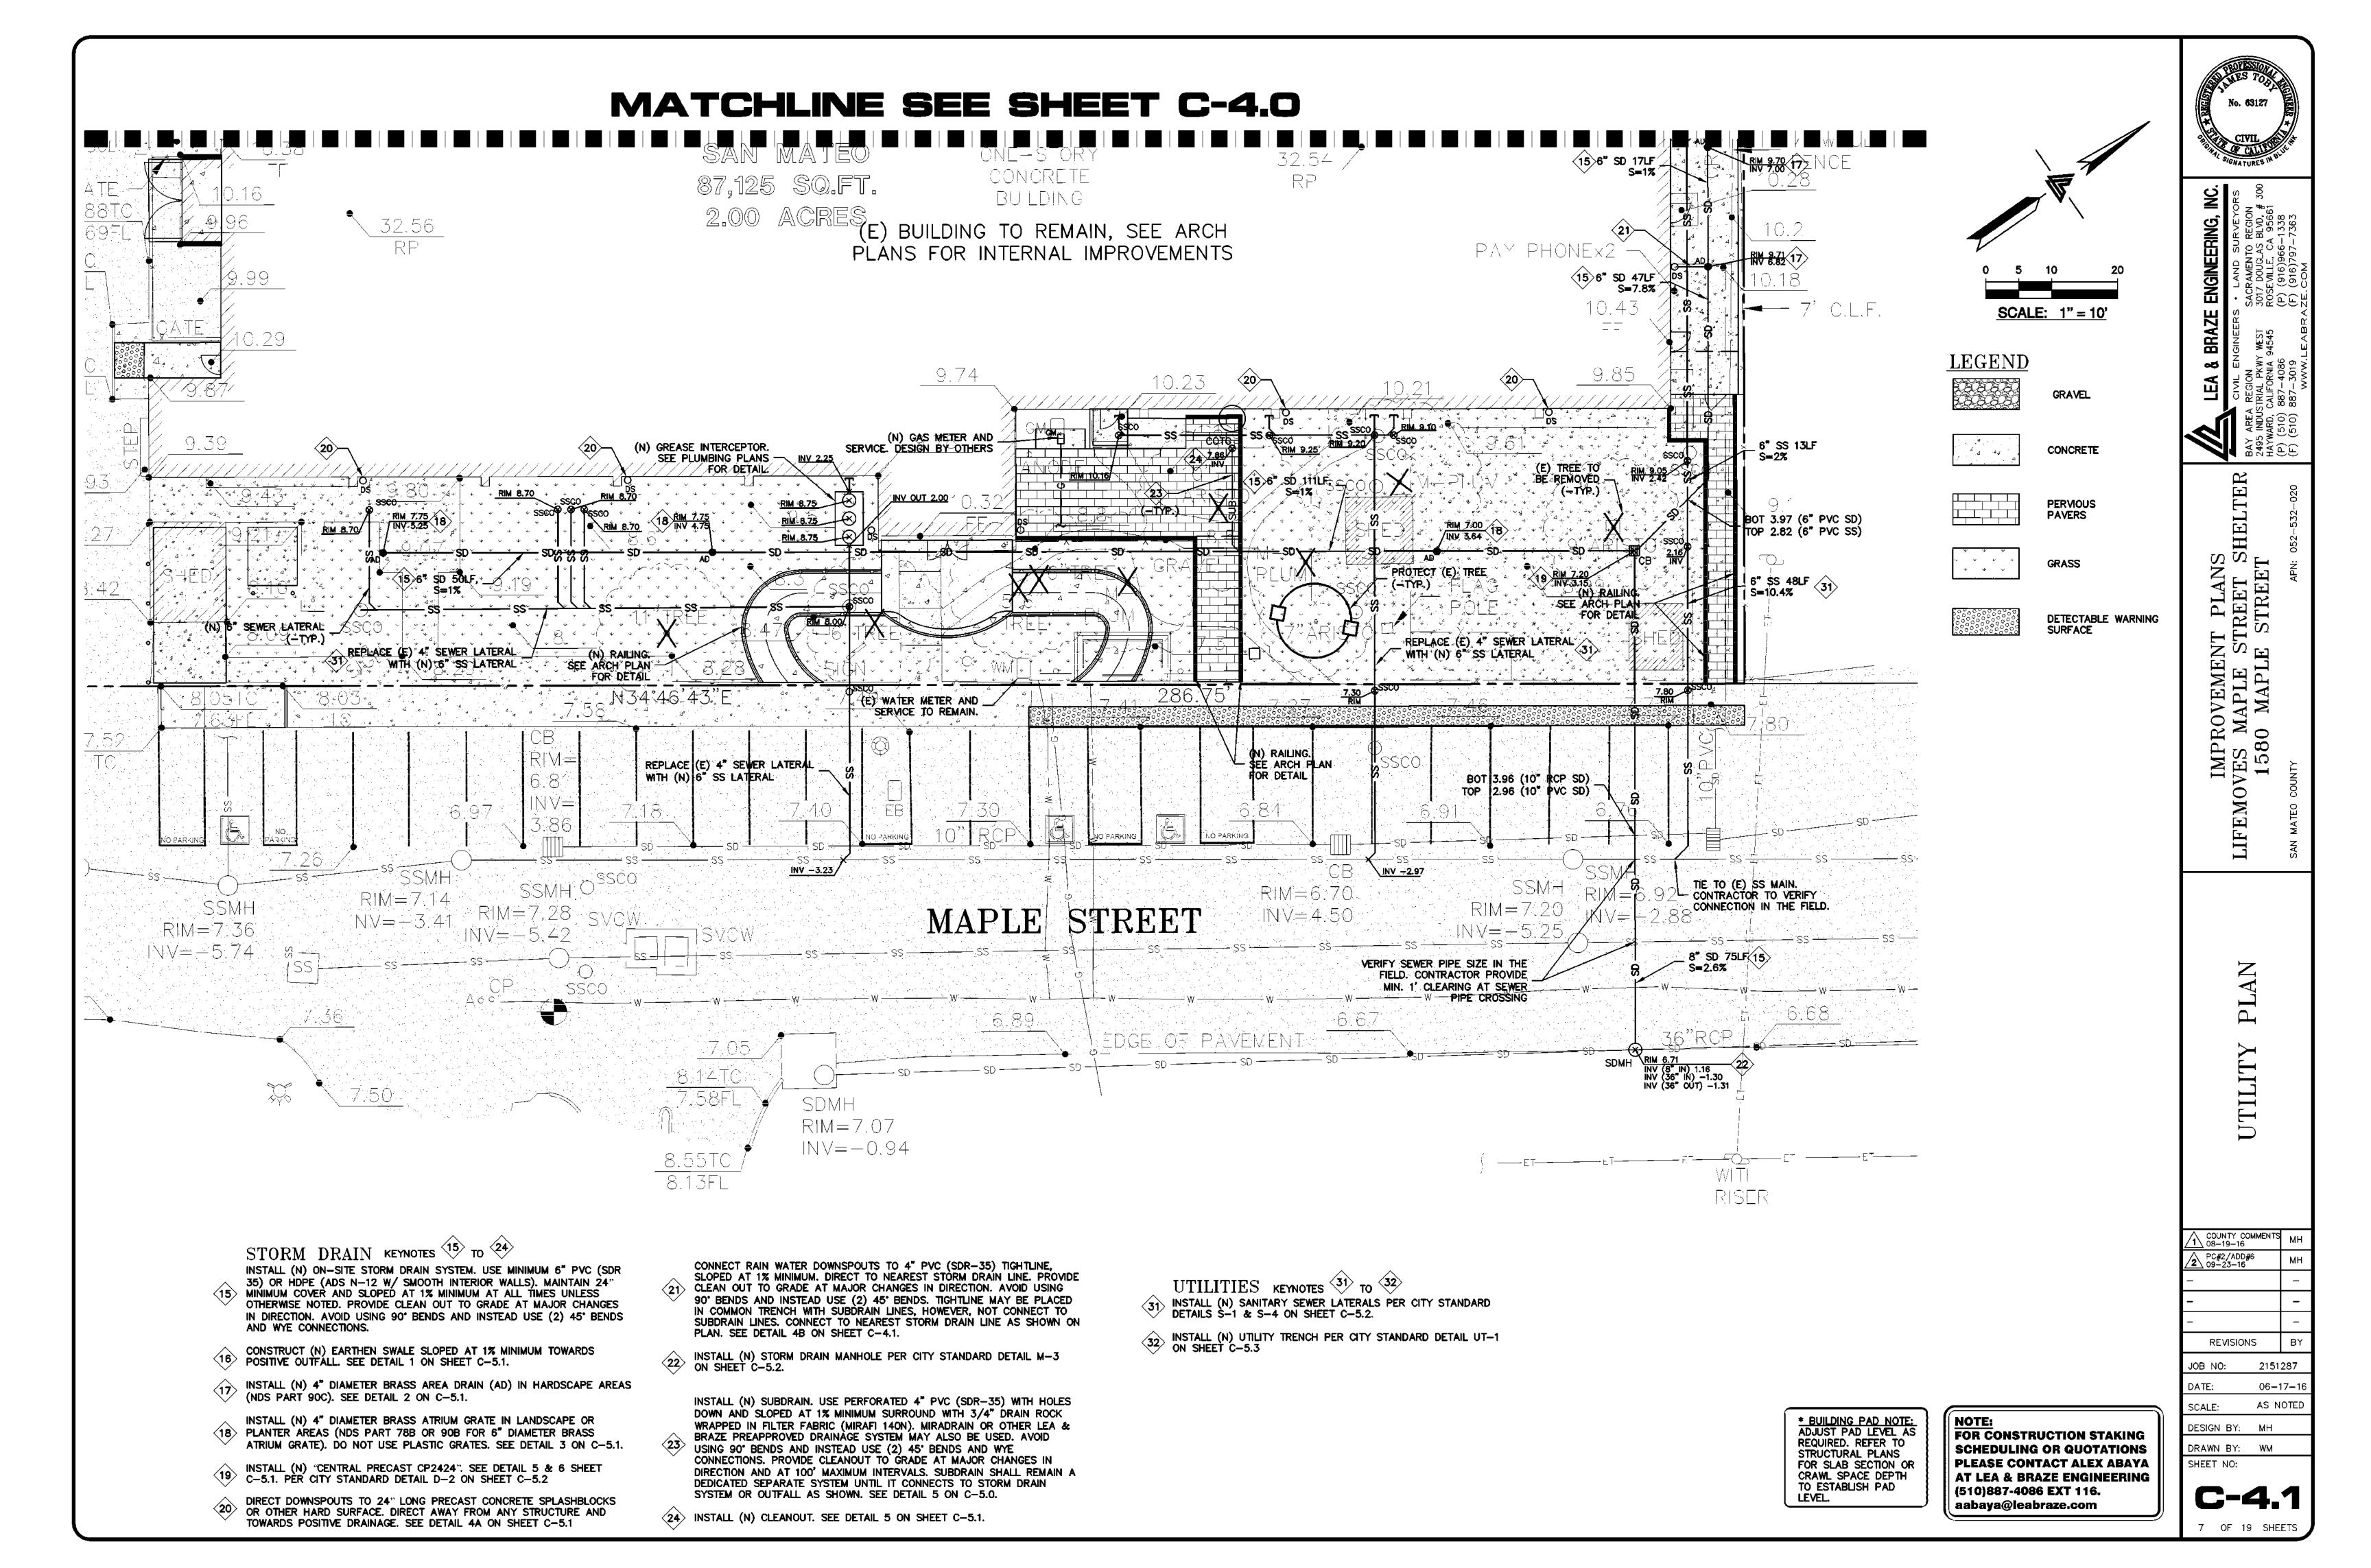

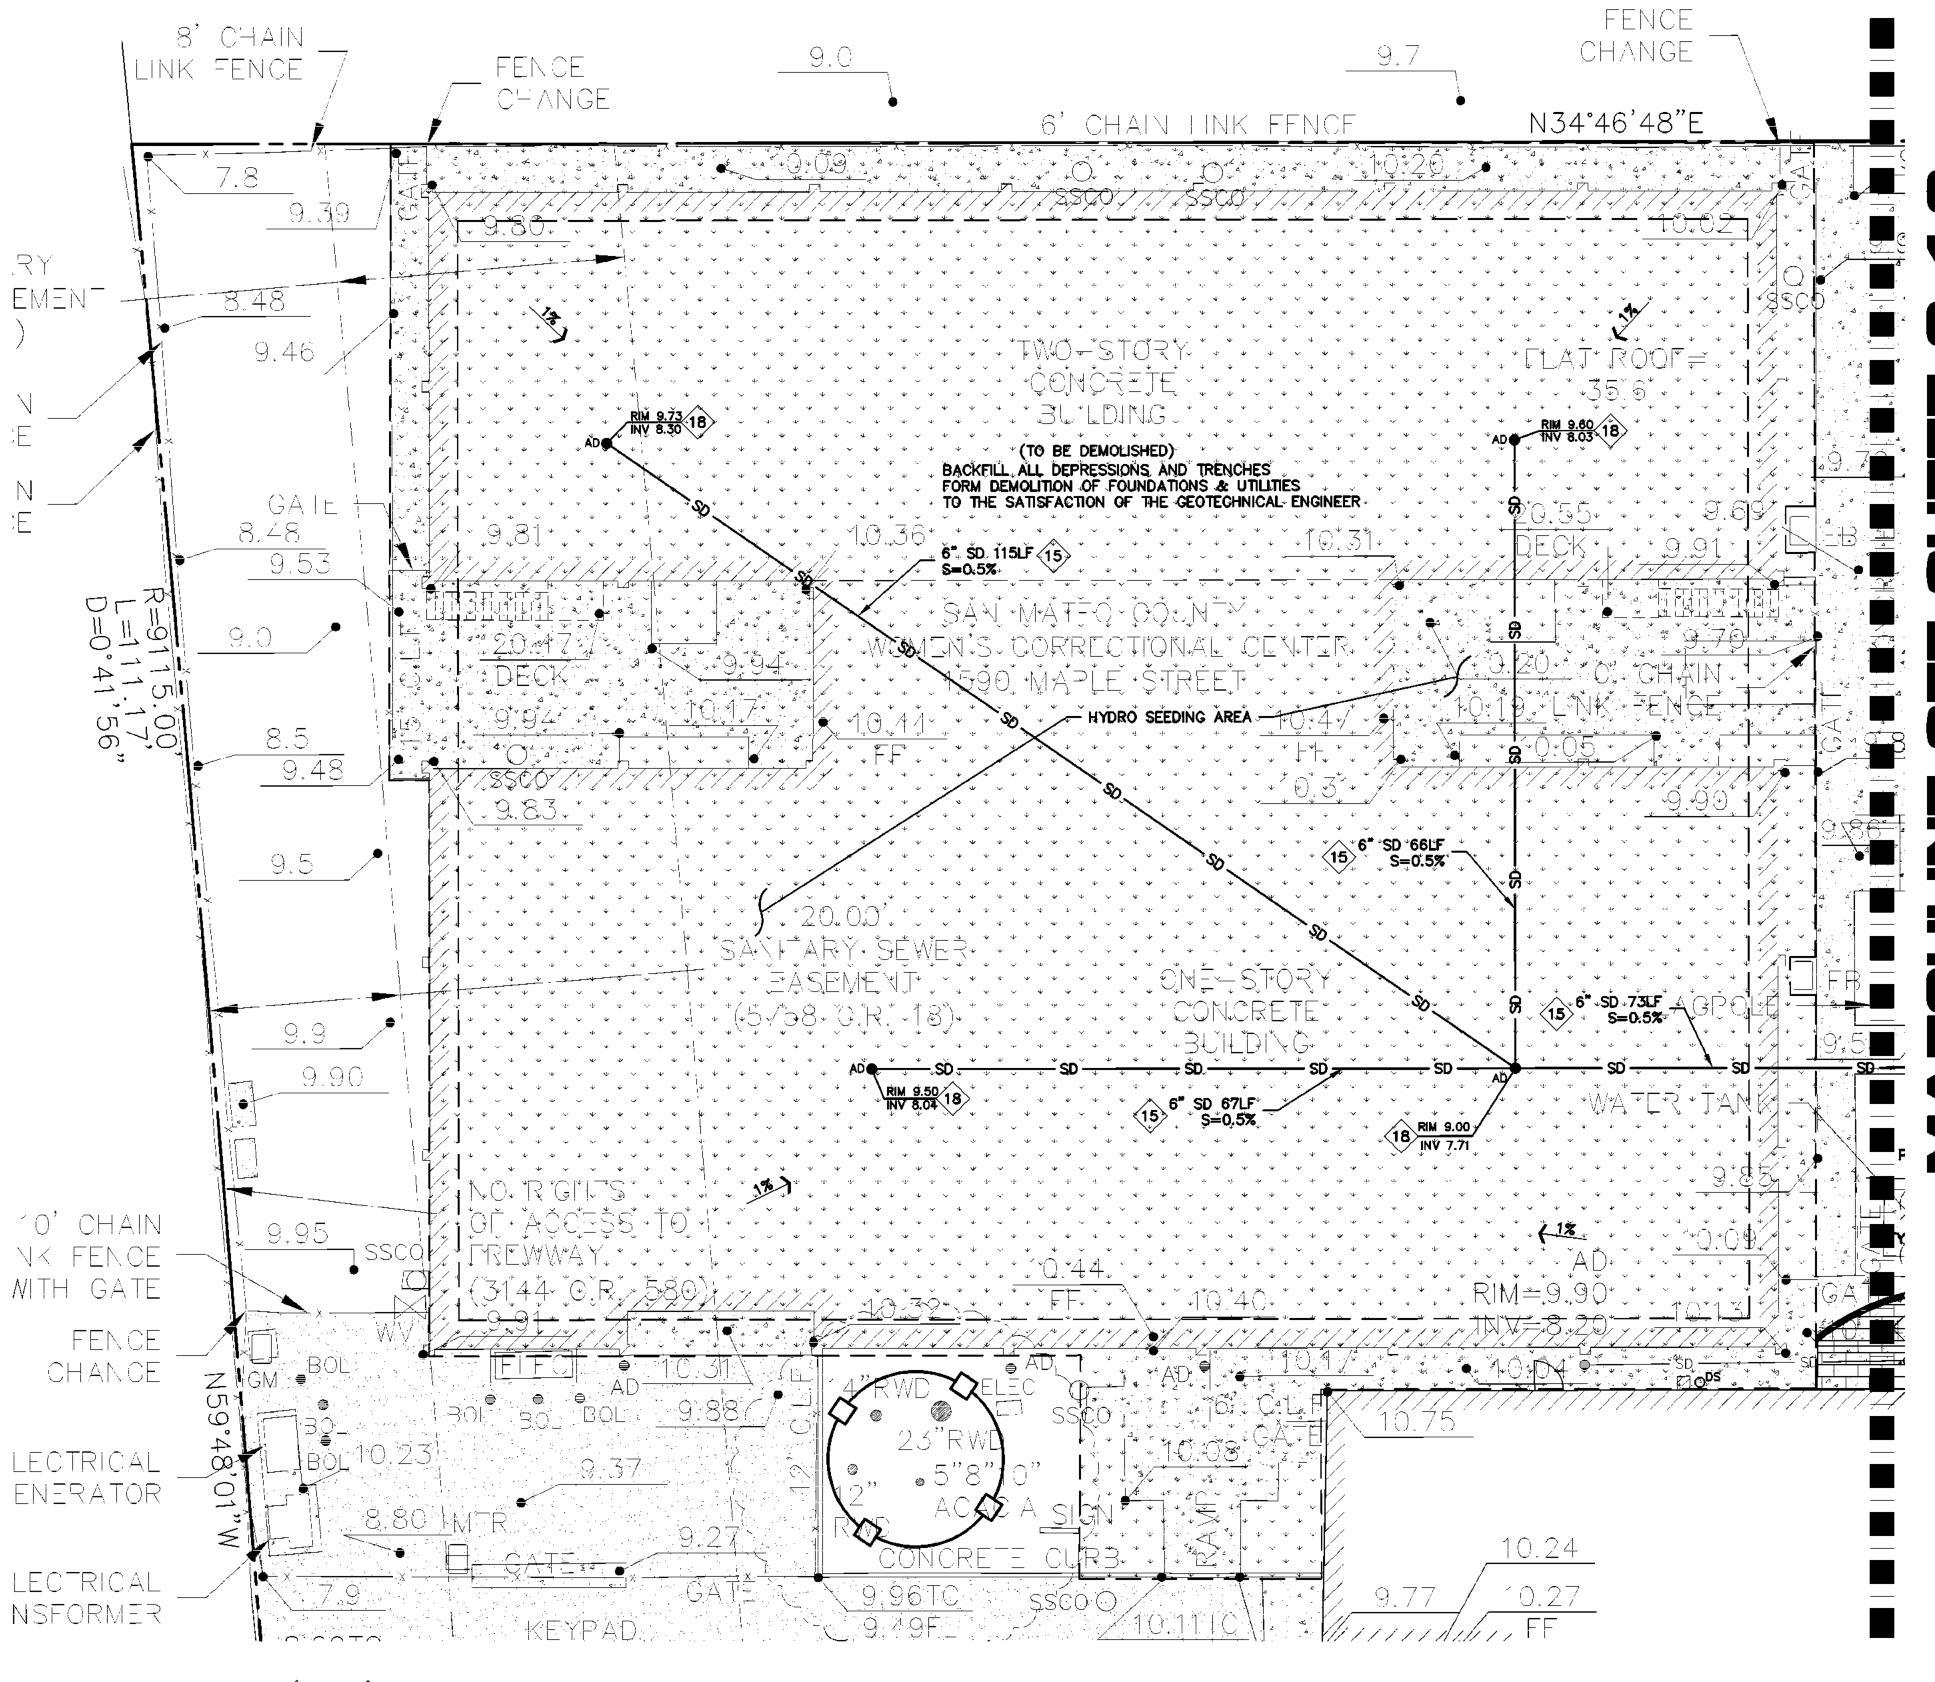

STORM DRAIN KEYNOTES (15) TO (24)

INSTALL (N) ON-SITE STORM DRAIN SYSTEM. USE MINIMUM 6" PVC (SDR 35) OR HDPE (ADS N-12 W/ SMOOTH INTERIOR WALLS). MAINTAIN 24"
MINIMUM COVER AND SLOPED AT 1% MINIMUM AT ALL TIMES UNLESS OTHERWISE NOTED. PROVIDE CLEAN OUT TO GRADE AT MAJOR CHANGES IN DIRECTION. AVOID USING 90' BENDS AND INSTEAD USE (2) 45' BENDS AND WYE CONNECTIONS.

- CONSTRUCT (N) EARTHEN SWALE SLOPED AT 1% MINIMUM TOWARDS POSITIVE OUTFALL. SEE DETAIL 1 ON SHEET C-5.1.
- (NDS PART 90C). SEE DETAIL 2 ON C-5.1. INSTALL (N) 4" DIAMETER BRASS AREA DRAIN (AD) IN HARDSCAPE AREAS
- INSTALL (N) 4" DIAMETER BRASS ATRIUM GRATE IN LANDSCAPE OR (18) PLANTER AREAS (NDS PART 78B OR 90B FOR 6" DIAMETER BRASS ATRIUM GRATE). DO NOT USE PLASTIC GRATES. SEE DETAIL 3 ON C-5.1.
- INSTALL (N) "CENTRAL PRECAST CP2424". SEE DETAIL 5 & 6 SHEET (19) C-5.1. PER CITY STANDARD DETAIL D-2 ON SHEET C-5.2
- DIRECT DOWNSPOUTS TO 24" LONG PRECAST CONCRETE SPLASHBLOCKS OR OTHER HARD SURFACE. DIRECT AWAY FROM ANY STRUCTURE AND TOWARDS DOSITIVE BRAINAGE SEE BETAIL 44 ON SHEET C & 1

- CONNECT RAIN WATER DOWNSPOUTS TO 4" PVC (SDR-35) TIGHTLINE, SLOPED AT 1% MINIMUM. DIRECT TO NEAREST STORM DRAIN LINE. PROVIDE CLEAN OUT TO GRADE AT MAJOR CHANGES IN DIRECTION. AVOID USING 90° BENDS AND INSTEAD USE (2) 45° BENDS. TIGHTLINE MAY BE PLACED IN COMMON TRENCH WITH SUBDRAIN LINES, HOWEVER, NOT CONNECT TO SUBDRAIN LINES. CONNECT TO NEAREST STORM DRAIN LINE AS SHOWN ON PLAN. SEE DETAIL 4B ON SHEET C-4.1.
- 22 INSTALL (N) STORM DRAIN MANHOLE PER CITY STANDARD DETAIL M-3 ON SHEET C-5.2.


INSTALL (N) SUBDRAIN. USE PERFORATED 4" PVC (SDR-35) WITH HOLES DOWN AND SLOPED AT 1% MINIMUM SURROUND WITH 3/4" DRAIN ROCK WRAPPED IN FILTER FABRIC (MIRAFI 140N). MIRADRAIN OR OTHER LEA & BRAZE PREAPPROVED DRAINAGE SYSTEM MAY ALSO BE USED. AVOID USING 90' BENDS AND INSTEAD USE (2) 45' BENDS AND WYE

CONNECTIONS. PROVIDE CLEANOUT TO GRADE AT MAJOR CHANGES IN DIRECTION AND AT 100' MAXIMUM INTERVALS. SUBDRAIN SHALL REMAIN A DEDICATED SEPARATE SYSTEM UNTIL IT CONNECTS TO STORM DRAIN SYSTEM OR OUTFALL AS SHOWN. SEE DETAIL 5 ON C-5.0.

(24) INSTALL (N) CLEANOUT. SEE DETAIL 5 ON SHEET C-5.1.

UTILITIES KEYNOTES (31) TO (32) INSTALL (N) SANITARY SEWER LATERALS PER CITY STANDARD DETAILS S-1 & S-4 ON SHEET C-5? DETAILS S-1 & S-4 ON SHEET C-5.2.

install (N) utility trench per city standard detail ut-1 on sheet c-5.3

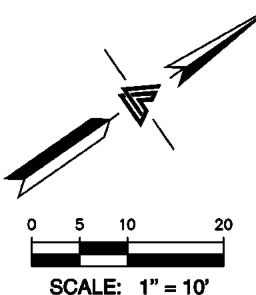

**LEGEND** 

DETECTABLE WARNING SURFACE

\* BUILDING PAD NOTE: ADJUST PAD LEVEL AS REQUIRED. REFER TO STRUCTURAL PLANS FOR SLAB SECTION OR CRAWL SPACE DEPTH TO ESTABLISH PAD LEVEL.

FOR CONSTRUCTION STAKING **SCHEDULING OR QUOTATIONS** PLEASE CONTACT ALEX ABAYA AT LEA & BRAZE ENGINEERING (510)887-4086 EXT 116. aabaya@leabraze.com




1 COUNTY COMMENTS PC#2/ADD#6 09-23-16 REVISIONS 2151287 JOB NO: 06-17-16

SHEET NO:

DESIGN BY: MH

DRAWN BY: WM

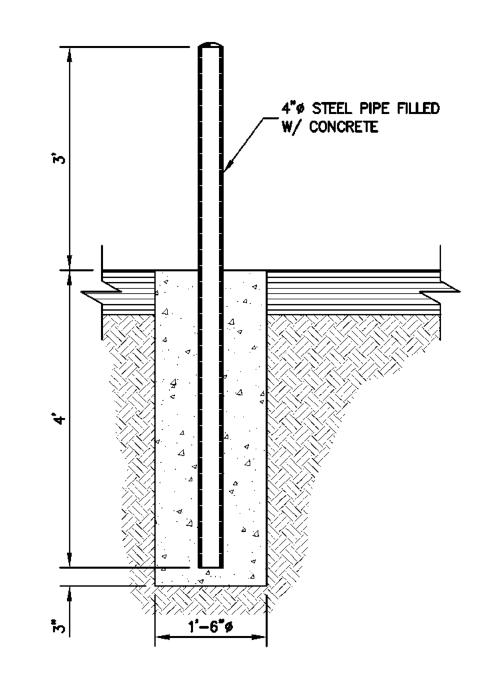

BOLLARD C-5.0

\_FLUSH CURB SIMILAR TO CURB DETAIL \_\_1/4" TYP IF APPLICABLE CONTINUOUS KEY CURB INTO 4" NATIVE SOIL

CURB MAY EITHER BE EXTRUDED TO THE SHAPE SHOWN OR FORMED & POURED IN PLACE. FLUSH CURB

PROVIDE EXPANSION JOINTS AT 15" O.C.

\_1/2" DEEP SEE LANDSCAPE OR ARCHITECTURAL PLANS FOR PLACEMENT OF JOINTS #4 REBAR 1012" OC EACH WAY FOR DRIVEWAY AND 16" OC FOR PATHWAY \_\_R=1/2\* -TYP EXPANSION JOINT - 3/8" HOLD FELT DOWN 1/2" AND SEAL W/ SEALANT, COLOR TO BE APPROVED SEE PLAN FOR TYPE —TOP SOIL FOR BY ARCHITECT -TYP LANDSCAPE AREAS SMOOTH SLIP DOWEL \_1/2" D 24" LONG \$18"
OC, GREASE ONE END
TYP 4" FOR PATHWAY, 6" FOR DRIVEWAY 8" CLASS II AGGREGATE BASE ROCK, PER CAL TRANS STD, TO BE COMPACTED IN ACCORDANCE WITH THE GEOTECHNICAL REPORT SEE PAVING SECTION ON NOTES: GRADING SHEET SUBGRADE TO BE COMPACTED IN ACCORDANCE WITH 1. SLOPE ALL CONCRETE TO DRAIN 1% MIN. 2. SEE LANDSCAPE OR ARCHITECTURAL GEOTECHNICAL REPORT PLANS FOR CONCRETE COLORS AND


CONTRACTION JOINT, 2

3. EASE ALL EDGES R=1/2"


FINISHES.

4. FELT SHALL BE NON-ASPHALTIC IMPREGNATED.


CONCRETE PAVING C-5.0

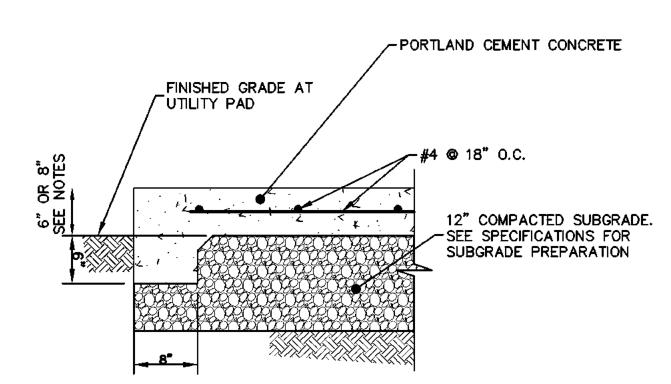


- TRANSFORMER PAD SHALL BE 6" MIN. WIDER THAN TRANSFORMER ENCLOSURE. TYPICAL TRANSFORMER IS 5'x 8'.
- 2. GAS METER PAD SHALL BE AS REQUIRED BY PG&E.
- 3. TRASH ENCLOSURE PAD SHALL BE 8" MIN. AND APRON SHALL EXTEND 10' IN FRONT OF ENCLOSURE.

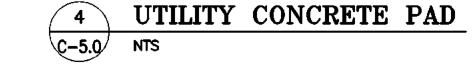

- 1. CURB RAMPS SHALL HAVE DETECTABLE WARNING SURFACE THE ENTIRE RAMP TRAVEL.
- 2. THE DETECTABLE WARNING BORDER SHALL BE A CONTRASTING SURFACE WITH THE ADJOINING SURFACE. ONLY ADA ACCESSIBLE PRODUCTS APPROVED BY THE DIVISION OF THE STATE ARCHITECT OF CALIFORNIA SHALL BE USED.
- 3. DOME ORIENTATION SHALL CONFORM TO THE LATEST ADA/TITLE 24 REGULATIONS.
- 4. IF PRECAST CONCRETE DETECTABLE WARNING DOMES PAVERS ARE USED, THE WILL NEED TO BE INSTALLED ON TOP OF A 4" THICK CONCRETE SURFACE.
  PAVERS SHALL BE LAID SUCH THAT JOINTS ARE LEVEL WITH ADJOINING
  SURFACE, TO PROVIDE A SMOOTH TRANSITION FROM PAVER TO PAVER AND FROM PAVER TO CONCRETE.
- 5. IF PLASTIC MAT DETECTABLE WARNING DOMES ARE USED, THE MAT NEEDS TO BE FLUSH WITH THE ADJOINING CONCRETE SURFACE. WHERE THE MAT IS INSTALLED, THE CONCRETE SURFACE WILL NEED TO BE HELD DOWN THE THICKNESS OF THE

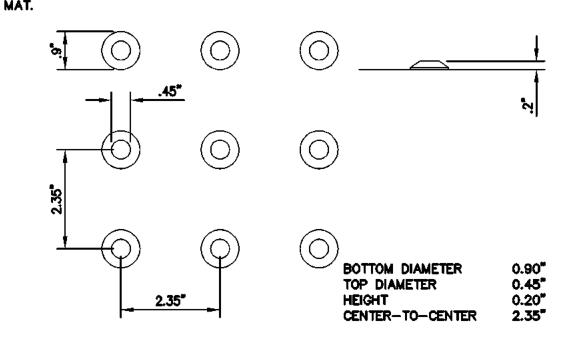


DETECTABLE WARNING SURFACE C-5.0

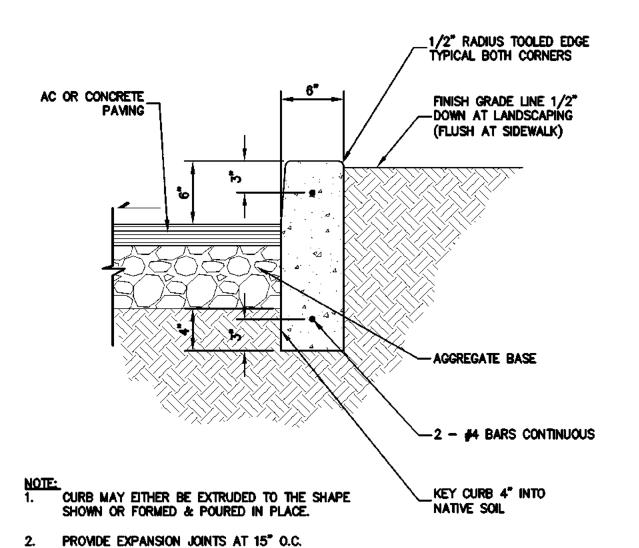

TYPICAL CURB C-5.0 NTS

PERMEABLE PAVERS, SEE LANDSCAPE PLANS FOR COLOR— AND SPECIFICATIONS (MIN. 3-1/8" THICK)	TYP. NO.8, 89, OR 9 AGGREGATE IN OPENINGS
	BEDDING COURSE 2* THICK (NO.8 AGGREGATE)  6* OPEN GRADE BASE THICK (NO.57 AGGREGATE)
	CLASS II PERMEABLE AGGREGATE PER CALTRANS SPECIFICATIONS NO.2 AGGREGATES WITH MIN 8" FOR PEDESTRIAN/PARKING AREA.
SUBGRADE DISTURE CONDITIONED AND COMPACTED PER GEOTECHNICAL	MIRAFI 140N FILTER FABRIC
REQUIREMENT  5 UNIT PAVERS	4" PERFORATED PVC (SDR35) WITH HOLES DOWN SUBDRAIN  0.5% MIN.

C-5.0 NTS

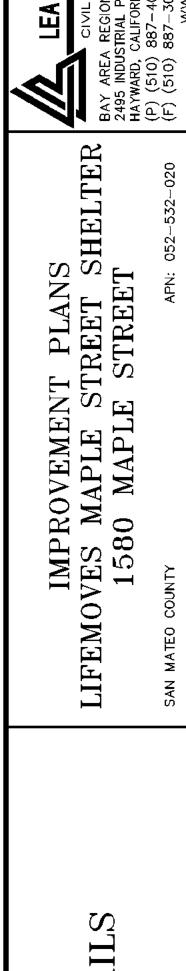


$\sum$ COUNTY COMME 08-19-16	NTS MH
PC#2/ADD#6 09-23-16	мН
	_
	_
	_
REVISIONS	BY
)B NO: 2	151287
	0 47 40


, ,
2151287
06-17-16
NTS
мн
WM



SHEET NO:

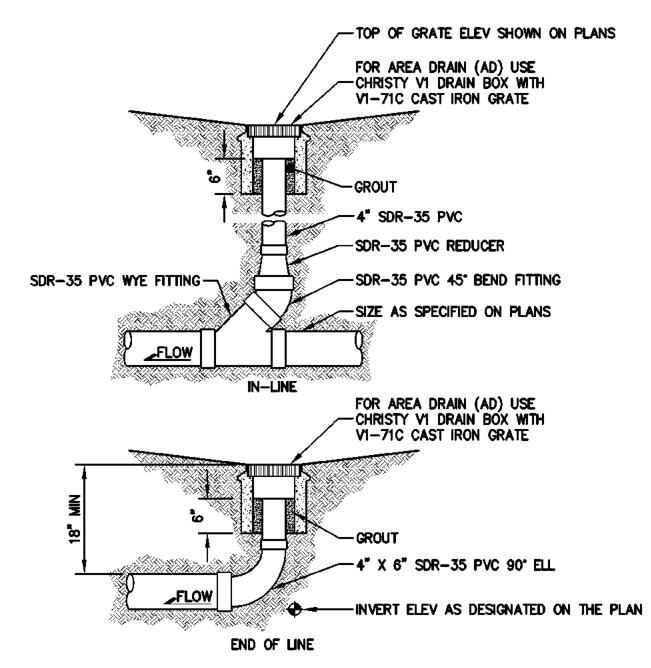



NOTE:
GLUED FITTINGS MAY BE SUBSTITUTED
FOR GASKETED FITTINGS AT THE OPTION
OF THE INSTALLATION CONTRACTOR.

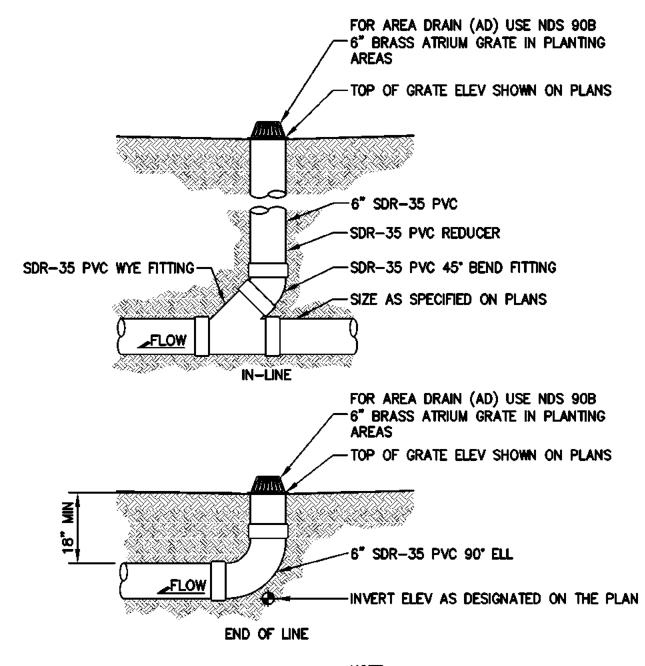


BRASS ATRIUM
AREA DRAIN

The installation contractor.

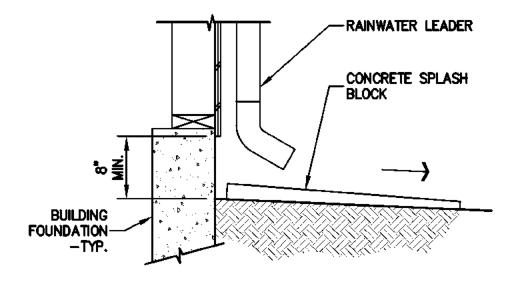

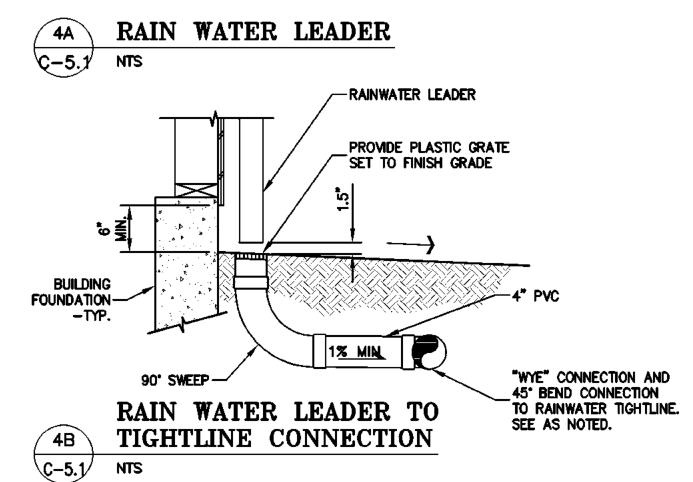

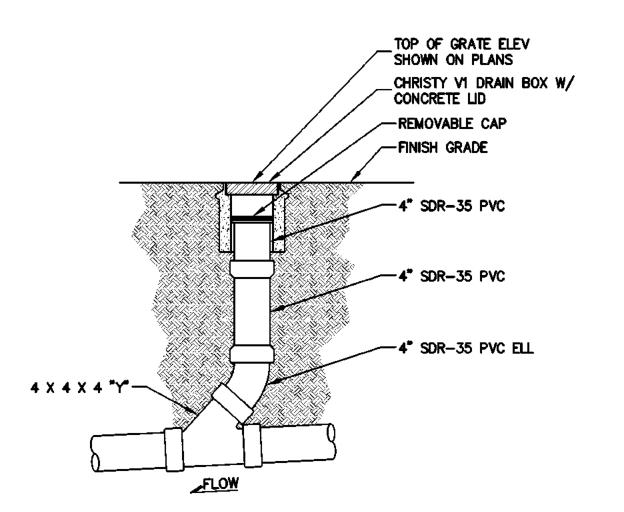

5 ON-SITE CLEANOUT

EARTHEN SWALE DETAIL

C-5.1


IMPROVEMENT PLANS LIFEMOVES MAPLE STREET SHELTER 1580 MAPLE STREET


C-5.1


DESIGN BY: MH


DRAWN BY: WM


SCALE:

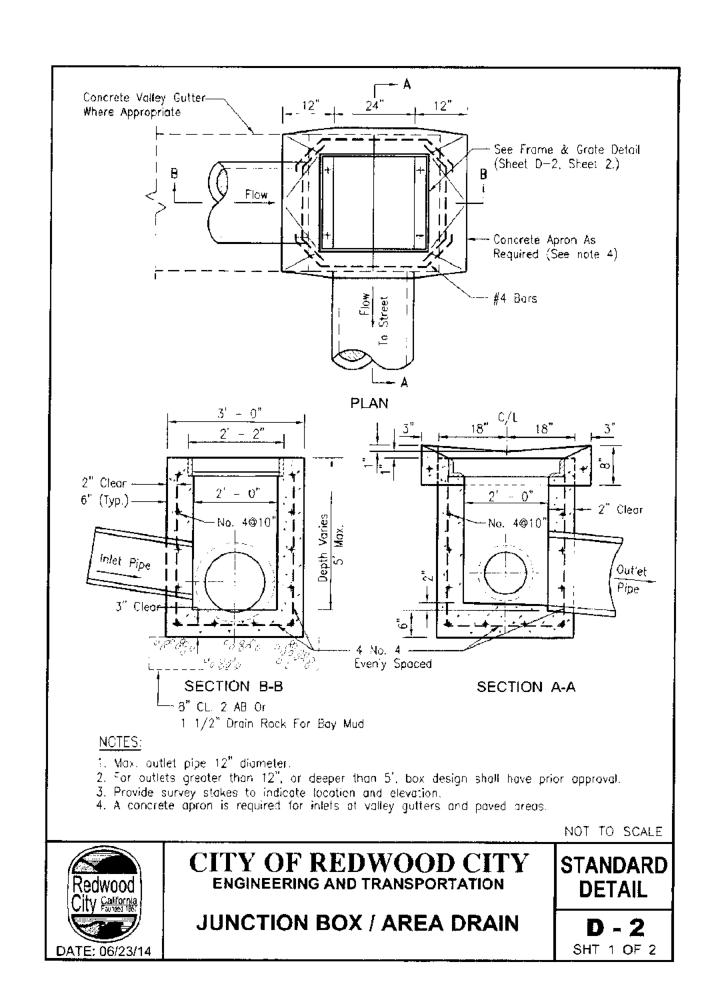


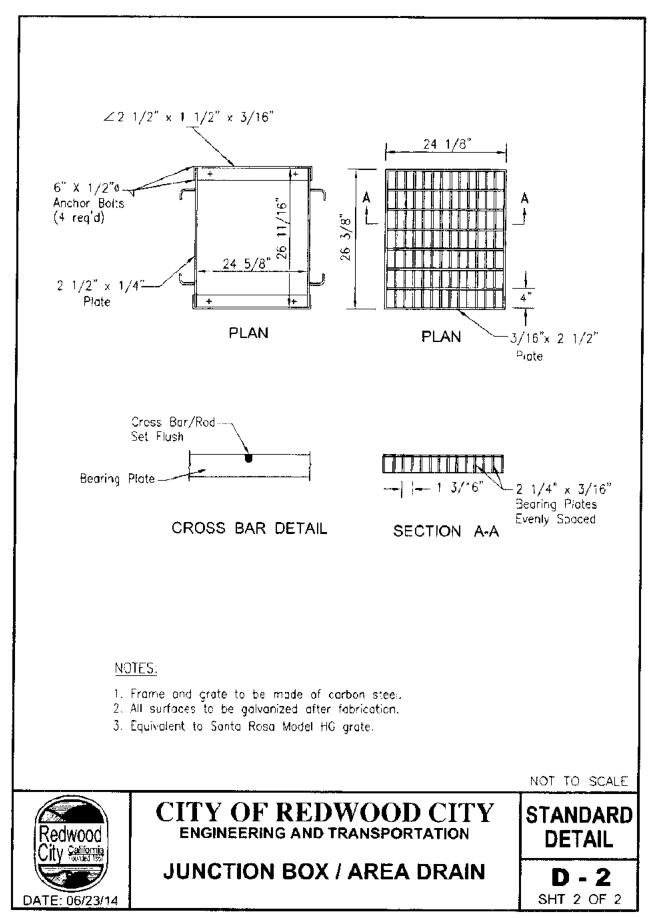


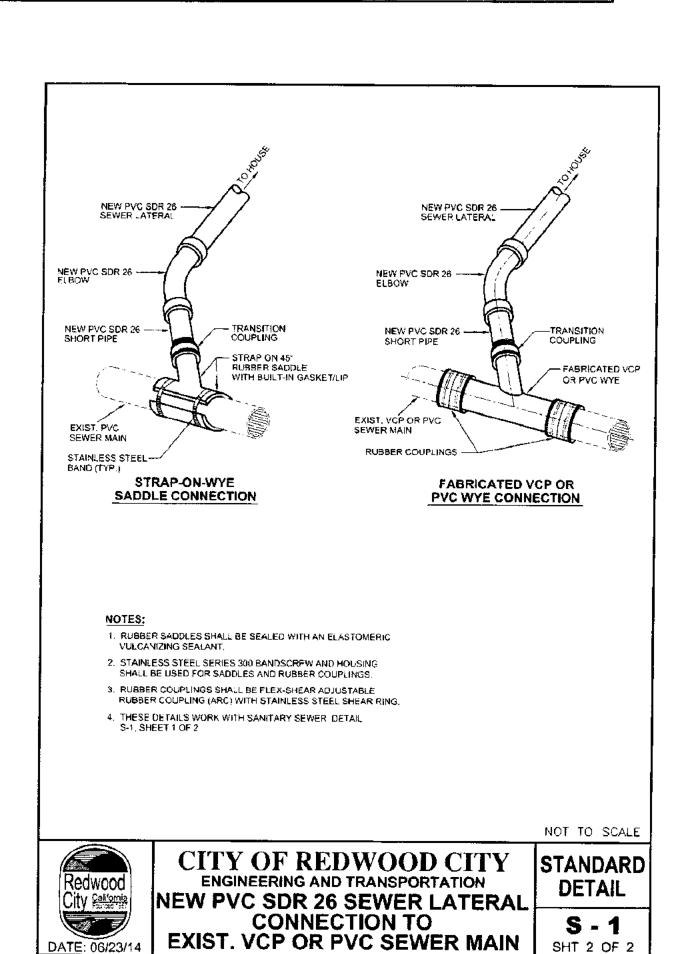

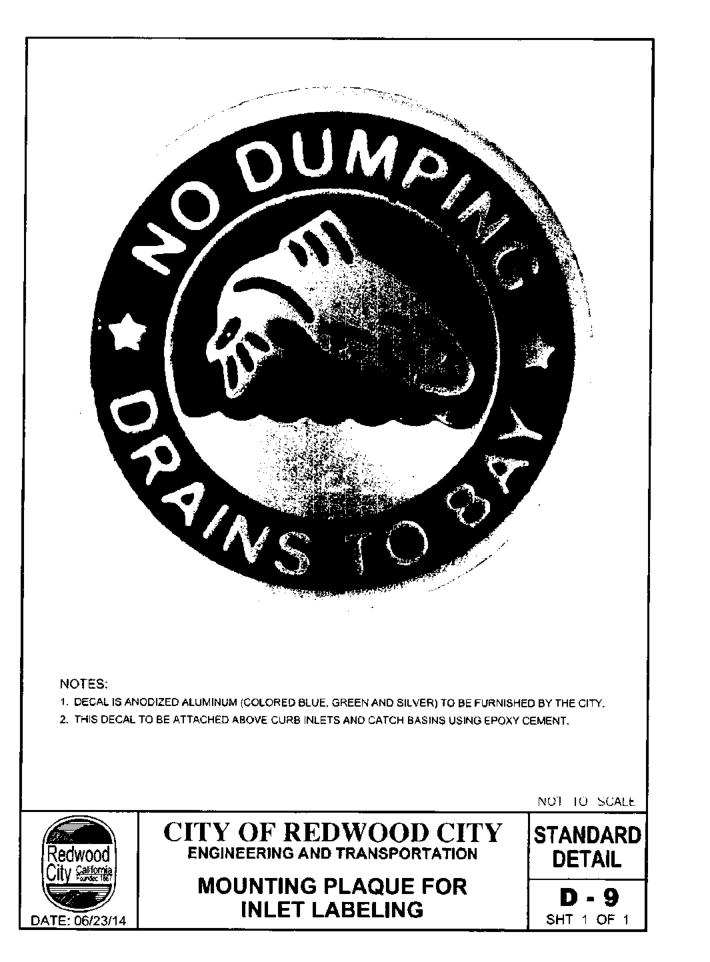

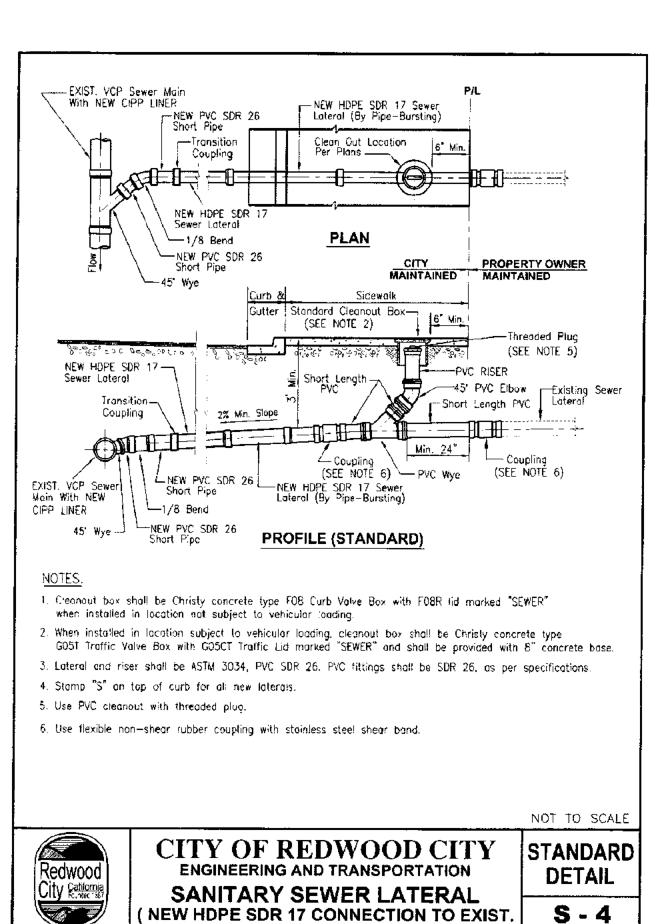

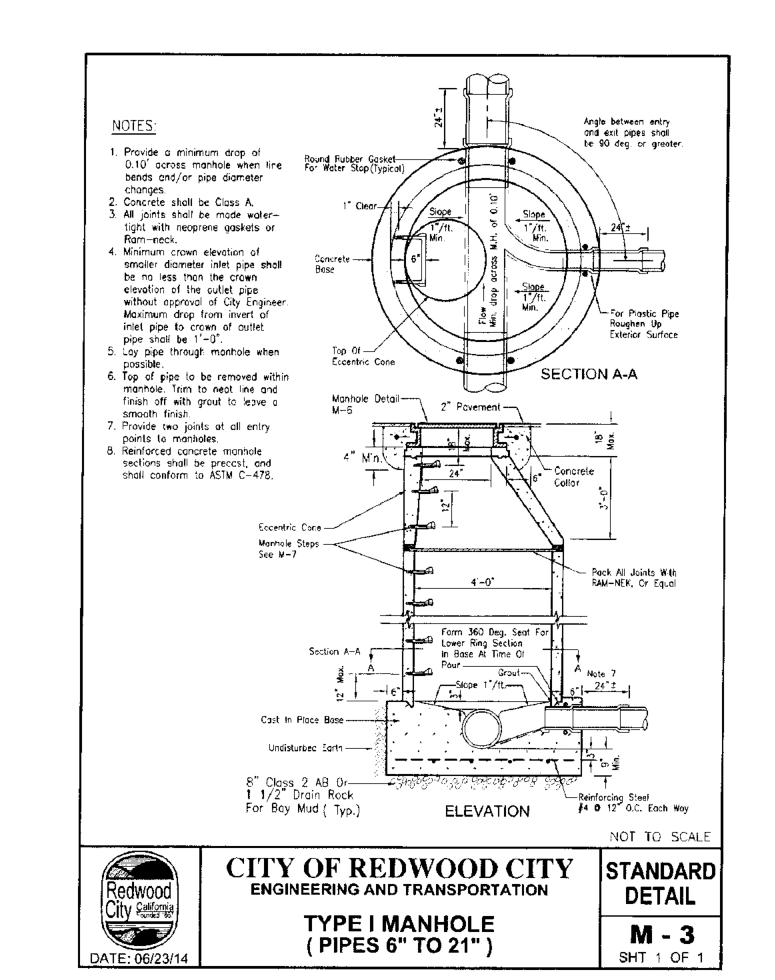

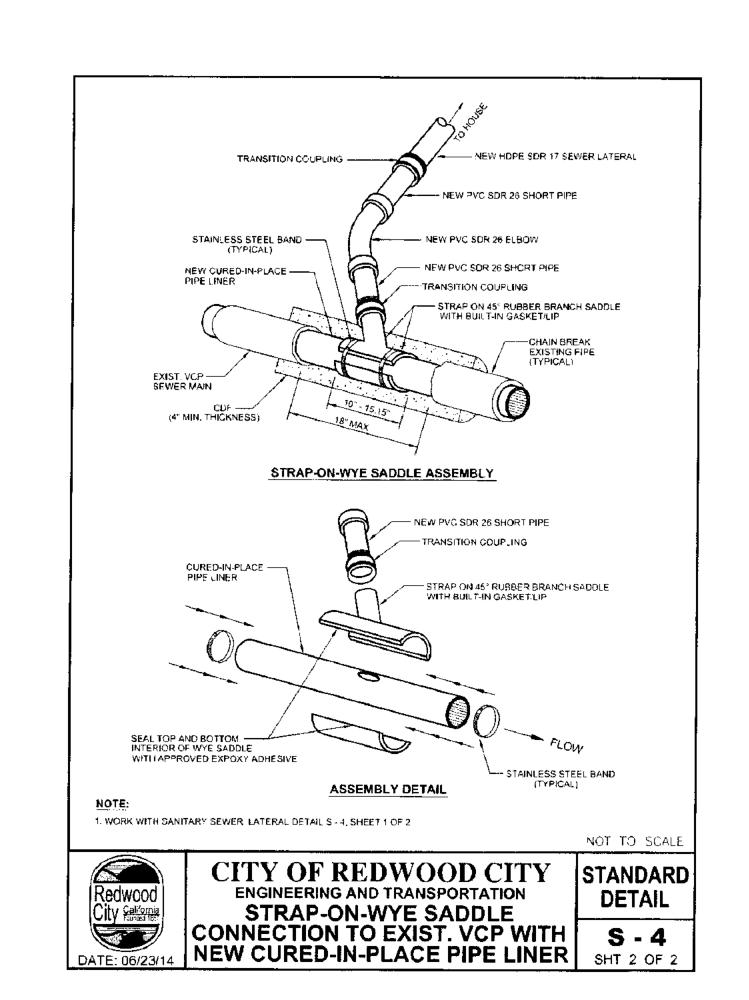



NS J


IMPROVEMENT PLAN VES MAPLE STREET 1580 MAPLE STREE

COUNTY COMMENTS MH PC#2/ADD#6 09-23-16 REVISIONS

JOB NO: 2151287 DATE: 06-17-16 NTS SCALE: DESIGN BY: MH DRAWN BY: WM

11 OF 19 SHEETS

SHEET NO:

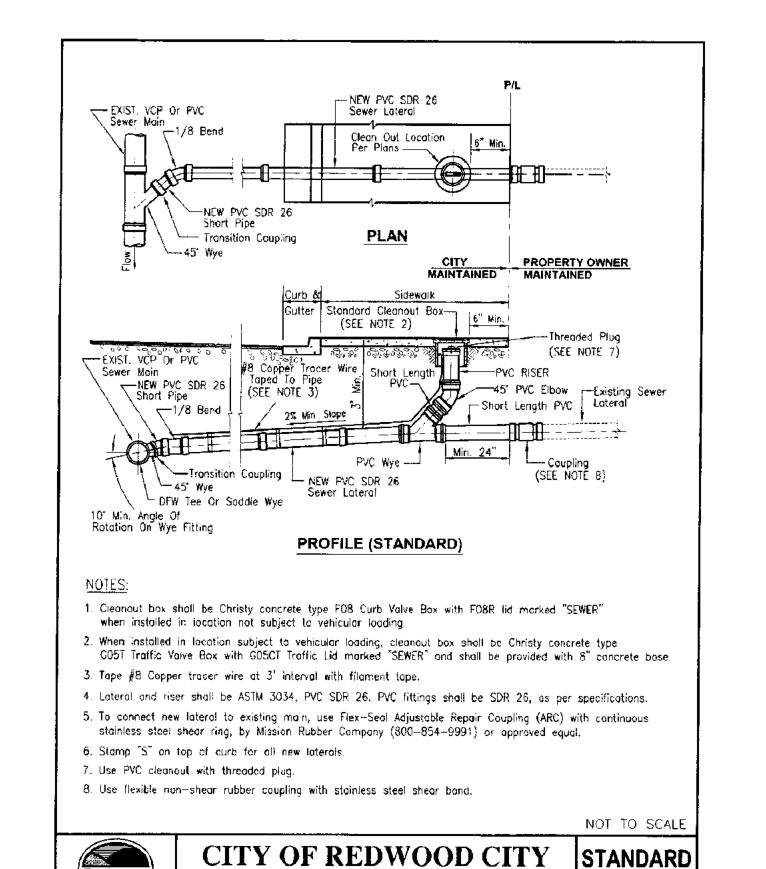

ENGINEERING AND TRANSPORTATION

SANITARY SEWER LATERAL

NEW CONNECTION TO EXIST. SEWER MAIN)

DETAIL


**S** - 1

SHT 1 QF 2

Redwood

City California


DATE: 06/23/14

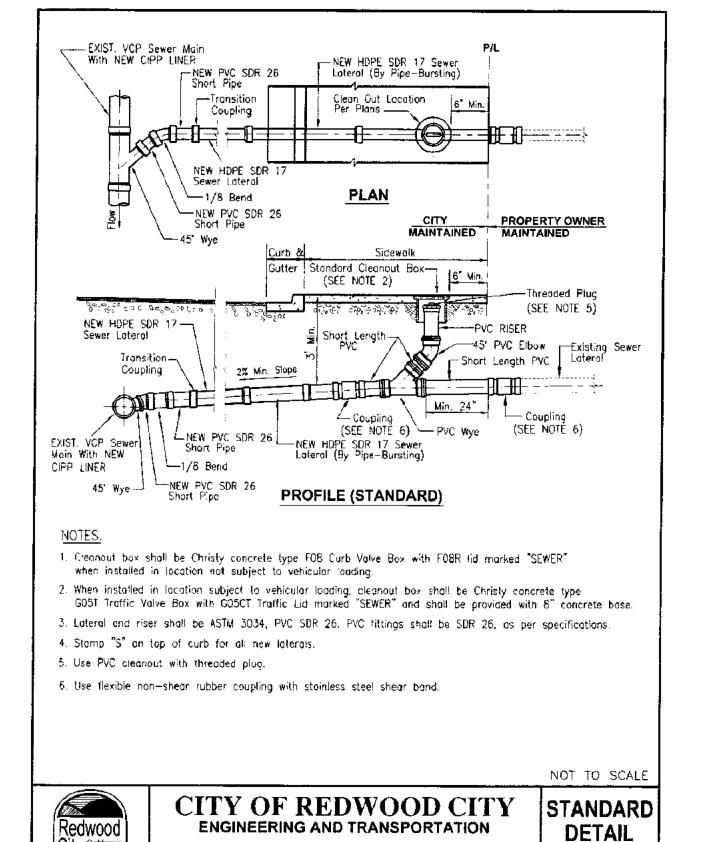


VCP SEWER MAIN WITH NEW CIPP LINER )

SHT 1 OF 2

DATE: 06/23/14

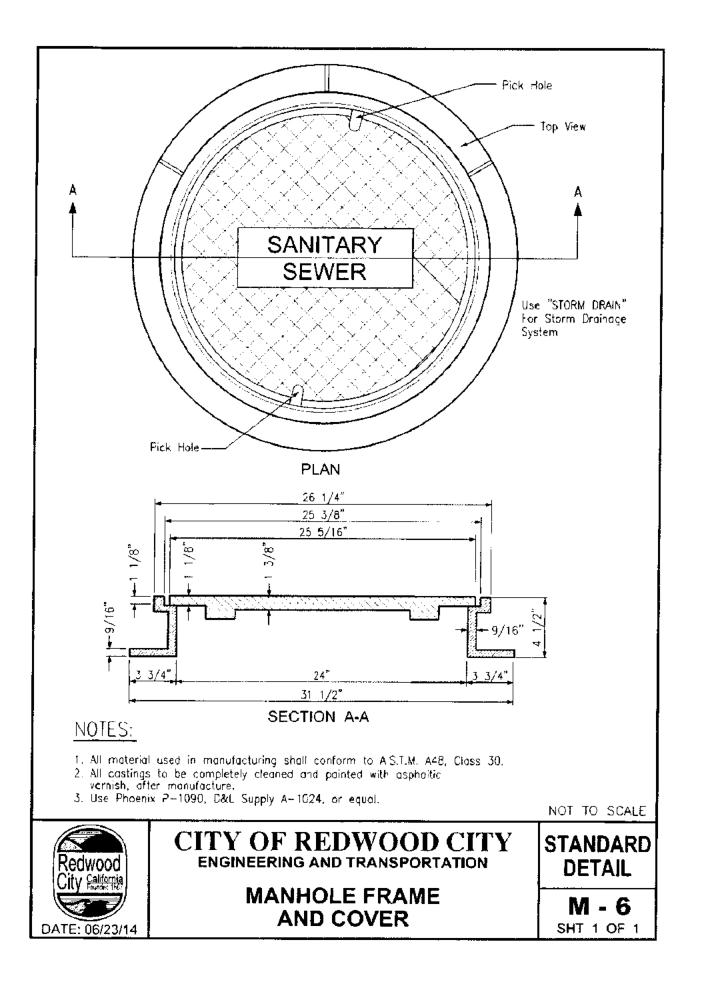

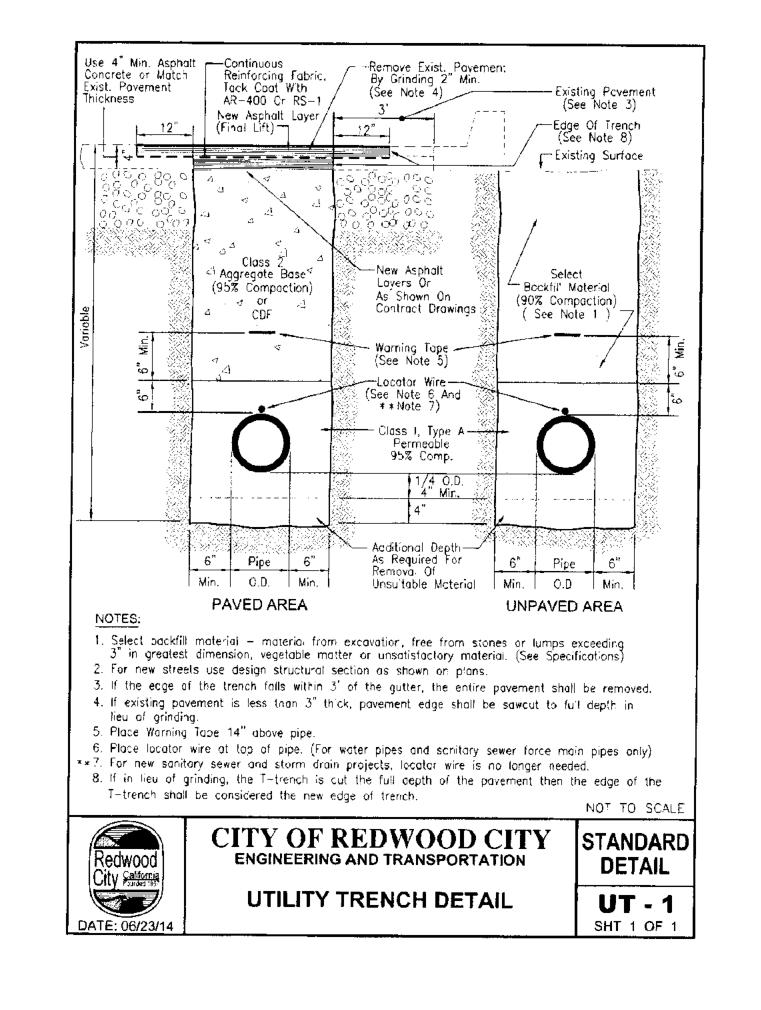

IMPROVEMENT PLANS LIFEMOVES MAPLE STREET SHELTER 1580 MAPLE STREET

06-17-16

REVISIONS

JOB NO: 2151287

#### **CAUTION:**

- CONTRACTOR SHALL CONTACT UNDERGROUND SERVICE ALERT FOR LOCATION OF UNDERGROUND UTILITIES AT LEAST 48 HOURS PRIOR TO COMMENCEMENT OF CONSTRUCTION— PHONE (800) 227—2600, CONTRACTOR SHALL VERIFY ALL EXISTING UTILITIES PRIOR TO BEGINNING ANY WORK ON THIS SITE.
- THE LOCATION, SIZES AND/OR DEPTHS OF EXISTING UNDERGROUND UTILITIES AS SHOWN ON THIS PLAN WERE OBTAINED FROM SOURCES OF VARYING RELIABILITY. THE CONTRACTOR IS CAUTIONED THAT ONLY ACTUAL EXCAVATION WILL REVEAL THE TYPES, EXTENT, SIZES, LOCATIONS AND DEPTHS OF SUCH UNDERGROUND UTILITIES. (A REASONABLE EFFORT HAS BEEN MADE TO LOCATE AND DELINEATE ALL KNOWN UNDERGROUND UTILITIES). CONTRACTOR SHALL VERIFY LOCATION AND DEPTH PRIOR TO ANY EXCAVATION OR IMPROVEMENT.
- THESE DRAWINGS DO NOT ADDRESS CONTRACTOR MEANS, METHODS OR PROCESSES THAT MAY BE ASSOCIATED WITH ANY TOXIC SOILS IF FOUND ON SITE. THE CONTRACTOR IS RESPONSIBLE FOR COMPLYING WITH ALL CITY AND COUNTY STANDARDS AND APPROPRIATE REGULATIONS IF TOXIC SOILS ARE ENCOUNTERED. CONTRACTOR MUST NOTIFY THE OWNER'S PROJECT MANAGER IMMEDIATELY IF ANY SOILS ARE EVEN SUSPECTED OF BEING CONTAINED.

#### GENERAL NOTES

- ALL GENERAL NOTES, SHEET NOTES, AND LEGEND NOTES FOUND IN THESE DOCUMENTS SHALL APPLY TYPICALLY THROUGHOUT. IF INCONSISTENCIES ARE FOUND IN THE VARIOUS NOTATIONS, NOTIFY THE ENGINEER IMMEDIATELY IN WRITING REQUESTING CLARIFICATION.
- 2. THESE DRAWINGS AND THEIR CONTENT ARE AND SHALL REMAIN THE PROPERTY OF LEA AND BRAZE ENGINEERING, INC. WHETHER THE PROJECT FOR WHICH THEY ARE PREPARED IS EXECUTED OR NOT. THEY ARE NOT TO BE USED BY ANY PERSONS ON OTHER PROJECTS OR EXTENSIONS OF THE PROJECT EXCEPT BY AGREEMENT IN WRITING AND WITH APPROPRIATE COMPENSATION TO THE
- ALL WORK SHALL COMPLY WITH APPLICABLE CODES AND TRADE STANDARDS WHICH GOVERN EACH PHASE OF WORK INCLUDING, BUT NOT LIMITED TO, CALIFORNIA MECHANICAL CODE, CALIFORNIA PLUMBING CODE, CALIFORNIA ELECTRICAL CODE, CALIFORNIA FIRE CODE, CALTRANS STANDARDS AND SPECIFICATIONS. AND ALL APPLICABLE STATE AND/OR LOCAL CODES AND/OR LEGISLATION.
- 4. IT IS THE RESPONSIBILITY OF THE CONTRACTOR AND ALL SUBCONTRACTORS TO CHECK AND VERIFY ALL CONDITIONS, DIMENSIONS, LINES AND LEVELS INDICATED. PROPER FIT AND ATTACHMENT OF ALL PARTS IS REQUIRED. SHOULD THERE BE ANY DISCREPANCIES, IMMEDIATELY NOTIFY THE ENGINEER FOR CORRECTION OR ADJUSTMENT THE EVENT OF FAILURE TO DO SO, THE CONTRACTOR SHALL BE RESPONSIBLE FOR CORRECTION OF ANY ERROR.
- 5. ALL DIMENSIONS AND CONDITIONS SHALL BE CHECKED AND VERIFIED ON THE JOB BY EACH SUBCONTRACTOR BEFORE HE/SHE BEGINS HIS/HER WORK. ANY ERRORS, OMISSION, OR DISCREPANCIES SHALL BE BROUGHT TO THE ATTENTION OF THE OWNER/CONTRACTOR BEFORE CONSTRUCTION BEGINS.
- COMMENCEMENT OF WORK BY THE CONTRACTOR AND/OR ANY SUBCONTRACTOR SHALL INDICATE KNOWLEDGE AND ACCEPTANCE OF ALL CONDITIONS DESCRIBED IN THESE CONSTRUCTION DOCUMENTS, OR EXISTING ON SITE, WHICH COULD AFFECT THEIR WORK.

- 1. IN THE EVENT ANY SPECIAL SEQUENCING OF THE WORK IS REQUIRED BY THE OWNER OR THE CONTRACTOR, THE CONTRACTOR SHALL ARRANGE A CONFERENCE BEFORE ANY SUCH WORK IS
- 2. SITE EXAMINATION: THE CONTRACTOR AND ALL SUBCONTRACTORS SHALL THOROUGHLY EXAMINE THE SITE AND FAMILIARIZE HIM/HERSELF WITH THE CONDITIONS UNDER WHICH THE WORK IS TO BE PERFORMED. THE CONTRACTOR SHALL VERIFY AT THE SITE ALL MEASUREMENTS AFFECTING HIS/HER WORK AND SHALL BE RESPONSIBLE FOR THE CORRECTIONS OF THE SAME. NO EXTRA COMPENSATION WILL BE ALLOWED TO THE CONTRACTOR FOR EXPENSES DUE TO HIS/HER NEGLECT TO EXAMINE, OR FAILURE TO DISCOVER, CONDITIONS WHICH AFFECT HIS/HER WORK.
- 3. LEA AND BRAZE ENGINEERING, INC. EXPRESSLY RESERVES ITS COMMON LAW COPYRIGHT AND OTHER PROPERTY RIGHTS IN THESE PLANS. THESE PLANS ARE NOT TO BE REPRODUCED, CHANGED OR COPIED IN ANY FORM OR MANNER WHATSOEVER, NOR ARE THEY TO BE ASSIGNED TO A THIRD PARTY WITHOUT FIRST OBTAINING THE WRITTEN PERMISSION AND CONSENT OF LEA AND BRAZE ENGINEERING, INC. IN THE EVENT OF UNAUTHORIZED REUSE OF THESE PLANS BY A THIRD PARTY, THE THIRD PARTY SHALL HOLD HARMLESS LEA AND BRAZE ENGINEERING, INC.
- CONSTRUCTION IS ALWAYS LESS THAN PERFECT SINCE PROJECTS REQUIRE THE COORDINATION AND INSTALLATION OF MANY INDIVIDUAL COMPONENTS BY VARIOUS CONSTRUCTION INDUSTRY TRADES. THESE DOCUMENTS CANNOT PORTRAY ALL COMPONENTS OR ASSEMBLIES EXACTLY. IT IS THE Intention of these engineering documents that they represent a reasonable standard OF CARE IN THEIR CONTENT. IT IS ALSO PRESUMED BY THESE DOCUMENTS THAT CONSTRUCTION REVIEW SERVICES WILL BE PROVIDED BY THE ENGINEER. SHOULD THE OWNER NOT RETAIN THE ENGINEER TO PROVIDE SUCH SERVICES, OR SHOULD HE/SHE RETAIN THE ENGINEER TO PROVIDE ONLY PARTIAL OR LIMITED SERVICES, THEN IT SHALL BE THE OWNER'S AND CONTRACTOR'S RESPONSIBILITY TO FULLY RECOGNIZE AND PROVIDE THAT STANDARD OF CARE.
- 5. IF THE OWNER OR CONTRACTOR OBSERVES OR OTHERWISE BECOMES AWARE OF ANY FAULT OR DEFECT IN THE PROJECT OR NONCONFORMANCE WITH THE CONTRACT DOCUMENTS, PROMPT WRITTEN NOTICE THEREOF SHALL BE GIVEN BY THE OWNER AND/OR CONTRACTOR TO THE ENGINEER.
- 6. THE ENGINEER SHALL NOT HAVE CONTROL OF OR CHARGE OF AND SHALL NOT BE RESPONSIBLE FOR CONSTRUCTION MEANS, METHODS, TECHNIQUES, SEQUENCES, OR PROCEDURES, OR FOR SAFETY PRECAUTIONS AND PROGRAMS IN CONNECTION WITH THE WORK, FOR THE ACTS OR OMISSIONS OF THE CONTRACTOR, SUBCONTRACTORS, OR ANY OTHER PERSONS PERFORMING ANY OF THE WORK. OR FOR THE FAILURE OF ANY OF THEM TO CARRY OUT THE WORK IN ACCORDANCE WITH THE CONTRACT DOCUMENTS.

#### SITE PROTECTION

PROTECT ALL LANDSCAPING THAT IS TO REMAIN. ANY DAMAGE OR LOSS RESULTING FROM EXCAVATION. GRADING, OR CONSTRUCTION WORK SHALL BE CORRECTED OR REPLACED BY THE CONTRACTOR AT NO ADDITIONAL COST TO THE OWNER. THE CONTRACTOR SHALL BE RESPONSIBLE FOR THE LOCATION OF ALL EXISTING SITE UTILITIES AND SHALL COORDINATE THEIR REMOVAL OR MODIFICATIONS (IF ANY) TO AVOID ANY INTERRUPTION OF SERVICE TO ADJACENT AREAS. THE GENERAL CONTRACTOR SHALL INFORM HIM/HERSELF OF MUNICIPAL REGULATIONS AND CARRY OUT HIS/HER WORK IN COMPLIANCE WITH ALL FEDERAL AND STATE REQUIREMENTS TO REDUCE FIRE HAZARDS AND INJURIES TO THE PUBLIC.

#### **EXISTING CONDITIONS:**

- 1. EXISTING TOPOGRAPHIC SURVEY PERFORMED BY LEA & BRAZE ENGINEERING INC. SURVEYING ON 01-06-16 (JOB #2151288), GRADES ENCOUNTERED ON-SITE MAY VARY FROM THOSE SHOWN. CONTRACTOR SHALL REVIEW THE PLANS AND CONDUCT FIELD INVESTIGATIONS AS REQUIRED TO VERIFY EXISTING CONDITIONS AT THE PROJECT SITE.
- 2. CLIENT SHALL HOLD HARMLESS LEA & BRAZE ENGINEERING FROM ANY AND ALL OCCURRENCES RESULTING FROM THE ACCURACY/INACCURACY OF THE CLIENT SUPPLIED TOPOGRAPHIC AND BOUNDARY SURVEY (AS PREPARED BY OTHERS).

#### SURVEYOR'S NOTES:

THE TYPES, LOCATIONS, SIZES AND/OR DEPTHS OF EXISTING UNDERGROUND UTILITIES AS SHOWN ON THIS TOPOGRAPHIC SURVEY ARE APPROXIMATE AND WERE OBTAINED FROM SOURCES OF VARYING RELIABILITY. ONLY ACTUAL EXCAVATION WILL REVEAL THE TYPES. EXTENT, SIZES, LOCATIONS AND DEPTHS OF SUCH UNDERGROUND UTILITIES. A REASONABLE EFFORT HAS BEEN MADE TO LOCATE AND DELINEATE ALL KNOWN UNDERGROUND UTILITIES. HOWEVER, THE ENGINEER CAN ASSUME NO RESPONSIBILITY FOR THE COMPLETENESS OR ACCURACY OF IT'S DELINEATE OF SUCH UNDERGROUND UTILITIES WHICH MAY BE ENCOUNTERED. BUT WHICH ARE NOT SHOWN ON THIS SURVEY.

CONTRACTOR SHALL VERIFY ALL UTILITIES IN DEPTH AND LOCATION PRIOR TO CONSTRUCTION.

#### TREE/PLANT PROTECTION NOTES:

- PRIOR TO BEGINNING CONSTRUCTION, CONTRACTOR SHALL IDENTIFY, CONFIRM WITH OWNER AND PROTECT EXISTING TREES AND PLANTS DESIGNED AS TO REMAIN. PROVIDE 6 FOOT TALL TREE PROTECTION FENCE WITH DISTINCTIVE MARKING VISIBLE TO
- CONSTRUCTION EQUIPMENT, ENCLOSING DRIP LINES OF TREES DESIGNED TO REMAIN. WORK REQUIRED WITHIN FENCE LINE SHALL BE HELD TO A MINIMUM, AVOID USE OF HEAVY EQUIPMENT WITHIN FENCED AREA AND DO NOT PARK ANY VEHICLES UNDER DRIP
- LINE OF TREES. DO NOT STORE EQUIPMENT OR MATERIALS WITHIN FENCE LINE. PRIOR TO REMOVING ROOTS AND BRANCHES LARGER THAN 2" IN DIAMETER OF TREES OR
- PLANTS THAT IS TO REMAIN. CONSULT WITH THE OWNER'S PROJECT MANAGER. ANY GRADE CHANGES GREATER THAN 6" WITHIN THE DRIPLINE OF EXISTING TREES SHALL NOT BE MADE WITHOUT FIRST CONSULTING THE LANDSCAPE ARCHITECT / CIVIL
- PROTECT EXISTING TREES TO REMAIN FROM SPILLED CHEMICALS, FUEL OIL, MOTOR OIL, GASOLINE AND ALL OTHER CHEMICALLY INJURIOUS MATERIALS: AS WELL AS FROM PUDDLING OR CONTINUOUSLY RUNNING WATER. SHOULD A SPILL OCCUR, STOP WORK IN THAT AREA AND CONTACT THE CITY'S ENGINEER / INSPECTOR IMMEDIATELY. CONTRACTOR SHALL BE RESPONSIBLE TO MITIGATÉ DAMAGE FROM SPILLED MATERIAL AS WELL AS MATERIAL CLEAN UP.
- PROVIDE TEMPORARY IRRIGATION TO ALL TREES AND PLANTS THAT ARE IN OR ADJACENT TO CONSTRUCTION AREAS WHERE EXISTING IRRIGATION SYSTEMS MAY BE AFFECTED BY
- THE CONSTRUCTION. ALSO PROVIDE TEMPORARY IRRIGATION TO RELOCATE TREES. CONTRACTOR SHALL BE RESPONSIBLE FOR ONGOING MAINTENANCE OF ALL TREES AND PLANTS DESIGNED TO REMAIN AND FOR MAINTENANCE OF RELOCATED TREES STOCKPILED DURING CONSTRUCTION. CONTRACTOR WILL BE REQUIRED TO REPLACE TREES OR PLANTS THAT DIE DUE TO LACK OF MAINTENANCE.

- 1. CONTRACTOR IS TO COMPLY WITH ALL GENERAL AND STATE REQUIREMENTS INVOLVING THE REMOVAL AND DISPOSAL OF HAZARDOUS MATERIAL(S).
- THE CONTRACTOR SHALL LOCATE AND CLEARLY MARK (AND THEN PRESERVE THESE MARKERS) FOR THE DURATION OF CONSTRUCTION OF ALL TELEPHONE, DATA, STREET LIGHT, SIGNAL LIGHT AND POWER FACILITIES THAT ARE IN OR NEAR THE AREA OF CONSTRUCTION.
- CONTRACTOR'S BID IS TO INCLUDE ALL VISIBLE SURFACE AND ALL SUBSURFACE FEATURES
- IDENTIFIED TO BE REMOVED OR ABANDONED IN THESE DOCUMENTS. THE CONTRACTOR SHALL BE RESPONSIBLE FOR A SITE INSPECTION TO FULLY
- ACKNOWLEDGE THE EXTENT OF THE DEMOLITION WORK.
- THE CONTRACTOR SHALL BE RESPONSIBLE FOR OBTAINING ANY AND ALL PERMITS NECESSARY FOR ENCROACHMENT, GRADING, DEMOLITION, AND STATE JURISDICTIONS.
- THE CONTRACTOR SHALL PAY ALL FEES ASSOCIATED WITH DISPOSAL OF MATERIALS BACKFILL ALL DEPRESSIONS AND TRENCHES FROM DEMOLITION OF FOUNDATIONS &
- UTILITIES TO THE SATISFACTION OF THE GEOTECHNICAL ENGINEER.
- WITHIN LIMITS OF WORK, REMOVE CURBS, GUTTERS, LANDSCAPING, SIGNAGE, TREES, SCRUBS, ASPHALT, UNDERGROUND PIPES, ETC. AS INDICATED ON THE PLANS AND SPECIFICATIONS.
- REMOVAL OF LANDSCAPING SHALL INCLUDE ROOTS AND ORGANIC MATERIALS TO THE SATISFACTION OF THE GEOTECHNICAL ENGINEER.
- PRIOR TO BEGINNING DEMOLITION WORK ACTIVITIES. CONTRACTOR SHALL INSTALL EROSION
- CONTROL MEASURES OUTLINED IN THE EROSION PLAN & DETAILS. CONTRACTOR SHALL BE RESPONSIBLE FOR DISPOSING ALL DEMOLITION MATERIALS, OR
- STORING SELECTED ITEMS BY OWNER'S REPRESENTATIVE AT DESIGNATED LOCATIONS. 12. THE CONTRACTOR SHALL MAINTAIN ALL SAFETY DEVICES, AND SHALL BE RESPONSIBLE
- FOR CONFORMANCE TO ALL LOCAL STATE AND FEDERAL SAFETY AND HEALTH STANDARDS LAWS AND REGULATIONS. 13. THE CONTRACTOR SHALL PROTECT FROM DAMAGE ALL EXISTING IMPROVEMENTS FACILITIES
- AND STRUCTURES WHICH ARE TO REMAIN. ANY ITEMS DAMAGED BY THE CONTRACTOR OR HIS AGENTS OF ANY ITEMS REMOVED FOR HIS USE SHALL BE REPLACED IN EQUAL OR BETTER CONDITION AS APPROVED BY THE ARCHITECT OR OWNER'S REPRESENTATIVE. COORDINATE WITH ELECTRICAL, MECHANICAL, LANDSCAPING AND ARCHITECTURAL DRAWINGS FOR UTILITY SHUT-DOWN / DISCONNECT LOCATIONS. CONTRACTOR IS TO SHUT OFF ALL
- UTILITIES AS NECESSARY PRIOR TO DEMOLITION. CONTRACTOR IS TO COORDINATE SERVICE INTERRUPTIONS WITH THE DEVELOPER / OWNER. DO NOT INTERRUPT SERVICES ADJACENT OFF-SITE OWNERS, ALSO SEE ARCHITECTURAL PLANS FOR ADDITIONAL DEMOLITION SCOPE OF WORK.
- 15. DEMOLITION INCLUDES REMOVAL OF ALL ITEMS ASSOCIATED WITH THE UTILITY, RETAINING WALL, FENCE, TREE OR BUILDING, INCLUDING BUT NOT LIMITED TO FOOTINGS, VALVES, ROOTS, BACKFILL, ETC. AND SHALL INCLUDE PREPARING THE SITE FOR NEW UTILITIES, BUILDINGS, RETAINING WALLS, ETC.
- 16. ALL MATERIALS TO BE DEMOLISHED AND REMOVED SHALL BECOME THE PROPERTY OF THE CONTRACTOR AND SHALL BE LAWFULLY DISPOSED OF OFF-SITE.
- 17. THE PLAN IS NOT INTENDED TO BE A COMPLETE CATALOGUE OF ALL EXISTING STRUCTURES AND UTILITIES. THIS PLAN INTENDS TO DISCLOSE GENERAL INFORMATION KNOWN BY THE ENGINEER AND TO SHOW THE LIMITS OF THE AREA WHERE WORK WILL BE PERFORMED. THIS PLAN SHOWS THE EXISTING FEATURES TAKEN FROM A FIELD SURVEY, FIELD INVESTIGATIONS AND AVAILABLE INFORMATION. THIS PLAN MAY OR MAY NOT ACCURATELY REFLECT THE TYPE OR EXTENT OF THE ITEMS TO BE ENCOUNTERED AS THEY ACTUALLY EXIST. WHERE EXISTING FEATURES ARE NOT SHOWN, IT IS IMPLIED THAT THEY ARE NOT TO BE DEMOLISHED OR REMOVED. THE CONTRACTOR SHALL PERFORM A THOROUGH FIELD INVESTIGATION AND REVIEW OF THE SITE WITHIN THE LIMIT OF WORK SHOWN IN THIS PLAN SET TO DETERMINE THE TYPE, QUANTITY AND EXTENT OF ANY AND ALL ITEMS. THE CONTRACTOR SHALL BE SOLELY RESPONSIBLE FOR DETERMINING THE EXTENT OF EXISTING STRUCTURES AND UTILITIES AND QUANTITY OR WORK INVOLVED IN REMOVING THESE ITEMS FROM THE SITE.
- 18. ALL ABANDONED BUILDINGS AND FOUNDATIONS, TREE (EXCEPT THOSE SPECIFIED TO REMAIN FOR LANDSCAPING PURPOSES), FENCES, VEGETATION AND ANY SURFACE DEBRIS SHALL BE REMOVED AND DISPOSED OF OFF THE SITE BY THE CONTRACTOR.
- 19. ALL ABANDONED UNDERGROUND TANKS AND ANY OTHER SUBSURFACE STRUCTURES EXISTING IN PROPOSED DEVELOPMENT AREAS SHALL BE REMOVED PRIOR TO ANY GRADING OR FILL OPERATION. ALL APPURTENANT DRAIN FIELDS AND OTHER CONNECTING LINES MUST ALSO BE TOTALLY REMOVED.
- 20. ALL UNDERGROUND IRRIGATION OR UTILITY LINES SHALL BE REMOVED 5' BEYOND PROPOSED BUILDING FOUNDATION. THE APPROPRIATE FINAL DISPOSITION OF SUCH LINES DEPEND UPON THEIR DEPTH AND LOCATION AND THE METHOD OF REMOVAL OR DEMOLITION SHALL BE DETERMINED BY THE SOILS ENGINEER. ONE OF THE FOLLOWING METHODS WILL BE USED:
- A. EXCAVATE AND TOTALLY REMOVE THE UTILITY LINE FROM THE TRENCH.
- B. EXCAVATE AND CRUSH THE UTILITY LINE IN THE TRENCH.
- C. CAP THE ENDS OF THE UTILITY LINE WITH CONCRETE TO PREVENT THE ENTRANCE OF WATER. THE LOCATIONS AT WHICH THE UTILITY LINE WILL BE CAPPED WILL BE DETERMINED BY THE CITY ENGINEER. THE LENGTH OF THE CAP SHALL NOT BE LESS THAN FIVE FEET, AND THE CONCRETED MIX EMPLOYED SHALL HAVE MINIMUM SHRINKAGE.

#### PAVEMENT SECTION:

- SEE STRUCTURAL DRAWINGS FOR BUILDING SLAB SECTIONS AND PAD
- PREPARATIONS. SEE GRADING AND DRAINAGE PLAN AS WELL AS DETAIL SHEETS FOR FLATWORK
- SECTIONS AND BASE REQUIREMENTS. EXISTING PAVEMENT SHALL BE TACK COATED PRIOR TO CONSTRUCTING NEW PAVEMENT.
- 4. THE FINAL OR SURFACE LAYER OF ASPHALT CONCRETE SHALL NOT BE PLACED UNTIL ALL ON-SITE IMPROVEMENTS HAVE BEEN COMPLETED, INCLUDING ALL GRADING, AND ALL UNACCEPTABLE CONCRETE WORK HAS BEEN REMOVED AND REPLACED. UNLESS OTHERWISE APPROVED BY THE CITY ENGINEER AND/OR DEVELOPER'S CITY ENGINEER.
- ALL PAVING SHALL BE IN CONFORMANCE WITH THE LATEST EDITION OF CALTRANS STANDARD SPECIFICATIONS.

#### SITE MAINTENANCE:

- 1. REMOVE ALL DIRT, GRAVEL, RUBBISH, REFUSE, AND GREEN WASTE FROM STREET PAVEMENT AND STORM DRAINS ADJOINING THE SITE. LIMIT CONSTRUCTION ACCESS ROUTES ONTO THE SITE AND PLACE GRAVEL PADS AT THESE LOCATIONS. DO NOT DRIVE VEHICLES AND EQUIPMENT OFF THE PAVED OR GRAVELED AREAS DURING
- WET WEATHER. SWEEP OR VACUUM THE STREET PAVEMENT AND SIDEWALKS ADJOINING THE PROJECT SITE AND THE ON-SITE PAVED AREAS ON A DAILY BASIS. SCRAPI CAKED-ON MUD AND DIRT FROM THESE AREAS BEFORE SWEEPING. CORNERS AND
- HARD TO REACH AREAS SHALL BE SWEPT MANUALLY. CONTRACTOR SHALL: GATHER ALL CONSTRUCTION DEBRIS ON A REGULAR BASIS AND PLACE IT IN A DUMPSTER OR OTHER CONTAINER WHICH IS EMPTIED OR REMOVED ON A REGULAR BASIS. WHEN APPROPRIATE, USE TARPS ON THE GROUND TO COLLECT FALLEN DEBRIS OR SPLATTERS THAT COULD CONTRIBUTE TO STORM WATER RUNOFF POLLUTION.
- 4. IF THE STREET, SIDEWALKS AND/OR PARKING LOT ARE PRESSURE WASHED, DEBRIS MUST BE TRAPPED AND COLLECTED TO PREVENT ENTRY INTO THE STORM DRAIN SYSTEM. NO CLEANING AGENT MAY BE DISCHARGED INTO THE STORM DRAIN. IF ANY CLEANING AGENT OR DEGREASER IS USED. WASHED WATER MUST BE COLLECTED AND DISCHARGED TO THE SANITARY SEWER, SUBJECT TO THE APPROVAL OF THE OWNER'S PROJECT MANAGER, OR OTHERWISE DISPOSED OF THROUGH APPROVED DISPOSAL METHODS.
- CREATE A CONTAINED AND COVERED AREA ON THE SITE FOR THE STORAGE OF BAGS, CEMENT, PAINTS, OILS, FERTILIZERS, PESTICIDES, OR OTHER MATERIAL USED ON THE SITE THAT HAVE THE POTENTIAL OF BEING WIND-BLOWN OR IN THE EVENT OF A MATERIAL SPILL.
- NEVER CLEAN MACHINERY, EQUIPMENT OR TOOLS INTO A STREET, GUTTER OR STORM DRAIN.
- ENSURE THAT CEMENT TRUCKS, PAINTERS, OR STUCCO/PLASTER FINISHING CONTRACTORS DO NOT DISCHARGE WASH WATER FROM EQUIPMENT, TOOLS OR RINSE CONTAINERS INTO GUTTERS OR DRAINS.
- THE ON-SITE STORM DRAIN FACILITIES SHALL BE CLEANED A MINIMUM OF TWICE A YEAR AS FOLLOWS: IMMEDIATELY PRIOR TO OCTOBER 15TH AND ONCE IN JANUARY. ADDITIONAL CLEANING MAY BE REQUIRED IF FOUND NECESSARY BY THE CITY ENGINEER/INSPECTOR. CONTRACTOR SHALL BE RESPONSIBLE FOR COST ASSOCIATED WITH CLEANING.
- PREVENT DUST FROM LEAVING THE SITE AND ACCUMULATING ON ADJACENT AREAS AS REQUIRED IN THE DUST CONTROL NOTES ON THIS SHEET.
- 10. PREVENT SEDIMENT LADEN STORM RUN-OFF FROM LEAVING THE SITE OR ENTERING STORM DRAIN OR SANITARY SEWER SYSTEMS AS REQUIRED IN THE EROSION AND SEDIMENTATION CONTROL NOTES ON THIS SHEET.
- 11. MAINTAIN EXISTING TREES AND PLANTS THAT ARE TO REMAIN AS REQUIRED BY THE TREE AND PLANT PROTECTION NOTES ON THE SHEET.

#### **EARTHWORK QUANTITY NOTES:**

- 1. THE CONTRACTOR IS RESPONSIBLE FOR DETERMINING THE QUANTITIES OF ALL FORMS OF EARTHWORK ON THIS PROJECT AND BASING THE BID ON THOSE QUANTITIES WITH FULL KNOWLEDGE THAT ADDITIONAL PROCESSES - INCLUDING ENGINEERING - AND QUANTITIES ARE ALSO TO BE INCLUDED IN THE BID PER THE FOLLOWING NOTES.
- 2. THE CONTRACTOR SHALL MAKE AN INITIAL DETERMINATION OF THE QUANTITIES. BASED ON A DETAILED SITE VISIT. THE TOPOGRAPHIC SURVEY. THE GEOTECHNICAL REPORT. THE FINISH GRADES SHOWN ON THESE DRAWINGS. THE SIZE AND EXTENT OF FOOTINGS, THE PREPARATION AND MATERIALS USED FOR BUILDING SLABS, PAVEMENT SECTIONS, AND THE SIZE AND DEPTH OF UTILITY TRENCHES, INCLUDING THE UTILITY CONTRACTORS ANTICIPATED RE-USE OF EXISTING MATERIAL FOR BACKFILL IF ANY.
- 3. THE CONTRACTOR SHALL MEET THE GRADES SHOWN ON THE DRAWINGS. ADJUSTING THE AMOUNT OF IMPORT OR EXPORT AS REQUIRED TO DO SO. NO ASSUMPTIONS SHOULD BE MADE ABOUT THE SITE BALANCING. NO ADJUSTMENTS TO THE GRADE SHALL BE PERMITTED UNLESS SPECIFICALLY APPROVED BY THE ARCH/ENGR IN WRITING AFTER THE IMPACT OF ANY GRADE CHANGES (IMPACT TO RAMPS, STAIRS, WORK BY OTHERS, ETC.) HAS BEEN THOROUGHLY REVIEWED BY THE ARCH/ENGR. WHEN PREPARING THE EARTHWORK BIDS, DO NOT ASSUME ANY CHANGES TO THE FINISHED GRADES SHOWN ON THESE DRAWINGS WILL BE PERMITTED.

#### SITE FENCING NOTES:

- 1. CONTRACTOR SHALL PROVIDE A CONSTRUCTION FENCE AROUND THE ENTIRE AREA OF DEMOLITION AND CONSTRUCTION, INCLUDING ALL STAGING, STORAGE, CONSTRUCTION OFFICE AND LAYDOWN AREAS.
- 2. FENCE LOCATION MAY BE ADJUSTED FROM TIME TO TIME AS CONSTRUCTION PROCEEDS TO EXCLUDE SOME AREAS WHERE CONSTRUCTION WORK IS NOT BEING DONE AND THE AREA IS NOT OBJECTIONABLE IN VISUAL APPEARANCE, AT THE DISCRETION AND APPROVAL OF THE DISTRICT STAFF.
- CONSTRUCTION FENCE SHALL BE A MINIMUM OF A 6' HIGH GALVANIZED CHAIN LINK FENCE WITH GREEN WINDSCREEN FABRIC ON THE OUTSIDE OF THE FENCE.
- CONTRACTOR SHALL REPLACE THE GREEN FABRIC AT LEAST ONCE A YEAR OR AT SUCH A TIME AS IT BECOMES TATTERED AND UNSIGHTLY DUE TO WIND OR CONSTRUCTION ACTIVITIES.

#### DUST CONTROL:

- WATER TRUCKS SHALL BE PRESENT AND IN USE AT THE CONSTRUCTION SITE. ALL PORTIONS OF THE SITE SUBJECT TO BLOWING DUST SHALL BE WATERED AS OFTEN AS DEEMED NECESSARY BY THE APPROPRIATE GOVERNMENTAL AGENCY IN ORDER TO ENSURE PROPER
- CONTROL OF BLOWING DUST FOR THE DURATION OF THE PROJECT. WATERING ASSOCIATED WITH ON-SITE CONSTRUCTION ACTIVITY SHALL TAKE PLACE BETWEEN THE ESTABLISHED CONSTRUCTION HOURS AND SHALL INCLUDE AT LEAST ONE
- LATE—AFTERNOON WATERING TO MINIMIZE THE EFFECTS OF BLOWING DUST. ALL PUBLIC STREETS AND MEDIANS SOILED OR LITTERED DUE TO THIS CONSTRUCTION ACTIVITY SHALL BE CLEANED AND SWEPT ON A DAILY BASIS DURING THE WORK WEEK. OR AS OFTEN AS DEEMED NECESSARY BY THE OWNER'S ENGINEER/INSPECTOR. TO THE SATISFACTION OF THE CITY'S DEPARTMENT OF PUBLIC WORKS.
- WATERING ON PUBLIC STREETS OR POWER WASHING SEDIMENTATION ON STREETS SHALL NOT OCCUR, UNLESS CONTRACTOR COLLECTS AND FILTERS THE WASH WATER PRIOR TO ITS ENTERING THE CITY'S STORM DRAIN SYSTEM.
- ON-SITE PAVED ACCESS ROADS, PARKING AREAS AND STAGING AREAS SHALL BE SWEPT DAILY WITH A WATER SWEEPER.
- WHEEL WASHERS SHALL BE INSTALLED AND USED TO CLEAN ALL TRUCKS AND EQUIPMENT LEAVING THE CONSTRUCTION SITE. IF WHEEL WASHERS CANNOT BE INSTALLED, TIRES OR TRACKS OF ALL TRUCKS AND EQUIPMENT SHALL BE WASHED OFF BEFORE LEAVING THE
- CONSTRUCTION SITE. GRADING OR ANY OTHER OPERATIONS THAT CREATES DUST SHALL BE STOPPED IMMEDIATELY IF DUST AFFECTS ADJACENT PROPERTIES. THE CONTRACTOR SHALL PROVIDE SUFFICIENT DUST CONTROL FOR THE ENTIRE PROJECT SITE IN ACCORDANCE WITH THE PROJECT SWPPP AT ALL TIMES. THE SITE SHALL BE SPRINKLERED AS NECESSARY TO PREVENT DUST NUISANCE, IN THE EVENT THAT THE CONTRACTOR NEGLECTS TO USE ADEQUATE MEASURES TO CONTROL DUST. THE CITY RESERVES THE RIGHT TO TAKE WHATEVER MEASURES ARE NECESSARY TO CONTROL DUST AND CHARGE THE COST TO THE CONTRACTOR.
- THE PERMITEE IS RESPONSIBLE FOR DUST CONTROL MEASURES AND FOR OBTAINING ALL REQUIRED PERMITS AND APPROVALS. ALL GRADING OPERATIONS SHALL BE SUSPENDED DURING SECOND (OR WORSE) STAGE SMOG ALERTS.
- 9. ALL TRUCKS HAULING SOIL, SAND, AND OTHER LOOSE MATERIALS SHALL BE COVERED WITH TARPAULINS OR OTHER EFFECTIVE COVERS.

#### GRADING & DRAINAGE NOTES:

- SCOPE OF WORK
  THESE SPECIFICATIONS AND APPLICABLE PLANS PERTAIN TO AND INCLUDE ALL SITE GRADING AND EARTHWORK ASSOCIATED WITH THE PROJECT INCLUDING, BUT NOT LIMITED TO THE FURNISHING OF ALL LABOR, TOOLS AND EQUIPMENT NECESSARY FOR SITE CLEARING AND GRUBBING, SITE PREPARATION, DISPOSAL OF EXCESS OR UNSUITABLE MATERIAL, STRIPPING, KEYING, EXCAVATION, OVER EXCAVATION, RECOMPACTION PREPARATION FOR SOIL RECEIVING FILL, PAVEMENT, FOUNDATION OF SLABS, EXCAVATION, IMPORTATION OF ANY REQUIRED FILL MATERIAL, PROCESSING, PLACEMENT AND COMPACTION OF FILL AND SUBSIDIARY WORK NECESSARY TO COMPLETE THE GRADING TO CONFORM TO THE LINES, GRADING AND SLOPE SHOWN ON THE PROJECT GRADING PLANS.
- A. ALL SITE GRADING AND EARTHWORK SHALL CONFORM TO THE RECOMMENDATIONS OF THESE SPECIFICATIONS, THE SOILS REPORT BY WAYPOINT ANALYTICAL: "GEOTECHNICAL INVESTIGATIONS", PROJECT NUMBER. 16-092-0105, DATED
- B. ALL FILL MATERIALS SHALL BE DENSIFIED SO AS TO PRODUCE A DENSITY NOT LESS THAN 90% RELATIVE COMPACTION BASED UPON ASTM TEST DESIGNATION D1557. FIELD DENSITY TEST WILL BE PERFORMED IN ACCORDANCE WITH ASTM TEST DESIGNATION 2922 AND 3017. THE LOCATION AND FREQUENCY OF THE FIELD DENSITY test will be as determined by the soil engineer. The results of these test and compliance with the SPECIFICATIONS WILL BE THE BASIS UPON WHICH SATISFACTORY COMPLETION OF THE WORK WILL BE JUDGED BY THE SOIL ENGINEER. ALL CUT AND FILL SLOPES SHALL BE CONSTRUCTED AS SHOWN ON PLANS, BUT NO STEEPER THAN TWO (2) HORIZONTAL TO ONE (1) VERTICAL.
- C. THE CONTRACTOR SHALL BE RESPONSIBLE FOR THE SATISFACTORY COMPLETION OF ALL THE EARTHWORK IN ACCORDANCE WITH THESE PLANS AND SPECIFICATIONS. NO DEVIATION FROM THESE SPECIFICATIONS SHALL BE MADE EXCEPT UPON WRITTEN APPROVAL BY THE SOILS ENGINEER. BOTH CUT AND FILL AREAS SHALL BE SURFACE COMPLETED TO THE SATISFACTION OF THE SOILS ENGINEER AT THE CONCLUSION OF ALL GRADING OPERATIONS AND PRIOR TO FINAL ACCEPTANCE. THE CONTRACTOR SHALL NOTIFY THE SOILS ENGINEER AT LEAST TWO (2) WORKING DAYS PRIOR TO DOING ANY SITE GRADING AND EARTHWORK INCLUDING CLEARING.

#### CLEARING AND GRUBBING

- A. THE CONTRACTOR SHALL ACCEPT THE SITE IN ITS PRESENT CONDITION. ALL EXISTING PUBLIC IMPROVEMENTS SHALL BE PROTECTED. ANY IMPROVEMENTS DAMAGED SHALL BE REPLACED BY THE CONTRACTOR AS DIRECTED BY THE LOCAL JURISDICTION WITH NO EXTRA COMPENSATION.
- B. ALL ABANDONED BUILDINGS AND FOUNDATIONS, TREE (EXCEPT THOSE SPECIFIED TO REMAIN FOR LANDSCAPING PURPOSES), FENCES, VEGETATION AND ANY SURFACE DEBRIS SHALL BE REMOVED AND DISPOSED OF OFF THE SITE BY THE CONTRACTOR. C. ALL ABANDONED SEPTIC TANKS AND ANY OTHER SUBSURFACE STRUCTURES EXISTING IN PROPOSED DEVELOPMENT
- AREAS SHALL BE REMOVED PRIOR TO ANY GRADING OR FILL OPERATION. ALL APPURTENANT DRAIN FIELDS AND OTHER CONNECTING LINES MUST ALSO BE TOTALLY REMOVED. D. ALL ABANDONED UNDERGROUND IRRIGATION OR UTILITY LINES SHALL BE REMOVED OR DEMOLISHED. THE
- APPROPRIATE FINAL DISPOSITION OF SUCH LINES DEPEND UPON THEIR DEPTH AND LOCATION AND THE METHOD OF REMOVAL OR DEMOLITION SHALL BE DETERMINED BY THE SOILS ENGINEER. ONE OF THE FOLLOWING METHODS WILL BE
- (1) EXCAVATE AND TOTALLY REMOVE THE UTILITY LINE FROM THE TRENCH.

EMPLOYED SHALL HAVE MINIMUM SHRINKAGE.


- (2) EXCAVATE AND CRUSH THE UTILITY LINE IN THE TRENCH. (3) CAP THE ENDS OF THE UTILITY LINE WITH CONCRETE TO PREVENT THE ENTRANCE OF WATER. THE LOCATIONS AT WHICH THE UTILITY LINE WILL BE CAPPED WILL BE DETERMINED BY THE UTILITY DISTRICT ENGINEER. THE LENGTH OF THE CAP SHALL NOT BE LESS THAN FIVE FEET, AND THE CONCRETED MIX
- SITE PREPARATION AND STRIPPING

  A. ALL SURFACE ORGANICS SHALL BE STRIPPED AND REMOVED FROM BUILDING PADS, AREAS TO RECEIVE COMPACTED FILL AND PAVEMENT AREAS.
- B. UPON THE COMPLETION OF THE ORGANIC STRIPPING OPERATION, THE GROUND SURFACE (NATIVE SOIL SUBGRADE) OVER THE ENTIRE AREA OF ALL BUILDING PADS, STREET AND PAVEMENT AREAS AND ALL AREAS TO RECEIVE COMPACTED FILL SHALL BE PLOWED OR SCARIFIED UNTIL THE SURFACE IS FREE OF RUTS, HUMMOCKS OR OTHER Uneven features which may inhibit uniform soil compaction. The ground surface shall then be disced OR BLADED TO A DEPTH OF AT LEAST 6 INCHES. UPON ENGINEER'S SATISFACTION. THE NEW SURFACE SHALL BE WATER CONDITIONED AND RECOMPACTED PER REQUIREMENTS FOR COMPACTING FILL MATERIAL.

#### **EXCAVATION**

- A. UPON COMPLETION OF THE CLEARING AND GRUBBING, SITE PREPARATION AND STRIPPING, THE CONTRACTOR SHALL MAKE EXCAVATIONS TO LINES AND GRADES NOTED ON THE PLAN. WHERE REQUIRED BY THE SOILS ENGINEER. UNACCEPTABLE NATIVE SOILS OR UNENGINEERED FILL SHALL BE OVER EXCAVATED BELOW THE DESIGN GRADE. SEE PROJECT SOILS REPORT FOR DISCUSSION OF OVER EXCAVATION OF THE UNACCEPTABLE MATERIAL. RESULTING GROUND LINE SHALL BE SCARIFIED, MOISTURE-CONDITIONED AND RECOMPACTED AS SPECIFIED IN SECTION 4 OF THESE SPECIFICATIONS. COMPACTED FILL MATERIAL SHALL BE PLACED TO BRING GROUND LEVEL BACK TO DESIGN
- B. EXCAVATED MATERIALS SUITABLE FOR COMPACTED FILL MATERIAL SHALL BE UTILIZED IN MAKING THE REQUIRED COMPACTED FILLS. THOSE NATIVE MATERIALS CONSIDERED UNSUITABLE BY THE SOILS ENGINEER SHALL BE DISPOSED OF OFF THE SITE BY THE CONTRACTOR.

- A. UPON COMPLETION OF THE CLEARING AND GRUBBING. SITE PREPARATION AND STRIPPING. THE CONTRACTOR SHALL MAKE EXCAVATIONS TO LINES AND GRADES NOTED ON THE PLAN. WHERE REQUIRED BY THE SOILS ENGINEER. UNACCEPTABLE NATIVE SOILS OR UNENGINEERED FILL SHALL BE OVER EXCAVATED BELOW THE DESIGN GRADE. SEE PROJECT SOILS REPORT FOR DISCUSSION OF OVER EXCAVATION OF THE UNACCEPTABLE MATERIAL, RESULTING GROUND LINE SHALL BE SCARIFIED, MOISTURE—CONDITIONED AND RECOMPACTED AS SPECIFIED IN SECTION 4 OF THESE SPECIFICATIONS. COMPACTED FILL MATERIAL SHALL BE PLACED TO BRING GROUND LEVEL BACK TO DESIGN
- B. EXCAVATED MATERIALS SUITABLE FOR COMPACTED FILL MATERIAL SHALL BE UTILIZED IN MAKING THE REQUIRED COMPACTED FILLS. THOSE NATIVE MATERIALS CONSIDERED UNSUITABLE BY THE SOILS ENGINEER SHALL BE DISPOSED OF OFF THE SITE BY THE CONTRACTOR.

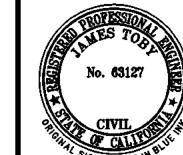

 $\infty$   $\infty$   $\overline{}$ r PLAN: MPROVEMENT ES MAPLE ST 1580 MAPLE

田

COUNTY COMMENTS MH C#2/ADD#6 09-23-16 мн REVISIONS 2151287 JOB NO: DATE: 06-17-16 NTS SCALE: DESIGN BY: MH DRAWN BY: WM

C-6.0

SHEET NO:

#### GRADING & DRAINAGE NOTES (CONT.):

PLACING. SPREADING AND COMPACTING FILL MATERIAL

A. <u>FILL MATERIALS</u> THE MATERIALS PROPOSED FOR USE AS COMPACTED FILL SHALL BE APPROVED BY THE SOILS ENGINEER BEFORE COMMENCEMENT OF GRADING OPERATIONS. THE NATIVE MATERIAL IS CONSIDERED SUITABLE FOR FILL; HOWEVER, ANY NATIVE MATERIAL DESIGNATED UNSUITABLE BY THE SOILS ENGINEER SHALL BE REMOVED FROM THE SITE BY THE CONTRACTOR. ANY IMPORTED MATERIAL SHALL BE APPROVED FOR USE BY THE SOILS ENGINEER, IN WRITING, BEFORE BEING IMPORTED TO THE SITE AND SHALL POSSESS SUFFICIENT FINES TO PROVIDE A COMPETENT SOIL MATRIX AND SHALL BE FREE OF VEGETATIVE AND ORGANIC MATTER AND OTHER DELETERIOUS MATERIALS. ALL FILL VOIDS SHALL BE FILLED AND PROPERLY COMPACTED. NO ROCKS LARGER THAN THREE INCHES IN DIAMETER SHALL BE PERMITTED.

B. FILL CONSTRUCTION THE SOILS ENGINEER SHALL APPROVE THE NATIVE SOIL SUBGRADE BEFORE PLACEMENT OF ANY COMPACTED FILL MATERIAL. UNACCEPTABLE NATIVE SOIL SHALL BE REMOVED AS DIRECTED BY THE SOILS ENGINEER. THE RESULTING GROUND LINE SHALL BE SCARIFIED MOISTURE CONDITIONED AND RECOMPACTED AS SPECIFIED IN SECTION 4 OF THESE SPECIFICATIONS, COMPACTED FILL MATERIAL SHALL BE PLACED TO BRING GROUND LEVEL BACK TO DESIGN GRADE, GROUND PREPARATION SHALL BE FOLLOWED CLOSELY BY FILL PLACEMENT TO PREVENT DRYING OUT OF THE SUBSOIL BEFORE PLACEMENT OF THE FILL.

THE APPROVED FILL MATERIALS SHALL BE PLACED IN UNIFORM HORIZONTAL LAYERS NO THICKER THAN 8" IN LOOSE THICKNESS. LAYERS SHALL BE SPREAD EVENLY AND SHALL BE THOROUGHLY BLADE MIXED DURING THE SPREADING TO ENSURE UNIFORMITY OF MATERIAL IN EACH LAYER. THE SCARIFIED SUBGRADE AND FILL MATERIAL SHALL BE MOISTURE CONDITIONED TO AT LEAST OPTIMUM MOISTURE. WHEN THE MOISTURE CONTENT OF THE FILL IS BELOW THAT SPECIFIED, WATER SHALL BE ADDED UNTIL THE MOISTURE DURING THE COMPACTION PROCESS. WHEN THE MOISTURE CONTENT OF THE FILL IS ABOVE THAT SPECIFIED, THE FILL MATERIAL SHALL BE AERATED BY BLADING OR OTHER SATISFACTORY METHODS UNTIL THE MOISTURE CONTENT IS AS SPECIFIED.

AFTER EACH LAYER HAS BEEN PLACED, MIXED, SPREAD EVENLY AND MOISTURE CONDITIONED, IT SHALL BE COMPACTED TO AT LEAST THE SPECIFIED DENSITY. THE FILL OPERATION SHALL BE CONTINUED IN COMPACTED LAYERS AS SPECIFIED ABOVE UNTIL THE FILL HAS BEEN BROUGHT TO THE FINISHED SLOPES AND GRADES AS SHOWN ON THE PLANS. NO LAYER

SHALL BE ALLOWED TO DRY OUT BEFORE SUBSEQUENT LAYERS ARE PLACED. COMPACTION EQUIPMENT SHALL BE OF SUCH DESIGN THAT IT WILL BE ABLE TO COMPACT THE FILL TO THE SPECIFIED MINIMUM COMPACTION WITHIN THE SPECIFIED MOISTURE CONTENT RANGE. COMPACTION OF EACH LAYER SHALL BE CONTINUOUS OVER ITS ENTIRE AREA UNTIL THE REQUIRED MINIMUM DENSITY HAS BEEN OBTAINED.

CUT OR FILL SLOPES

ALL CONSTRUCTED SLOPES, BOTH CUT AND FILL, SHALL BE NO STEEPER THAN 2 TO 1 (HORIZONTAL TO VERTICAL). DURING THE GRADING OPERATION, COMPACTED FILL SLOPES SHALL BE OVERFILLED BY AT LEAST ONE FOOT HORIZONTALLY AT THE COMPLETION OF THE GRADING OPERATIONS, THE EXCESS FILL EXISTING ON THE SLOPES SHALL BE BLADED OFF TO CREATE THE FINISHED SLOPE EMBANKMENT. ALL CUT AND FILL SLOPES SHALL BE TRACK WALKED AFTER BEING BROUGHT TO FINISH GRADE AND THEN BE PLANTED WITH EROSION CONTROL SLOPE PLANTING. THE SOILS ENGINEER SHALL REVIEW ALL CUT SLOPES TO DETERMINE IF ANY ADVERSE GEOLOGIC CONDITIONS ARE EXPOSED. IF SUCH CONDITIONS DO OCCUR, THE SOILS ENGINEER SHALL RECOMMEND THE APPROPRIATE MITIGATION MEASURES AT THE TIME OF THEIR DETECTION.

SEASONAL LIMITS AND DRAINAGE CONTROL FILL MATERIALS SHALL NOT BE PLACED, SPREAD OR COMPACTED WHILE IT IS AT AN UNSUITABLY HIGH MOISTURE CONTENT OR DURING OTHERWISE UNFAVORABLE CONDITIONS. WHEN THE WORK IS INTERRUPTED FOR ANY REASON THE FILL OPERATIONS SHALL NOT BE RESUMED UNTIL FIELD TEST PERFORMED BY THE SOILS ENGINEER INDICATE THAT THE MOISTURE CONDITIONS IN AREAS TO BE FILLED ARE AS PREVIOUSLY SPECIFIED. ALL EARTH MOVING AND WORKING OPERATIONS SHALL BE CONTROLLED TO PREVENT WATER FROM RUNNING INTO EXCAVATED AREAS. ALL EXCESS WATER SHALL BE PROMPTLY REMOVED AND THE SITE KEPT DRY.

10. DUST CONTROL THE CONTRACTOR SHALL TAKE ALL STEPS NECESSARY FOR THE ALLEVIATION OR PREVENTION OF ANY DUST NUISANCE ON OR ABOUT THE SITE CAUSED BY THE CONTRACTOR'S OPERATION EITHER DURING THE PERFORMANCE OF THE GRADING OR RESULTING FROM THE CONDITION IN WHICH THE CONTRACTOR LEAVES THE SITE. THE CONTRACTOR SHALL ASSUME ALL LIABILITY INCLUDING COURT COST OF CO-DEFENDANTS FOR ALL CLAIMS RELATED TO DUST OR WIND-BLOWN MATERIALS ATTRIBUTABLE TO HIS WORK. COST FOR THIS ITEM OF WORK IS TO BE INCLUDED IN THE EXCAVATION ITEM AND NO

ADDITIONAL COMPENSATION SHALL BE ALLOWED. 11. <u>INDEMNITY</u>

CONTRACTOR WILL HOLD HARMLESS, INDEMNIFY AND DEFEND THE ENGINEER, THE OWNER AND HIS CONSULTANTS AND EACH OF THEIR OFFICERS AND EMPLOYEES AND AGENTS, FROM ANY AND ALL LIABILITY CLAIMS, LOSSES OR DAMAGE ARISING OR ALLEGED TO HEREIN, BUT NOT INCLUDING THE SOLE NEGLIGENCE OF THE OWNER, THE ARCHITECT, THE ENGINEER AND HIS CONSULTANTS AND EACH OF THEIR OFFICERS AND EMPLOYEES AND AGENTS.

12. SAFETY IN ACCORDANCE WITH GENERALLY ACCEPTED CONSTRUCTION PRACTICES, THE CONTRACTOR WILL BE SOLELY AND COMPLETELY RESPONSIBLE FOR CONDITIONS OF THE JOB SITE, INCLUDING SAFETY OF ALL PERSONS AND PROPERTY DURING PERFORMANCE OF THE WORK. THIS REQUIREMENT WILL APPLY CONTINUOUSLY AND NOT BE LIMITED TO NORMAL WORKING HOURS. THE DUTY OF THE ENGINEERS TO CONDUCT CONSTRUCTION REVIEW OF THE CONTRACTOR'S

PERFORMANCE IS NOT INTENDED TO INCLUDE REVIEW OF THE ADEQUACY OF THE CONTRACTOR'S SAFETY MEASURES, IN, ON OR NEAR THE CONSTRUCTION SITE.

<u>GUARANTEE</u>

NEITHER THE FINAL PAYMENT, NOR THE PROVISIONS IN THE CONTRACT, NOR PARTIAL, NOR ENTIRE USE OR OCCUPANCY OF THE PREMISES BY THE OWNER SHALL CONSTITUTE AN ACCEPTANCE OF THE WORK NOT DONE IN ACCORDANCE WITH THE CONTRACT OR RELIEVES THE CONTRACTOR OF LIABILITY IN RESPECT TO ANY EXPRESS WARRANTIES OR RESPONSIBILITY FOR FAULTY MATERIAL OR WORKMANSHIP. THE CONTRACTOR SHALL REMEDY ANY DEFECTS IN WORK AND PAY FOR ANY DAMAGE TO OTHER WORK RESULTING THERE FROM WHICH SHALL APPEAR WITHIN A PERIOD OF ONE (1) CALENDAR YEAR FROM THE DATE OF FINAL ACCEPTANCE OF THE WORK. TRENCH BACKFILL

EITHER THE ON-SITE INORGANIC SOIL OR APPROVED IMPORTED SOIL MAY BE USED AS TRENCH BACKFILL. THE BACKFILL MATERIAL SHALL BE MOISTURE CONDITIONED PER THESE SPECIFICATIONS AND SHALL BE PLACED IN LIFTS OF NOT MORE THAN SIX INCHES IN HORIZONTAL UNCOMPACTED LAYERS AND BE COMPACTED BY MECHANICAL MEANS TO A MINIMUM OF 90% RELATIVE COMPACTION. IMPORTED SAND MAY BE USED FOR TRENCH BACKFILL MATERIAL PROVIDED IT IS COMPACTED TO AT LEAST 90% RELATIVE COMPACTION, WATER JETTING ASSOCIATED WITH COMPACTION USING VIBRATORY EQUIPMENT WILL BE PERMITTED ONLY WITH IMPORTED SAND BACKFILL WITH THE APPROVAL OF THE SOILS ENGINEER, ALL PIPES SHALL BE BEDDED WITH SAND EXTENDING FROM THE TRENCH BOTTOM TO TWELVE INCHES ABOVE THEPIPE. SAND BEDDING IS TO BE COMPACTED AS SPECIFIED ABOVE FOR SAND BACKFILL.

N. ALL GRADING. EROSION AND SEDIMENT CONTROL AND RELATED WORK UNDERTAKEN ON THIS SITE IS SUBJECT TO ALL TERMS AND CONDITIONS OF THE COUNTY GRADING ORDINANCE AND MADE A PART HEREOF BY REFERENCE.

B. THE CONTRACTOR WILL BE LIABLE FOR ANY AND ALL DAMAGES TO ANY PUBLICLY OWNED AND MAINTAINED ROAD CAUSED BY THE AFORESAID CONTRACTOR'S GRADING ACTIVITIES, AND SHALL BE RESPONSIBLE FOR THE CLEANUP OF ANY MATERIAL SPILLED ON ANY PUBLIC ROAD ON THE HAUL ROUTE. C. THE EROSION CONTROL MEASURES ARE TO BE OPERABLE DURING THE RAINY SEASON, GENERALLY FROM

OCTOBER FIRST TO APRIL FIFTEENTH, EROSION CONTROL PLANTING IS TO BE COMPLETED BY OCTOBER FIRST. NO GRADING OR UTILITY TRENCHING SHALL OCCUR BETWEEN OCTOBER FIRST AND APRIL FIFTEENTH UNLESS AUTHORIZED BY THE LOCAL JURISDICTION.

D. ALL EROSION CONTROL MEASURES SHALL BE MAINTAINED UNTIL DISTURBED AREAS ARE STABILIZED AND CHANGES TO THIS EROSION AND SEDIMENT CONTROL PLAN SHALL BE MADE TO MEET FIELD CONDITIONS ONLY WITH THE APPROVAL OF OR AT THE DIRECTION OF THE SOILS ENGINEER.

E. DURING THE RAINY SEASON, ALL PAVED AREAS SHALL BE KEPT CLEAR OF EARTH MATERIAL AND DEBRIS. THE SITE SHALL BE MAINTAINED SO AS TO MINIMIZE SEDIMENT-LADEN RUNOFF TO ANY STORM Drainage system.

F. ALL EROSION CONTROL FACILITIES MUST BE INSPECTED AND REPAIRED AT THE END OF EACH WORKING DAY DURING THE RAINY SEASON.

G. WHEN NO LONGER NECESSARY AND PRIOR TO FINAL ACCEPTANCE OF DEVELOPMENT, SEDIMENT BASINS

SHALL BE REMOVED OR OTHERWISE DEACTIVATED AS REQUIRED BY THE LOCAL JURISDICTION. H. A CONSTRUCTION ENTRANCE SHALL BE PROVIDED AT ANY POINT OF EGRESS FROM THE SITE TO ROADWAY. A CONSTRUCTION ENTRANCE SHOULD BE COMPOSED OF COARSE DRAIN ROCK (2" TO 3") MINIMUM DIAMETER) AT LEAST EIGHT INCHES THICK BY FIFTY (50) FEET LONG BY TWENTY (20) FEET WIDE UNLESS SHOWN OTHERWISE ON PLAN AND SHALL BE MAINTAINED UNTIL THE SITE IS PAVED.

I. ALL AREAS SPECIFIED FOR HYDROSEEDING SHALL BE NOZZLE PLANTED WITH STABILIZATION MATERIAL CONSISTING OF FIBER, SEED, FERTILIZER AND WATER, MIXED AND APPLIED IN THE FOLLOWING PROPORTIONS:

FIBER, 2000 LBS/ACRE SEED, 55 LBS/ACRE (SEE NOTE J, BELOW) FERTILIZER (7-2-1), 1,000 LBS/ACRE

WATER, AS REQUIRED FOR APPLICATION I. SEED MIX SHALL BE PER CALTRANS STANDARDS. K. WATER UTILIZED IN THE STABILIZATION MATERIAL SHALL BE OF SUCH QUALITY THAT IT WILL PROMOTE GERMINATION AND STIMULATE GROWTH OF PLANTS. IT SHALL BE FREE OF POLLUTANT MATERIALS AND

L. HYDROSEEDING SHALL CONFORM TO THE PROVISIONS OF SECTION 20, EROSION CONTROL AND HIGHWAY PLANTING", OF THE STANDARD SPECIFICATIONS OF THE STATE OF CALIFORNIA DEPARTMENT OF TRANSPORTATION, AS LAST REVISED.

M. A DISPERSING AGENT MAY BE ADDED TO THE HYDROSEEDING MATERIAL, PROVIDED THAT THE CONTRACTOR FURNISHES SUITABLE EVIDENCE THAT THE ADDITIVE WILL NOT ADVERSELY AFFECT THE PERFORMANCE OF THE SEEDING MIXTURE.

N. STABILIZATION MATERIALS SHALL BE APPLIED AS SOON AS PRACTICABLE AFTER COMPLETION OF GRADING OPERATIONS AND PRIOR TO THE ONSET OF WINTER RAINS, OR AT SUCH OTHER TIME AS DIRECTED BY THE COUNTY ENGINEER. THE MATERIAL SHALL BE APPLIED BEFORE INSTALLATION OF OTHER LANDSCAPING MATERIALS SUCH AS TREES, SHRUBS AND GROUND COVERS.

O. THE STABILIZATION MATERIAL SHALL BE APPLIED WITHIN 4—HOURS AFTER MIXING. MIXED MATERIAL NOT USED WITHIN 4-HOURS SHALL BE REMOVED FROM THE SITE.

P. THE CONTRACTOR SHALL MAINTAIN THE SOIL STABILIZATION MATERIAL AFTER PLACEMENT. THE COUNTY ENGINEER MAY REQUIRE SPRAY APPLICATION OF WATER OR OTHER MAINTENANCE ACTIVITIES TO ASSURE THE EFFECTIVENESS OF THE STABILIZATION PROCESS. APPLICATION OF WATER SHALL BE ACCOMPLISHED USING NOZZLES THAT PRODUCE A SPRAY THAT DOES NOT CONCENTRATE OR WASH AWAY THE STABILIZATION MATERIALS.

THE CONTRACTOR MUST MAINTAIN THE SITE CLEAN, SAFE AND IN USABLE CONDITION. ANY SPILLS OF SOIL ROCK OR CONSTRUCTION MATERIAL MUST BE REMOVED FROM THE SITE BY THE CONTRACTOR DURING CONSTRUCTION AND UPON COMPLETION OF THE PROJECT. COST FOR THIS ITEM OF WORK SHALL BE INCLUDED IN THE EXCAVATION AND COMPACTION ITEM AND NO ADDITIONAL COMPENSATION SHALL BE ALLOWED.

#### GENERAL UTILITY SYSTEM NOTES:

ALL TRENCHES SHALL BE BACKFILLED PER THE GEOTECHNICAL ENGINEER

RECCOMMENDATIONS. CLEAN OUTS, CATCH BASINS AND AREA DRAINS ARE TO BE ACCURATELY LOCATED BY THEIR RELATIONSHIP TO THE BUILDING, FLATWORK, ROOF DRAINS, AND/OR CURB LAYOUT, NOT BY THE LENGTH OF PIPE SPECIFIED IN THE DRAWNGS (WHICH IS APPROXIMATE).

CONTRACTOR SHALL STAKE LOCATION OF ABOVE GROUND UTILITY EQUIPMENT (BACKFLOW PREVENTOR, SATELLITE DISH, TRANSFORMER, GAS METER, ETC.) AND MEET WITH OWNER TO REVIEW LOCATION PRIOR TO INSTALLATION. PLANNING DEPARTMENT MUST SPECIFICALLY AGREE WITH LOCATION PRIOR TO PROCEEDING WITH THE INSTALLATION.

CONTRACTOR SHALL PREPARE AN ACCURATE COMPOSITE UTILITY PLAN THAT TAKES INTO ACCOUNT THE ACTUAL LOCATION OF EXISTING UTILITIES AS DETERMINED DURING THE DEMOLITION WORK. THE UTILITIES SHOWN ON THE CIVIL DRAWINGS, AND THE SITE POWER, CONDUITS AND LIGHTING SHOWN ON THE ELECTRICAL PLANS. THE FIRE SPRINKLER SYSTEM SHALL BE INCLUDED AS DESIGNED BY THE DESIGN/BUILD UNDERGROUND FIRE SPRINKLER CONTRACTOR.

COMPLETE SYSTEMS: ALL UTILITY SYSTEMS ARE DELINEATED IN A SCHEMATIC MANNER ON THESE PLANS. CONTRACTOR IS TO PROVIDE ALL FITTINGS, ACCESSORIES, AND WORK NECESSARY TO COMPLETE THE UTILITY SYSTEM SO THAT IT IS FULLY FUNCTIONING FOR

THE PURPOSE INTENDED. UNDERGROUND UTILITIES OR STRUCTURES ARE SHOWN IN THEIR APPROXIMATE LOCATIONS AND EXTENT BASED UPON RECORD INFORMATION. LOCATIONS MAY NOT HAVE BEEN VERIFIED IN THE FIELD AND NO GUARANTEE IS MADE ON THE ACCURACY COMPLETENESS FOR THE INFORMATION SHOWN. THE OWNER, BY ACCEPTING THESE PLANS OR PROCEEDING WITH IMPROVEMENTS PURSUANT THERETO, AGREES TO ASSUME LIABILITY AND TO HOLD THE UNDERSIGNED HARMLESS FOR ANY DAMAGES RESULTING FROM THE EXISTENCE OF UNDERGROUND UTILITIES OR STRUCTURES NOT REPORTED TO THE UNDERSIGNED: NOT INDICATED ON THE PUBLIC RECORDS EXAMINED, LOCATED AT VARIANCE WITH THOSE REPORTED OR SHOWN ON RECORDS EXAMINED.

THE CONTRACTOR SHALL BE RESPONSIBLE FOR PROTECTING ALL UTILITIES FROM DAMAGE DURING COMPACTION OF ROADWAY SUBGRADE AND PRIOR TO PLACEMENT OF FINAL PAVEMENT SECTIONS.

CONTRACTOR SHALL VERIFY ALL EXISTING INVERT ELEVATIONS FOR STORM DRAIN AND SANITARY SEWER CONSTRUCTION PRIOR TO COMMENCEMENT OF ANY WORK. ALL WORK FOR STORM AND SANITARY SEWER INSTALLATION SHALL BEGIN AT THE DOWNSTREAM CONNECTION POINT. THIS WILL ALLOW FOR ANY NECESSARY ADJUSTMENTS TO BE MADE PRIOR TO THE INSTALLATION OF THE ENTIRE LINE. IF THE CONTRACTOR FAILS TO BEGIN AT THE DOWNSTREAM CONNECTION POINT AND WORKS UP STREAM, HE SHALL PROCEED AT HIS OWN RISK AND BE RESPONSIBLE FOR ANY ADJUSTMENTS NECESSARY. CONTRACTOR SHALL VERIFY LOCATION OF SANITARY SEWER LATERAL WITH OWNER PRIOR TO CONSTRUCTION.

EXISTING UTILITY CROSSINGS OF THE NEW PIPELINE ARE SHOWN ACCORDING TO THE BEST AVAILABLE INFORMATION. GAS, WATER AND SEWER, SERVICE LATERALS ARE SHOWN ACCORDING TO THE BEST AVAILABLE INFORMATION. THE CONTRACTOR SHALL VERIFY THE TYPE, SIZE, LOCATION, AND DEPTH OF ALL EXISTING UTILITIES (BOTH MAINS AND LATERALS) ARE CORRECT AS SHOWN. NO GUARANTEE IS MADE THAT ALL EXISTING UTILITIES (BOTH MAINS AND LATERALS) ARE SHOWN. THE CONTRACTOR SHALL EXERCISE CAUTION WHEN EXCAVATING AND SHALL PROTECT ALL EXISTING UTILITIES (BOTH MAINS AND LATERALS) FROM DAMAGE DUE TO HIS OPERATION.

10. CONTRACTOR SHALL UNCOVER AND EXPOSE ALL EXISTING UTILITY AND SEWER LINES WHERE THEY ARE TO BE CROSSED ABOVE OR BELOW BY THE NEW FACILITY BEING CONSTRUCTED IN ORDER TO VERIFY THE GRADE AND TO ENSURE THAT THERE IS

SUFFICIENT CLEARANCE. VERTICAL SEPARATION REQUIREMENTS:

A MINIMUM OF SIX (6) INCHES VERTICAL CLEARANCE SHALL BE PROVIDED BETWEEN CROSSING UTILITY PIPES, EXCEPT THAT THE MINIMUM VERTICAL CLEARANCE BETWEEN WATER AND SANITARY SEWER PIPELINES SHALL BE 12 INCHES AND ALL NEW WATER PIPES SHALL BE TYPICALLY INSTALLED TO CROSS ABOVE/OVER EXISTING SANITARY SEWER PIPELINES.

WHERE NEW WATER PIPELINES ARE REQUIRED TO CROSS UNDER EXISTING AND/OR NEW SANITARY SEWER PIPELINES, THE MINIMUM VERTICAL SEPARATION SHALL BE 12 INCHES. WATER LINE PIPE ENDS SHALL BE INSTALLED NO CLOSER THEN 10' MINIMUM HORIZONTAL DISTANCE FROM CENTERLINE OF UTILITY CROSSINGS WHERE FEASIBLE.

HORIZONTAL SEPARATION REQUIREMENTS: A MINIMUM HORIZONTAL SEPARATION BETWEEN NEW PIPELINES AND ANY EXISTING UTILITIES SHALL BE 5' FEET EXCEPT THAT THE MINIMUM HORIZONTAL SEPARATION FOR WATER AND SANITARY SEWER PIPELINES SHALL BE 10' MINIMUM, UNLESS OTHERWISE NOTED. A MINIMUM HORIZONTAL SEPARATION BETWEEN NEW PIPELINES AND JOINT

TRENCH SHALL BE 5 FEET. 11. THE CONTRACTOR SHALL BE RESPONSIBLE FOR CONTACTING APPROPRIATE UTILITIES AND REQUESTING VERIFICATION OF SERVICE POINTS, FIELD VERIFICATION OF LOCATION. SIZE. DEPTH, ETC. FOR ALL THEIR FACILITIES AND TO COORDINATE WORK SCHEDULES.

#### STORM DRAIN NOTES:

ALL STORM DRAIN PIPE SHALL BE PVC SDR 35. PIPE SHALL BE SIZED AS SPECIFIED ON THE PLANS. ALL DIRECTION CHANGES SHALL BE MADE WITH A WYE CONNECTION OR LONG SWEEP ELBOWS, REGULAR ELBOWS, AND TEE'S SHOULD BE AVOIDED.

2. USE DETECTABLE METALIZED WARNING TAPE APPROXIMATE 6" BELOW THE SURFACE. TAPE SHALL BE A BRIGHT COLOR AND IMPRINTED WITH "CAUTION—STORM DRAIN LINE BELOW". CALPICO TYPE 2 OR EQUAL

PAINT THE TOP OF THE CURBS ADJACENT TO EACH CATCH BASIN INSTALLED UNDER THE WORK OR ADJACENT TO THIS SITE WITH THE WORDS "NO DUMPING! FLOWS TO BAY" PER COUNTY STANDARDS.

ALL AREA DRAINS AND CATCH BASINS GRATES WITHIN PEDESTRIAN ACCESSIBLE AREAS SHALL MEET ADA REQUIREMENTS.

ALL TRENCHES SHALL BE BACKFILLED PER THE SPECIFICATIONS WITH APPROPRIATE TEST BY THE GEOTECHNICAL ENGINEER TO VERIFY COMPACTION

6. FOR GRAVITY FLOW SYSTEMS CONTRACTOR SHALL VERIFY (POTHOLE IF NECESSARY) SIZE, MATERIAL, LOCATION AND DEPTH OF ALL SYSTEMS ARE TO BE CONNECTED TO OR CROSSED PRIOR TO TRENCHING OR INSTALLATION OF ANY GRAVITY FLOW SYSTEM.

COMPLETE SYSTEMS; ALL UTILITY SYSTEMS ARE DELINEATED IN SCHEMATIC MANNER ON THESE PLANS. CONTRACTOR IS TO PROVIDE ALL FITTINGS. ACCESSORIES, AND WORK NECESSARY TO COMPLETE THE UTILITY SYSTEM SO THAT IT IS FULLY FUNCTIONING FOR THE PURPOSE INTENDED.

PRIVATE STORM DRAIN LINE WITH A MINIMUM OF TWO (2) FEET OF COVER IN NON-TRAFFIC AREAS SHALL BE POLYVINAL CHLORIDE (PVC) SDR 35.

#### SANITARY SEWER NOTES:

INSTALL DETECTABLE METALIZED WARNING TAPE APPROXIMATELY 6"-12" BELOW THE SERVICE IN NON-PAVED AREAS. AND AT THE BOTTOM OF BASEROCK FOR PAVED AREAS. GREEN IMPRINTED WITH "CAUTION- SANITARY SEWER LINE BELOW, CALPICO TYPE 2 OR EQUAL.

ALL SEWER WORK SHALL BE IN CONFORMANCE WITH THE CITY/TOWN OR

APPROPRIATE SANITARY SEWER DISTRICT. PUBLIC AND PRIVATE SANITARY SEWER MAIN AND SERVICE LINE 4-INCH THROUGH

8-INCH SHALL BE POLYVINYL CHLORIDE (PVC) SDR 26 SEWER PIPE. WHERE CONNECTION IS TO BE MADE TO AN EXISTING SEWER OR STRUCTURE, SAID EXISTING SEWER OR STRUCTURE SHALL BE UNCOVERED AND CHECKED FOR LOCATION AND ELEVATION PRIOR TO STAKING NEW SEWER DEPTH AND LOCATION. ANY DISCREPANCY BETWEEN THE PLANS AND THE FIELD INFORMATION SHALL BE REPORTED IMMEDIATELY TO THE ENGINEER.

MINIMUM SLOPE FOR SITE SANITARY SEWER PIPES SHALL BE CURRENT UPC REQUIREMENTS:

4" - 2% 6" - 1%

8" & LARGER - 0.5%

6. ALL LATERALS SHALL HAVE A CLEANOUT AT THE FACE OF THE BUILDING AND AT THE PROPERTY LINE. AS SHOWN ON THE PLANS AND PER THE CITY/TOWN STANDARDS OR APPROPRIATE SANITARY SEWER DISTRICT.

#### WATER SYSTEM NOTES:

WHERE WATER LINES HAVE TO CROSS SANITARY SEWER LINES, DO SO AT A 90 DEGREE ANGLE AND WATER LINES SHALL BE MINIMUM OF 12" ABOVE THE TOP OF THE SANITARY SEWER LINES.

WATER LINES ARE SHOWN SCHEMATICALLY; CONTRACTOR SHALL IDENTIFY EACH ANGLE AND OR BEND THAT MAY BE REQUIRED TO ACCOMPLISH THE INTENDED

USE DETECTABLE METALIZED WARNING TAPE APPROXIMATELY 6" BELOW THE SURFACE, TAPE SHALL BE A BRIGHT COLOR AND IMPRINTED WITH "CAUTION-WATER

LINE BELOW", CALPICO TYPE 2 OR EQUAL. 4. ALL WATER SERVICE CONNECTIONS SHALL BE INSTALLED IN ACCORDANCE WITH THE CITY/COUNTY OR APPLICABLE WATER DISTRICT STANDARDS.

WATER MAIN AND WATER SERVICE LINE 2-INCH THROUGH 12-INCH SHALL BE POLYVINYL CHLORIDE (PVC) AND SHALL MEET AWWA C900, RATED FOR 200 PSI CLASS PIPE WITH EPOXY COATED DUCTILE IRON FITTINGS AND FUSION EPOXY COATED GATE VALVES. ALL JOINTS SHALL FACTORY MANUFACTURED WITH BEL AND SPIGOT ENDS AND RUBBER GASKETS. NONMETALLIC WATER LINES HAVE TRACER WIRE INSTALLED PER CITY/COUNTY STANDARDS.

CONNECTION TO THE EXISTING WATER MAIN SHALL BE APPROVED BY THE CITY/TOWN. THE DEVELOPER SHALL PAY THE ACTUAL COSTS OF CONSTRUCTION. THE CONTRACTOR SHALL PERFORM ALL EXCAVATION PREPARE THE SITE, FURNISH ALL MATERIALS, INSTALL TAPPING TEE VALVE AND ALL THRUST BLOCKS. BACKFILL, RESTORE THE SURFACE, AND CLEANUP. THE CITY WILL PROVIDE THE DEVELOPER WITH A LIST OF APPROVED CONTRACTORS FOR MAKING WET TAPS. NONMETALLIC WATER LINES SHALL HAVE TRACER WIRES INSTALLED.

ALL WATER LINES SHALL BE INSTALLED WITH 3' MINIMUM COVER.

ALL WATER VALVES SHALL BE PER CITY\WATER DISTRICT STANDARD. CONCRETE THRUST BLOCKS SHALL BE INSTALLED AT ALL TEES, CROSSES, BENDS (HORIZONTAL AND VERTICAL), AT SIZE CHANGES AND AT FIRE HYDRANTS PER CITY

STANDARD. AWWA C600. SECTION 3.8 UNLESS NOTED OTHERWISE. 10. ALL WATER VALVES SHALL BE CLUSTERED, UNLESS OTHERWISE DIRECTED BY THE CITY ENGINEER OR WATER DISTRICT.

11. THE CONTRACTOR SHALL BE RESPONSIBLE FOR COLLECTING AND DELIVERING WATER SAMPLES FOR ANALYSIS TO A CITY APPROVED LAB.

12. ALL LANDSCAPE IRRIGATION SYSTEMS SHALL BE IN ACCORDANCE WITH THE LANDSCAPE ARCHITECTURAL PLANS AND SPECIFICATIONS AND SHALL BE CONNECTED TO THE EXISTING AND/OR NEW WATER SYSTEM AND METERED ACCORDINGLY.

13. INSTALL CITY/COUNTY APPROVED PRESSURE REGULATOR AND REDUCED BACKFLOW PREVENT OR ON WATER LINE AT ENTRANCE TO BUILDING REFERENCE PLUMBING PLANS FOR MORE DETAIL.

#### STORMWATER POLLUTION PREVENTION NOTES

STORE, HANDLE, AND DISPOSE OF CONSTRUCTION MATERIALS AND WASTES PROPERLY, SO AS TO PREVENT THEIR

CONTACT WITH STORMWATER. CONTROL AND PREVENT THE DISCHARGE OF ALL POTENTIAL POLLUTANTS, INCLUDING SOLID WASTES, PAINTS, CONCRETE, PETROLEUM PRODUCTS, CHEMICALS, WASH WATER OR SEDIMENT, AND NON-STORMWATER DISCHARGES

TO STORM DRAINS AND WATER COURSES. USE SEDIMENT CONTROL OR FILTRATION TO REMOVE SEDIMENT FROM DEWATERING EFFLUENT.

AVOID CLEANING, FUELING, OR MAINTAINING VEHICLES ON SITE, EXCEPT IN A DESIGNATED AREA IN WHICH RUNOFF IS CONTAINED AND TREATED.

DELINEATE CLEARING LIMITS. EASEMENTS. SETBACKS, SENSITIVE OR CRITICAL AREAS, BUFFER ZONES, TREES AND DISCHARGE COURSE WITH FIELD MARKERS.

PROTECT ADJACENT PROPERTIES AND UNDISTURBED AREAS FROM CONSTRUCTION IMPACTS USING VEGETATIVE BUFFER STRIPS, SEDIMENT BARRIERS OF FILTERS, DIKES, MULCHING, OR OTHER MEASURES AS APPROPRIATE. PERFORM CLEARING AND EARTH MOVING ACTIVITIES DURING DRY WEATHER TO THE MAXIMUM EXTENT PRACTICAL.

LIMIT AND TIME APPLICATIONS OF PESTICIDES AND FERTILIZERS TO PREVENT POLLUTED RUNOFF. LIMIT CONSTRUCTION ACCESS ROUTES AND STABILIZE DESIGNATED ACCESS POINTS.

10. AVOID TRACKING DIRT OR MATERIALS OFF-SITE; CLEAN OFF-SITE PAVED AREAS AND SIDEWALKS USING DRY SWEEPING METHODS TO THE MAXIMUM EXTENT PRACTICAL.

#### SUPPLEMENTAL MEASURES

A. THE PHRASE "NO DUMPING - DRAINS TO BAY" OR EQUALLY EFFECTIVE PHRASE MUST BE LABELED ON STORM DRAIN INLETS (BY STENCILING, BRANDING, OR PLAQUES) TO ALERT THE PUBLIC TO THE DESTINATION OF STORM WATER AND TO PREVENT DIRECT DISCHARGE OF POLLUTANTS INTO THE STORM DRAIN.

USING FILTRATION MATERIALS ON STORM DRAIN COVERS TO REMOVE SEDIMENT FROM DEWATERING EFFLUENT. C. STABILIZING ALL DENUDED AREAS AND MAINTAINING EROSION CONTROL MEASURES CONTINUOUSLY FROM OCTOBER

REMOVING SPOILS PROMPTLY. AND AVOID STOCKPILING OF FILL MATERIALS. WHEN RAIN IS FORECAST. IF RAIN THREATENS, STOCKPILED SOILS AND OTHER MATERIALS SHALL BE COVERED WITH A TARP OR OTHER WATERPROOF

STORING. HANDLING. AND DISPOSING OF CONSTRUCTION MATERIALS AND WASTES SO AS TO AVOID THEIR ENTRY TO THE STORM DRAIN SYSTEMS OR WATER BODY.

AVOIDING CLEANING, FUELING, OR MAINTAINING VEHICLES ON—SITE, EXCEPT IN AN AREA DESIGNATED TO CONTAIN AND TREAT RUNOFF.

> THESE NOTES ARE INTENDED TO BE USED AS A GENERAL GUIDELINE. THE REFERENCED SOILS REPORT FOR THE PROJECT AND GOVERNING AGENCY GRADING ORDINANCE SHALL SUPERSEDE THESE NOTES. THE SOILS ENGINEER MAY MAKE ON-SITE RECOMMENDATIONS DURING GRADING OPERATIONS.



 $\infty$   $\infty$   $\overline{\phantom{a}}$ 

PLAN:
'REET
STREET

MPROVEME ES MAPLE 1580 MAPL

国

**ラギ**に

1 COUNTY COMMENTS MH

PC#2/ADD#6 09-23-16

REVISIONS

DESIGN BY: MH

DRAWN BY: WM

SHEET NO:

JOB NO:

DATE:

SCALE:


2151287

NTS

06-17-16

#### EROSION CONTROL NOTES:

- 1. IT SHALL BE THE OWNER'S/CONTRACTOR'S RESPONSIBILITY TO MAINTAIN CONTROL OF THE ENTIRE CONSTRUCTION OPERATION AND TO KEEP THE ENTIRE SITE IN COMPLIANCE WITH THIS EROSION CONTROL PLAN.
- 2. THE INTENTION OF THIS PLAN IS FOR INTERIM EROSION AND SEDIMENT CONTROL ONLY. ALL EROSION CONTROL MEASURES SHALL CONFORM TO CALIFORNIA REGIONAL WATER QUALITY CONTROL BOARD'S FIELD MANUAL FOR EROSION AND SEDIMENTATION CONTROL, THE CALIFORNIA STORM WATER QUALITY ASSOCIATION BEST MANAGEMENT PRACTICES HANDBOOK FOR CONSTRUCTION, AND THE LOCAL GOVERNING AGENCY FOR THIS
- OWNER/CONTRACTOR SHALL BE RESPONSIBLE FOR MONITORING EROSION AND SEDIMENT CONTROL MEASURES PRIOR TO, DURING, AND AFTER STORM EVENTS. PERSON IN CHARGE OF MAINTAINING EROSION CONTROL MEASURES SHOULD WATCH LOCAL WEATHER REPORTS AND ACT APPROPRIATELY TO MAKE SURE ALL NECESSARY MEASURES ARE IN
- 4. SANITARY FACILITIES SHALL BE MAINTAINED ON THE SITE AT ALL TIMES.
- 5. DURING THE RAINY SEASON, ALL PAVED AREAS SHALL BE KEPT CLEAR OF EARTH MATERIAL AND DEBRIS. THE SITE SHALL BE MAINTAINED SO AS TO MINIMIZE SEDIMENT-LADEN RUNOFF TO ANY STORM DRAINAGE SYSTEM, INCLUDING EXISTING DRAINAGE SWALES AND WATERCOURSES.
- 6. CONSTRUCTION OPERATIONS SHALL BE CARRIED OUT IN SUCH A MANNER THAT EROSION AND WATER POLLUTION WILL BE MINIMIZED. COMPLIANCE WITH FEDERAL, STATE AND LOCAL LAWS CONCERNING POLLUTION SHALL BE MAINTAINED AT ALL TIMES.
- CONTRACTOR SHALL PROVIDE DUST CONTROL AS REQUIRED BY THE APPROPRIATE FEDERAL, STATE AND LOCAL AGENCY REQUIREMENTS.
- 8. ALL MATERIALS NECESSARY FOR THE APPROVED EROSION CONTROL MEASURES SHALL BE IN PLACE BY OCTOBER 15TH.
- 9. EROSION CONTROL SYSTEMS SHALL BE INSTALLED AND MAINTAINED THROUGHOUT THE RAINY SEASON, OR FROM OCTOBER 15TH THROUGH APRIL 15TH, WHICHEVER IS LONGER.
- 10. IN THE EVENT OF RAIN, ALL GRADING WORK IS TO CEASE IMMEDIATELY AND THE SITE IS TO BE SEALED IN ACCORDANCE WITH THE APPROVAL EROSION CONTROL MEASURES AND APPROVED EROSION CONTROL PLAN.
- 11. THE CONTRACTOR SHALL BE RESPONSIBLE FOR CHECKING AND REPAIRING EROSION CONTROL SYSTEMS AFTER EACH STORM.
- 12. ADDITIONAL EROSION CONTROL MEASURES MAY BE REQUIRED BY LOCAL JURISDICTION'S ENGINEERING DEPARTMENT OR BUILDING OFFICIALS.
- 13. MEASURES SHALL BE TAKEN TO COLLECT OR CLEAN ANY ACCUMULATION OR DEPOSIT OF DIRT, MUD, SAND, ROCKS, GRAVEL OR DEBRIS ON THE SURFACE OF ANY STREET, ALLEY OR PUBLIC PLACE OR IN ANY PUBLIC STORM DRAIN SYSTEMS. THE REMOVAL OF AFORESAID SHALL BE DONE BY STREET SWEEPING OR HAND SWEEPING. WATER SHALL NOT BE USED TO WASH SEDIMENTS INTO PUBLIC OR PRIVATE DRAINAGE FACILITIES.
- 14. EROSION CONTROL MEASURES SHALL BE ON-SITE FROM SEPTEMBER 15TH THRU APRIL 15TH.
- 15. ALL EROSION CONTROL MEASURES SHALL BE INSTALLED AND MAINTAINED THROUGHOUT THE RAINY SEASON OR FROM OCTOBER 15 THRU APRIL 15, WHICHEVER IS GREATER.
- 16. PLANS SHALL BE DESIGNED TO MEET C3 REQUIREMENTS OF THE MUNICIPAL STORMWATER REGIONAL PERMIT("MRP") NPDES PERMIT CAS
- 17. THE CONTRACTOR TO NPDES (NATIONAL POLLUTION DISCHARGE ELIMINATION SYSTEM) BEST MANAGEMENT PRACTICES (BMP) FOR SEDIMENTATION PREVENTION AND EROSION CONTROL TO PREVENT DELETERIOUS MATERIALS OR POLLUTANTS FROM ENTERING THE TOWN OR COUNTY STORM DRAIN SYSTEMS.
- 18. THE CONTRACTOR MUST INSTALL ALL EROSION AND SEDIMENT CONTROL MEASURES PRIOR TO THE INCEPTION OF ANY WORK ONSITE AND MAINTAIN THE MEASURES UNTIL THE COMPLETION OF ALL LANDSCAPING.
- 19. THE CONTRACTOR SHALL MAINTAIN ADJACENT STREETS IN A NEAT, CLEAN DUST FREE AND SANITARY CONDITION AT ALL TIMES AND TO THE SATISFACTION OF THE TOWN INSPECTOR. THE ADJACENT STREET SHALL AT ALL TIMES BE KEPT CLEAN OF DEBRIS, WITH DUST AND OTHER NUISANCE BEING CONTROLLED AT ALL TIMES. THE CONTRACTOR BE RESPONSIBLE FOR ANY CLEAN UP ON ADJACENT STREETS AFFECTED BY THE BY THEIR CONSTRUCTION, METHOD OF STREET CLEANING SHALL BE BY DRY SWEEPING OF ALL PAVED AREAS. NO STOCKPILING OF BUILDING MATERIALS WITHIN THE TOWN RIGHT-OF-WAY.
- 20. SEDIMENTS AND OTHER MATERIALS SHALL NOT BE TRACKED FROM THE SITE BY VEHICLE TRAFFIC. THE CONTRACTOR SHALL INSTALL A STABILIZED CONSTRUCTION ENTRANCE PRIOR TO THE INSPECTION OF ANY WORK ONSITE AND MAINTAIN IT FOR THE DURATION OF THE CONSTRUCTION PROCESS SO AS TO NOT INHIBIT SEDIMENTS FROM BEING DEPOSITED INTO THE PUBLIC RIGHT-OF-WAY UNTIL THE COMPLETION OF ALL LANDSCAPING.
- 21. THE CONTRACTOR SHALL PROTECT DOWN SLOPE DRAINAGE COURSES, STREAMS AND STORM DRAINS WITH ROCK FILLED SAND BAGS, TEMPORARY SWALES, SILT FENCES, AND EARTH PERMS IN CONJUNCTION OF ALL LANDSCAPING.
- 22. STOCKPILED MATERIALS SHALL BE COVERED WITH VISQUEEN OR A TARPAULIN UNTIL THE MATERIAL IS REMOVED FROM THE SITE. ANY REMAINING BARE SOIL THAT EXISTS AFTER THE STOCKPILE HAS BEEN REMOVED SHALL BE COVERED UNTIL A NATURAL GROUND COVER IS ESTABLISHED OR IT IS SEEDED OR PLANTED TO PROVIDE GROUND COVER PRIOR TO THE FALL RAINY SEASON.
- 23. EXCESS OR WASTE CONCRETE MUST NOT BE WASHED INTO THE PUBLIC RIGHT-OF-WAYOR ANY OTHER DRAINAGE SYSTEM. PROVISIONS SHALL BE MADE TO RETAIN CONCRETE WASTES ON SITE UNTIL THEY CAN BE DISPOSED OF AS SOLID WASTE.
- 24. TRASH AND CONSTRUCTION RELATED SOLID WASTES MUST BE DEPOSITED INTO A COVERED RECEPTACLE TO PREVENT CONTAMINATION AND DISPERSAL BY WIND FUELS, OILS, SOLVENTS AND OTHER TOXIC MATERIALS MUST BE STORED IN ACCORDANCE WITH THEIR LISTING AND ARE NOT TO CONTAMINATE THE SOIL AND SURFACE WATERS. ALL APPROVED STORAGE CONTAINERS ARE TO BE PROTECTED FROM THE WEATHER. SPILLS MUST BE CLEANED UP IMMEDIATELY AND DISPOSED OF IN A PROPER MANNER. SPILLS MUST NOT BE WASHED INTO THE DRAINAGE SYSTEM,
- 25. DUST CONTROL SHALL BE DONE BY WATERING AND AS OFTEN AS REQUIRED BY THE TOWN INSPECTOR.
- 26. SILT FENCE(S) AND/OR FIBER ROLL(S) SHALL BE INSTALLED PRIOR TO SEPTEMBER 15TH AND SHALL REMAIN IN PLACE UNTIL THE LANDSCAPING GROUND COVER IS INSTALLED. CONTRACTOR SHALL CONTINUOUSLY MONITOR THESE MEASURES, FOLLOWING AND DURING ALL RAIN EVENTS, TO PUBLIC OWNED FACILITIES.

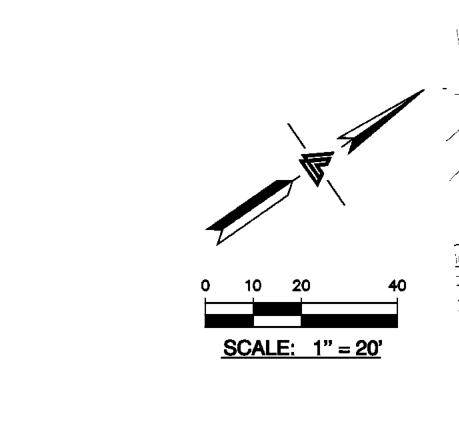

#### PURPOSE:


THE PURPOSE OF THIS PLAN IS TO STABILIZE THE SITE TO PREVENT EROSION OF GRADED AREAS AND TO PREVENT SEDIMENTATION FROM LEAVING THE CONSTRUCTION AREA AND AFFECTING NEIGHBORING SITES, NATURAL AREAS, PUBLIC FACILITIES OR ANY OTHER AREA THAT MIGHT BE AFFECTED BY SEDIMENTATION, ALL MEASURES SHOWN ON THIS PLAN SHOULD BE CONSIDERED THE MINIMUM REQUIREMENTS NECESSARY. SHOULD FIELD CONDITIONS DICTATE ADDITIONAL MEASURES, SUCH MEASURES SHALL BE PER CALIFORNIA REGIONAL WATER QUALITY CONTROL BOARD'S FIELD MANUAL FOR EROSION AND SEDIMENTATION CONTROL AND THE CALIFORNIA STORM WATER QUALITY ASSOCIATION BEST MANAGEMENT PRACTICES HANDBOOK FOR CONSTRUCTION. LEA & BRAZE ENGINEERING SHOULD BE NOTIFIED IMMEDIATELY SHOULD CONDITIONS CHANGE.

#### REFERENCES:

- CALIFORNIA REGIONAL WATER QUALITY CONTROL BOARD'S FIELD MANUAL FOR EROSION AND SEDIMENTATION CONTROL
- 2. CALIFORNIA STORM WATER QUALITY ASSOCIATION BEST MANAGEMENT PRACTICES HANDBOOK FOR CONSTRUCTION

#### **EROSION CONTROL MEASURES:**


- THE FACILITIES SHOWN ON THIS PLAN ARE DESIGNED TO CONTROL EROSION AND SEDIMENT DURING THE RAINY SEASON, OCTOBER 15TH TO APRIL 15. EROSION CONTROL FACILITIES SHALL BE IN PLACE PRIOR TO OCTOBER 15TH OF ANY YEAR. GRADING OPERATIONS DURING THE RAINY SEASON WHICH LEAVE DENUDED SLOPES SHALL BE PROTECTED WITH EROSION CONTROL MEASURES IMMEDIATELY FOLLOWING GRADING ON THE SLOPES.
- 2. SITE CONDITIONS AT TIME OF PLACEMENT OF EROSION CONTROL MEASURES WILL VARY, APPROPRIATE ACTION INCLUDING TEMPORARY SWALES, INLETS, HYDROSEEDING, STRAW BALES, ROCK SACKS, ETC. SHALL BE TAKEN TO PREVENT EROSION AND SEDIMENTATION FROM LEAVING SITE. EROSION CONTROL MEASURES SHALL BE ADJUSTED AS THE CONDITIONS CHANGE AND THE NEED OF CONSTRUCTION
- CONSTRUCTION ENTRANCES SHALL BE INSTALLED PRIOR TO COMMENCEMENT OF GRADING. ALL CONSTRUCTION TRAFFIC ENTERING ONTO THE PAVED ROADS MUST CROSS THE STABILIZED CONSTRUCTION ENTRANCES. CONTRACTOR SHALL MAINTAIN STABILIZED ENTRANCE AT EACH VEHICLE ACCESS POINT TO EXISTING PAVED STREETS. ANY MUD OR DEBRIS TRACKED ONTO PUBLIC STREETS SHALL BE REMOVED DAILY AND AS REQUIRED BY THE GOVERNING AGENCY.
- 4. ALL EXPOSED SLOPES THAT ARE NOT VEGETATED SHALL BE HYDROSEEDED. IF HYDROSEEDING IS NOT USED OR IS NOT EFFECTIVE BY OCTOBER 15, THEN OTHER IMMEDIATE METHODS SHALL BE IMPLEMENTED, SUCH AS EROSION CONTROL BLANKETS, OR A THREE-STEP APPLICATION OF 1) SEED, MULCH, FERTILIZER 2) BLOWN STRAW 3) TACKIFIER AND MULCH. HYDROSEEDING SHALL BE IN ACCORDANCE WITH THE PROVISIONS OF SECTION 20" EROSION CONTROL AND HIGHWAY PLANTING" OF THE STANDARD SPECIFICATION OF THE STATE OF CALIFORNIA DEPARTMENT OF TRANSPORTATION, AS LAST REVISED. REFER TO THE EROSION CONTROL SECTION OF THE GRADING SPECIFICATIONS THAT ARE A PART OF THIS PLAN SET FOR FURTHER INFORMATION.
- 5. INLET PROTECTION SHALL BE INSTALLED AT OPEN INLETS TO PREVENT SEDIMENT FROM ENTERING THE STORM DRAIN SYSTEM. INLETS NOT USED IN CONJUNCTION WITH EROSION CONTROL ARE TO BE BLOCKED TO PREVENT ENTRY OF SEDIMENT, MINIMUM INLET PROTECTION SHALL CONSIST OF A ROCK SACKS OR AS SHOWN ON THIS PLAN
- 6. THIS EROSION AND SEDIMENT CONTROL PLAN MAY NOT COVER ALL THE SITUATIONS THAT MAY ARISE DURING CONSTRUCTION DUE TO UNANTICIPATED FIELD CONDITIONS. VARIATIONS AND ADDITIONS MAY BE MADE TO THIS PLAN IN THE FIELD. A REPRESENTATIVE OF LEA & BRAZE ENGINEERING SHALL PERFORM A FIELD REVIEW AND MAKE RECOMMENDATIONS AS NEEDED. CONTRACTOR IS RESPONSIBLE TO NOTIFY LEA & BRAZE ENGINEERING AND THE GOVERNING AGENCY OF ANY CHANGES.
- 7. THE EROSION CONTROL MEASURES SHALL CONFORM TO THE LOCAL JURISDICTION'S STANDARDS AND THE APPROVAL OF THE LOCAL JURISDICTION'S ENGINEERING DEPARTMENT.
- 8. STRAW ROLLS SHALL BE PLACED AT THE TOE OF SLOPES AND ALONG THE DOWN SLOPE PERIMETER OF THE PROJECT. THEY SHALL BE PLACED AT 25 FOOT INTERVALS ON GRADED SLOPES. PLACEMENT SHALL RUN WITH THE CONTOURS AND ROLLS SHALL BE TIGHTLY END BUTTED. CONTRACTOR SHALL REFER TO MANUFACTURES SPECIFICATIONS FOR PLACEMENT AND INSTALLATION INSTRUCTIONS.

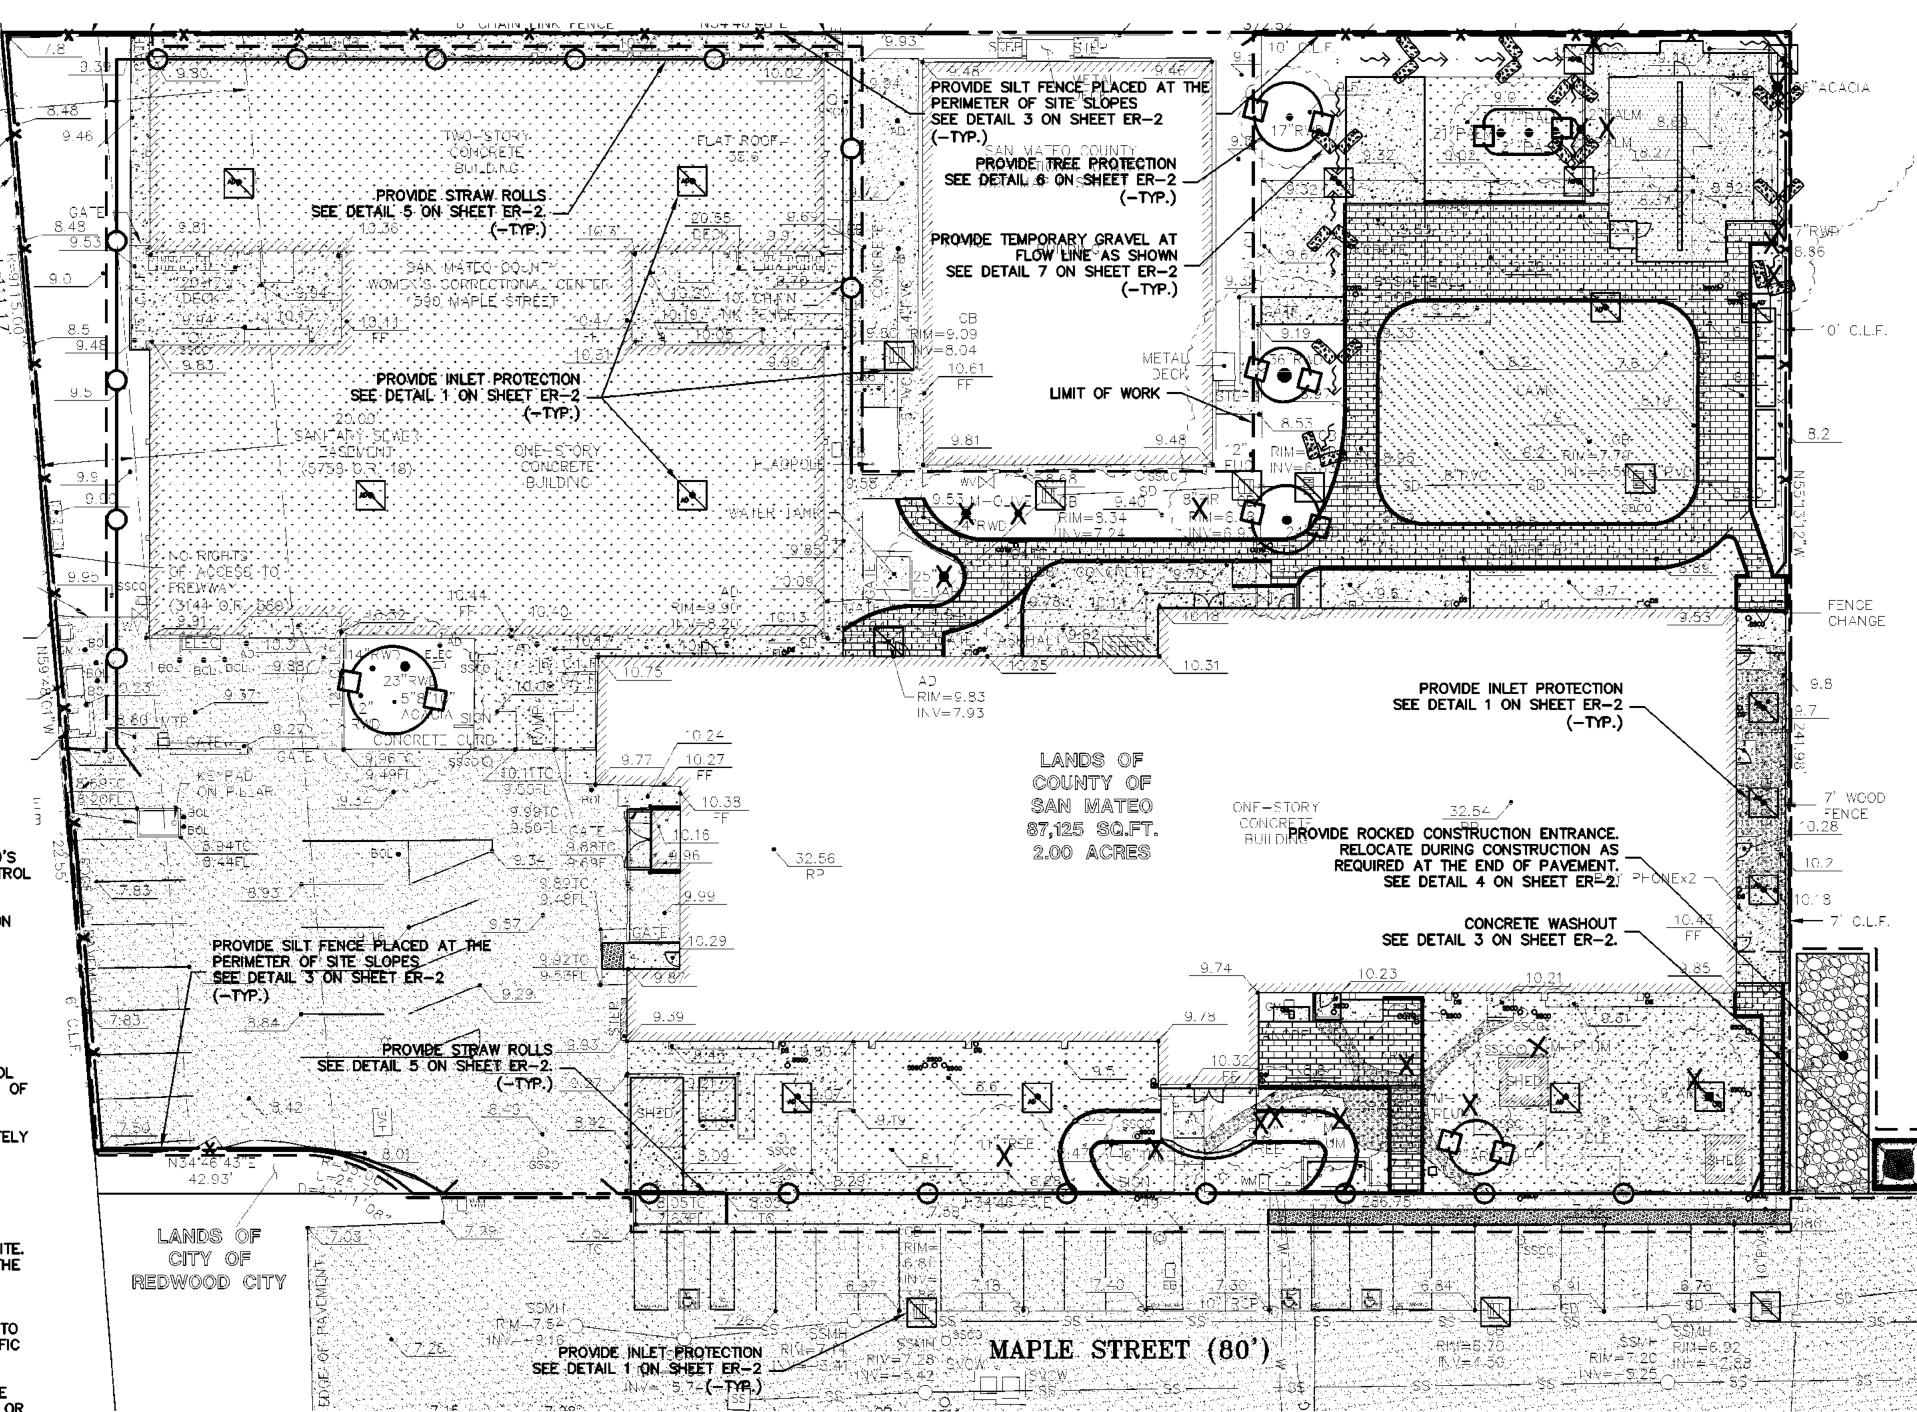


#### PERIODIC MAINTENANCE:

- 1. MAINTENANCE IS TO BE PERFORMED AS FOLLOWS:
- A. DAMAGES CAUSED BY SOIL EROSION OR CONSTRUCTION SHALL BE REPAIRED AT THE END OF EACH WORKING DAY.
- B. SWALES SHALL BE INSPECTED PERIODICALLY AND MAINTAINED AS NEEDED.
- C. SEDIMENT TRAPS, BERMS, AND SWALES ARE TO BE INSPECTED AFTER EACH STORM AND REPAIRS MADE AS NEEDED.
- D. SEDIMENT SHALL BE REMOVED AND SEDIMENT TRAP RESTORED TO ITS ORIGINAL DIMENSIONS WHEN SEDIMENT HAS ACCUMULATED TO A DEPTH OF 1' FOOT.
- E. SEDIMENT REMOVED FROM TRAP SHALL BE DEPOSITED IN A SUITABLE AREA AND IN SUCH A MANNER THAT IT WILL NOT
- F. RILLS AND GULLIES MUST BE REPAIRED.
- 2. GRAVEL BAG INLET PROTECTION SHALL BE CLEANED OUT WHENEVER SEDIMENT DEPTH IS ONE HALF THE HEIGHT OF ONE GRAVEL BAG.
- 3. STRAW ROLLS SHALL BE PERIODICALLY CHECKED TO ASSURE PROPER FUNCTION AND CLEANED OUT WHENEVER THE SEDIMENT DEPTH REACHED HALF THE HEIGHT OF THE ROLL.
- 4. SILT FENCE SHALL BE PERIODICALLY CHECKED TO ASSURE PROPER FUNCTION AND CLEANED OUT WHENEVER THE SEDIMENT DEPTH REACHES ONE FOOT IN HEIGHT.
- 5. CONSTRUCTION ENTRANCE SHALL BE REGRAVELED AS NECESSARY FOLLOWING SILT/SOIL BUILDUP.
- 6. ANY OTHER EROSION CONTROL MEASURES SHOULD BE CHECKED AT REGULAR INTERVALS TO ASSURE PROPER FUNCTION

## EROSION CONTROL LEGEND

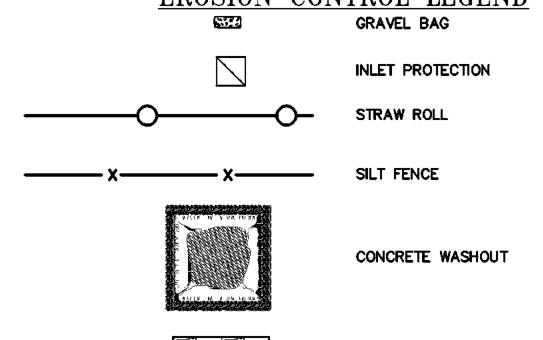

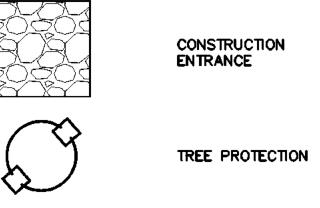

LIMITS OF WORK

SEAL ALL OTHER INLETS NOT INTENDED TO ACCEPT STORM WATER AND DIRECT FLOWS TEMPORARILY TO FUNCTIONAL SEDIMENTATION BASIN INLETS. -TYP

JOB NO: DATE:

13 OF 19 SHEETS

DESIGN BY: MH

DRAWN BY: WM

 $\mathbf{O}$ 

 $\alpha$ 

COUNTY COMMENTS MH

PC#2/ADD#6 09-23-16

REVISIONS

SCALE:

SHEET NO:

2151287

06-17-16

AS NOTED

1 COUNTY COMMENTS PC#2/ADD#6 09-23-16 REVISIONS


JOB NO: 2151287 DATE: 06-17-16 NTS SCALE: DESIGN BY: MH

SHEET NO: **ER-2** 

14 OF 19 SHEETS

DRAWN BY: WM

10' MIN. 1. SET POSTS AND EXCAVATE 2. STAPLE WIRE FENCE TO THE A 4"X4" TRENCH UP SLOPE ALONG THE LINE OF POSTS. POSTS. NOTES: PUBLIC **EXISTING** STABILIZED CONSTRUCTION SITE RIGHT-OF-WAY GROUND ACCESS SHALL BE CONSTRUCTED 50' MIN. OF 3" TO 4" WASHED, FRACTURED STONE AGGREGATE. MATERIAL SHALL BE PLACED TO A MINIMUM THICKNESS OF 12". LENGTH OF ENTRANCE SHALL BE A STAPLE DETAIL **SECTION** 12" MIN. PROVIDE MINIMUM OF 50'. APPROPRIATE TRANSITION STRAW BALES GEOTEXTILE LINER BENEATH— -BETWEEN STABILIZED ATTACH THE FILTER FABRIC TO THE WIRE FENCE AND EXTEND IT INTO THE WIDTH SHALL BE A MIN. OF 15' OR GREATER IF NECESSARY TO COVER 10 MIL\_\_ PLASTIC LINING 4. BACKFILL AND COMPACT THE (ABOVE GRADE) -TYP CONSTRUCTION ENTRANCE EXCAVATED SOIL. AGGREGATE AND PUBLIC RIGHT-OF-WAY ALL VEHICULAR INGRESS AND PLAN VIEW EGRESS. PROVIDE AMPLE TURNING RADII. PLYWOOD -48"x24" PAINTED WHITE STRAW ROLL 50' MIN. THE ENTRANCE SHALL BE KEPT IN GOOD CONDITION BY OCCASIONAL TOP DRESSING WITH MATERIAL AS BUTTED UP STAPLES - AGAINST \_PLASTIC LINING -LETTERS -MATERIAL CONSTRUCTION (2 PER BALE) (OPTIONAL) 6" HEIGHT SPECIFIED IN ABOVE NOTE. ENTRANCE ACCESSES SHALL BE INSPECTED WEEKLY DURING PERIODS OF HEAVY SCREWS 4" TO 6" -ANGULAR USAGE, MONTHLY DURING NORMAL WOOD POST EXTENSION OF FABRIC AND WIRE INTO THE TRENCH. RIP-RAP EXISTING GROUND USAGE, AND AFTER EACH 3"X3"X8' STRAW RAINFALL, WITH MAINTENANCE WOOD OR \_PUBLIC RIGHT-OF-WAY PROVIDED AS NECESSARY. -METAL STAKE (2 PER BALE) CONCRETE WASHOUT PERIODIC TOP DRESSING SHALL BE SIGN DETAIL DONE AS NEEDED. SECTION PROVIDE DEPRESSION
\_TO DIRECT RUN OFF
AWAY FROM PUBLIC NOTE: IT IS ESSENTIAL THAT THE NOTES: ACTUAL LAYOUT DETERMINED WIRE/FABRIC BE FULLY EMBEDDED INTO THE GROUND RIGHT-OF-WAY SO RUN-OFF CANNOT FLOW FREELY UNDER FENCE. SILT FENCE CONCRETE WASHOUT CONSTRUCTION ENTRANCE THE CONCRETE WASHOUT SIGN SHALL BE INSTALLED WITHIN ER-2 ER-2 10' OF THE TEMPORARY CONCRETE WASHOUT FACILITY.

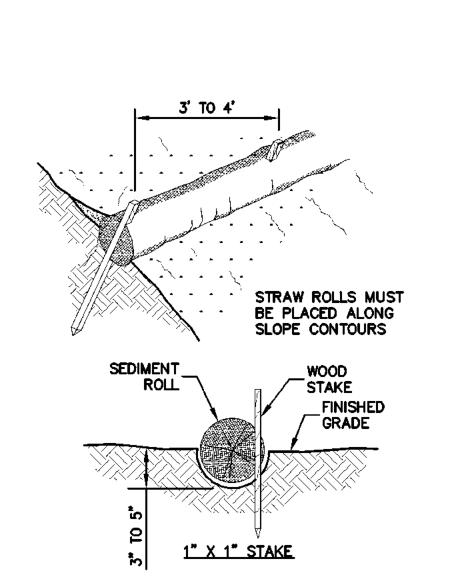

6" COBBLE\_ STONE MIN

FILTER FABRIC\_ TO COVER INLET


INLET PROTECTION

—(E) GRADE


NOTE:

1. STRAW ROLL INSTALLATION REQUIRES THE PLACEMENT AND SECURE STAKING OF THE ROLL IN A TRENCH, 3" TO 5" DEEP, DUG ON CONTOUR. RUNOFF MUST NOT BE ALLOWED TO RUN UNDER OR AROUND ROLL. CONTRACTOR IS RESPONSIBLE FOR REGULAR MAINTENANCE AND INSPECTION. THE SILT SHALL BE CLEANED OUT WHEN IT REACHES HALF THE HEIGHT OF THE ROLL.

STRAW ROLLS FLAT LOT **ER**−2

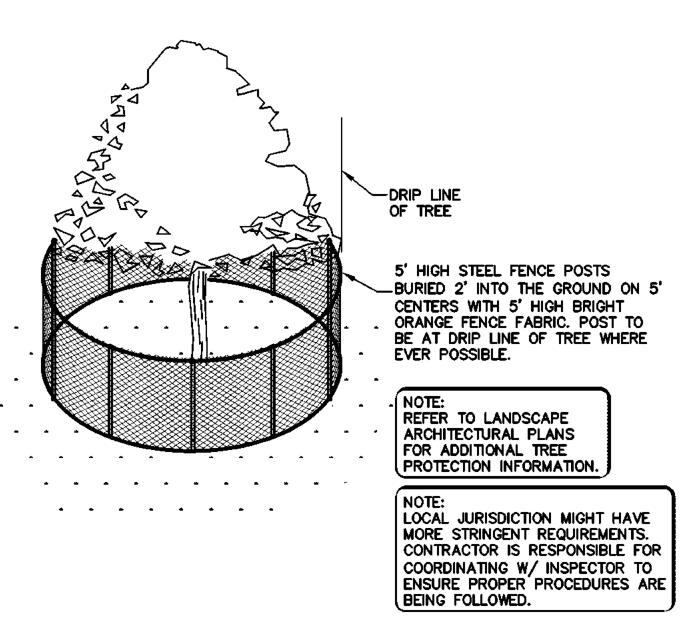

EXISTING TREE PROTECTION DETAIL

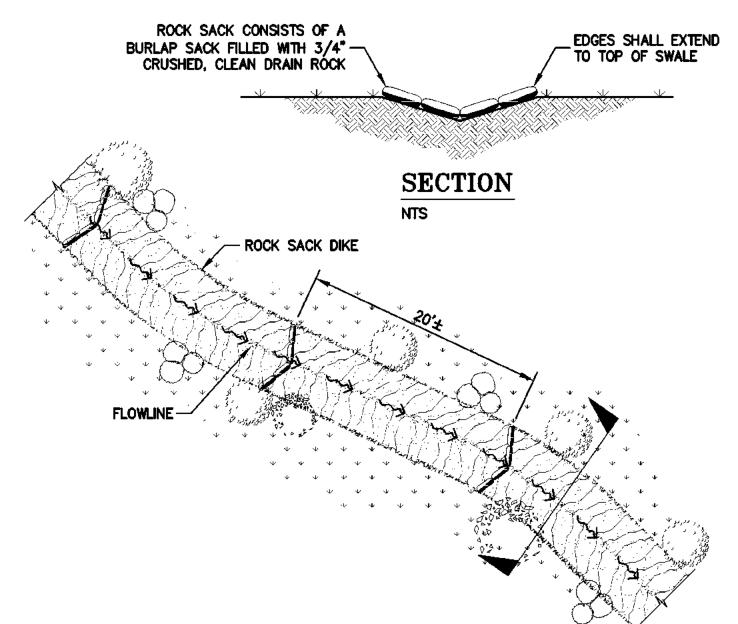


ROCK SACK DIKE IN SWALE

# Construction Best Management Practices (BMPs)

Construction projects are required to implement the stormwater best management practices (BMP) on this page, as they apply to your project, all year long.

Clean Water. Healthy Community.

#### Materials & Waste Management

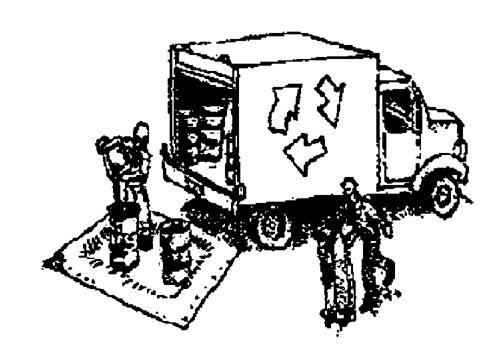

#### Non-Hazardous Materials

- ☐ Berm and cover stockpiles of sand, dirt or other construction material with tarps when rain is forecast or if not actively being used within 14 days.
- ☐ Use (but don't overuse) reclaimed water for dust control.

#### **Hazardous Materials**

- ☐ Label all hazardous materials and hazardous wastes (such as pesticides, paints, thinners, solvents, fuel, oil, and antifreeze) in accordance with city, county, state and federal regulations.
- ☐ Store hazardous materials and wastes in water tight containers, store in appropriate secondary containment, and cover them at the end of every work day or during wet weather or when rain is forecast.
- ☐ Follow manufacturer's application instructions for hazardous materials and be careful not to use more than necessary. Do not apply chemicals outdoors when rain is forecast within 24 hours.
- ☐ Arrange for appropriate disposal of all hazardous wastes.


#### Waste Management

- □ Cover waste disposal containers securely with tarps at the end of every work day and during wet weather.
- ☐ Check waste disposal containers frequently for leaks and to make sure they are not overfilled. Never hose down a dumpster on the construction site.
- ☐ Clean or replace portable toilets, and inspect them frequently for leaks and spills.
- ☐ Dispose of all wastes and debris properly. Recycle materials and wastes that can be recycled (such as asphalt, concrete, aggregate base materials, wood, gyp board, pipe, etc.)
- ☐ Dispose of liquid residues from paints, thinners, solvents, glues, and cleaning fluids as hazardous waste.

#### **Construction Entrances and Perimeter**

- ☐ Establish and maintain effective perimeter controls and stabilize all construction entrances and exits to sufficiently control erosion and sediment discharges from site and tracking off site.
- □ Sweep or vacuum any street tracking immediately and secure sediment source to prevent further tracking. Never hose down streets to clean up tracking.

## **Equipment Management & Spill Control**

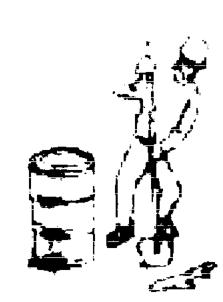


#### Maintenance and Parking

- Designate an area, fitted with appropriate BMPs, for vehicle and equipment parking and storage.
- Perform major maintenance, repair jobs, and vehicle and equipment washing off site.
- ☐ If refueling or vehicle maintenance must be done onsite, work in a bermed area away from storm drains and over a drip pan or drop cloths big enough to collect fluids. Recycle or dispose of fluids as hazardous waste.
- ☐ If vehicle or equipment cleaning must be done onsite, clean with water only in a bermed area that will not allow rinse water to run into gutters, streets, storm drains, or surface waters.
- ☐ Do not clean vehicle or equipment onsite using soaps, solvents, degreasers, or steam cleaning equipment.

#### Spill Prevention and Control

- ☐ Keep spill cleanup materials (e.g., rags, absorbents and cat litter) available at the construction site at all times.
- ☐ Inspect vehicles and equipment frequently for and repair leaks promptly. Use drip pans to catch leaks until repairs are made.
- ☐ Clean up spills or leaks immediately and dispose of cleanup materials properly.
- Do not hose down surfaces where fluids have spilled. Use dry cleanup methods (absorbent materials, cat litter, and/or rags).
- Sweep up spilled dry materials immediately. Do not try to wash them away with water, or bury them.
- Clean up spills on dirt areas by digging up and properly disposing of contaminated soil.
- Report significant spills immediately. You are required by law to report all significant releases of hazardous materials, including oil. To report a spill: 1) Dial 911 or your local emergency response number. 2) Call the Governor's Office of Emergency Services Warning Center, (800) 852-7550 (24 hours).

### **Earthmoving**

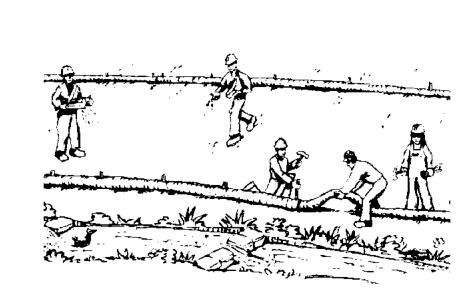


- ☐ Schedule grading and excavation work during dry weather.
- ☐ Stabilize all denuded areas, install and maintain temporary erosion controls (such as erosion control fabric or bonded fiber matrix) until vegetation is established.
- ☐ Remove existing vegetation only when absolutely necessary, and seed or plant vegetation for erosion control on slopes or where construction is not immediately planned
- Prevent sediment from migrating offsite and protect storm drain inlets, gutters, ditches, and drainage courses by installing and maintaining appropriate BMPs, such as fiber rolls, silt fences, sediment basins, gravel bags, berms, etc.
- ☐ Keep excavated soil on site and transfer it to dump trucks on site, not in the streets.

#### Contaminated Soils

- ☐ If any of the following conditions are observed, test for contamination and contact the Regional Water Quality Control Board:
- Unusual soil conditions, discoloration or odor.
- Abandoned underground tanks.
- Abandoned wells
- Buried barrels, debris, or trash.

### Paving/Asphalt Work

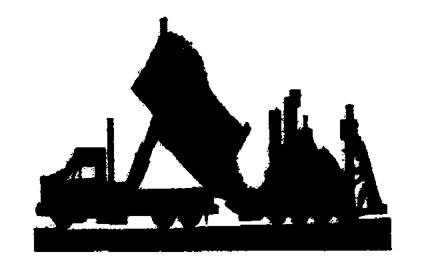


- Avoid paving and seal coating in wet weather or when rain is forecast, to prevent materials that have not cured from contacting stormwater runoff.
- ☐ Cover storm drain inlets and manholes when applying seal coat, tack coat, slurry seal, fog seal, etc.
- ☐ Collect and recycle or appropriately dispose of excess abrasive gravel or sand. Do NOT sweep or wash it into gutters.
- ☐ Do not use water to wash down fresh asphalt concrete pavement.

#### Sawcutting & Asphalt/Concrete Removal


- ☐ Protect nearby storm drain inlets when saw cutting. Use filter fabric, catch basin inlet filters, or gravel bags to keep slurry out of the storm drain system.
- ☐ Shovel, abosorb, or vacuum saw-cut slurry and dispose of all waste as soon as you are finished in one location or at the end of each work day (whichever is sooner!).
- ☐ If sawcut slurry enters a catch basin, clean it up immediately.

# Concrete, Grout & Mortar Application

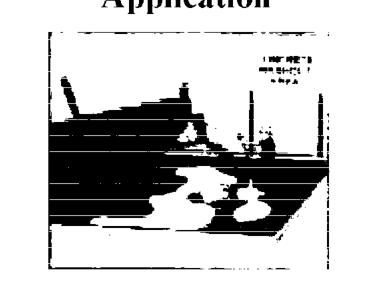


- Store concrete, grout, and mortar away from storm drains or waterways, and on pallets under cover to protect them from rain, runoff, and wind.
- ☐ Wash out concrete equipment/trucks offsite or in a designated washout area, where the water will flow into a temporary waste pit, and in a manner that will prevent leaching into the underlying soil or onto surrounding areas. Let concrete harden and dispose of as garbage.
- ☐ When washing exposed aggregate, prevent washwater from entering storm drains. Block any inlets and vacuum gutters, hose washwater onto dirt areas, or drain onto a bermed surface to be pumped and disposed of properly.

## Landscaping

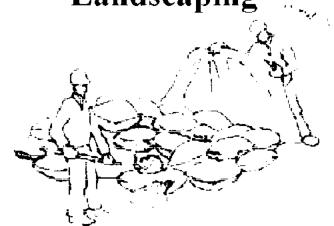

- ☐ Protect stockpiled landscaping materials from wind and rain by storing them under tarps all year-round.
- ☐ Stack bagged material on pallets and under cover.
- ☐ Discontinue application of any crodible landscape material within 2 days before a forecast rain event or during wet weather.

#### Painting & Paint Removal

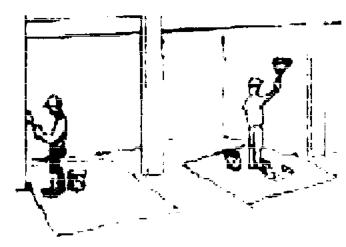


#### Painting Cleanup and Removal

- ☐ Never clean brushes or rinse paint containers into a street, gutter, storm drain, or stream.
- ☐ For water-based paints, paint out brushes to the extent possible, and rinse into a drain that goes to the sanitary sewer.

  Never pour paint down a storm drain.
- ☐ For oil-based paints, paint out brushes to the extent possible and clean with thinner or solvent in a proper container. Filter and reuse thinners and solvents. Dispose of excess liquids as hazardous waste.
- ☐ Paint chips and dust from non-hazardous dry stripping and sand blasting may be swept up or collected in plastic drop cloths and disposed of as trash.
- ☐ Chemical paint stripping residue and chips and dust from marine paints or paints containing lead, mercury, or tributyltin must be disposed of as hazardous waste.

  Lead based paint removal requires a state-certified contractor.


## **Dewatering**

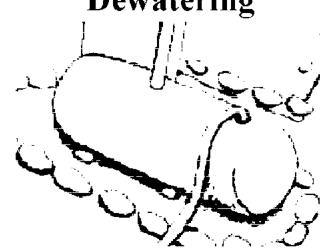


- Discharges of groundwater or captured runoff from dewatering operations must be properly managed and disposed. When possible send dewatering discharge to landscaped area or sanitary sewer. If discharging to the sanitary sewer call your local wastewater treatment plant.
- ☐ Divert run-on water from offsite away from all disturbed areas.
- When dewatering, notify and obtain approval from the local municipality before discharging water to a street gutter or storm drain. Filtration or diversion through a basin, tank, or sediment trap may be required.
- ☐ In areas of known or suspected contamination, call your local agency to determine whether the ground water must be tested. Pumped groundwater may need to be collected and hauled off-site for treatment and proper disposal.

Storm drain polluters may be liable for fines of up to \$10,000 per day!

STORM WATER
PREVENTION POLLUTION
PLAN

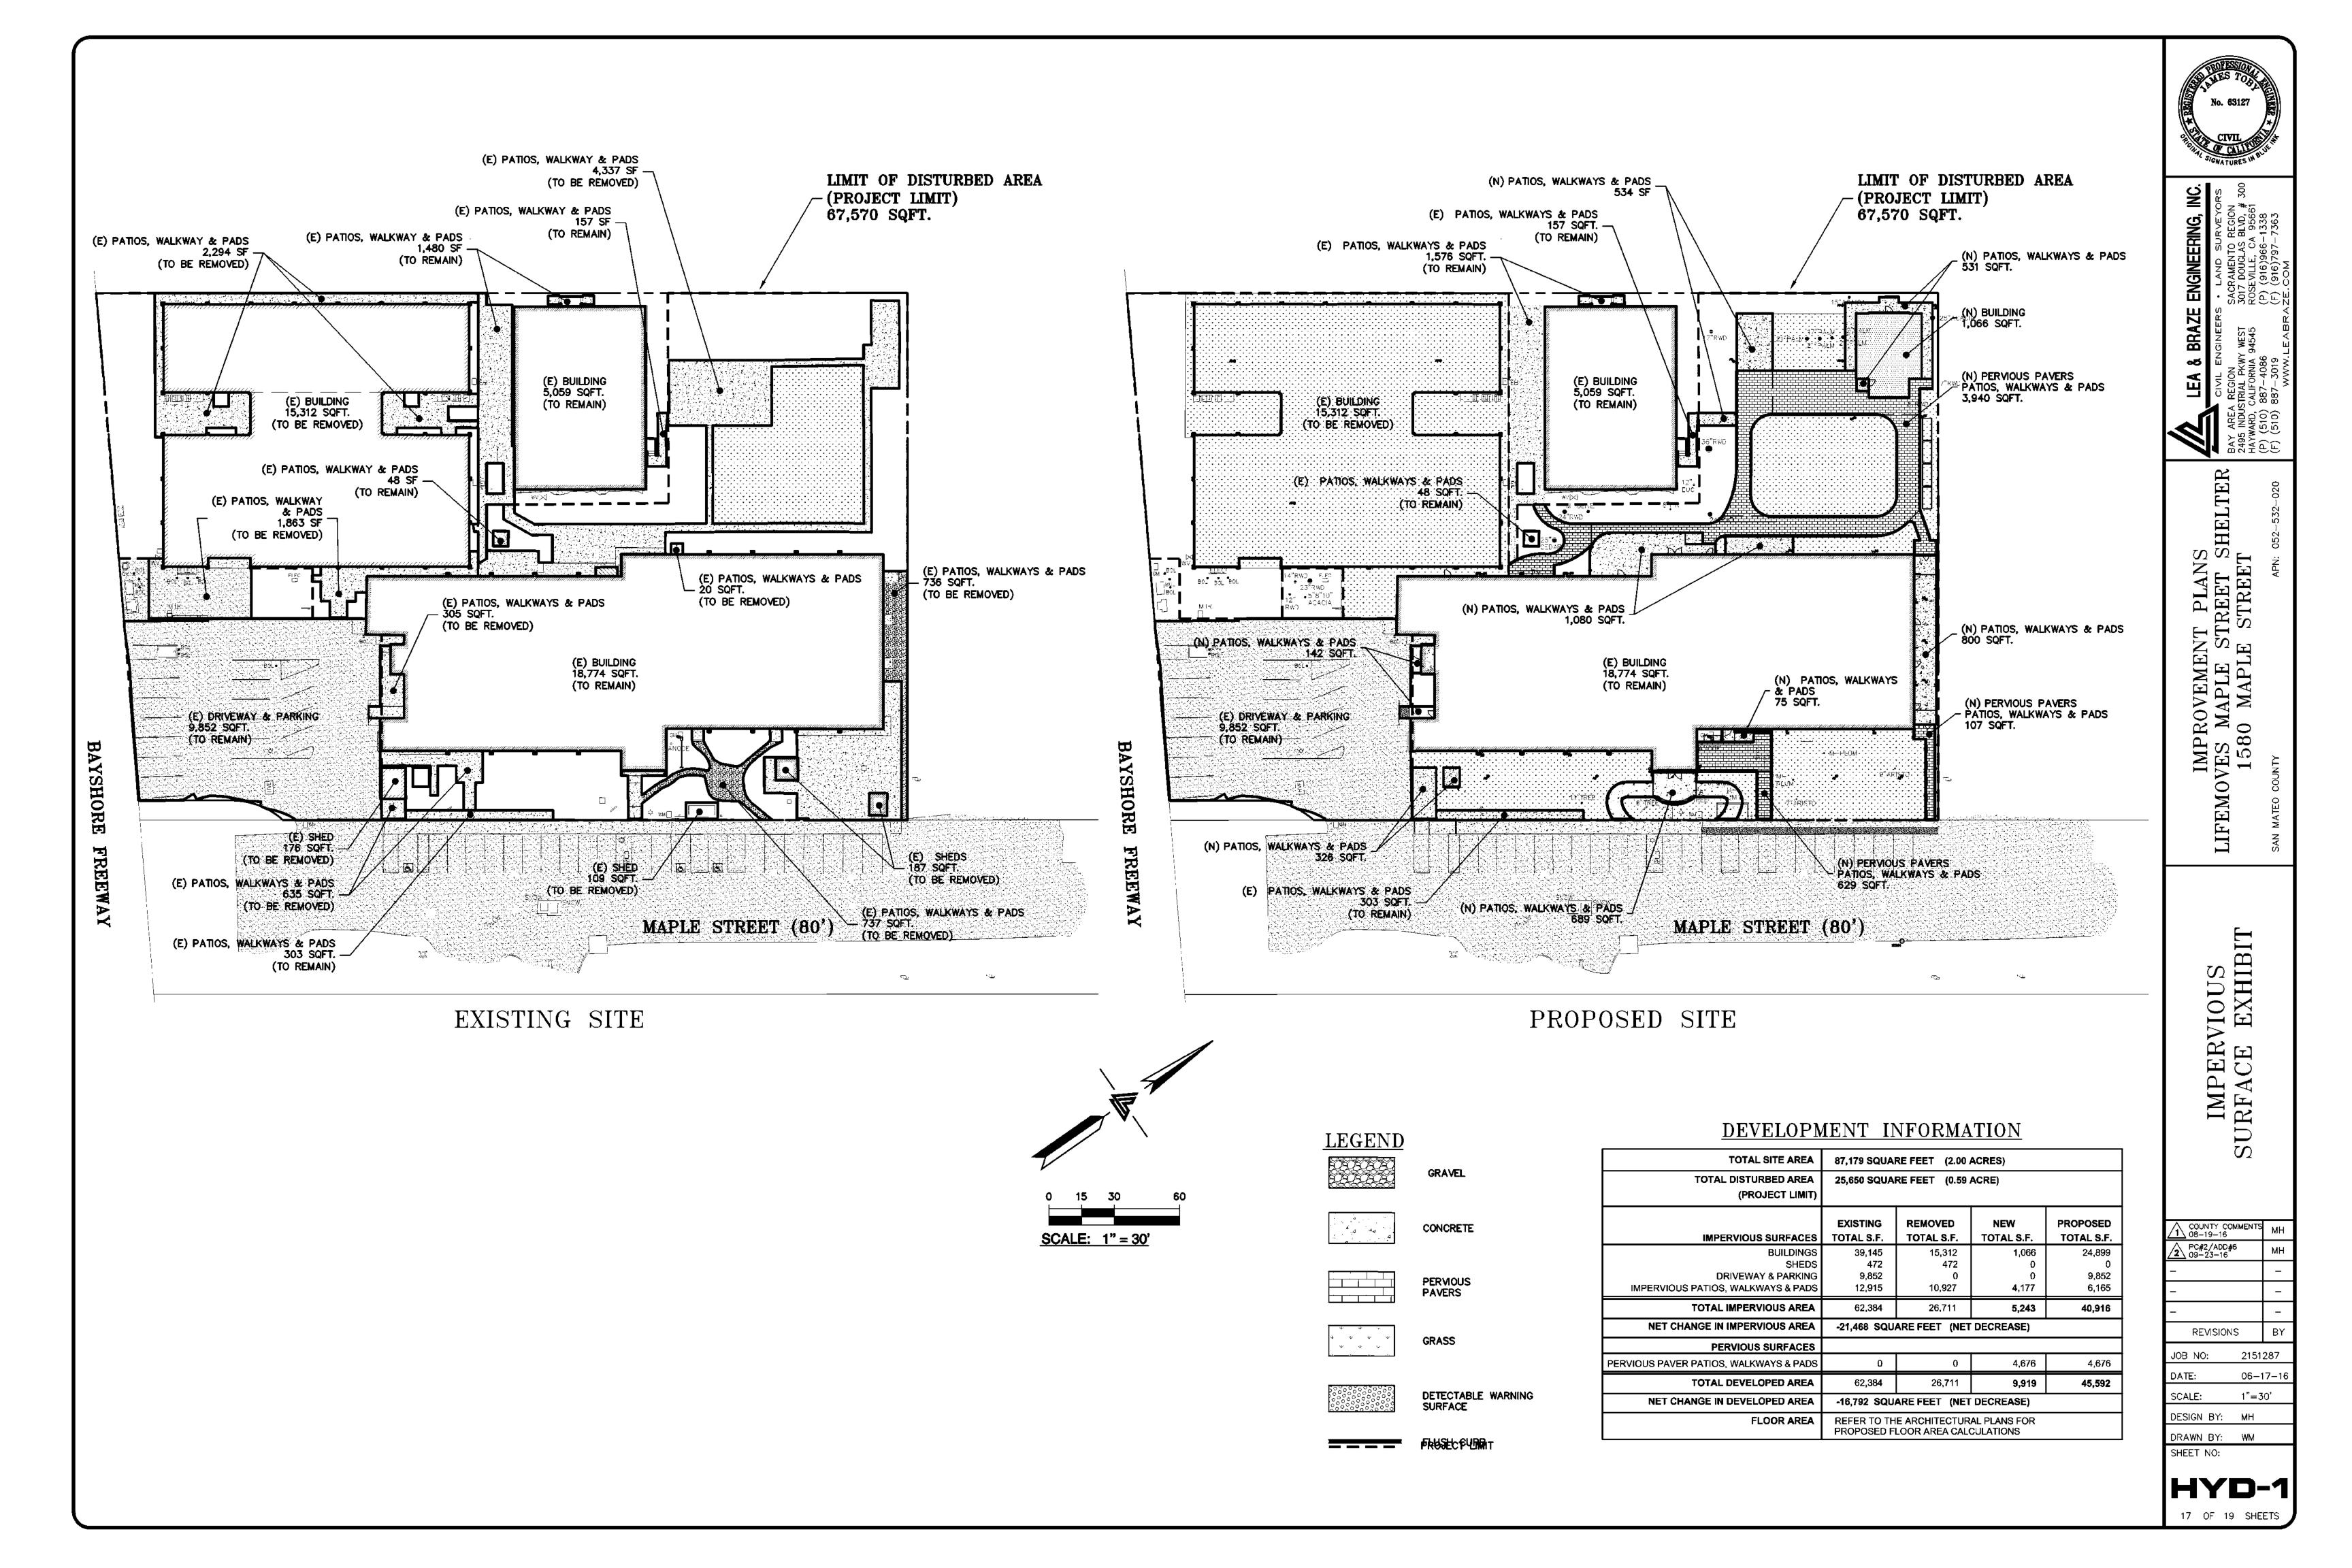

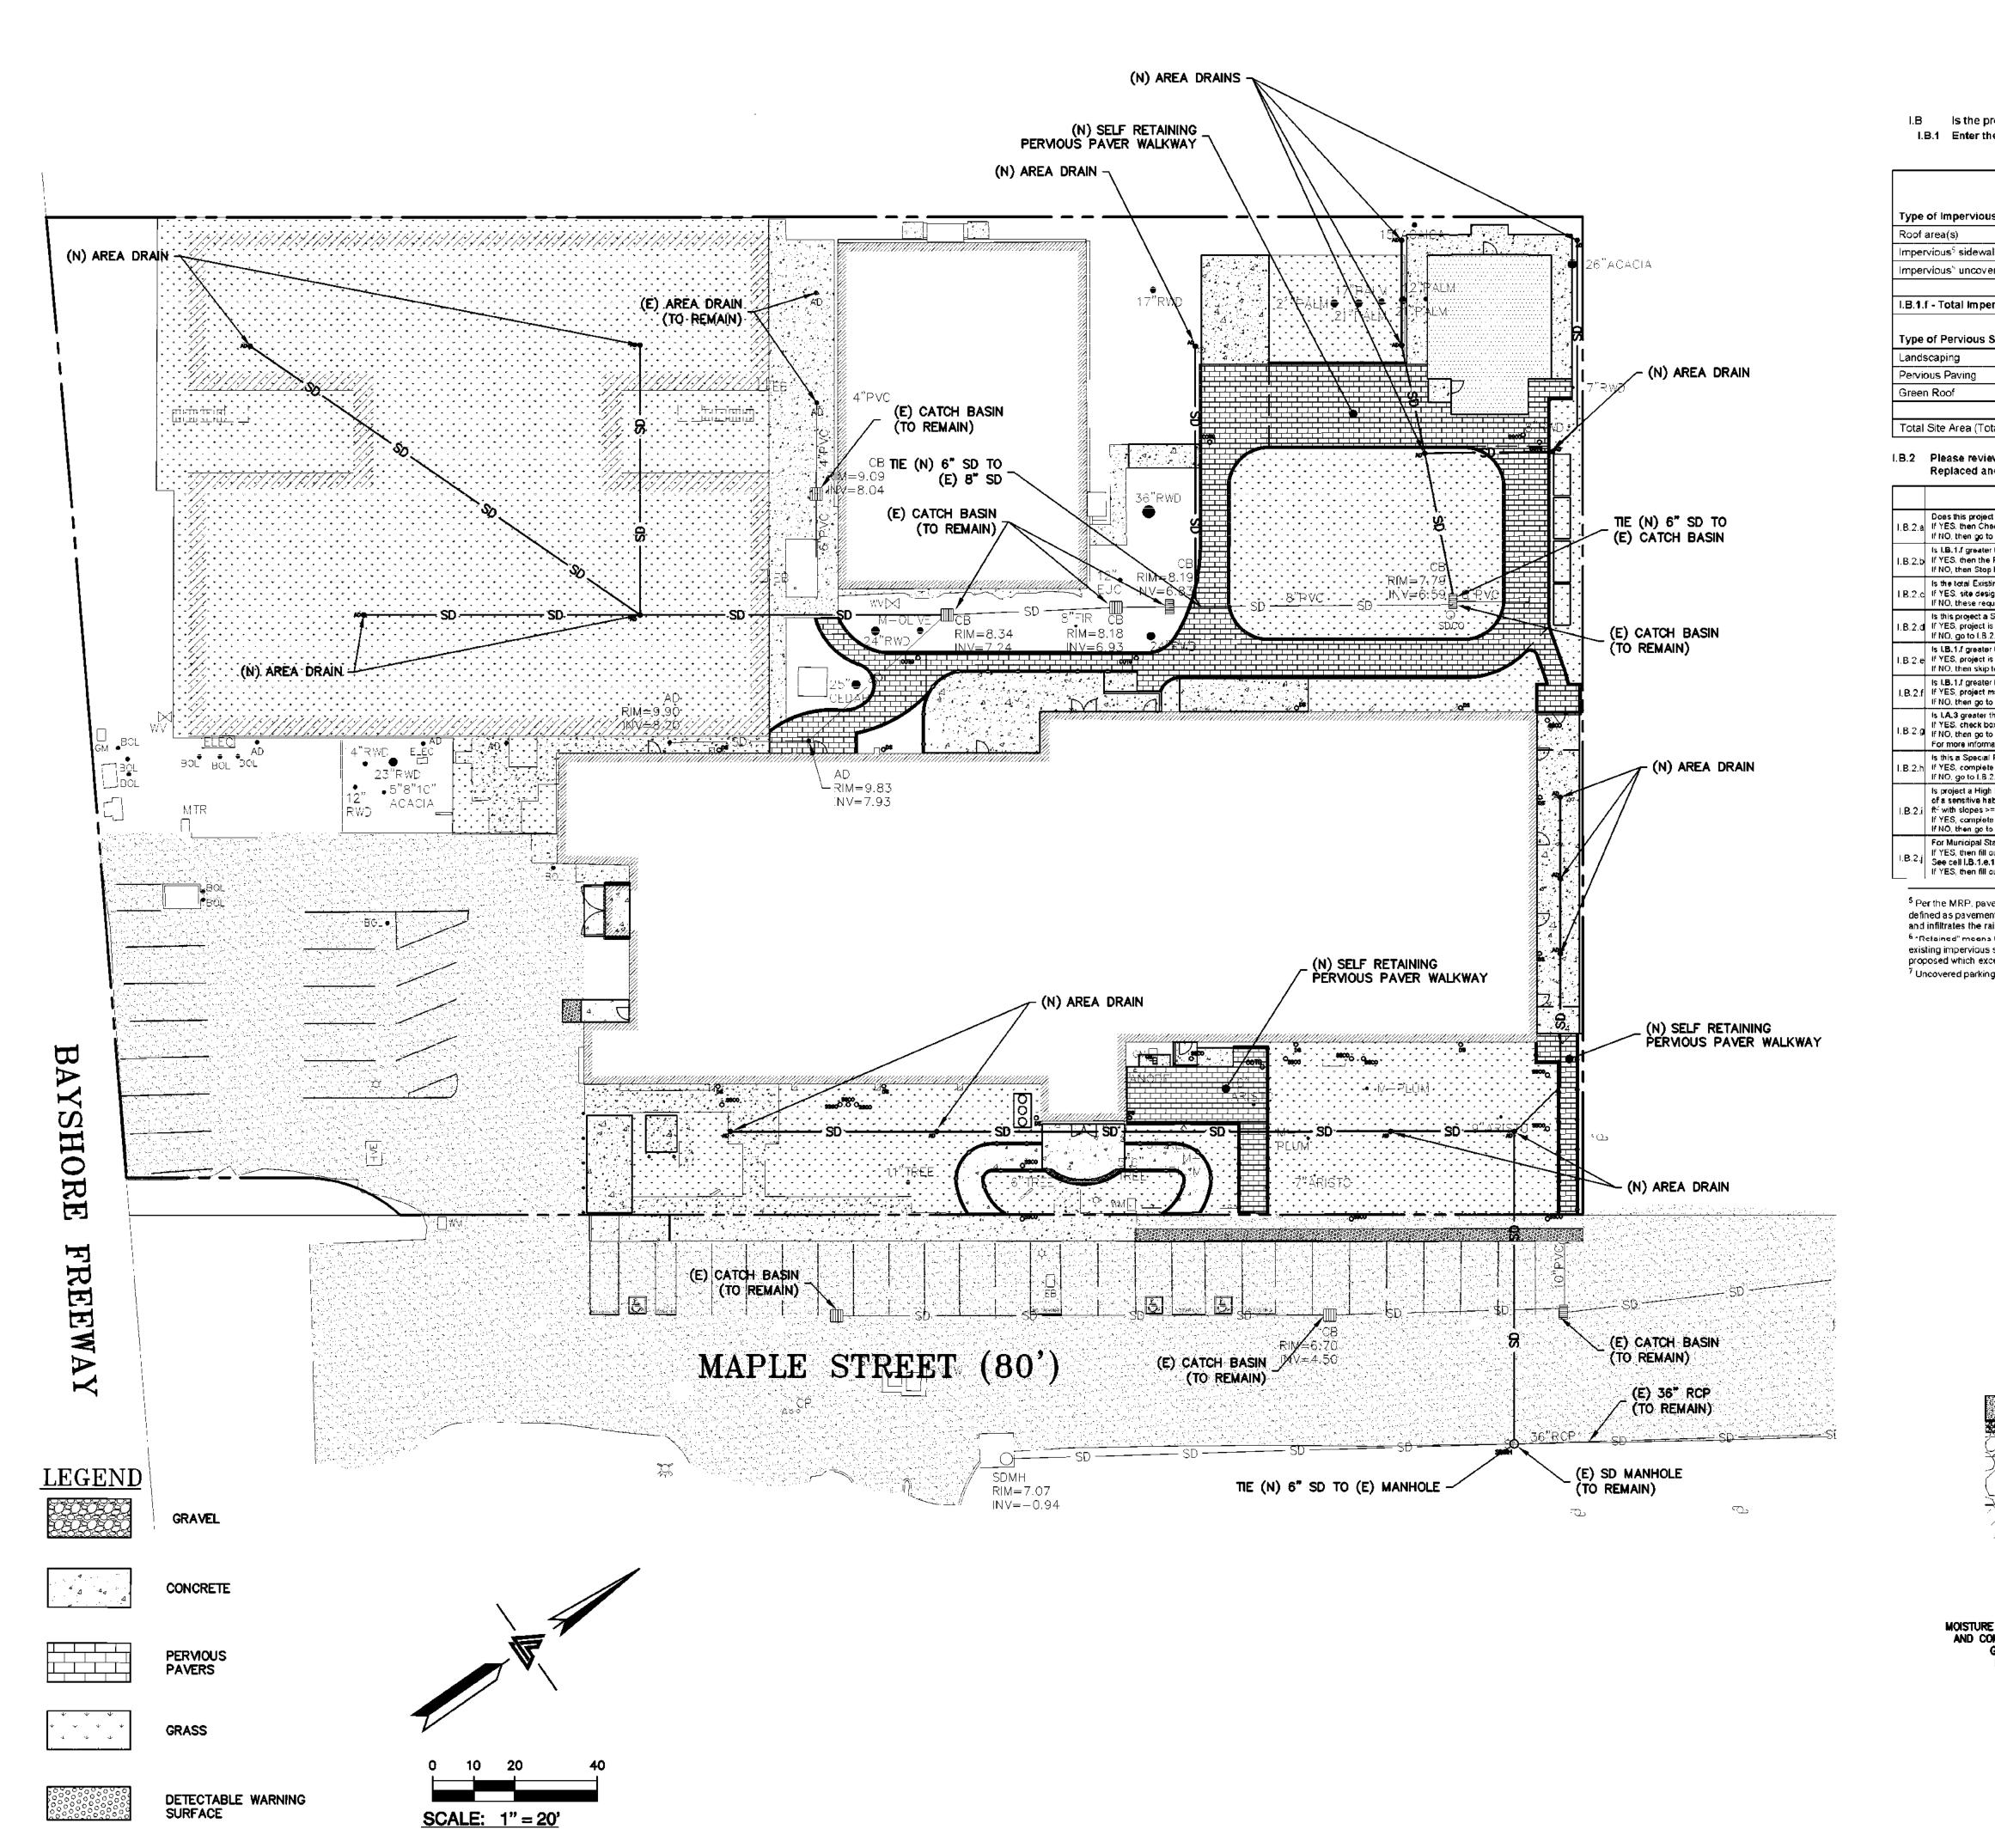

C.3 and C.6 Development Review Checklist

I.B Is the project a "C.3 Regulated Project" per MRP Provision C.3.b? I.B.1 Enter the amount of impervious surface<sup>5</sup> Retained, Replaced and/or Created by the project:

#### Table I.B.1 Impervious<sup>5</sup> and Pervious Surfaces

	I.B.1.a	I.B.1.b	I.B.1.c	I.B.1.d	1.B.1.e
Type of Impervious <sup>5</sup> Surface	Pre-Project Impervious <sup>6</sup> Surface (sq.ft.)	Existing Impervious <sup>6</sup> Surface to be Retained <sup>L</sup> (sq.ft.)	Existing Impervious <sup>6</sup> Surface to be Replaced <sup>6</sup> (sq.ft.)	New Impervious <sup>6</sup> Surface to be Created <sup>6</sup> (sq.ft.)	Post-Project Impervious <sup>5</sup> Surface (sq.ft.) (=b+c+d)
Roof area(s)	39,617	23,833	1,066	0	24,899
Impervious <sup>5</sup> sidewalks, patios, paths, driveways, streets	22,767	11,840	4,177	0	16,017
Impervious' uncovered parking/	0	0	0	0	0
Totals of Impervious Surfaces:	62,384	35,673	5,243	0	40,916
I.B.1.f - Total Impervious <sup>5</sup> Surface Replaced and Crea	ted (sum of tota	is for columns i.	B.1.c and I.B.1.d	(): 5,243	
Type of Pervious Surface	Pre-Project Pervious Surface (sq.fl.)				Post-project Pervious Surface (sq.ft.)
Landscaping	24,795				41,587
Pervious Paving	0			I.B.1.e.1:	4,676
Green Roof	0				0
Totals of Pervious Surfaces:	24,795				46,263
Total Site Area (Total Impervious <sup>5</sup> +Total Pervious=I.A.2)	87,179				87,179

#### I.B.2 Please review and attach additional worksheets as required below using the Total Impervious Surface (IS) Replaced and Created in cell I.B.1.f from Table I.B.1 above and other factors:


	Check all that apply:		( One	
	Oneon an inacappy.	Yes	No	Works
I.B.2.a	Does this project involve any earthwork?  If YES, then Check Yes, and Complete Worksheet A.  If NO, then go to I.B.2.b	⊠		A
I.B.2.b	is I.B. 1.f greater than or equal to 2,500 sq.ft? If YES, then the Project is subject to Provision C.3.i complete Worksheets B, C & go to 1.B.2.c. If NO, then Stop here - go to I.A.5 and complete Certification or ask municipal staff for Small Project Checklist.	$\boxtimes$		В.
I.B.2.c	Is the total Existing IS to be Replaced (column I.B.1.c) 50 percent or more of the total Pre-Project IS (column I.B.1.a)? If YES, site design, source control and treatment requirements apply to the whole site. Continue to I.B.2.d If NO, these requirements apply only to the impervious surface created and/or replaced. Continue to I.B.2.d		×	
I.B.2.d	Is this project a Special Land Use Category (I.A.1) and is I.B.1.If greater than or equal to 5.000 sq.ft? If YES, project is a Regulated Project, Fill out Worksheet D. Go to I.B.2 f. If NO, go to I.B.2.e		$\boxtimes$	С
I.B.2.e	Is I.B.1.f greater than or equal to 10,000 sq.ft? If YES, project is a C.3 Regulated Project - complete Worksheet D. Then continue to I.B.2 f, If NO, then skip to I.B.2.g.		M	С
I.B.2.f	Is I.B.1.f greater than or equal to 43,560 sq.ft? If YES, project may be subject to Hydromodification Management requirements - complete Worksheet E then continue to I.B.2.g. If NO, then go to I.B.2.g.		×	€
I.B.2.g	Is I.A.3 greater than or equal to 1 acre? If YES, check box, obtain coverage under the CA Const, General Permit & submit Notice of Intent to municipality - go to I.B.2.h. If NO, then go to I.B.2.h. For more information see: www.swr.cb.ca.gov/water_issues/programs/storrowater.construction.shtml	×		
I.B.2.h	Is this a Special Project or does it have the potential to be a Special Project?  If YES, complete Worksheet F - then continue to I B.2 i,  If NO, go to I.B.2.i.			F
I.B.2.i	Is project a High Priority Site? (Determined by the Municipality, High Priority Sites can include those located in or within 100 feet of a sensitive habitat, an Area of Special Biological Significance, a body of water, or starting 7/1/16 on sites disturbing >=5,000 ft <sup>2</sup> with slopes >=15% (see I.A.4) (or per municipal criteria/map) and are subject to monthly inspections from Oct 1 to April 30.) If YES, complete section G-2 on Worksheet G - then continue to I.B.2.j. If NO, then go to I.B.2.j		×	G
I.B.2.j	For Municipal Staff Use Only: Are you using Alternative Certification for the project review?  If YES, then fill out section G-1 on Worksheet G. Fill out other sections of Worksheet G as appropriate.  See cell I.B.1.e.1 above - Is the project installing 3,000 square feet or more of pervious paving?  If YES, then fill out section G-3 on Worksheet G. Add to Municipal Inspection Lists (C.3.h)			G

<sup>5</sup> Per the MRP, pavement that meets the following definition of pervious pavement is NOT an impervious surface. Pervious pavement is defined as pavement that stores and infiltrates rainfall at a rate equal to immediately surrounding unpaved, landscaped areas, or that stores and infiltrates the rainfall runoff volume described in Provision C.3.

6 "Retained" means to leave existing impervious surfaces in place, unshanged; "Replaced" means to install new impervious surface where existing impervious surface is removed anywhere on the same property; and "Created" means the amount of new impervious surface being proposed which exceeds the total existing amount of impervious surface at the property.

 $^{7}$  Uncovered parking includes the top level of a parking structure.

1/1/16 v.2

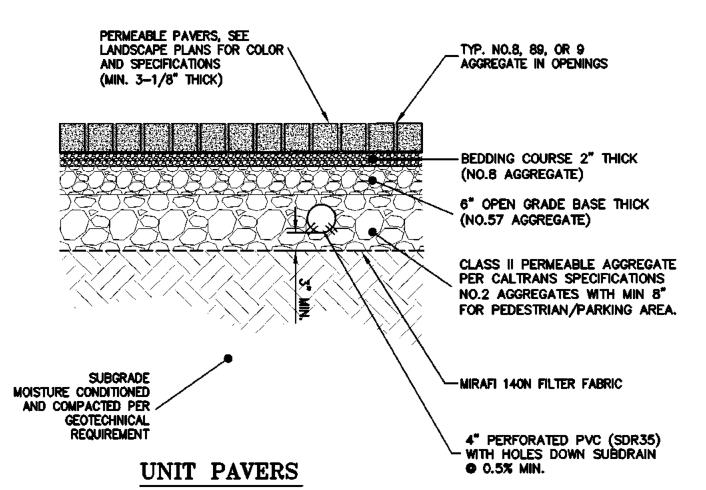



IMPROVEMENT PLANS EMOVES MAPLE STREET SHELTER 1580 MAPLE STREET

SED PROPO:

1 COUNTY COMMENTS MH PC#2/ADD#6 09-23-16 REVISIONS JOB NO: 2151287 DATE: 06-17-16 SCALE: 1"=20' DESIGN BY: MH DRAWN BY: WM

SHEET NO:

#### **GENERAL NOTES:** WITH THE INSTALLATION WORK OF OTHER TRADES. THE DRAWINGS ARE DIAGRAMMATIC AND SHALL NOT BE SCALED TO DETERMINE THE EXACT LOCATION OF SINGLE LINE DUCTS. CONTRACTOR SHALL VERIFY FIELD CONDITIONS AND CLEARANCES ABOVE CEILING AND SHALL MAKE ADJUSTMENTS TO DUCT SIZES, LAYOUTS, EQUIPMENT LOCATIONS AND OTHERS TO BEST SUIT FIELD CONDITIONS.

- 2. THIS CONTRACTOR SHALL REFER TO ELECTRICAL CONTRACT DOCUMENTS TO OBTAIN THE INFORMATION OF STARTERS, VOLTAGE, PHASE, INTERLOCKING CONTROLS & MISCELLANEOUS EQUIPMENT SUCH AS RELAYS IN STARTERS, ETC., SO THAT ALL ELECTRICAL EQUIPMENT SHALL FULLY COMPLY WITH ELECTRICAL AND CONTROL REQUIREMENTS.
- 3. THIS CONTRACTOR WILL PROVIDE THREE COPIES OF OPERATING AND MAINTENANCE INSTRUCTIONS TO THE OWNER (IN VINYL COVER).
- ACCESS OPENINGS FOR DAMPERS SHALL BE INSTALLED IN DUCTWORK WHEREVER FIRE
- 5. DUCT SIZES WITH LINING SHOWN ARE NET, CLEAR INSIDE DIMENSIONS.
- 6. PROVIDE HVAC DUCT INSULATION IN ACCORDANCE WITH ALL APPLICABLE LOCAL CODES.
- 7. ALL SQUARE ELBOW TURNS IN DUCTWORK SHALL HAVE TURNING VANES.
- ALL CURBS AND SLEEPERS FOR AC EQUIPMENT, EXHAUST FANS AND CURBED DUCT PENETRATIONS TO BE FURNISHED AND INSTALLED BY THE CONTRACTOR UNLESS OTHERWISE NOTED. ALL CURBS AND SLEEPERS TO BE INSTALLED LEVEL WITH FINISH FLOOR.
- 9. FURNISH AND INSTALL NOISE AND VIBRATION ISOLATION DEVICES ON DUCTWORK AND EQUIPMENT.
- 10. FLEXIBLE DUCT WORK SHALL NOT BE MORE THAN 6 FEET IN LENGTH FOR ANY ONE APPLICATION.
- 11. EACH SINGLE SYSTEM PROVIDING HEATING OR COOLING AIR IN EXCESS OF 2000 CUBIC FEET PER MINUTE SHALL BE EQUIPPED WITH SMOKE DETECTORS & AUTOMATIC SHUT-OFFS.
- THE ENGINEER DOES NOT TAKE RESPONSIBILITY FOR THE COMPLETE ACCURACY OF THESE CONDITIONS SHOWN ON THE PLANS. THE CONTRACTOR, THEREFORE, SHALL MAKE ALLOWANCES IN HIS BID TO PROVIDE A COMPLETE AND OPERABLE SYSTEM WITH THE INTENT AS DESCRIBED BY THESE DRAWINGS AND SPECIFICATIONS - MAKING PROVISIONS FOR FIELD ADJUSTMENTS AS REQUIRED. THE CONTRACTOR SHALL VISIT THE SITE PRIOR TO
- 13. OPPOSED BLADE DAMPERS ARE NOT PERMITTED AT THE FACE OF THE DIFFUSERS.

START OF WORK OR PRICING.

14. CONTRACTOR SHALL FIELD VERIFY DUCT CLEARANCES, TAKE FIELD MEASUREMENTS AND PROVIDE SHOP DRAWINGS FOR ENGINEERS REVIEW PRIOR TO START OF FIELD CONDITIONS. ENGINEER DOES NOT TAKE RESPONSIBILITIES FOR THE ACCURACY OF DUCT CLEARANCES.

#### **KEYED SHEET NOTES:**

- ALL GREASE DUCTS SHALL SLOPE AT ( 2% ) 1/4 INCH PER FOOT TOWARDS LOWEST POINT AT HOOD CONNECTION. GREASE DUCT SYSTEMS SHALL HAVE CLEANOUTS WITH FIRE RATED ACCESS OPENINGS AND DOORS PER CMC 507.5. LOCATE CLEANOUTS AT EVERY 10 FEET ON STRAIGHT DUCT RUNS, AND AT EACH ELBOW FITTING AND WHERE ANY PORTION OF DUCT HAVING SECTIONS INACCESSIBLE FROM THE DUCT ENTRY OR DISCHARGE. CLEANOUT OPENINGS SHALL BE EQUIPPED WITH TIGHT FITTING DOORS CONSTRUCTED OF STEEL HAVING A THICKNESS NOT LESS THAN THAT REQUIRED FOR THE DUCT, AND EQUIPPED WITH A SUBSTANTIAL METHOD OF LATCHING, SUFFICIENT TO HOLD THE DOOR TIGHTLY CLOSED. DOORS SHALL BE SO DESIGNED THAT THEY CAN BE OPENED WITHOUT THE USE OF A TOOL. ALL GREASE DUCTS, AND THE TOP PORTIONS OF THE TYPE 1 HOODS EXPOSED IN PLENUM, AND CONNECTED SYSTEMS CONCEALED ABOVE CEILINGS SHALL BE WRAPPED IN A 2-HOUR FIRE RATED ENCLOSURE PER CMC 507.6 USING 3M FIRE WRAP FROM DUCT CONNECTION AT HOOD TO THE DUCT PENETRATION THRU ROOF, UP TO 6 INCHES PAST ROOF LINE. PROVIDE FIRE RESISTIVE OPENINGS PER MANUFACTURER SPECIFICATIONS AND DETAILS AT EACH CLEANOUT POINT. REFER TO DETAILS ON SHEET AIR VELOCITY IN GREASE DUCTS SHALL BE MAINTAINED BETWEEN
- 1500 FPM AND 2500 FPM. GREASE DUCT SHALL BE CONSTRUCTED OF BLACK STEEL MINIMUM 16 GAUGE WITH CONTINUOUS LIQUID TIGHT WELD AT ALL JOINTS AND SEAMS.
- DUCTS SHALL BE SUPPORTED PER THE MINIMUM REQUIREMENT OF UMC TABLE 6-E AND SHALL BE BRACED AND GUYED TO PREVENT LATERAL OR HORIZONTAL SWING. THE USE OF LATERAL OR HORIZONTAL SEISMIC RESTRAINT GUIDELINES PER "SMACNA" IS ALSO APPLICABLE.
- (3) INSULATION MATERIALS APPLIED TO THE EXTERIOR OF THE DUCTS LOCATED IN THE BUILDING SHALL HAVE A FLAME SPREAD OF NOT MORE THAN 25 AND SMOKE-DENSITY NOT EXCEEDING 50 WHEN TESTED AS A COMPOSITE INSTALLATION.
- 4 AIR MOVING SYSTEMS SUPPLYING AIR IN EXCESS OF 2,000 CFM SHALL BE EQUIPPED WITH AN AUTOMATIC SHUTOFF/SMOKE DETECTOR. THE SMOKE DETECTOR SHALL AUTOMATICALLY UPON DETECTION OF SMOKE IN THE MAIN SUPPLY-AIR DUCT

- (6) MECHANICAL CONTRACTOR SHALL PROVIDE RECTANGULAR TO ROUND DUCT TRANSITIONS/FITTINGS WHERE REQUIRED.
- (7) INSTALL KITCHEN GREASE EXHAUST HOOD. SUPPORT HOOD PER MANUFACTURER'S INSTRUCTIONS. TRANSITION FROM HOOD CONNECTION TO WELDED KITCHEN EXHAUST DUCT SIZES SHOWN.
- (8) ALL GREASE DUCT SEAMS, JOINTS AND PENETRATIONS AND DUCT TO DUCT COLLAR CONNECTIONS SHALL HAVE A LIQUIDTIGHT CONTINUOUS EXTERNAL WELD. DUCT COLLAR CONNECTIONS SHALL BE ALLOWED TO BE NON WELDED AS SHOWN ON DETAILS ON SECTION 510.5.2 CMC 2013. BUTT-WELDED CONNECTIONS SHALL NOT BE ALLOWED. RECTANGULAR GREASE DUCT SHALL COMPLY WITH CMC 2013 SECTION 510.5.2.1 - 1/2" FLANGE WITH EDGE WELD OR FILLED WELD IS ALLOWED.
- 9 PROVIDE METAL SHIELD (COLLAR) AT POINT OF CEILING PENETRATION TO SEAL DUCT. PROVIDE FIRE RATED CEILING MATERIAL A MINIMUM OF 18 INCHES FROM OUTER EDGE
- (10) RUN DUCT FROM CEILING EXHAUST FAN UP TO HIGH ROOF WITH ROOF VENT AND CAP. TERMINATE VENT CAP 10 FEET FROM FRESH AIR INTAKES.
- (1) GENERAL: THE DUCT LAYOUT IS SCHEMATIC IN NATURE AND THE CONTRACTOR SHALL TAKE INTO ACCOUNT ALL EXISTING FIELD CONDITIONS INCLUDING BEAM AND JOIST ELEVATIONS AND CEILING HEIGHT REQUIREMENTS BY ARCHITECT. THE PROJECT WILL INVOLVE SOME TIGHT CEILING CLEARANCE AREAS. THE CONTRACTOR SHALL MAKE ADJSTMENTS TO DUCT LAYOUT AND SIZING TO FIT THE EXISTING RESTRICTIONS, AT NO ADDED COSTS TO OWNER. THE CONTRACTOR SHALL PRODUCE DETAILED SHEET METAL SHOP DRAWINGS FOR ENGINEERS REVIEWW BEFORE START OF DUCT FABRICATION.
- (12) GENERAL: FOR CEILING DIFFUSERS IN SHEETROCK CEILING AREAS, THE CONTRACTOR SHALL PROVIDE A PLASTER TRIM THAT ALLOWS THE CEILING DIFFUSER TO BE LAY-IN STYLE. THE INTENT IS TO ALLOW THE DIFFUSERS TO BE MOVED FROM PLASTER TRIM FRAME FOR ACCESS TO CEILING MANUAL AIR VOLUME/BALANCING DAMPER MOUNTED IN FLEX DUCT CONNECTOR, WITHOUT THE NEED FOR REMOTE DAMPER OPERATORS.
- \$\frac{13}{2}\$ PROVIDE DUCT SMOKE DETECTORS AT THE MAIN MAKEUP AIR DUCTS FOR MAU-1. THE ELECTRICAL CONTRACTOR SHALL PROVIDE 120V POWER TO THE MAKEUP AIR UNIT AND SHALL INTERLOCK MAKEUP AIR UNITS AND DUCT SMOKE DETECTORS TO SHUT DOWN FANS WHEN SMOKE IS DETECTED. PROVIDE INTERLOCK FOR MONITORING OF DUCT SMOKE DETECTORS BY FIRE ALARM SYSTEM IF

- (14) RUN GREASE DUCT UP THRU ROOF TO EXHAUST FAN. INSTALL 3M FIRE WRAP AROUND DUCTWORK PER M3.10 DETAILS. REFER TO SHEET M2.2 FOR CONTINUATION.
- (15) KEEP AREA ABOVE PANELBOARDS AND ABOVE WORKING AREA OF PANELBOARDS CLEAR OF DUCTWORK IN COMPLIANCE WITH NEC - COORDINATE WITH ELECTRICAL
- (16) MOUNT ALL THERMOSTATS IN MANAGER'S OFFICE WALL, PROVIDE CLEAR LABELS FOR ALL T'STATS, EACH T'STAT SHALL HAVE A REMOTE TEMPERATURE SENSOR MOUNTED IN SPACE BEING SERVED BY HVAC SYSTEM. FINAL SENSOR LOCATIONS SHALL BE COORDINATED WITH OWNER AND ARCHITECT.
- (17) RUN LINED DUCT UP THRU ROOF TO AC UNIT. PROVIDE CURBED ROOF PENETRATION PER DETAIL 5/M3.8. REFER TO SHEET M2.2 FOR CONTINUATION.
- 18 PROVIDE COMBINATION FIRE/SMOKE DAMPER FOR DUCT PENETRATION THRU RATED CEILING LID AT EXIT CORRIDOR WHICH IS A TUNNEL CONSTRUCTION. SEE DETAIL 8/M3.5. PROVIDE REMOTE TEST AND RESET STATION AND MOUNT IN CORRIDOR WALL WITHIN 10 FEET OF FSD.
- (19) PROVIDE 4-INCH DIAMETER DRYER VENT DUCT THRU ROOF. DUCT SHALL BE OF ALUMINUM CONSTRUCTION. PROVIDE LINT TRAP BOX AND BOOSTER FAN. FANTECH OR EQUAL. ONE PER VENT DUCT. PROVIDE ROOF JACK, FLASHING, AND GOOSENECK TERMINATION ON ROOF WITH INSECT SCREEN.
- (20) PROVIDE A SECOND SET OF SA AND RA DUCT PENETRATIONS THRU ROOF FOR AC-5 TO AVOID EXISTING CONCRETE WALL BELOW AT COLUMN LINE 6. THE SECOND ROOF PENETRATION SHALL OCCUR ABOVE FLAT ROOF.

CJ W ARCHITECTURE BORDER REMARKS 130 Portola Road, suite A Portola Valley, CA 94028 \_AY—IN #44 WHITE (650) 851-9335 / (Fax) 851-9337 \_AY—IN #44 WHITE MOUNT \_AY—IN #44 WHITE Tantech Engineers MOUNT BORDER 22 MEP CONSULTING H3 CLIP **ENGINEERS** 

3		
)		
3		
	ı	

nese plans are copyrighted and are subject to copyright tection as an "architectural work" under Sec. 102 of the opyright Act, 17 U.S.O. as amended December 1990 and own as Architectural Works Copyright Protection Act of 990. The protection includes but is not limited to the rerall form as well as the arrangement and composition of aces and elements of the design. Under such protection uthorized use of these plans, work or home represented n legally result in the cessation of construction or building ing seized and /or monetary compensation to CJW

1431 Cedar Street

San Carlos, CA 94070

(415) 269-4283

• PROJECT •

LifeMoves Maple Street Shelter 1580 Maple Street Redwood City CA 94063

• SHEET TITLE •


**HVAC Floor Plan** 


	• REV	ISIONS •
No.	Date 6.17.16	Notes BLDG SUBMITTAL
2	8.15.16	PLAN CHECK # 1 ADDENDUM # 3
<u> </u>	8.25.16	ADDENDUM # 5
4	9.23.16	PLAN CHECK #2 ADDENDUM # 6

• JOB: 2015.2801

° DATE: 06/17/16

• SHEET: M2.1

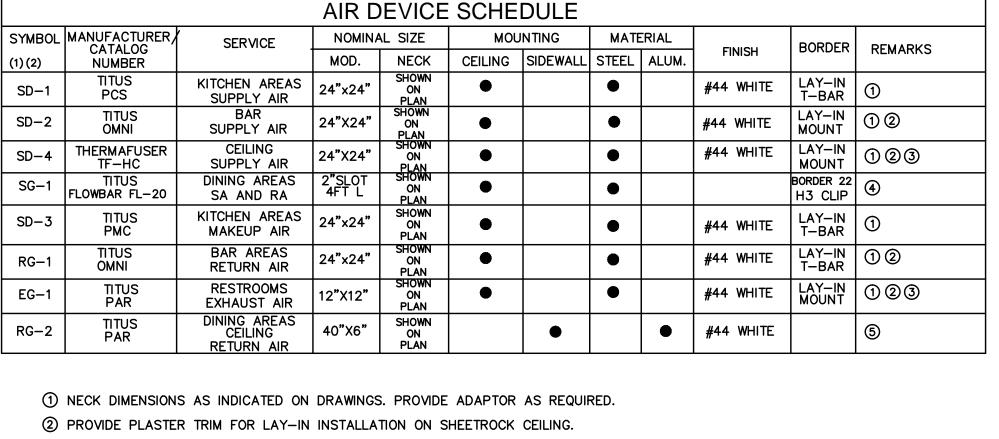

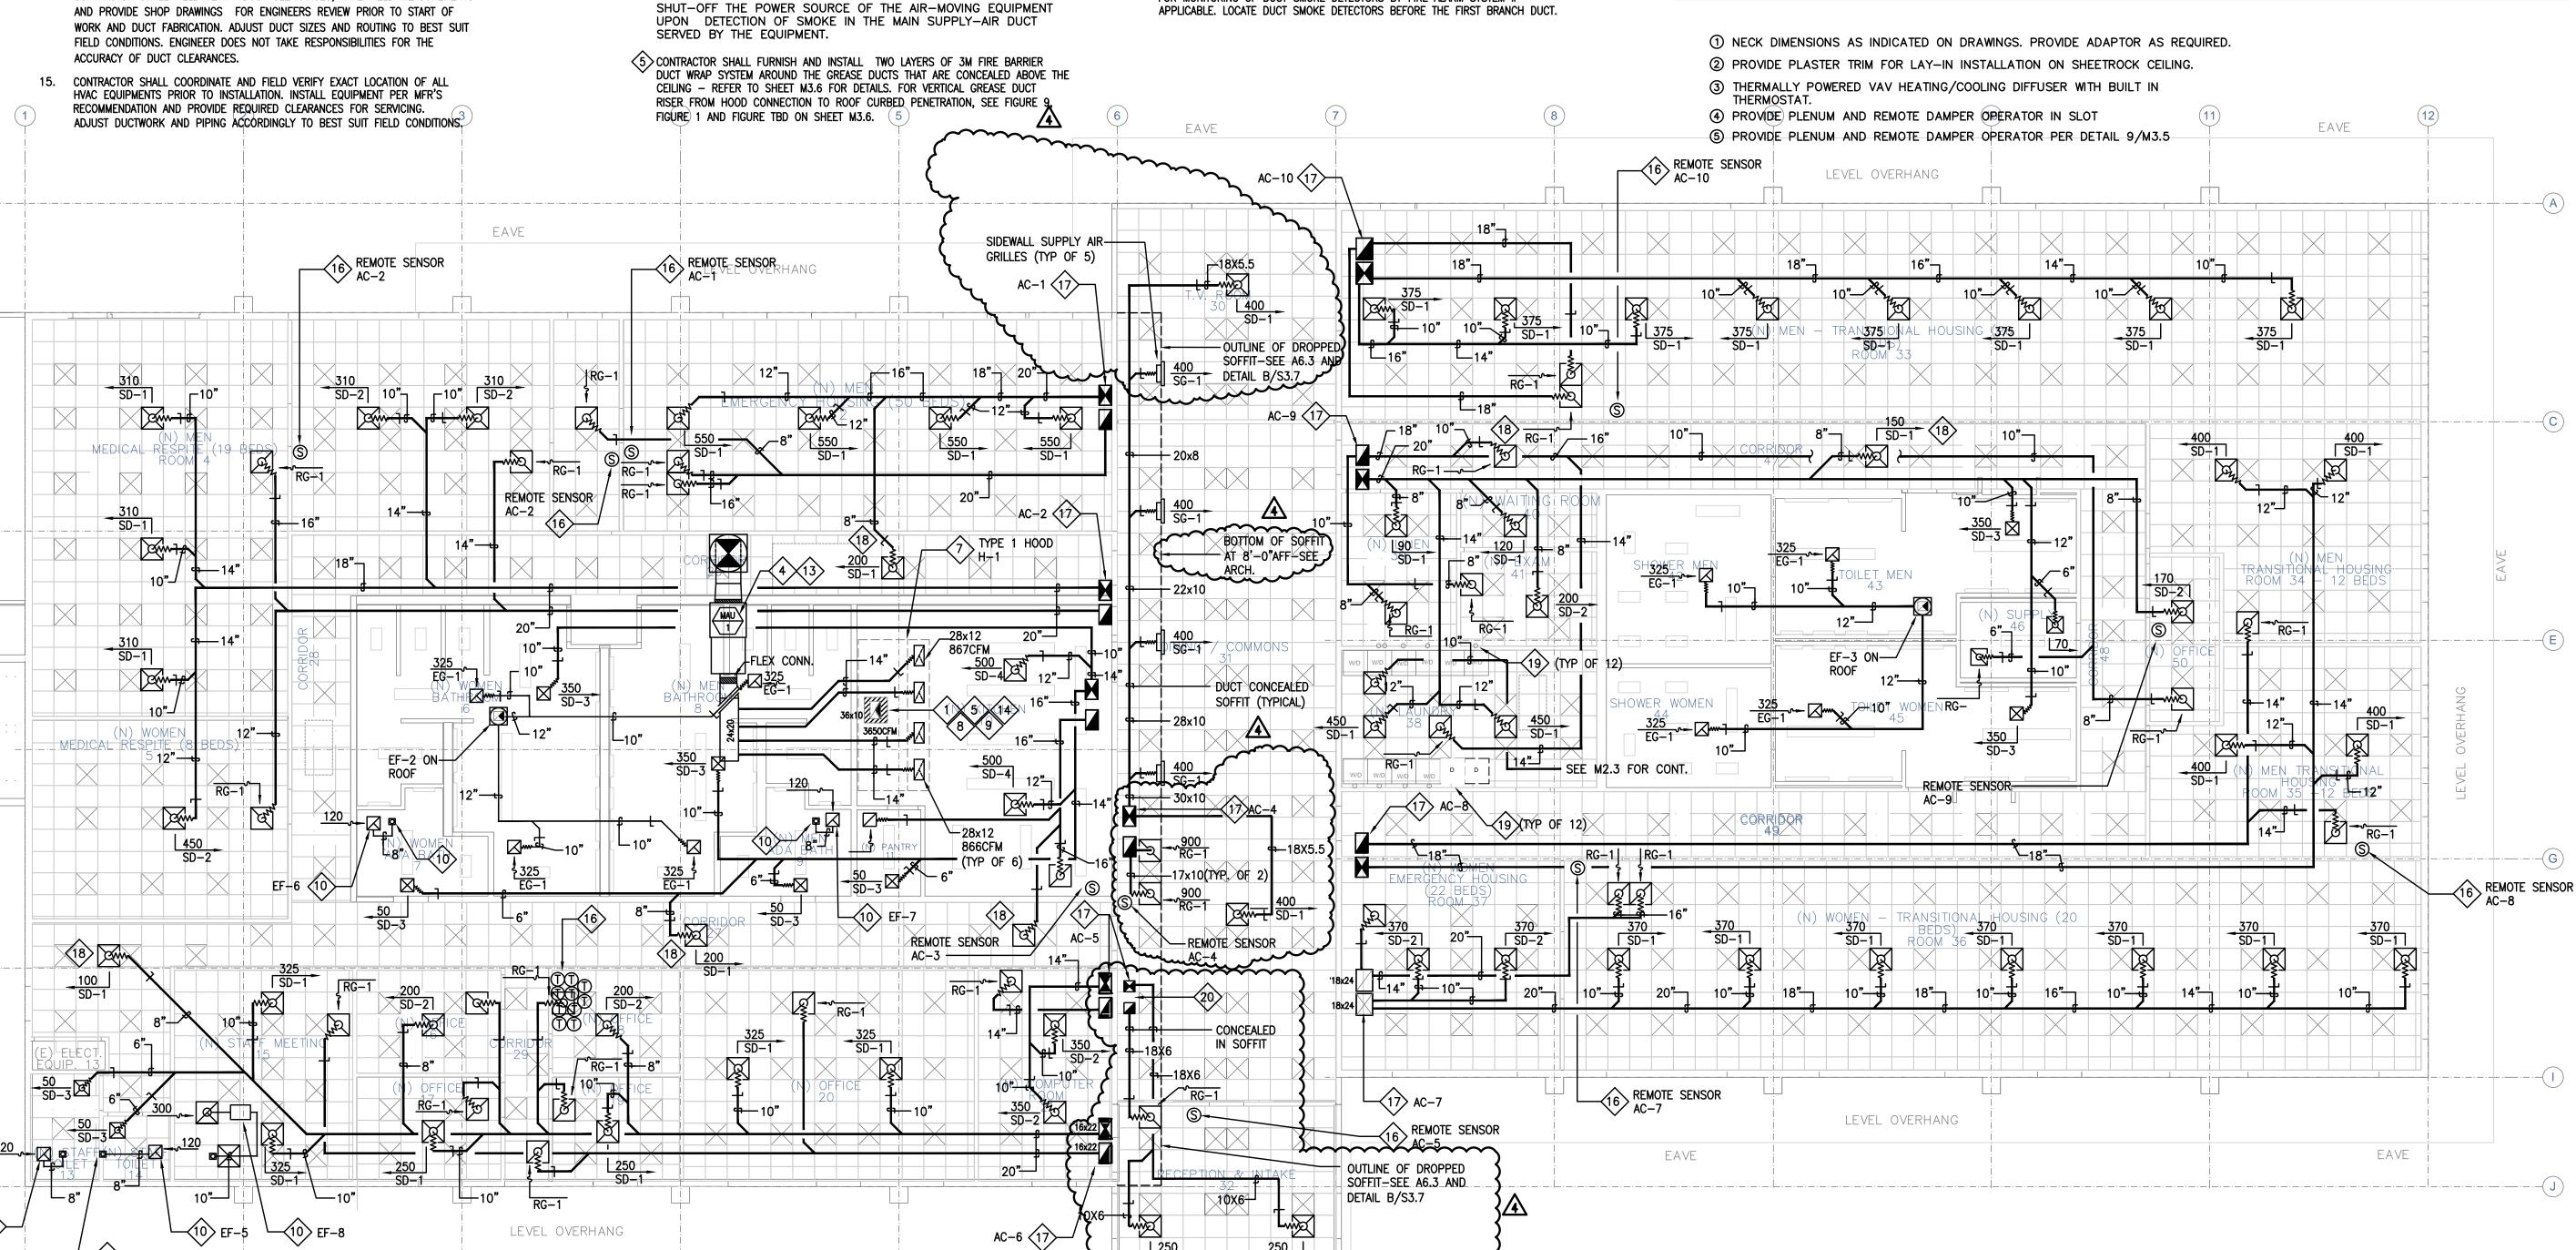

HVAC Floor Plan

CAL GRE	EN 2013 WATE	R FLOW RAT	ES-20% REDU	CTION
	CAL GREEN 2013	3 section 5.303.6		
FIXTURE TYPE	PREVIOUS ALLOWED FLOW RATE	PRESCRIPTIVE 20% REDUCTION REQUIREMENTS	NUMBER INSTALLED	SUBCONTRACTOR INITIAL
SINGLE SHOWER HEADS SECTION 5.303.3.3.1	2.5 GPM @ 80 PSI	2.0 GPM @ 80 PSI	17	
LAVATORY FAUCETS NON RESIDENTIAL SECTION 5.303.3.4.1	0.5 GPM @ 60 PSI	0.5 GPM @ 60 PSI	37	
KITCHEN FAUCETS SECTION 5.303.3.4.2	2.2 GPM @ 60 PSI	1.8 GPM @ 60 PSI	2	
MULTIPLE SHOWER HEADS SERVING ONE SHOWER SECTION 5.303.3.3.2	2.5 GPM @ 80 PSI	2.0 GPM @ 80 PSI	NOT APPLICABLE	
METERING FAUCETS 5.303.3.4.4	0.25/20GPM @ 60 PSI	0.25 GALLONS/CYCLE	NOT APPLICABLE	
WASH FOUNTAINS 5.303.3.4.3	2.0 GPM/20	1.8 GPM/20	NOT APPLICABLE	
WATER CLOSETS 5.303.3.1	1.6 GALLONS/FLUSH	1.28 GALLONS/FLUSH	20	
URINALS 5.303.3.2	1.0 GALLONS/FLUSH	0.5 GALLONS/FLUSH	7	

#### COMMISIONING AND ACCEPTANCE TESTING:

THE CONTRACTOR SHALL ENGAGE A PROFESSIONAL COMMISSIONING THIRD PARTY AGENT OR CONSULTANT, CERTIFIED TO PERFORM THE MEP SYSTEMS COMMISSIONING AND TO PROVIDE A REPORT FOR ALL FUNCTIONAL PEFORMANCE TESTS COMPLETED AS PART OF THE ACCEPTANCE TEST PROCESS. THE LIGHTING CONTROLS ACCEPTANCE TEST TECHNICIANS SHALL BE CERTIFIED THRU AN APPROVED TRAINING PROGRAM, AND REGISTERED WITHIN THE STATE OF CALIFORNIA. BUILDING COMMISSIONING REQUIREMENTS SHALL BE MET AS OUTLINED IN THE 2013 TITLE 24 STANDARDS, PART 11, SECTION 5.410 AND THE CALIFORNIA GREEN BUILDING STANDARDS CODE. ALL PLUMBING FIXTURES SHALL BE TESTED AND COMMISSIONED.

## **GENERAL NOTES:**

- COORDINATE AND VERIFY EXACT LOCATION, SIZE, POINT OF CONNECTION AND INVERT ELEVATION OF SANITARY SEWER, STORM DRAIN, AND WATER BEFORE TRENCHING AND INSTALLATION OF THE PLUMBING SYSTEM. NOTIFY THE ARCHITECT IMMEDIATELY IF THE PLUMBING DRAWINGS INDICATE DIFFERENT LOCATIONS AND INVERT ELEVATION OF THE EXISTING SITE UTILITIES.
- COORDINATE AND VERIFY WITH STRUCTURAL DRAWINGS FOR EXACT LOCATIONS AND ELEVATIONS OF ALL GRADE BEAMS AND FOOTINGS. PROVIDE AND INSTALL SLEEVES THROUGH BEAMS AS REQUIRED WHETHER OR NOT SLEEVES ARE INDICATED ON THE PLUMBING DRAWINGS.
- COORDINATE AND VERIFY ALL LOCATIONS, SIZES AND ELEVATIONS OF ALL SLEEVES THROUGH BEAMS, COLUMNS, SLABS AND FOOTINGS WITH STRUCTURAL ENGINEER AND ARCHITECT PRIOR TO STARTING INSTALLATION OF THE PLUMBING SYSTEM.
- 4. SEE ARCHITECTURAL DRAWINGS FOR EXACT LOCATIONS OF ALL PLUMBING FIXTURES, DRAINS AND EQUIPMENT.
- 5. ALL HORIZONTAL WASTE LINES SHALL BE RUN AT A MINIMUM SLOPE OF 1/4" PER FOOT UNLESS OTHERWISE NOTED ON PLAN.
- 6. ALL VENTS THROUGH ROOF SHALL BE 10'-0" MINIMUM AWAY FROM ANY FRESH AIR INTAKE AND WINDOW.
- THE LOCATION AND ELEVATION OF ALL PLUMBING PIPING SHALL BE VERIFIED AND COORDINATED WITH ALL OTHER TRADES, STRUCTURAL CONDITIONS AND BUILDING CONSTRUCTION PRIOR TO START OF INSTALLATION.
- ALL VALVES AND COCKS SHALL BE LOCATED TO BE READILY ACCESSIBLE. WHERE VALVES ARE INSTALLED WITHIN OR BEHIND WALLS, PARTITIONS OR CEILINGS, AN ACCESS PANEL SHALL BE INSTALLED.
- ALL OUTLETS FOR FUTURE CONNECTIONS SHALL BE INSTALLED SO AS TO PERMIT EASY CONNECTION.
- 10. ALL PLUMBING WORK SHALL BE DONE IN ACCORDANCE WITH BASE-SHELL BUILDING SPECIFICATIONS.
- 11. ALL WASTE AND VENT PIPE SHALL SERVICE WEIGHT NO-HUB CAST IRON PIPE AND FITTINGS.
- 12. ALL HOT AND COLD WATER PIPING SHALL BE TYPE "L" COPPER TUBING, HARD DRAWN WITH WROT COPPER FITTINGS WITH COPPER BRAZED JOINTS.
- 13. ALL HOT WATER PIPING SHALL BE INSULATED, 1" MINIMUM THICKNESS, MANVILLE MICROLOK FIBERGLASS INSULATION.
- 14. HORIZONTAL RAINWATER PIPING SHALL BE SIZED BASED ON TABLE D-2 OF THE 2013 CALIFORNIA PLUMBING CODE .
- ROOF DRAINS, OVERFLOW DRAINS AND RAINWATER PIPING WITHIN THE INTERIOR OF THE BUILDING SHALL BE TESTED IN ACCORDANCE WITH THE PROVISIONS OF THE PLUMBING CODE FOR TESTING DRIAN, WASTE AND VENT SYSTEMS.
- 16. OVERFLOW DRAINS HAVING THE SAME SIZES AS THE ROOF DRAINS SHALL BE INSTALLED WITH THE INLET FLOW LINE LOCATED TWO (2) INCHES ABOVE THE LOW POINT OF THE ROOF.
- 17. ROOF DRAIN AND OVERFLOW PIPING WITHIN THE BUILDING SHALL UTILIZE APPROVED DRAINAGE FITTINGS .
- MANUFACTURED ROOF DRAINS AND OVERFLOW (FIXTURES) SHALL BE IAPMO LISTED

MAPLE STREET SHELTER	
JOB NAME : DOMESTIC POTABLE WATER	
JOB NO. :	
DATE: 5.20.16	
RESERVOIR FED SYSTEM	
PRESSURE AVAILABLE : MINIMUM = $\frac{70}{100}$ P.S.	
$MAXIMUM = \underline{76}  P.S.$	l.
PRESSURE REQUIRED AT FARTHEST FIXTURE :	<u>25</u> P
PRESSURE LOSS DUE TO HEIGHT: 15'x.433	<u>6.5</u> P
PRESSURE LOSS THROUGH METER:	6_ P
PRESSURE LOSS THROUGH BACKFLOW:	<u>12</u> P
OTHER LOSSES :	P
TOTAL LOSSES :	<u>49.5</u> P
LOSS AVAILABLE FOR FRICTION:	
76 - 49.5 = 26.5 P.S.I.	
LENGTH OF RUN - METER TO FARTHEST FIXTURE	:
OUTSIDE BUILDING:	50
INSIDE BUILDING :	_200_
TOTAL:	_250_
EQUIVALENT RUN: $\underline{250}$ X 1.25 =	<u>312.5</u>
ALLOWABLE FRICTION LOSSES:	

F	RICTIO	N LOSS	8.48	PSI PER 10	0 FEET
SIZE	FIX	TURE UNITS		VELOCITY	G.P.M.
SIZE	CW-FLUSH VALVE	CW-FLUSH TANK	HW	(FPS)	G.F.M.
1/2	0	3	3	2.3	1.7
3/4	0	11	9	3.0	4.5
1	0	24	17	3.5	9.0
1-1/4	14	55	29	4.0	15.6
1-1/2	35	104	48	4.5	25.0
2	136	260	120	5.3	51.5
2-1/2	358	474	246	6.1	91.0
3	699	747	412	6.8	145

SET AT 8.48 PSI/100 NOT TO EXCEED 8' PER SECOND

UNIT NO.		1						
NO.	DESCRIPTION		CON	NECTION SIZ	ZES		REMARKS	
WC\		TRAP	W	V	CW	HW	WALL HUNG WATER CLOSET, AMERICAN STANDARD AFWALL, 2257.101, 5905.100 OPEN SEAT, SLOAN ROYAL 111-1.28	
1	WATER CLOSET FLUSH VALVE	INT.	4"	2"	1"	_	FLUSH VÁLVE, MIFAB MC-10 WÁLL CARRIER, ADA COMPLIANT MOUNTING, WHITE VIT. CHINA, BOLT CAPS AND ANGLE STOP	
UR 1	URINAL	INT.	2"	1-1/2"	3/4"	-	WALL HUNG ADA COMPLIANT URINAL, ZURN 5755=U K-5016-ET, SLOAN ROYAL 186-0.5, 0.5 GPF FLUSH VALVE, WHITE VITREOUS CHINA, WALL CARRIER	
LAV 1	LAVATORY, UNDERCOUNTER MOUNT	2"	2"	1-1/2"	1/2"	1/2"	OVAL UNDERCOUNTER MOUNT LAVATORY, KOHLER CAXTON K-2210, 17"X14", WHITE VITREOUS CHINA, WITH OVERFLOW, PROVIDE GRID STRAINER AND BRASS DRAIN PIPE, PROVIDE TRUE BRO LAV INSULATION KIT, STOP AND SUPPLY VALVE, MOEN CHATEAU DECK MOUNT FAUCET WITH 0.5 GPM ARERATORS AND ADA COMPLIANT I ZURN P-6900-MV-XL THERMOSTATIC MIXING VALVE	LEVE
SH 1	STANDARD SHOWER STALLS ASSEMBLY				3/4"	3/4"	SYMMONS 1-911RS SHOWER ASSMEBLY, #22 SINGLE SUPPLY LEVER HANDLE, #221 SUPER BALL JOINT ADJUSTABLE SPRAY SHOWER HEAD WITH VOLUME CONTROL, #RS RECESSED SOAP DISH, 2.0 GPM FLOW RESTRICTOR, THERMOSTATIC PRESSURE BALANCED MIXING VALVE	
SH 2	WALL MOUNT SINGLE SHOWER ASSEMBLY — ADA				3/4"	3/4"	SYMMONS 1-911RS SHOWER ASSMEBLY, #22 SINGLE SUPPLY LEVER HANDLE, #221 SUPER BALL JOINT ADJUSTABLE SPRAY SHOWER HEAD WITH VOLUME CONTROL, #RS RECESSED SOAP DISH, 2.0 GPM FLOW RESTRICTOR, THERMOSTATIC PRESSURE BALANCED MIXING VALVE	
SD 1	SHOWER FLOOR DRAIN FOR SHOWER SH-1 AND SH-2	2"	2"	1-1/2"	-	_	J.R. SMITH 2005-ALP050, 6" STAINLESS STEEL STRAINER, SPEEDI-SET OUTLET	
FD 1	FLOOR DRAIN	3"	3"	2"	_	_	JR. SMITH 2005-B6 W/ NICKEL BRONZE 6"ROUND STRAINER 1/2 INCH TRAP PRIMER TAP, VANDAL PROOF SCREWS CLAMPING COLAR AND SEEPAGE OPENINGS	
FS 1	FLOOR SINK	3"	3"	2"	-	_	JR. SMITH 3120F , 12 INCH SQUARE, 8" SUMP DOME STRAINER PROVIDE HALF GRATE FOR INDIRECT WASTE RECEIVER	
WC 2	FLOOR MOUNT WATER CLOSET FLUSH VALVE	INT.	4"	2"	1"		FLOOR MOUNT WATER CLOSET, AMERICAN STANDARD, MODEL TBD BY ARCHITECT AM STD. 5905.100 OPEN SEAT, SLOAN ROYAL 111-1.28 FLUSH VALVE ADA COMPLIANT MOUNTING, WHITE VIT. CHINA, BOLT CAPS, AND ANGLE STOP VALV	E_
SK 1	LAUNDRY ROOM SINK	2"	2"	1-1/2"	1/2"	1/2"	ELKAY STAINLESS STEEL SINK, COUNTER MOUNT, 24"WIDE X 6"DEEP, ADA ACCESS PROVIDE OFF SET DRAIN AND TRAP FOR ADA ACCESS BELOW, ZURN Z831C4-XL-GOOSENECK FAUCET, TRUEBRO EZ TRAP INSULATION KIT	JIBL –14
SK 2	EXAM ROOM SINK	2"	2"	1-1/2"	1/2"	1/2"	ELKAY STAINLESS STEEL SINK, COUNTER MOUNT, MODEL LRADQ191855, 19X18X5.5' PROVIDE OFF SET DRAIN AND TRAP FOR ADA ACCESS BELOW, ZURN Z831C4—XL-GOOSENECK FAUCET, TRUEBRO EZ TRAP INSULATION KIT	" DI -14
SK 3	STAFF MEETING ROOM SINK	2"	2"	1-1/2"	1/2"	1/2"	ELKAY STAINLESS STEEL SINK, COUNTER MOUNT, 24"WDE X 6"DEEP, ADA ACCESS PROVIDE OFF SET DRAIN AND TRAP FOR ADA ACCESS BELOW, ZURN Z831C4=XLGOOSENECK FAUCET, TRUEBRO EZ TRAP INSULATION KIT	 -14
MS 1	JANITORIAL MOP SINK	2"	2"	1-1/2"	1/2"	1/2"	ELKAY SERVICE SINK, FLOOR MODEL EFS3321C, WITH SERVICE/UTILITY WALL MOUNT FAUCET WITH VACUUM BREAKER, ELKAY MODEL LKB940C	
HB 1	HOSE BIBB	_	_	_	3/4"	_	WOODFORD MODEL 24P CP W/ VAC. BRKR.	
HB 2	HOSE BIBB	-	-	-	3/4"	_	ACORN MODEL 8151 RECESSED HOSE BOX W/ VAC. BRKR.	
<u>AV</u> 2	LAVATORY, WALL HUNG ADA COMPLIANT	2"	2"	1-1/2"	1/2"	1/2"	KOHLER K-2005 KINGSTON LAVATORY, WALL HUNG, ZURN Z-1251 WALL CARRIER, ZURN MV-XL POINT OF USE THERMOSTATIC MIXING VALVE, MOEN 8416 FAUCET, PROFLO PFGD DRAIN, PROFLO P-TRAP, STOP & SUPPLY ANGLE VALVES, TRUEBRO EZ TRAP INSULATIO	100
TMV 1	MIXING VALVE	_	-	_	1"	1-1/4"	SYMMONS MODEL 7-400, PREPIPED WITH TEMP. GAUGE AND BALL VALVE, THERMOSTATIC MIXING VALVE ASSEMBLY, ONE ASSEMBLY PER WATER HEATER RAC	 CK
DF 1	DRINKING FOUNTAIN	2"	2"	1-1/2"	3/4"	-	ELKAY EZH2O BOTTLE FILLER STATION, FILTERED BI-LEVEL LZ COOLER, ELKAY LZSTL8WS HI-LOW ADA COMPLIANT WATER DUAL WATER COOLER WITH CHILLER, 115V-1PH, 4.2 AM PROVIDE (2) ELECT OUTLETS PER ROUGH IN MFR SKETCH, ELKAY MLP-200 WALL CARRI PROVIDE FINISH PER ARCHITECTS DIRECTION	PS,
TD 1	PET KENNEL TRENCH DRAIN SYSTEM	4"	4"	2"	-	_	JR SMITH 9895 KLASSIKDRAIN TRENCH DRAIN SYSTEM , 6-INCH WDTH TRENCH DRAIN S INTERLOCKING PRECAST POLYESTER CONCRETE CHANNELS WITH METAL RAIL , JR SMITH SLOTTED BLACK POLYPROPYLENE GRATE, INSTALL PER MFR INSTRUCTIONS, PROVIDE 4-INCH BOTTOM DRAIN CONNECTIONS	
WHR 1 WHR 2	WATER HEATER RACK				2"	2"	HIGH EFFICIENCY TANKLESS TYPE WATER HEATER, GAS—FIRED, NORITZ C—1991 WITH RACK ASSEMBLY WITH FOUR UNITS PER ASSEMBLY WITH, 2 UNITS BACK TO BACK RACK ASSEMBLY, SHALL BE FACTORY PREPIPED AND PREINSTALLED ON METAL RA COMMON CW, HW, GAS, AND CONDENSATE MANIFOLDS, RATED FOR MAX. 199x4=76 GAS INPUT, PROVIDE 8"PVC COMMON FLUE VENTING KIT FOR BOTH EXHAUST & CO AIR INTAKE WITH VERTICAL THRU ROOF TERMINATION KITS, ROOF JACKS AND CAPS TRS—04 SYSTEMS PER VENT ASSEMBLY KIT, PROVIDE MSB CONTROLLER AND CABL INSTALL AND WIRE PER MFR INSTALLATION INSTRUCTIONS.  WEIGHT: 357 LBS. DIMENSIONS: 44"X29"X58" HT.	WA CK 59 N OMB S, T
WHR 3	(TYPICAL OF FOUR)  PROVIDE (1) CONDENSATE NEUTRALI	ZATION TAP	NK TO SEF	RVE WHR-1	AND WHR-		PROVIDE (1) SEPARATE COND. NEUTR. TANK TO SERVE WHR-3 AND WHR-4. EACH	
MHR 4	HAS PREPIPED CONDENSATE DRAIN MECH CONTRACTOR SHALL PROVIDE ABOVE NEAREST SINK.	MANIFOLD, SHEET ME	COLLECT TAL DRAIN	TO RACKS T	TO A 1-IN PLUMBER :	CH PVC LII SHALL RUN	NE AND RUN AS INDIRECT WASTE TO A RECEPTOR IN ATTIC ( WITH TRAP PRIMER)	). TUC
	ST-8. WATER HEATER RACK #3 SHA	ALL HAVE C	ONE THERM	MOSTATIC MI	XING VALV	E ASSEMB	LY AND ONE EXPANSION TANK. EXPANSION TANK SHALL BE AMTROL THERM X-TROL LY AND ONE EXPANSION TANK. EXPANSION TANK SHALL BE AMTROL THERM X-TROL	_
GI 1	OUTDOOR GREASE INTERCEPTOR		4"	3"		-	OUTDOOR GREASE INTERCEPTOR, JENSEN PRECAST MODEL JP750-EPE, 4" CAST IRON MANHOLE COVERS WITH EXTENSION RINGS AS REQD TO MEET GRADE.	_
PBP 1	REDUCED PRESSURE BACKFLOW PREVENTER	-	_	-	1"	_	WATTS 009-QTS, REDUCED PRESSURE PRINCIPLE, W/ STRAINER, DRAIN TO FLOOR SINK.	
WHA 1	WATER HAMMER ARRESTER	_	_	AS NOTED	_	_	PRECISION PLUMBING PRODUCTS	_
PRV 1	PRESSURE REDUCING VALVE	-	-	-	-	_	WATTS #223-5 BRONZE "Y" STRAINER IN LINE.	
TP \	TRAP PRIMER				3/4"	_	PRECISION PLUMBING PRODUCTS, PPP #P1-500 WITH DU-4. CONCEAL BEHIND STAINLESS STEEL WALL ACCESS COVER.	

PLUMBING FIXTURE SCHEDULE													
	PIPE SCHEDULE												
SERVICE	LOCATION							MAT (%) (%) (%) (%) (%) (%) (%) (%)	ERIA Ly Sold Sold Sold Sold Sold Sold Sold Sold				FITTINGS  SEE SPECIFICATIONS FOR ADDITIONAL INFORMATION
WATER	OUTSIDE		+		-	H	<u>•</u>	+	+	+	+	$\dashv$	LEAD FREE SOLDER LEAD FREE SOLDER
WASTE	ABV. FLR. BEL. FLR.		•		•	H	1	#	#	#	‡	7	PROVIDE TYLER 2-BAND NO-HUB COUPLINGS SCH 40 PVC DWV WITH SOVENT WELD JOINTS
VENT	ABV. FLR. BEL. FLR.		•		•	H	1	+	+	ļ	+	7	PROVIDE TYLER 2-BAND NO-HUB COUPLINGS SCH 40 PVC DWV WITH SOVENT WELD JOINTS
INDIRECT WASTE	INSIDE OUTSIDE	•	+			Н	1	7	+		+	7	LEAD FREE SOLDER LEAD FREE SOLDER
CONDENSATE DRAIN	INSIDE OUTSIDE	•	4				4	7	+	-	1	4	LEAD FREE SOLDER LEAD FREE SOLDER
GAS	INSIDE OUTSIDE IN/OUT		-	•			+		+	+	+	1	SCH. 40 THREADED FITTINGS - 2" & SMALLER SCH. 40 THREADED FITTINGS - 2" & SMALLER WELDED JOINTS - 2.5" AND LARGER
STORM DRAIN	•		•	1		П	7	•	T		1	$\forall$	PROVIDE TYLER 2-BAND NO-HUB COUPLINGS
ROOF DRAIN			•								1		PROVIDE TYLER 2-BAND NO-HUB COUPLINGS
RECYCLED	INSIDE												SEE SHEET P0.2
WATER	OUTSIDE								T				SEE SHEET P0.2

PIPE SCHEDULE & GENERAL NOTES

SCALE NONE

PLUMBING LEGEND

LE	GEND		
SYMBOL	ABBR.	DESCRIPTION	
_	S OR W	SOIL OR WASTE ABOVE FLOOR OR GRADE	
044	S OR W	SOIL OR WASTE BELOW FLOOR OR GRADE	
CWV	SD	COMBINATION WASTE & VENT BELOW GRADE	
	SD	STORM DRAIN ABOVE FLOOR OR GRADE  STORM DRAIN BELOW FLOOR OR GRADE	
OD	OD	OVERFLOW DRAIN ABOVE FLOOR OR GRADE	
— — OD ———	OD	OVERFLOW DRAIN BELOW FLOOR OR GRADE	CJ W ARCHITECTURE
	V	SANITARY VENT	
	CW	COLD WATER	130 Portola Road, suite A Portola Valley, CA 94028
ICW	HW	INDUSTRIAL COLD WATER  HOT WATER	(650) 851-9335 / (Fax) 851-9337
	HWR	HOT WATER  HOT WATER RETURN	
— А —	A	COMPRESSED AIR	Tantech Engineers
— F ——	F	FIRE MAIN	MEP CONSULTING ENGINEERS
AS	AS	AUTOMATIC FIRE SPRINKLER	1431 Cedar Street San Carlos, CA 94070
ASD	ASD	AUTOMATIC SPRINKLER DRAIN	(415) 269-4283
D	D CD	INDIRECT DRAIN LINE	These plans are copyrighted and are subject to copyright
G	G	CONDENSATE DRAIN  FUEL GAS	protection as an "architectural work" under Sec. 102 of the Copyright Act, 17 U.S.O. as amended December 1990 and
TP	TP	TRAP PRIMER	known as Architectural Works Copyright Protection Act of 1990. The protection includes but is not limited to the overall form as well as the arrangement and composition of
<b>—</b>		DIRECTION OF FLOW	spaces and elements of the design. Under such protection, unauthorized use of these plans, work or home represented,
	P.G.	PRESSURE GAUGE W/PETE COCK	can legally result in the cessation of construction or building being seized and /or monetary compensation to CJW
<u> </u>	G.C.	GAS COCK	Architecture.
	P.R.V. G.V.	PRESSURE REDUCING VALVE  GATE VALVE	
	FCO	FLOOR CLEANOUT	
I	wco	WALL CLEANOUT	
——— <u>э</u>		DOWN	
		RISE	
<u> </u>		UNION	
<u> </u>	W.H.A.	SLOPE IN DIRECTION OF FLOW  WATER HAMMER ARRESTOR	• PROJECT •
•	P.O.C.	POINT OF CONNECTION	
	RPBP	REDUCED PRESSURE BACKFLOW PREVENTER	
	ABV.	ABOVE	LifeMoves Maple Street
	A.F.F.	ABOVE FINISHED FLOOR	Shelter 1580 Maple Street
	A.P. BEH.	ACCESS PANEL	Redwood City CA 94063
	BEL.	BEHIND BELOW	
	CLG.	CEILING	
	CONT.	CONTINUATION	
	EXIST.	EXISTING	
	FDC	FIRE DEPT. CONNECTION	SHEET TITLE
	F.F.E. FLR.	FINISHED FLOOR ELEVATION  FLOOR	PLUMBING
	FR.	FROM	LEGEND, NOTES,
	GR	GRADE	AND SCHEDULES
	HDR	HEADER	, 12
	I.E.	INVERT ELEVATION	
	0.S.&Y.	OUTSIDE SCREW & YOKE	
	PIV VTR	POST INDICATOR VALVE  VENT THROUGH ROOF	
	PTR	PRESSURE, TEMP., RELIEF VALVE	• REVISIONS •
			No. Date Notes
	CHEET IN	DEV	6.17.16 BLDG SUBMITTAL 1
	SHEET IN		8.15.16 PLAN CHECK # 1 ADDENDUM # 3  8.25.16 ADDENDUM # 5  9.23.16 PLAN CHECK #2
P0.1 PLU	IMPINO I FOEN	D, NOTES AND SCHEDULES	8.25.16 ADDENDUM # 5
P0.2 REC	CYCLED WATER	SYSTEM NOTES	9.23.16 PLAN CHECK #2 ADDENDUM # 6
P2.2 PLU	JMBING PLAN	<ul><li>WASTE AND VENT</li><li>HOT &amp; CW AND GAS PIPING</li></ul>	
	JMBING ROOF JMBING PLAN	PLAN - DEMOLITION	
P2.5 PLU		- PET KENNEL	
P3.2 WA1	TER HEATER A	CCESSORIES DETAILS	
P3.4 PLU	JMBING DETAIL JMBING DETAIL	S	
	S RISER DIAGR T AND CW RIS		
P3.7 WAS	STE AND VENT	RISER DIAGRAM RISER DIAGRAM	• JOB: 2015.2801
4 JDP-1 JAIL	BUILDING PL	UMBING PLAN - DEMOLITION WORK FURLOUGH BLDG PLUMBING SITE PLAN - DEMOLITION	
VDI -Z MOL	WIN HOLK	JONESCON DEDO I EGNIDINO SITE I EAN — DEMOCITION	° DATE: 06/17/16
		UNIC LECENID SCALE	, CHEET, DO 1

• SHEET: **P0.1** 

#### **KEYED SHEET NOTES:**

- 1 DEMOLISH AND REMOVE EXISTING RESTROOM FIXTURES AND ASSOCIATED PLUMBING WORK. CAP OFF PIPING BELOW SLAB.
- (2) RUN 4" WASTE AND 2" VENT UP IN WALL FOR WATER CLOSET. PROVIDE WALL CARRIER FOR WALL HUNG FIXTURE. MIFAB OR EQUAL. FOR BACK TO BACK FIXTURES PROVIDE THE APPROPRIATE WALL CARRIER TYPE.
- (3) RUN 4" WASTE AND 2" VENT UP IN WALL FOR WATER CLOSET. PROVIDE WALL CARRIER FOR WALL HUNG FIXTURE, MIFAB OR EQUAL. REVIEW EXISTING GRADE BEAM CONDITIONS BEFORE START OF WORK AND ADJUST LAYOUT IN FIELD TO BEST SUIT FIELD CONDITIONS AND TO AVOID CORING THRU GRADE BEAMS WHERE POSSIBLE, AT NO ADDED COST TO OWNER.
- (4) RUN 2" WASTE AND 1.5" VENT UP IN WALL FOR LAVATORY. PROVIDE TRAP INSULATION KIT, TRUEBRO EZ OR EQUAL.
- (5) OUTLINE OF EXISTING FOUNDATION GRADE BEAMS BELOW SLAB, NEW WORK SHALL NOT CONFLICT WITH GRADE BEAMS AND SHALL NOT DAMAGE GRADE BEAMS - VERIFY INVERT ELEVATIONS AND DIMENSIONS AND CONDITIONS IN FIELD. REUSE EXISTING SLEEVES THRU GRADE BEAMS WHERE FEASIBLE — VERIFY IN FIELD. THE PROJECT INTENT IS TO AVOID CORING THRU GRADE BEAMS WHERE POSSIBLE. ANY PROPOSED NEW CORING THRU GRADE BEAMS IF REQUIRED BY FIELD CONDITIONS SHALL BE REVIEWED AND APPROVED BY STRUCTURAL ENGINEER BEFORE START OF WORK.
- (6) RUN 2" WASTE AND 1.5" VENT UP IN WALL FOR SHOWER DRAIN.
- 7 RUN 3" WASTE AND 2" VENT UP IN WALL FOR FLOOR DRAIN. PROVIDE TRAP

- 8 RUN 2" WASTE AND 1.5" VENT UP IN WALL FOR URINAL. PROVIDE WALL
- (9) RUN 2" WASTE AND 1.5" VENT UP IN WALL FOR SHOWER DRAIN. LOCATE SHOWER DRAIN OFF CENTER AS REQUIRED TO AVOID CONFLICT WITH GRADE BEAMS BELOW - VERIFY IN FIELD. SLOPE FLOOR TO CENTERLINE OF FLOOR DRAIN - SEE ARCH PLANS.
- (10) GENERAL: RUN ALL SANITARY WASTE PIPING AT 1/4-INCH PER FOOT SLOPE WHERE FEASIBLE. ALL UNDERSLAB WASTE AND VENT PIPING SHALL BE SCH 40 PVC CONSTRUCTION, DWV SERVICE WEIGHT, SDR-26. ALL UNDERGROUND PIPING SHALL BE SUPPORTED ON STAINLESS STEEL STRAPS AND HANGER RODS AT 8 FEET ON CENTER AND SECURE HANGER RODS FROM SLAB STRUCTURE OR UNDERSIDE OF EXISTING GRADE BEAMS WITH 3/4-INCH EMBED ANCHOR BOLTS. CUTTING THRU EXISTING REBAR REINFORCED SLAB SHALL BE MINIMIZED AND DONE ONLY WITH STRUCTURAL ENGINEERS APPROVAL AND REVIEW. REFER TO SHEET P2.4 FOR PROPOSED AREAS OF SLAB REMOVAL BETWEEN EXISTING GRADE BEAMS. TRENCH, EXCAVATE AND BACKFILL WORK OUTSIDE F DESIGNATED SLAB REMOVAL AREAS SHALL ALL HAPPEN BELOW EXISTING SLAB STRUCTURE. OUTSIDE OF DESIGNATED SLAB REMOVAL AREAS. THE CONTRACTOR SHALL PROVIDE OWNER WITH PROPOSED METHOD OF INSTALLATION OF UNDERGROUND PIPING, INCLUDING SUPPORT OF PIPING FROM EXISTING SLAB STRUCTURE, WITH NO SAWCUTTING OF EXISTING REINFORCED SLAB STRUCTURE. THE PROJECT MAY INVOLVE EXCAVATION AND DIGGING OF TUNNELS TO ALLOW FOR INSTALLATION AT EACH LATERAL FROM BELOW SLAB.
- (11) RUN 2" WASTE AND 1.5" VENT UP TO ATTIC SPACE AND PROVIDE INDIRECT

- (12) RUN 2" WASTE AND 1.5" VENT UP TO ATTIC SPACE AND PROVIDE INDIRECT WASTE RECEPTOR FOR WATER HEATER RACKS. RUN 1" PVC CONDENSATE DRAIN LINES FROM EACH WATER HEATER RACK MANIFOLD TO THE IW RECEPTOR AND TERMINATE WITH AIR GAP. PROVIDE TRAP PRIMER FOR IW RECEPTOR TRAP. SEE SHEET M2.3 FOR LOCATION OF WATER HEATER RACKS. PROVIDE CONDENSATE NEUTRALIZER TANK FOR EACH TWO WATER HEATER RACKS AND INSTALL PER MFR. INSTALLATION INSTRUCTIONS.
- 13) RUN 3/4" PVC CONDENSATE DRAIN LINES FROM EACH WATER HEATER RACK FLUE CVENT END PIECE AND TERMINATE WITH AIR GAP ABOVE IW RECEPTOR. TWO WATER HEATER RACKS SHARE ONE 8-INCH CPVC FLUE. PROVIDE AND INSTALL CONDENSATE DRAIN TRAP PER MFR INSTALLATION INSTRUCTION AS
- (14) RUN FULLSIZE INDIRECT WASTE LINE FROM PREP SINK TO TERMINATE ABOVE
- (15) RUN 2" WASTE AND 1.5" VENT UP IN WALL FOR SINK.


PROVIDED BY RINNAI.

FLOOR SINK WITH AIR GAP.

- (16) RUN 2" GREASE WASTE FROM EACH COMPARTMENT AND COLLECT TO A COMMON 3" GREASE WASTE LINE AND RUN TO WALL AND DOWN THRU SLAB TO UNDERGROUND GW LINE. PROVIDE 2" VENT UP IN WALL.
- (17) RUN 2" INDIRECT WASTE LINE FROM DISHWASHER TO TERMINATE ABOVE FLOOR SINK WITH AIR GAP.
- (18) RUN 3" PVC GREASE WASTE FROM FLOOR SINK, WITH 2" VENT UP IN WALL AND CONNECT TO GREASE WASTE LINE.

- 20 RUN 4" SANITARY VENT HRU ROOF WITH ROOF JACK, FLASHING AND SEAL WEATHERTIGHT USING ROOFING CONTRACTOR. TERMINATE VTR A MINIMUM OF 15 4 FEET FROM ANY FRESH AIR INTAKES ON ROOF - COORDINATE WITH MECHANICAL CONTRACTOR.
- (21) RUN 3/4" T&PRV RELIEF VALVE DRAIN LINES FROM WATER HEATERS TO THE INDIRECT WASTE RECEPTORS IN ATTIC SPACE, WITH AIR GAP TERMINATION. PROVIDE SHEET METAL DRAIN PAN BELOW EACH WATER HEATER RACK AND RUN 1-INCH SECONDARY DRAIN LINE FROM SHEET METAL PAN THRU THE CEILING WITH ESCUTCHEON, ABOVE A SINK SUCH THAT ANY LEAKAGE PROBLEMS WILL BE VISIBLE FROM BELOW.
- (22) RUN 2" WASTE AND 1.5" VENT UP IN WALL FOR DRINKING FOUNTAIN.
- 23 RUN 2" WASTE AND 1.5" VENT UP IN WALL FOR DISHWASHER. PROVIDE AIR GAP ABOVE COUNTER AND INSTALL DRAIN PER MFR INSTRUCTIONS.
- (24) FURNISH AND INSTALL AN UNDERGROUND OUTDOOR GREASE INTERCEPTOR, JENSEN PRECAST JP750-EPE-G, WITH 4" GREASE WASTE IN AND OUT. PROVIDE 24-INCH CAST IRON MANHOLE COVERS AND EXTENSION RINGS AS REQUIRED. PROVIDE VENT LINES TO BUILDING AS SHOWN.
- 5 FURNISH AND INSTALL NEW RAINWATER LEADERS, TO REPLACE EXISTING RWL IN SAME LOCATIONS AND SIZES - COPPER PIPING CONSTRUCTION FOR VERTICAL RISERS. ROOF DRAINS SHALL ALSO BE REPLACED WITH NEW IN SAME LOCATION - SEE SHEET P2.3 AND P2.4. VERIFY CONDITIONS IN FIELD. PROVIDE 3" RAINWATER LEADERS SECURED TO WALL TO REPLACE EXISTING 3 SHEETMETAL DOWNSPOUTS, RUN RWL DOWN TO BELOW GRADE AND CONNECT

- 26 FURNISH AND INSTALL NEW STORM DRAIN LINES BELOW SLAB IN SAME LAYOUT AND LOCATION AND SIZES TO REPLACE EXISTING - SEE SHEET P2.4. THE UNDERGROUND PIPING SHALL BE PVC SCH 40 CONSTRUCTION WITH STAINLESS STEEL SUPPORTS SET AT 8 FT OC, SECURED TO SLAB OR GRADE BEAM STRUCTURE WITH S.S. ANCHOR BOLTS AND USE S.\$. HANGERS AND STRAPS.
- 27 RUN 4"SS FROM PET KENNEL AREA TO THE SEWER MAIN SEE CIVIL PLANS FOR CONTINUATION.
- (28) RUN WASTE LINE CONCEALED IN CHASE ABOVE SLAB AND PENETRATE SLAB AT LOCATION AS SHOWN TO AVOID GRADE BEAM.
- (29) GENERAL: CONTRACTOR SHALL PERFORM GPR OR XRAY OF EXISTING SLAB STRUCTURE BEFORE CORING FOR NEW FLOOR SINKS OR FLOOR DRAIN'S TO AVOID CONFLICTS WITH EXISTING REBAR AND SLAB REINFORCEMENTS. CORING THRU EXISTING REBAR REINFORCED SLAB | SHALL BE DONE PER STRUCTURAL ENGINEERS RECOMMENDATIONS.
- (30) RUN 4" WASTE AND 2" VENT UP IN WALL FOR WATER CLOSET. PROVIDE BACK TOP BACK WALL CARRIER FOR WALL HUNG FIXTURES, MIFAB OR EQUAL. RUN 4" WASTE LINE IN CHASE BEHIND FIXTURES ABOVE FINISH FLOOR AND RUN TO CHASE TO CLEAR GRADE BEAM BEFORE SLAB PENETRATION.

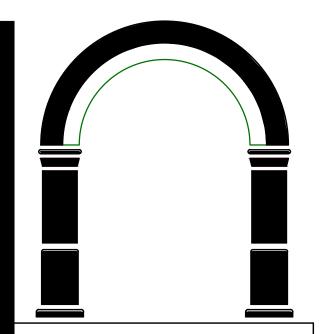

CJ W ARCHITECTURE

130 Portola Road, suite A Portola Valley, CA 94028

(650) 851-9335 / (Fax) 851-9337

Tantech Engineers **MEP CONSULTING ENGINEERS** 1431 Cedar Street San Carlos, CA 94070 (415) 269-4283

hese plans are copyrighted and are subject to copyright ection as an "architectural work" under Sec. 102 of the pyright Act, 17 U.S.O. as amended December 1990 and nown as Architectural Works Copyright Protection Act of 90. The protection includes but is not limited to the erall form as well as the arrangement and composition of paces and elements of the design. Under such protection, authorized use of these plans, work or home represented, can legally result in the cessation of construction or building ng seized and /or monetary compensation to CJW

• PROJECT •

LifeMoves Maple Street Shelter 1580 Maple Street Redwood City CA 94063

SHEET TITLE •

PLUMBING PLAN -WASTE AND **VENT** 


0	REVISIONS	0


BLDG SUBMITTAL PLAN CHECK #1 ADDENDUM # 3 ADDENDUM # 5 PLAN CHECK #2 ADDENDUM # 6


JOB: 2015.2801


DATE: 06/17/16

• SHEET: **P2.1** 

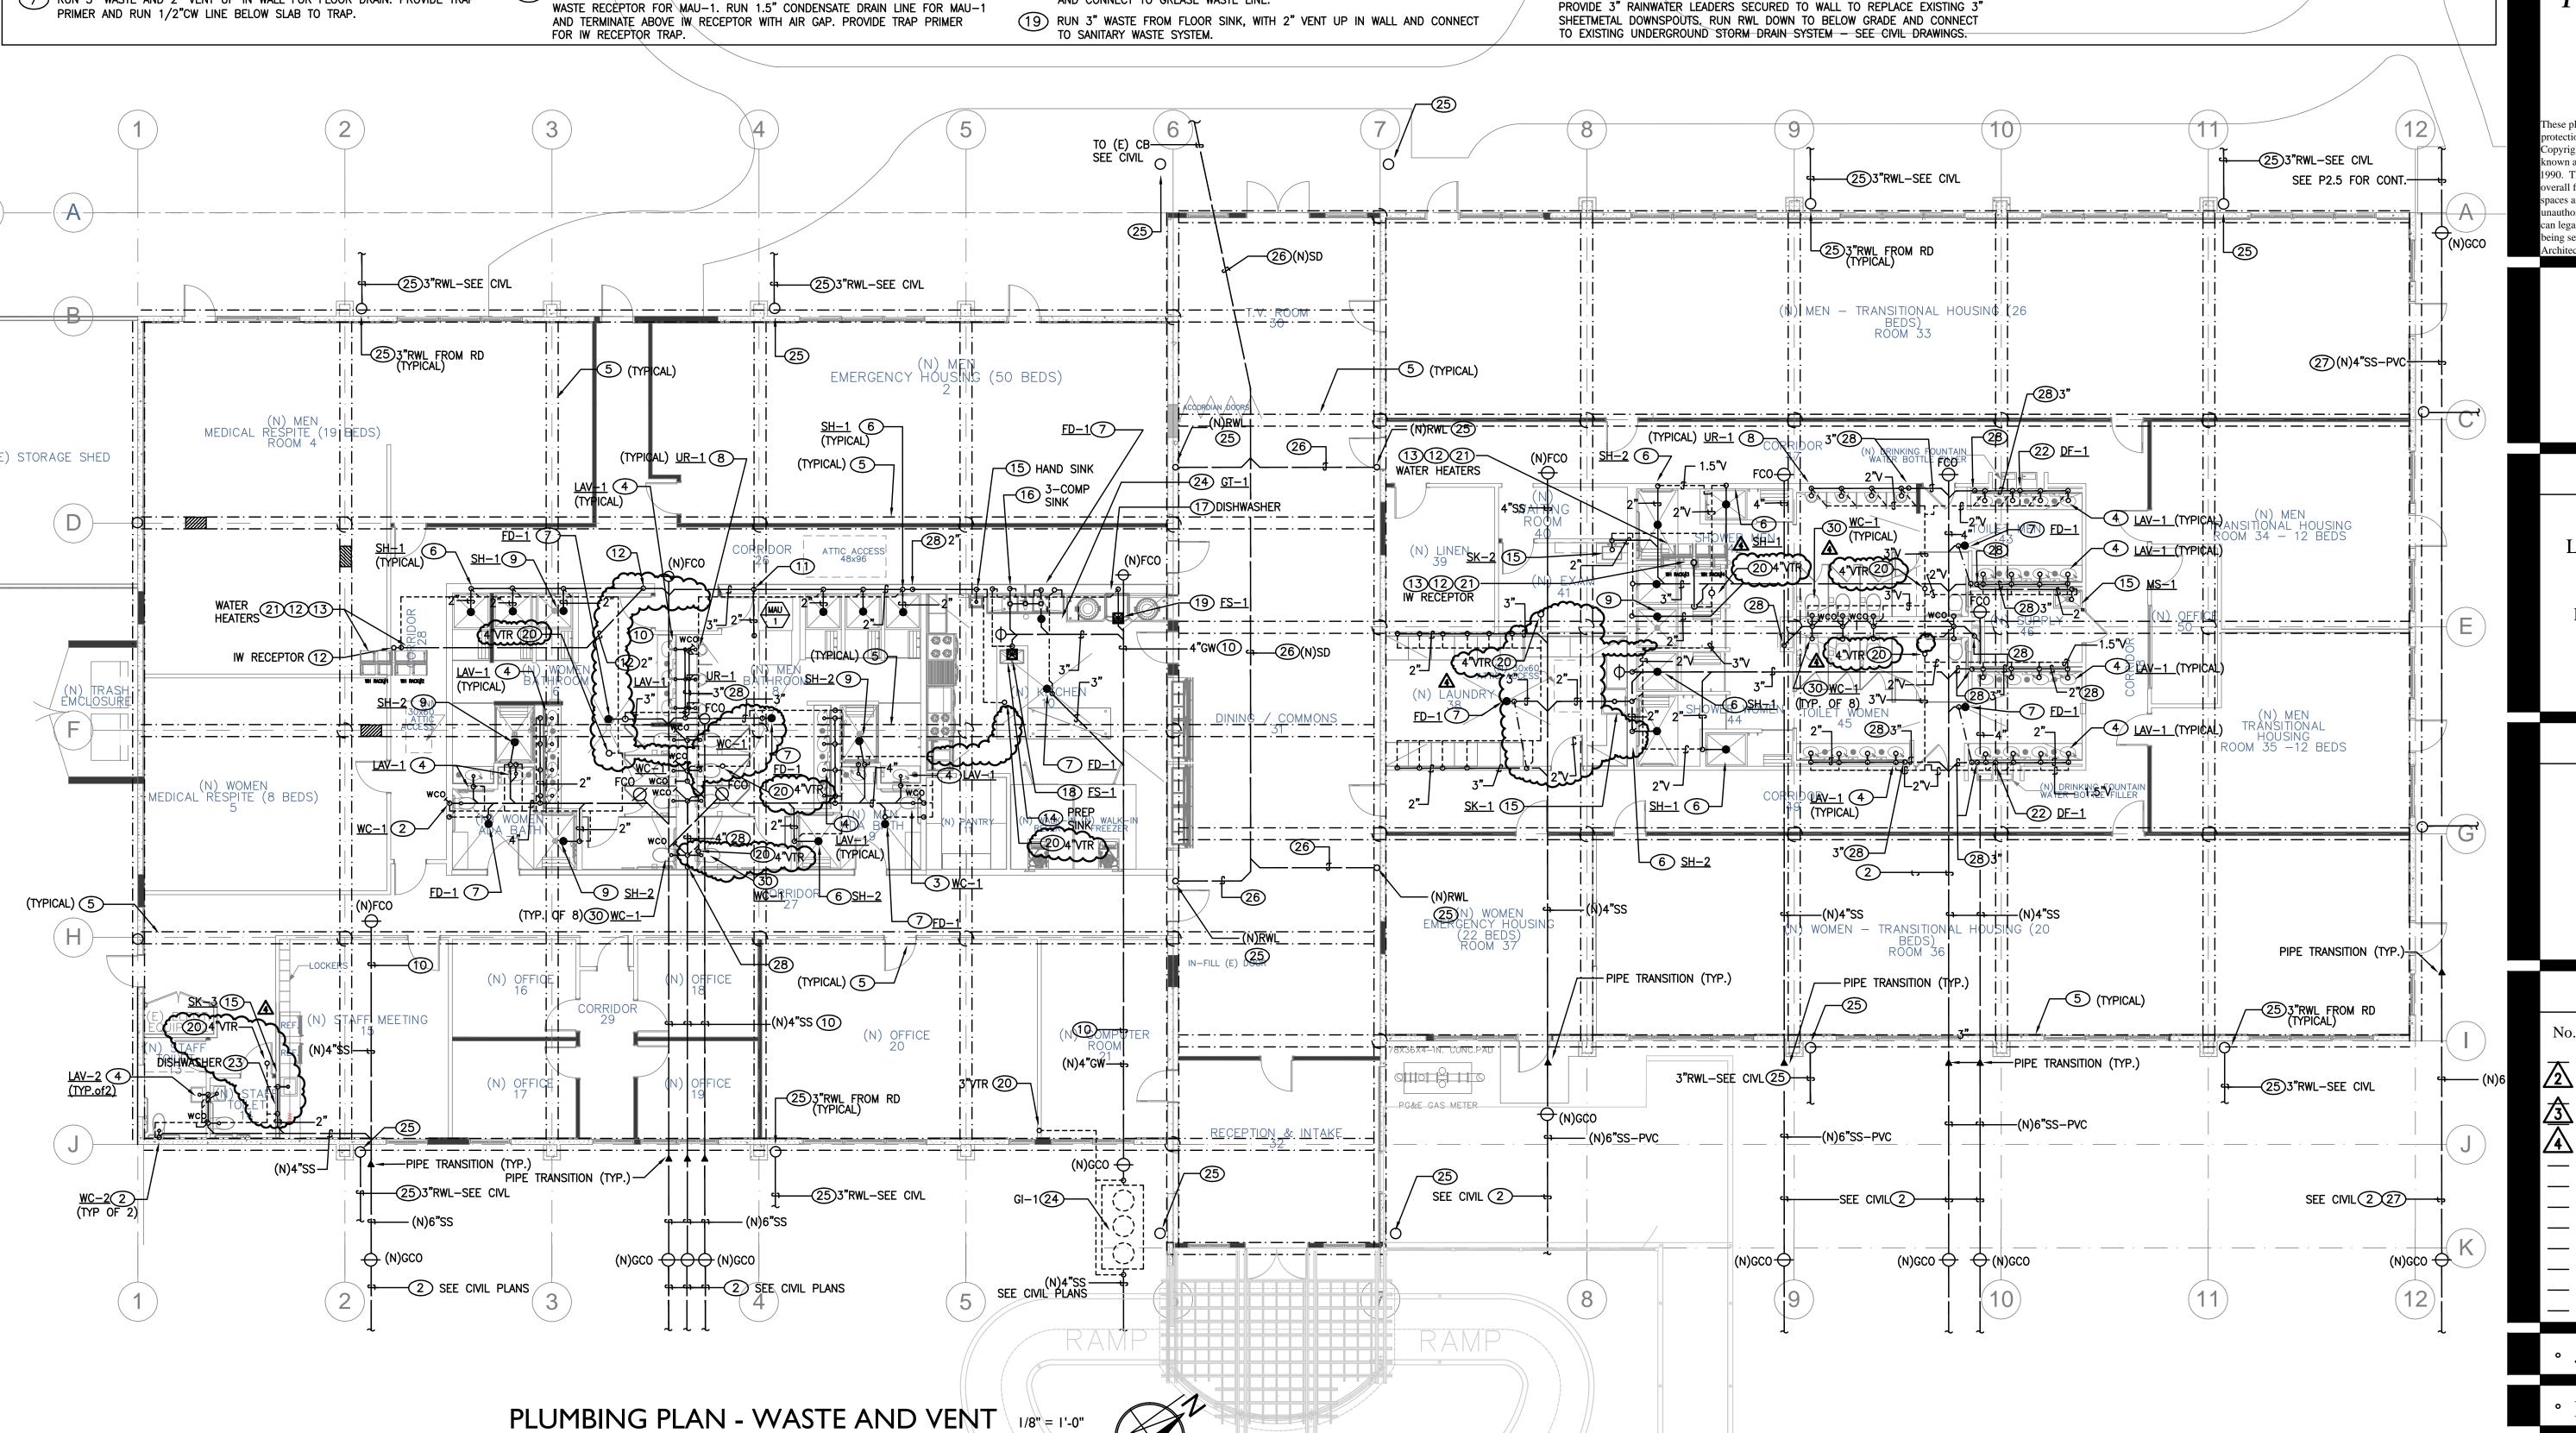

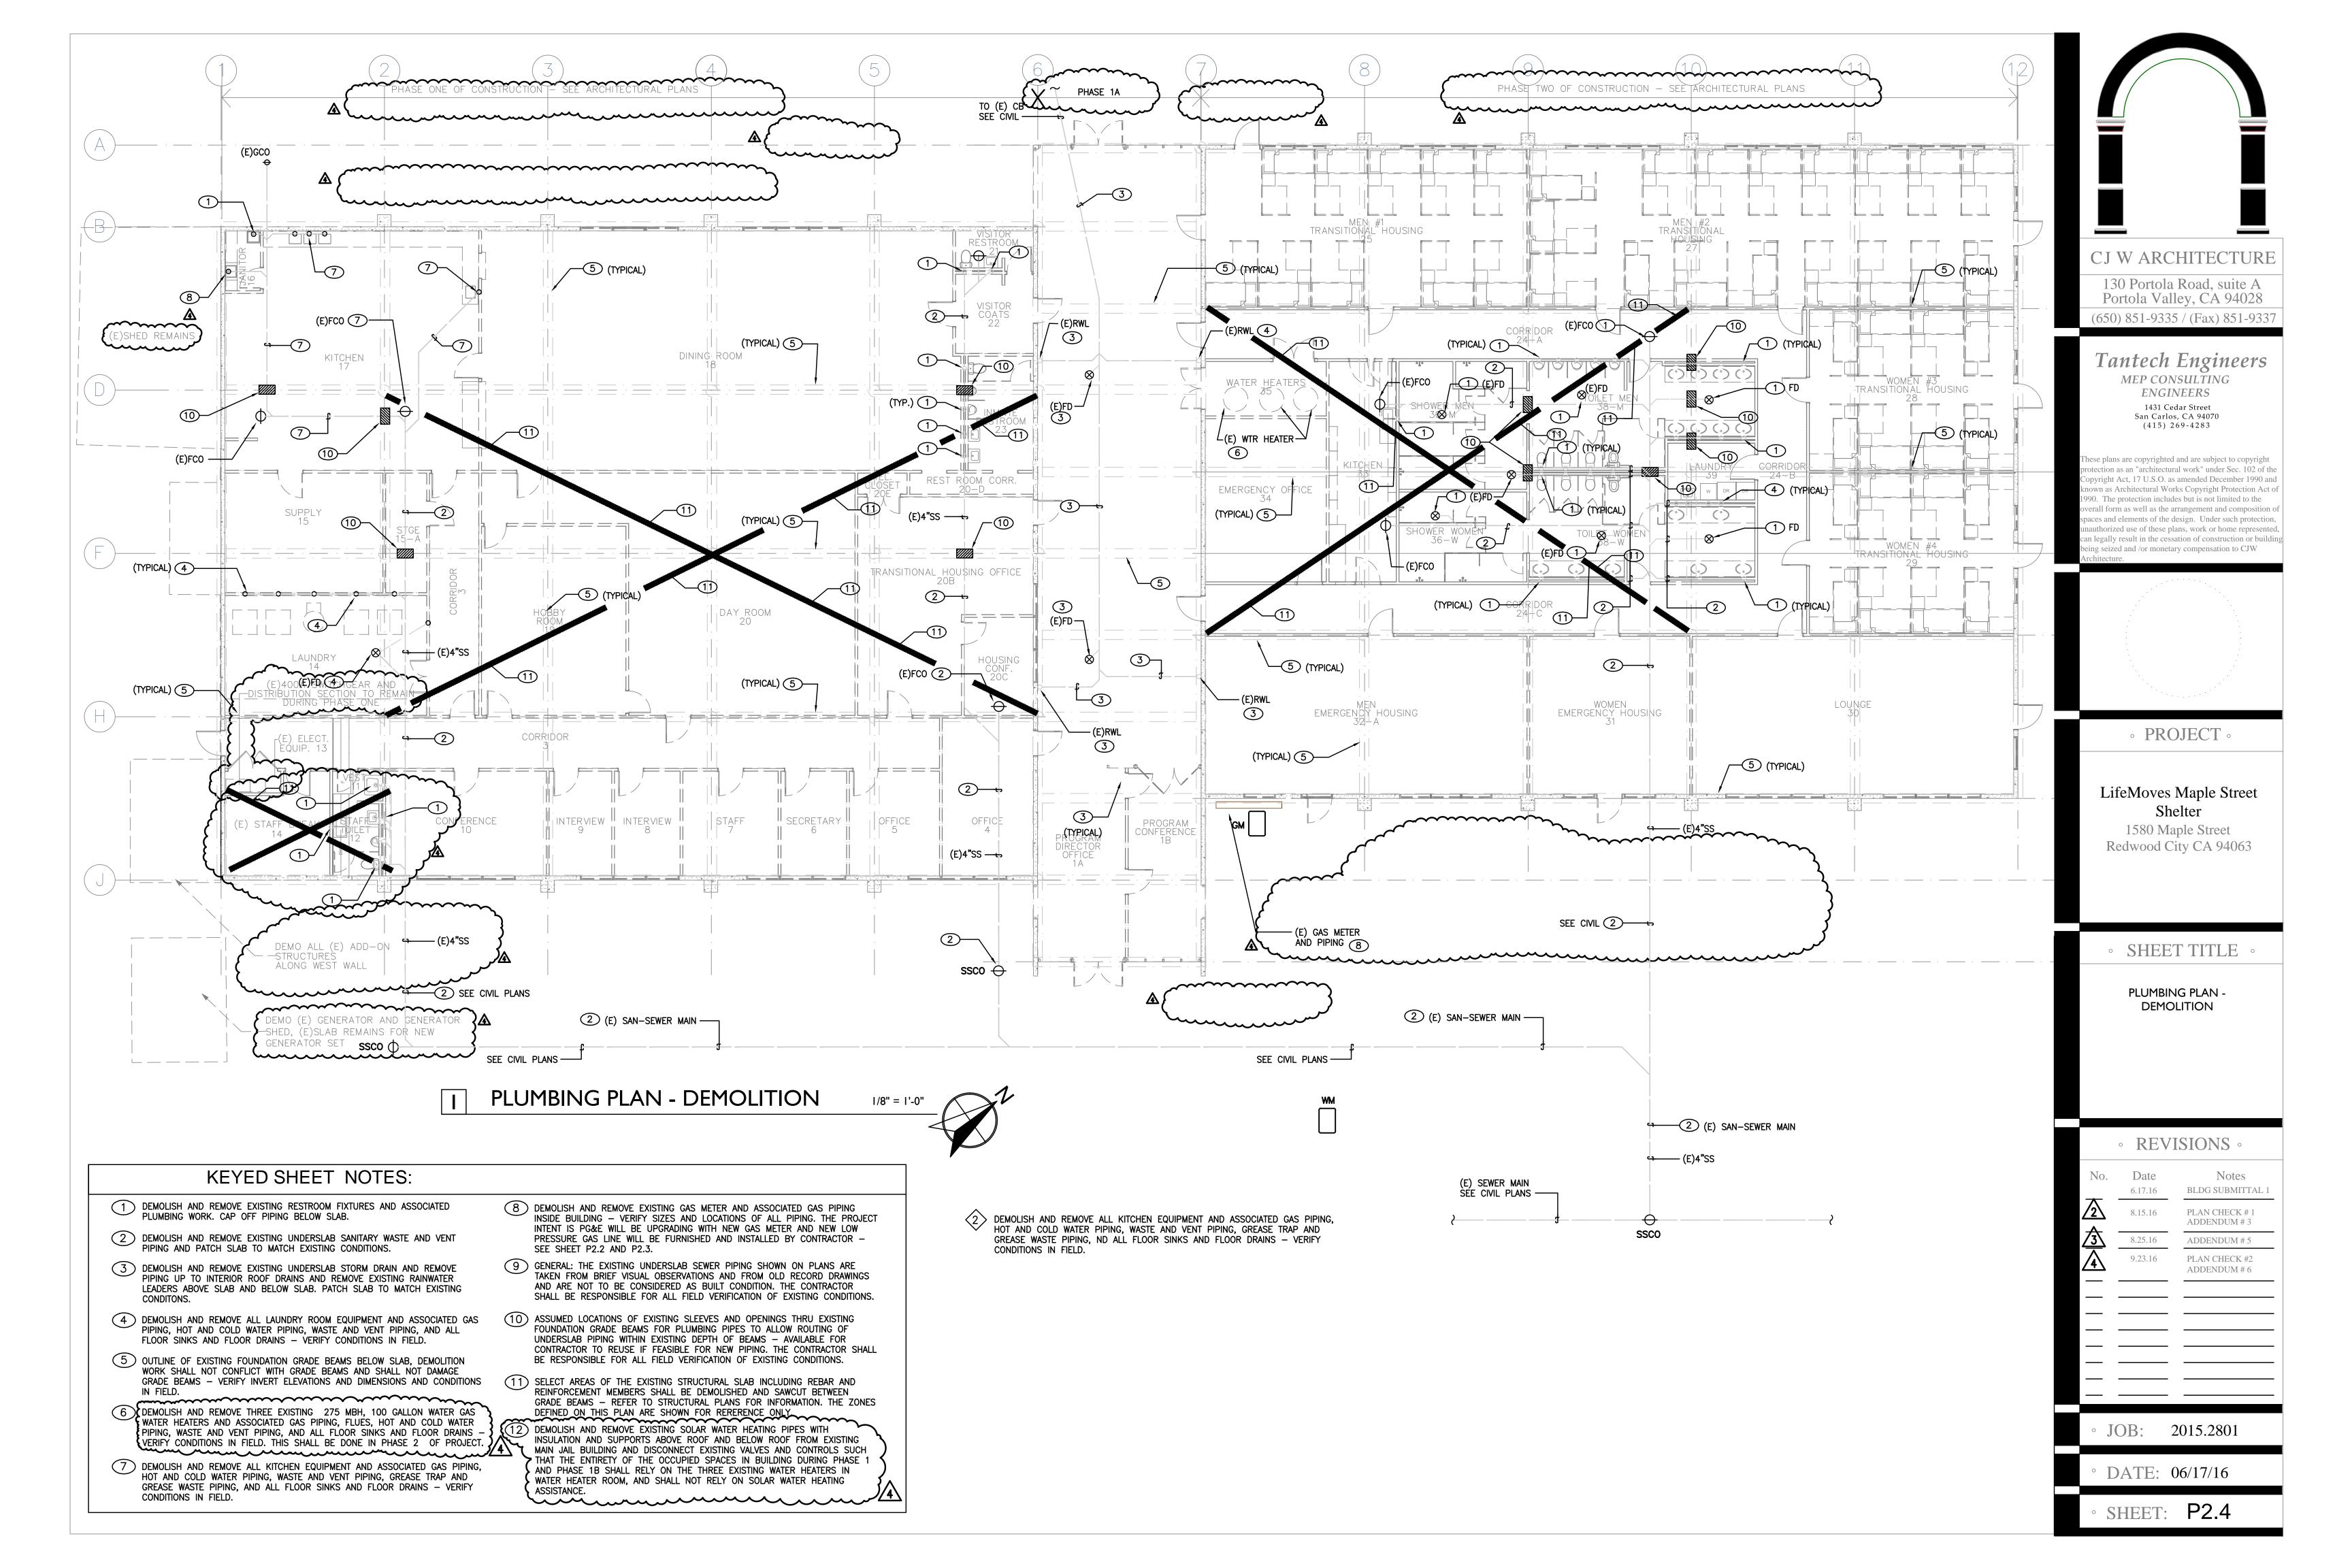

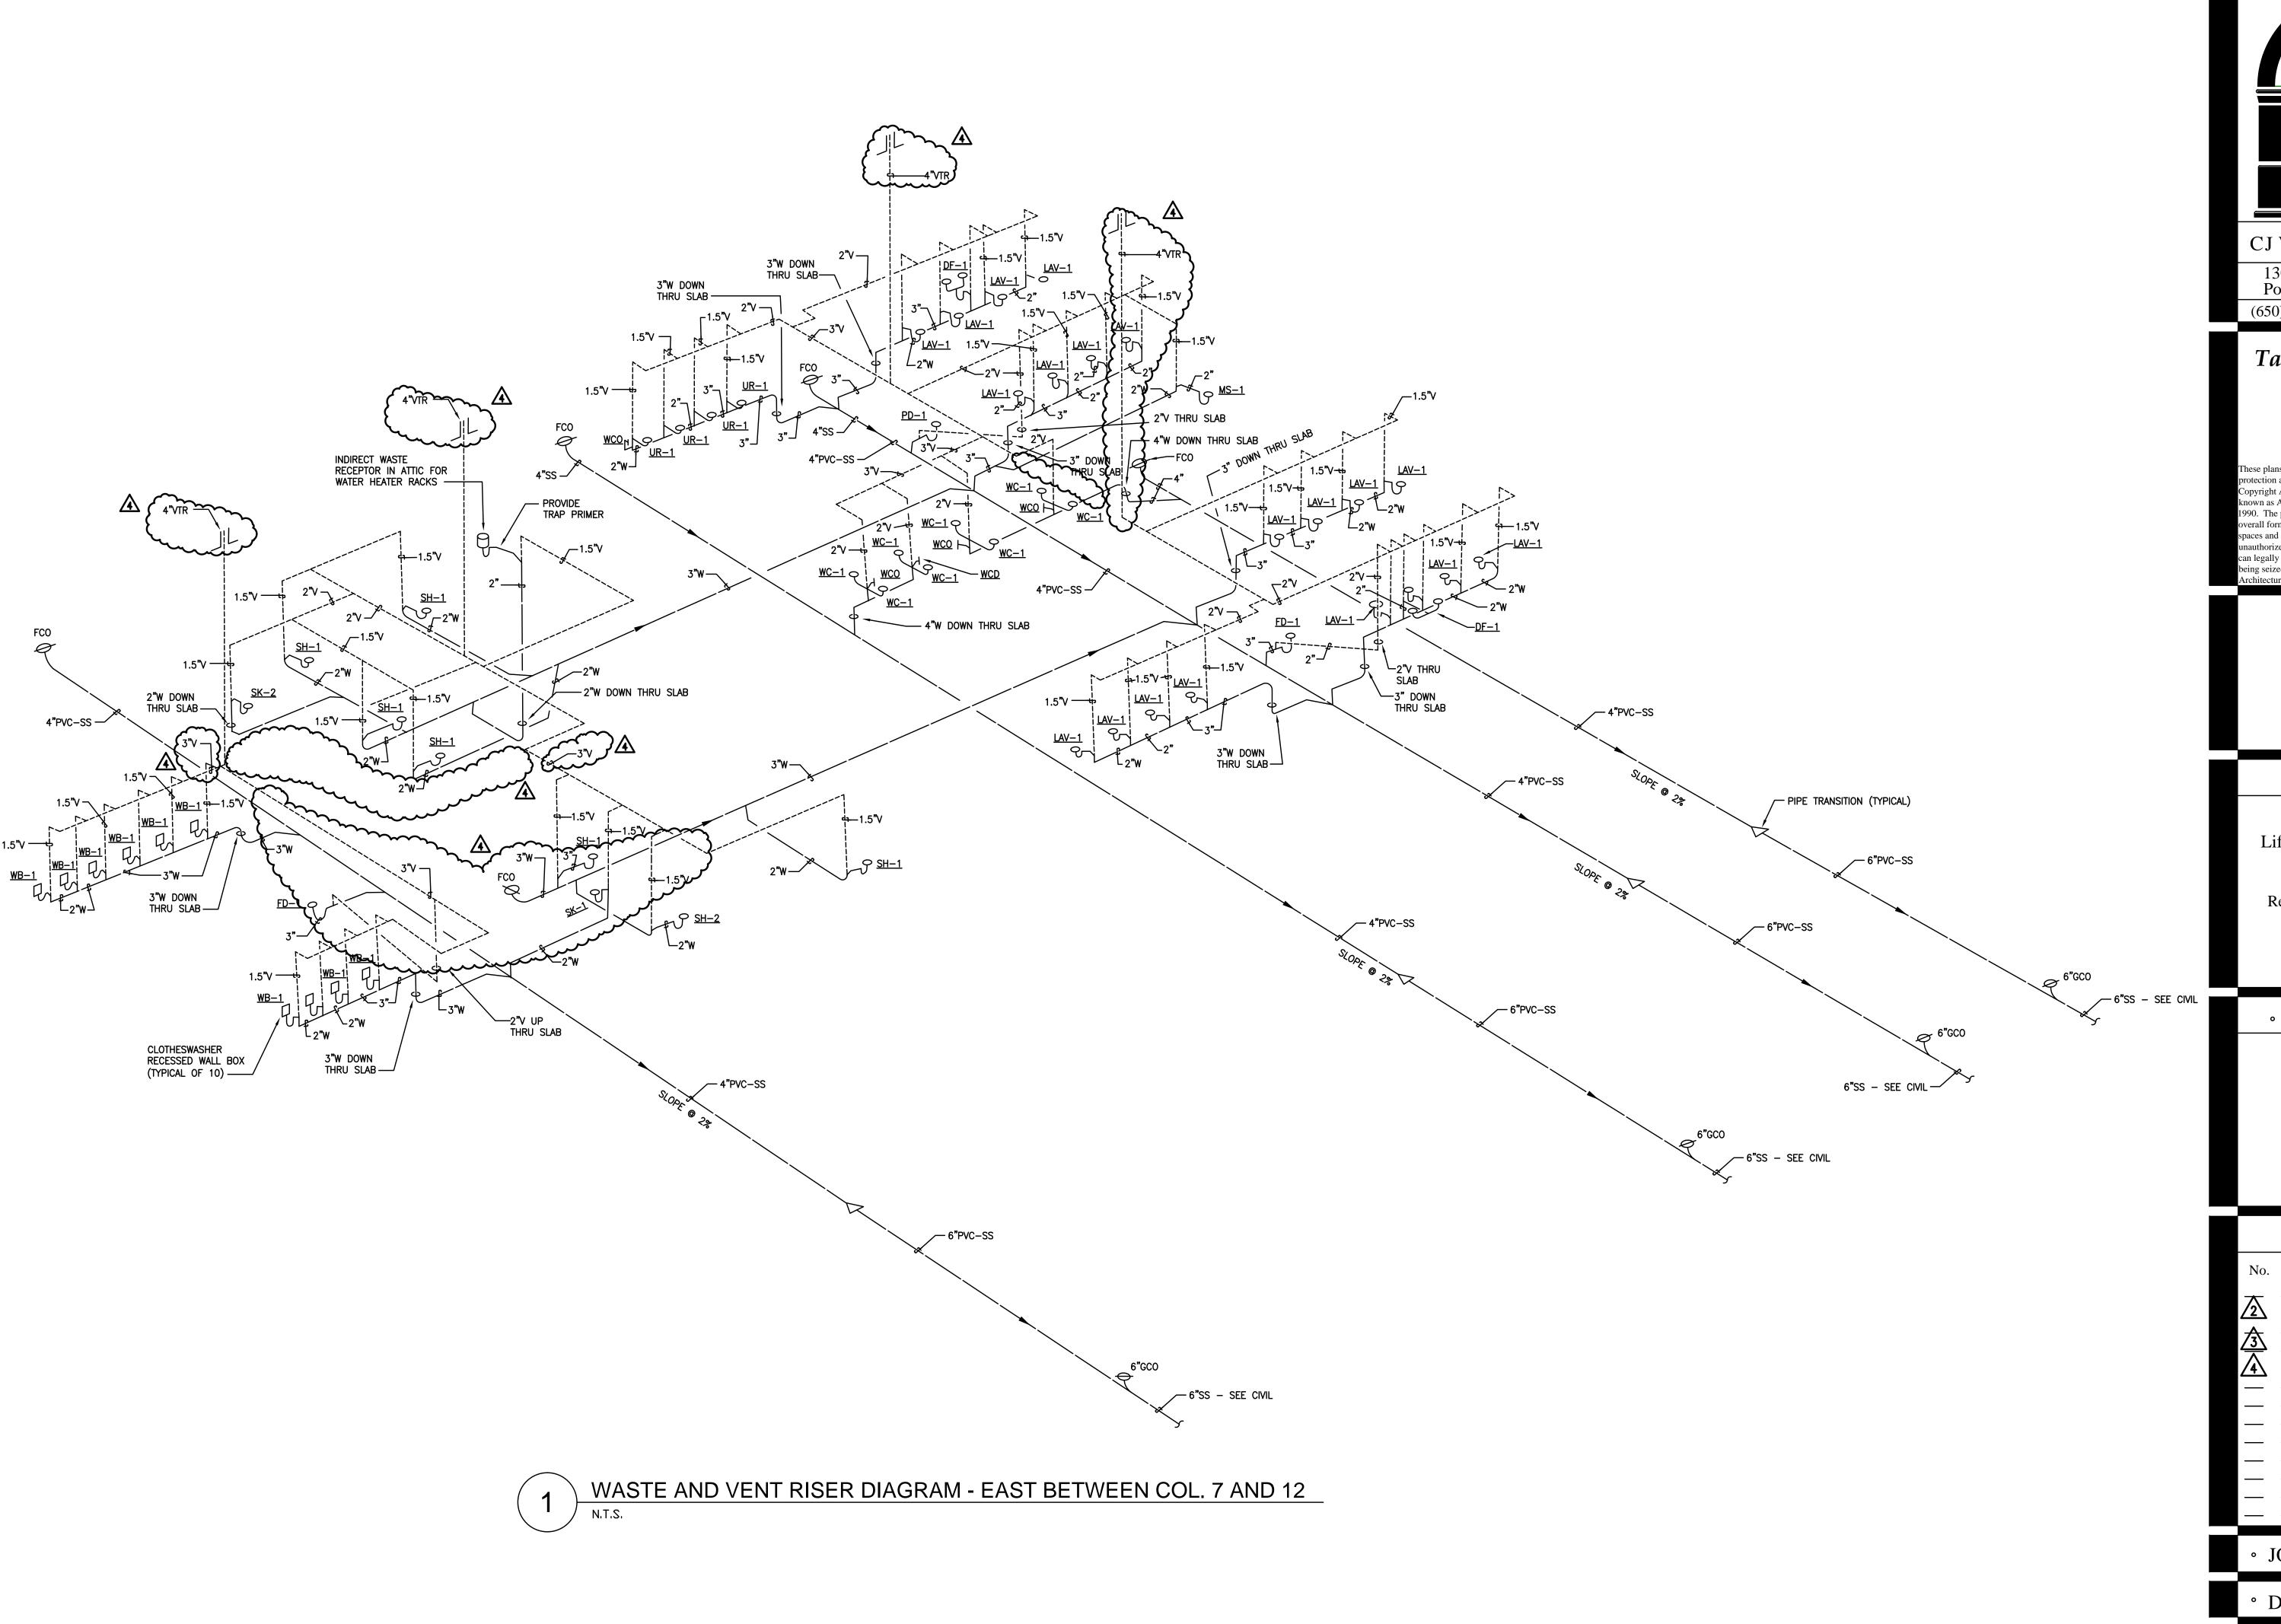

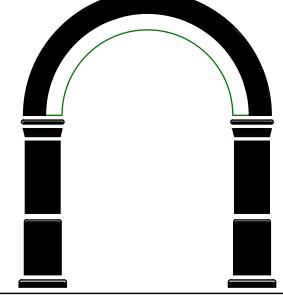

CJ W ARCHITECTURE

130 Portola Road, suite A Portola Valley, CA 94028


(650) 851-9335 / (Fax) 851-9337

## Tantech Engineers MEP CONSULTING

ENGINEERS

1431 Cedar Street
San Carlos, CA 94070
(415) 269-4283

These plans are copyrighted and are subject to copyright protection as an "architectural work" under Sec. 102 of the Copyright Act, 17 U.S.O. as amended December 1990 and known as Architectural Works Copyright Protection Act of 1990. The protection includes but is not limited to the overall form as well as the arrangement and composition of spaces and elements of the design. Under such protection, unauthorized use of these plans, work or home represented, can legally result in the cessation of construction or building being seized and /or monetary compensation to CJW Architecture.

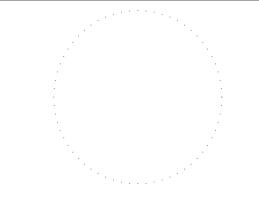

#### • PROJECT •

LifeMoves Maple Street Shelter 1580 Maple Street Redwood City CA 94063

#### • SHEET TITLE •

HW AND CW RISER DIAGRAM


•	KE'	V 13	10	1/2


No.	Date	Notes
	6.17.16	BLDG SUBMITTAI
2	8.15.16	PLAN CHECK # 1 ADDENDUM # 3
<u> </u>	8.25.16	ADDENDUM # 5
4	9.23.16	PLAN CHECK #2 ADDENDUM # 6

• JOB: 2015.2801

° DATE: 06/17/16

• SHEET: **P3.7** 

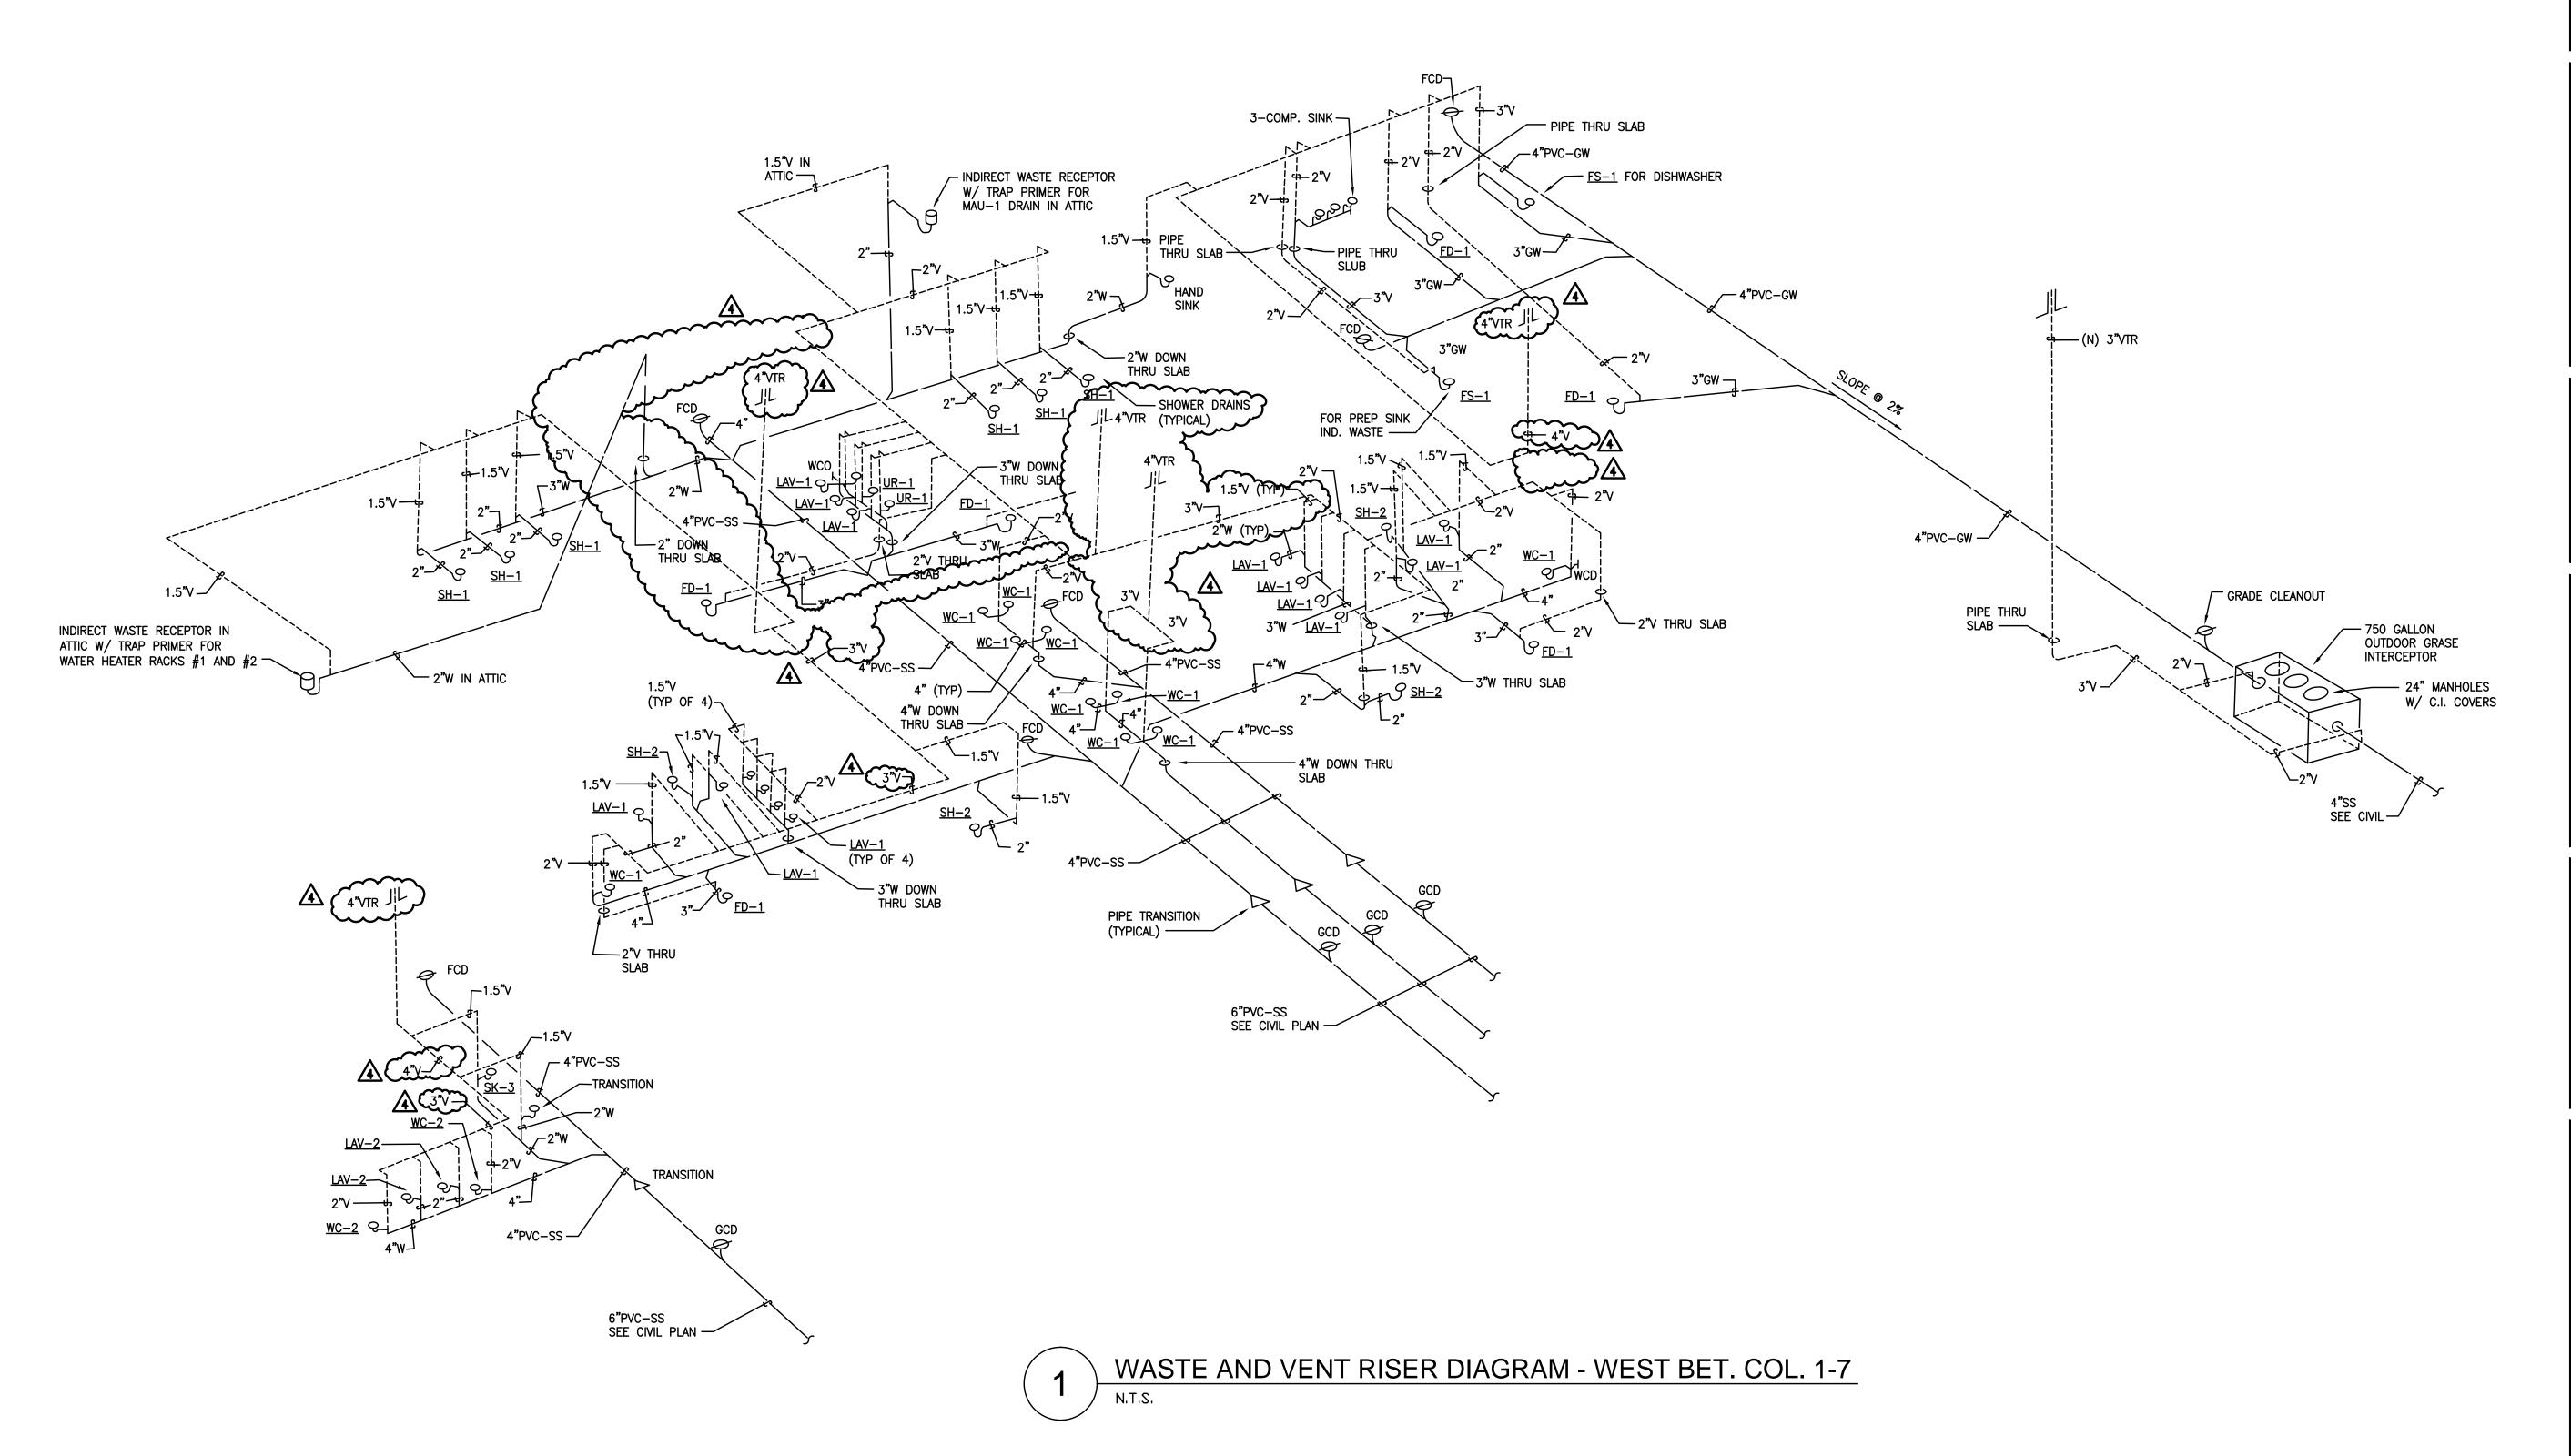

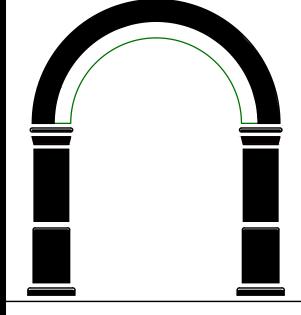

#### CJ W ARCHITECTURE


130 Portola Road, suite A Portola Valley, CA 94028

(650) 851-9335 / (Fax) 851-9337

# Tantech Engineers MEP CONSULTING ENGINEERS 1431 Cedar Street

1431 Cedar Street San Carlos, CA 94070 (415) 269-4283

These plans are copyrighted and are subject to copyright protection as an "architectural work" under Sec. 102 of the Copyright Act, 17 U.S.O. as amended December 1990 and known as Architectural Works Copyright Protection Act of 1990. The protection includes but is not limited to the overall form as well as the arrangement and composition of spaces and elements of the design. Under such protection, unauthorized use of these plans, work or home represented, can legally result in the cessation of construction or building being seized and /or monetary compensation to CJW Architecture.

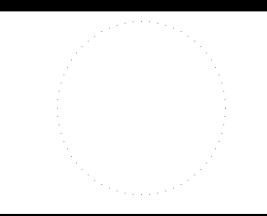

#### • PROJECT •

LifeMoves Maple Street Shelter 1580 Maple Street Redwood City CA 94063

#### • SHEET TITLE •

HW AND CW RISER DIAGRAM


<ul> <li>REVISIONS</li> </ul>
-------------------------------

No.	Date 6.17.16	Notes BLDG SUBMITTAL
2	8.15.16	PLAN CHECK # 1 ADDENDUM # 3
<u> </u>	8.25.16	ADDENDUM # 5
4	9.23.16	PLAN CHECK #2 ADDENDUM # 6

• JOB: 2015.2801


° DATE: 06/17/16

• SHEET: **P3.8** 

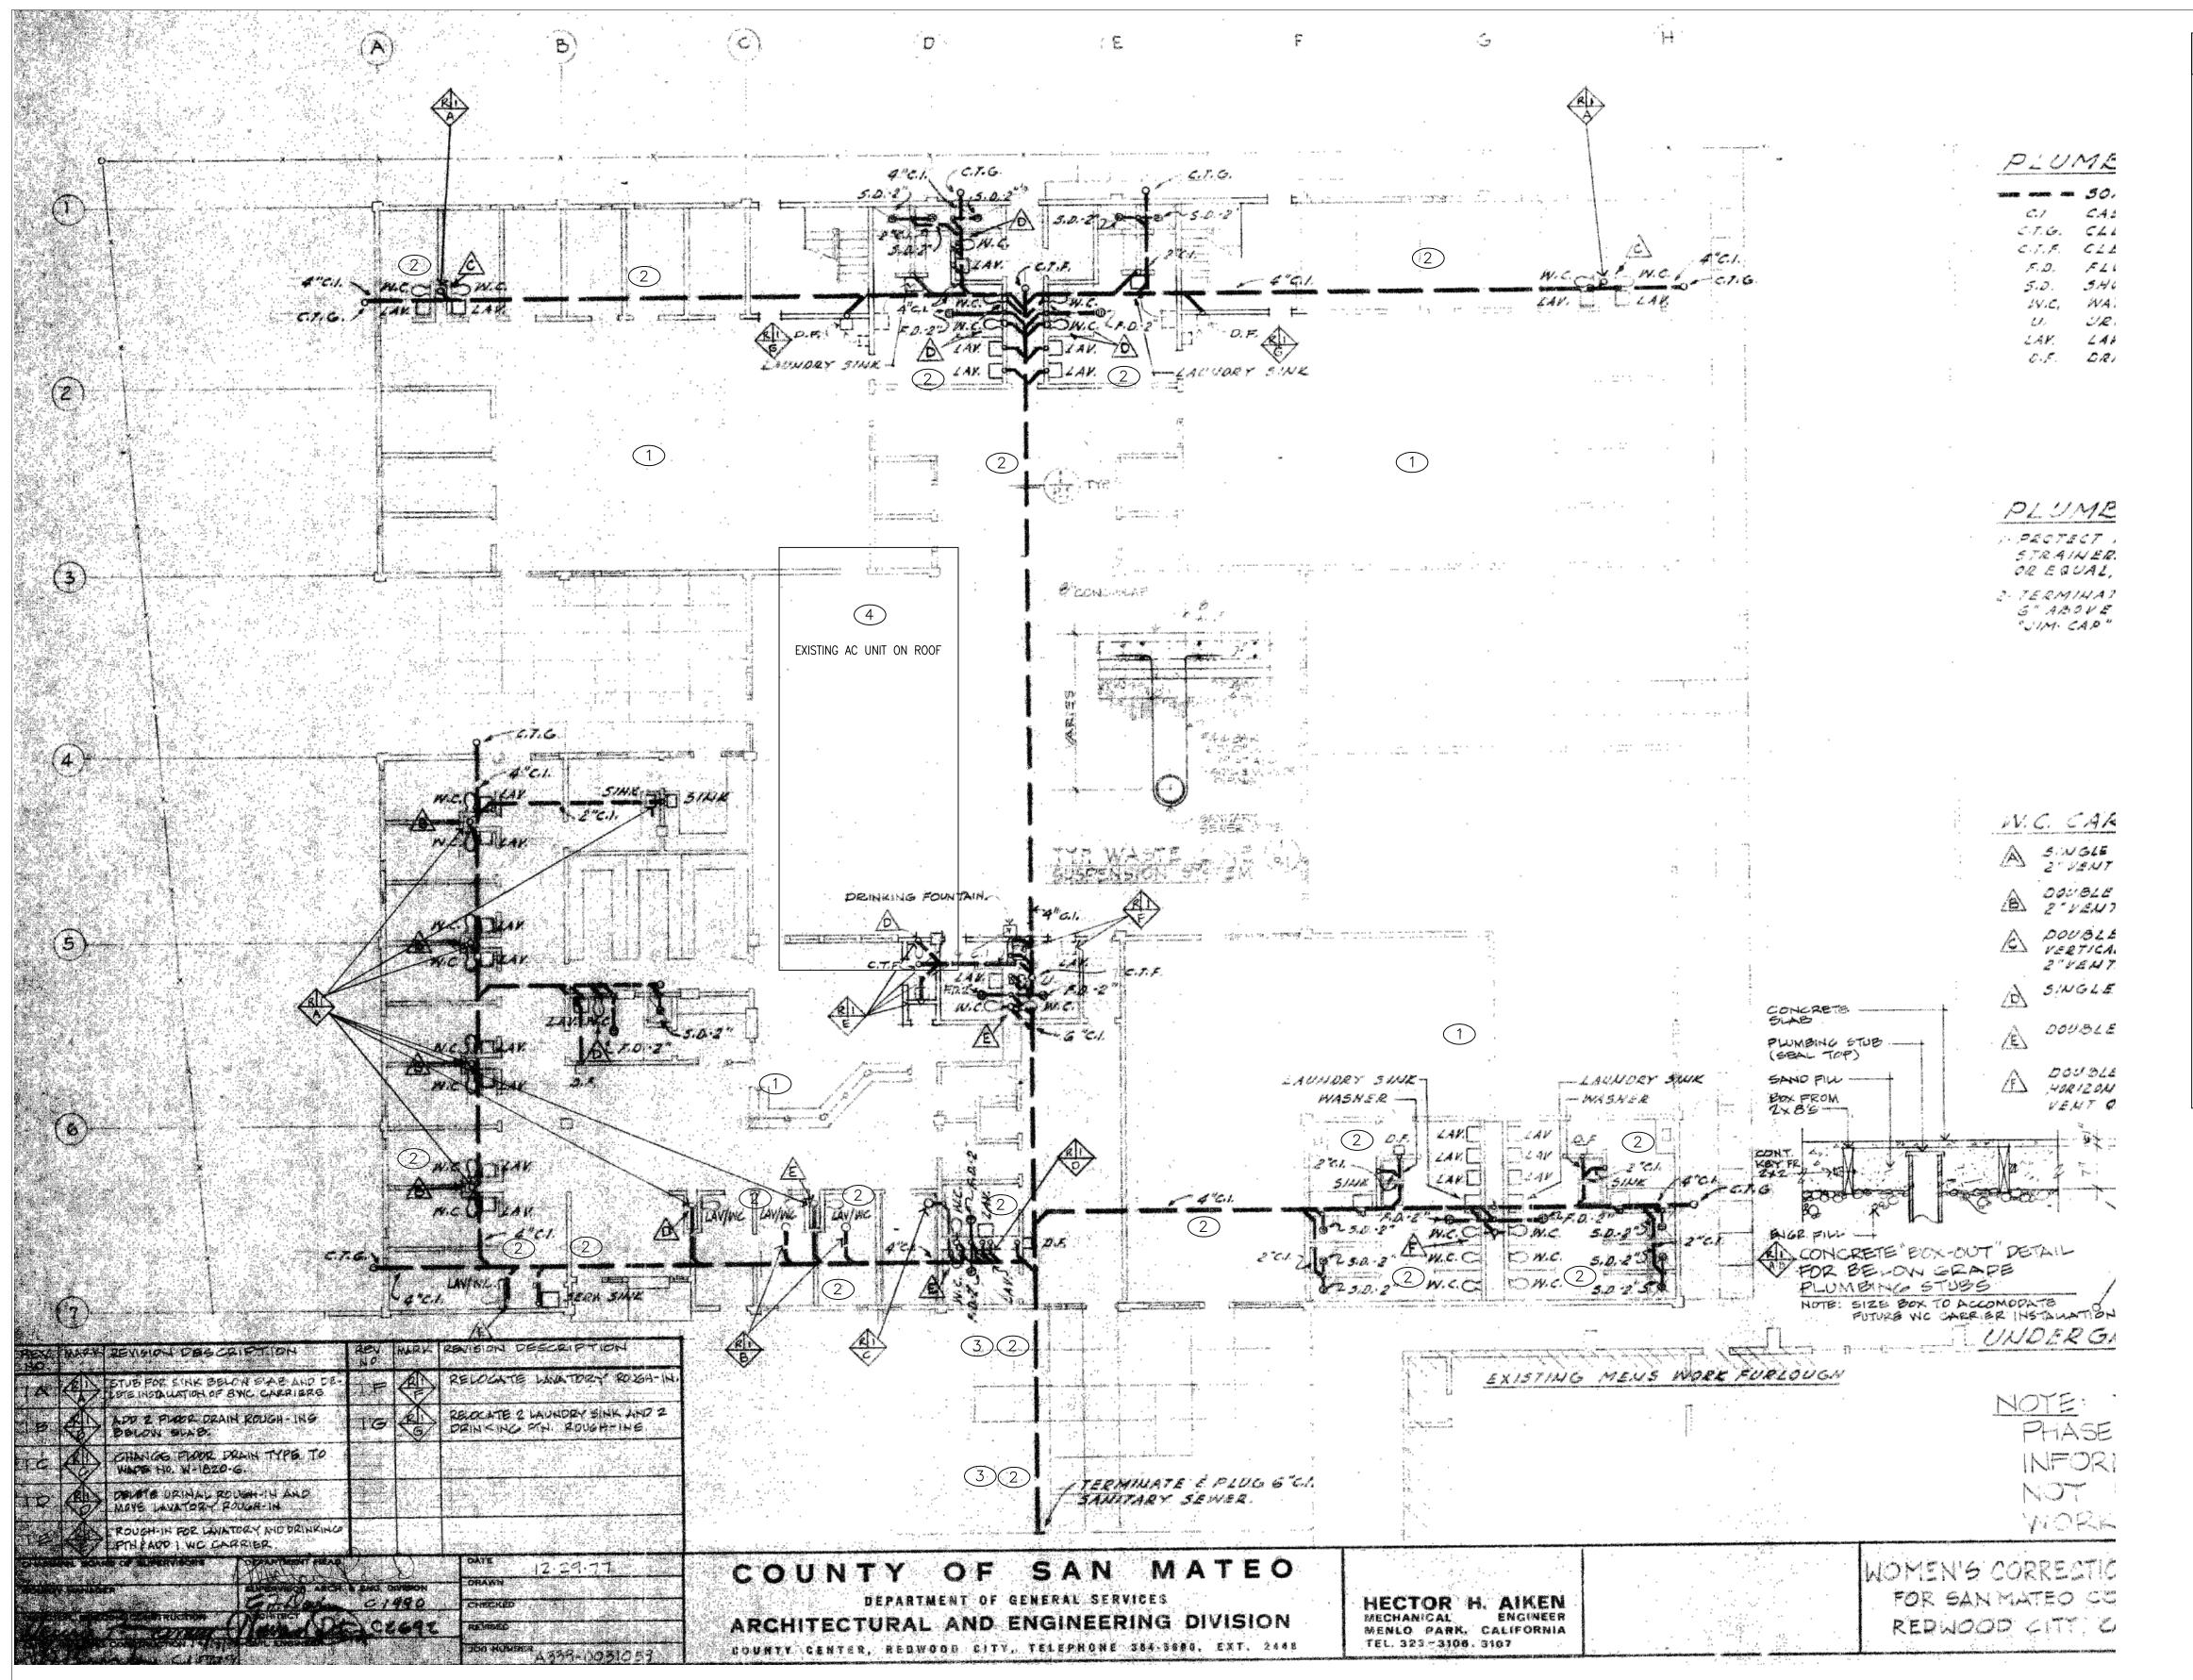

#### **KEYED SHEET NOTES:**

- THE PLAN SHOWN ON THIS SHEET IS TAKEN FROM AVAILABLE RECORD DRAWINGS DATE 1977 FOR THE EXISTING WOMEN'S JAIL BUILDING WHICH SHALL BE DEMOLISHED AS PAOF PHASE ONE OF THIS PROJECT. THE CONTRACTOR SHALL PERFORM THE NECESSARY SITE VISITS TO FIELD VERIFY EXISTING CONDITIONS AND SHALL NOT RELY ON THIS DRAWING FOR 100% ACCURATE AS BUILT CONDITIONS.
- THE CONTRACTOR SHALL DEMOLISH AND REMOVE ALL EXISTING PLUMBING SYSTEMS INSIDE THE BUILDING ABOVE THE SLAB AND BELOW THE SLAB INCLUDING SANITARY WASTE AND VENT SYSTEMS, HOT AND COLD WATER SYSTEMS, WATER HEATERS, BOILERS, GAS PIPING, INDIRECT WASTE SYSTEMS, PLUMBING FIXTURES, PIPING SUPPORTS PIPING INSULATION. AND ASSOCIATED APPURTENANCES.
- THE CONTRACTOR SHALL DEMOLISH AND REMOVE ALL EXISTING PLUMBING UNDERGROUND SITE UTILITIES TO THE BUILDING INCLUDING SEWER LINES, WATER LINES, WATER METER, STORM DRAIN LINES, AND GAS LINES. VERIFY CONDITIONS IN FIELD. REFER TO SHEET
- THE MECHANICAL AND GENERAL CONTRACTOR SHALL DEMOLISH AND REMOVE AND DISPOSE OF EXISTING ROOFTOP AC UNIT. THE WORK WILL INVOLVE CRANE REMOVAL AND REFRIGERANT SYSTEM EVACUATION FOR THE PACKAGE UNIT. VERIFY CONDITIONS IN FIELD.
- THE CONTRACTOR SHALL DEMOLISH AND REMOVE AND DISPOSE OF EXISTING ROOFTOP SOLAR WATER HEATING PANELS, NOT SHOWN ON THIS PLAN. THE WORK WILL ALSO INCLUDE DEMOLITION OF EXISTING SOLAR HOT WATER PIPING DISTRIBUTION SYSTEMS TO THE SHELTER BUILDING (ABOVE ROOF), THE EXISTING PIPING DISTRIBUTION TO THE MODULAR WORK FURLOUGH BUILDING (ABOVE ROOF AND UNDERGROUND) AND THE EXISTING SOLAR HW STORAGE TANK ON CONCRETE PAD ON SITE, AND ASSOCIATED SUPPORTS, PUMPS, CONTROLS, AND PIPE INSULATION. REFER TO SHEET JDP-2.

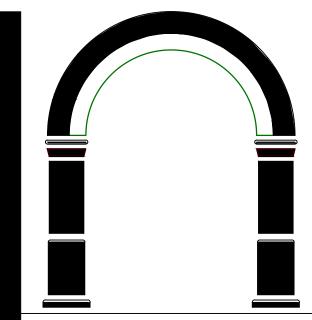

CJ W ARCHITECTURE

130 Portola Road, suite A Portola Valley, CA 94028

(650) 851-9335 / (Fax) 851-9337

#### Tantech Engineers

MEP CONSULTING

ENGINEERS

1431 Cedar Street
San Carlos, CA 94070
(415) 269-4283

These plans are copyrighted and are subject to copyright rotection as an "architectural work" under Sec. 102 of the Copyright Act, 17 U.S.O. as amended December 1990 and nown as Architectural Works Copyright Protection Act of 1990. The protection includes but is not limited to the everall form as well as the arrangement and composition of paces and elements of the design. Under such protection, nauthorized use of these plans, work or home represented, an legally result in the cessation of construction or building eing seized and /or monetary compensation to CJW architecture.

#### • PROJECT •

LifeMoves Maple Street Shelter 1580 Maple Street Redwood City CA 94063

SHEET TITLE

Jail Building Plumbing Plan -Demolition Work

	• REV	ISIONS •
No.	Date 6.17.16	Notes BLDG SUBMITTAL 1
2	8.15.16	PLAN CHECK # 1 ADDENDUM # 3
<u>3</u>	8.25.16	ADDENDUM # 5
4	9.23.16	PLAN CHECK #2 ADDENDUM # 6
_		

JOB: 2015.2801


° DATE: 06/17/16

• SHEET: UDP-1




NOT TO SCA



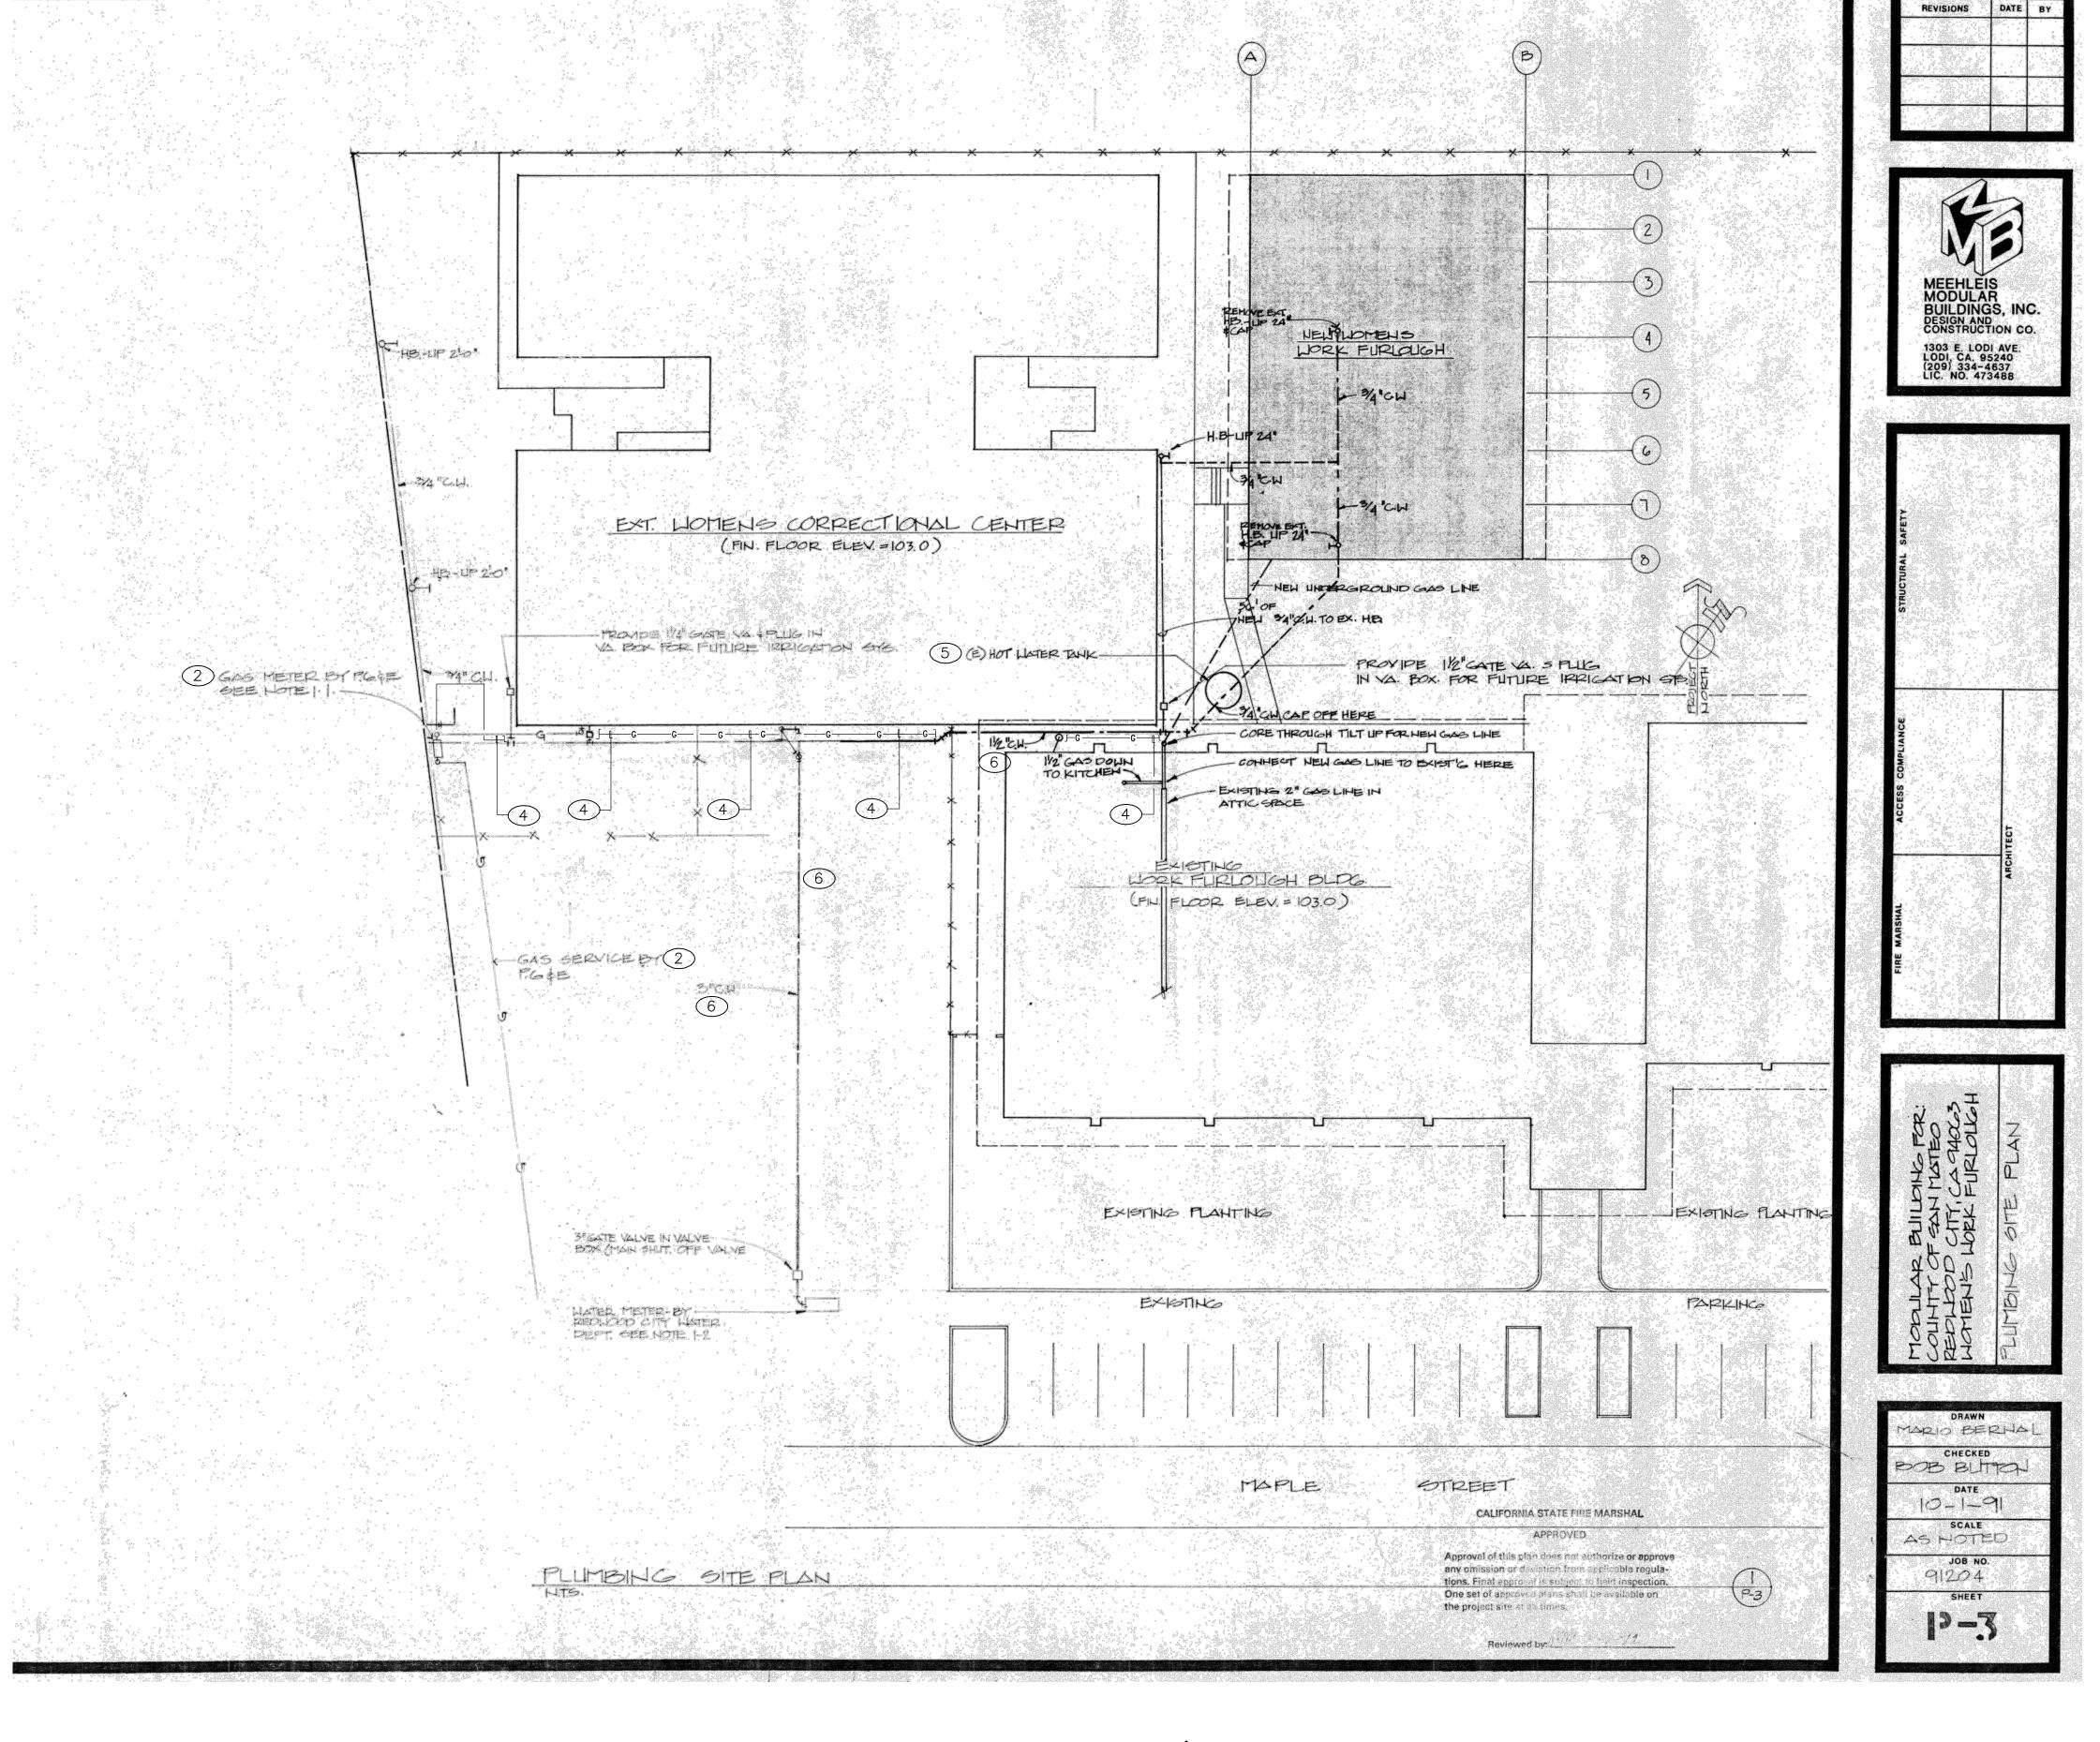



- THE PLAN SHOWN ON THIS SHEET IS TAKEN FROM AVAILABLE RECORD DRAWINGS DATED 1991 FOR THE EXISTING MODULAR WORK FURLOUGH BUILDING WHICH SHALL REMAIN. THE CONTRACTOR SHALL PERFORM THE NECESSARY SITE VISITS TO FIELD VERIFY EXISTING CONDITIONS AND SHALL NOT RELY ON THIS DRAWING FOR 100% ACCURATE AS BUILT CONDITIONS. ISSUED FOR REFERENCE ONLY.
- THE CONTRACTOR SHALL DEMOLISH AND REMOVE 2—INCH GAS LINE FROM WOMENS JAIL BUILDING SERVING THE MODULAR WORK FURLOUGH BUILDING FROM THE RISER AT WOMENS JAIL BUILDING TO THE GAS METER MANIFOLD AREA. THE EXISTING GAS METER, WHICH SERVES THE WOMENS JAIL BLDG AND THE WOMEN'S JAIL BUILDING, SHALL REMAIN. THE EXISTING UNDERGROUND 2—INCH BRANCH GAS LINE FROM GAS METER TO WOMENS JAIL BUILDING SHALL BE DEMOLISHED, REMOVED, AND CAPPED OFF AT MANIFOLD. SEE SHEET SE—2 FOR EXISTING GAS LINES.
- THE EXISTING 2—INCH EXISTING UNDERGROUND 2—INCH BRANCH GAS LINE FROM GAS METER TO WOMENS JAIL BUILDING ROOF, WHICH SERVES WORK FURLOUGH BUILDING, SHALL BE PARTIALLY DEMOLISHED AND REMOVED. THIS SHALL OCCUR AS PART OF PHASE ONE FOR PROJECT. SEE SHEET SE—2 FOR EXISTING GAS LINES.
- AT THE END OF PHASE 1B OF PROJECT, THE CONTRACTOR SHALL RECONNECT THE MODULAR WORK FURLOUGH BLDG TO THE EXISTING GAS METER AND MANIFOLD WITH NEW 2-INCH UNDERGROUND GAS LINE AND THIS SHALL INTERCEPT THE EXISTING GAS LINE CLOSE TO MODULAR WORK FURLOUGH BLDG VERIFY LOCATION IN FIELD.
- 5 DEMOLISH AND REMOVE EXISTING SOLAR HW STORAGE TANK ON SITE REFER TO SHEET
- THE CONTRACTOR SHALL VERIFY SOURCE OF DOMESTIC WATER SERVICE TO THE EXISTING MODULAR WORK FURLOUGH BLDG. THE SERVICE SHALL REMAIN INTACT. IF THE EXISTING 3-INCH MAIN SERVING THE WOMEN'S JAIL BLDG IS ALSO SERVING THE WORK FURLOUGH MODULAR BLDG, THEN THE UNDERGROUND LINE AND EXISTING WATER METER SHALL REMAIN IN SERVICE.

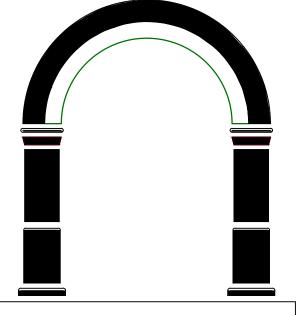

CJ W ARCHITECTURE

130 Portola Road, suite A Portola Valley, CA 94028

(650) 851-9335 / (Fax) 851-9337

### Tantech Engineers

MEP CONSULTING ENGINEERS 1431 Cedar Street San Carlos, CA 94070

(415) 269-4283

These plans are copyrighted and are subject to copyright protection as an "architectural work" under Sec. 102 of the Copyright Act, 17 U.S.O. as amended December 1990 and known as Architectural Works Copyright Protection Act of 1990. The protection includes but is not limited to the overall form as well as the arrangement and composition of spaces and elements of the design. Under such protection, anauthorized use of these plans, work or home represented, can legally result in the cessation of construction or building being seized and /or monetary compensation to CJW Architecture

• PROJECT •

LifeMoves Maple Street Shelter 1580 Maple Street Redwood City CA 94063

SHEET TITLE

Modular Work Furlough Bldg Plumbing Site Plan -Demolition

• REVISIO	ONS
-----------	-----

Notes

6.17.16 BLDG SUBMITTAL 1

8.15.16 PLAN CHECK # 1
ADDENDUM # 3

8.25.16 ADDENDUM # 5

PLAN CHECK #2
ADDENDUM # 6

• JOB: 2015.2801

° DATE: 06/17/16

• SHEET: {JDP-2}





#### → GENERAL NOTES RE: ALL ELECTRICAL SHEETS

- A. ALL ELECTRICAL EQUIPMENT SHALL BE CERTIFIED AND LISTED BY UL OR OTHER NATIONALLY ACCREDITED AGENCIES. ANY EQUIPMENT NOT LISTED SHALL BE FIELD TESTED AND CERTIFIED BY AN APPROVED TESTING AGENCY. PROJECT OWNER AND HIS DESIGN/CONSTRUCTION TEAM SHALL NOTIFY THE BUILDING DEPARTMENT AND ARRANGE FIELD TEST AND CERTIFICATION OF UNLISTED EQUIPMENT PRIOR TO REQUESTING FINAL INSPECTION BY THE BUILDING INSPECTOR.
- B. TYPICAL CIRCUIT WIRING FROM THE PANELS SHALL BE THHN/THWN COPPER 75 DEGREE WIRE IN EMT CONDUIT. REFER TO SPEC 16000, EMT CONDUIT SHALL BE SUPPORTED AT 10'-0" ON CENTER AND WITHIN 3"-0" OF EACH JUNCTION.
- C. UNDERGROUND CONDUIT STUB-UPS:
- 1.STUB-UP AND CAP UNDERSLAB CONDUITS AT 6" ABOVE FINISHED FLOOR.
- 2.VERIFY EXACT LOCATIONS OF ALL OUTLETS WITH ARCHITECT AND OWNER PRIOR TO ROUGH-IN. 3.CONDUIT STUB-UPS AT EQUIPMENT SHALL BE PROVIDED WITH AN APPROVED GROUNDING HUB OR LUG.
- 4.CONDUIT STUB-UPS AT WALLS SHALL BE A MAXIMUM OF 3" CLEAR OF PROPOSED WALL LOCATIONS.
- 5.CONDUIT STUB-UPS WITHIN PROPOSED WALLS SHALL BE CENTERED WITHIN WALL SPACE. 6.PROVIDE A PERMANENT LABEL AT ALL STUB-UPS INDICATING LOCATION OF STUB-OUT OR TERMINATION AT THE OTHER END. PROVIDE LABEL AT BOTH ENDS OF CONDUIT RUN. PROVIDE PULL ROPE IN ALL EMPTY CONDUITS.
- 7.WRAP ALL METAL PORTIONS OF RIGID GALVANIZED STEEL CONDUIT RISERS WITH CORROSIVE RESISTANCE TAPE WHERE EXTENDED BELOW GRADE. PROVIDE SCOTCH #50 TAPE OR APPROVED EQUIVALENT.
- D. VERIFY LOCATION OF OUTLETS AND SWITCHES IN FINISHED ROOMS WITH ARCHITECTURAL DRAWINGS OF INTERIOR DETAILS AND FINISH. WHEN CENTERING OUTLETS AND LOCATING BOXES AND OUTLETS, ALLOW FOR OVERHEAD PIPES, DUCTS AND MECHANICAL EQUIPMENT, VARIATIONS IN FIREPROOFING AND PLASTERING, WINDOW AND DOOR TRIM, PANELING, SUSPENDED CEILINGS AND THE LIKE. CORRECT ANY INACCURACY RESULTING FROM FAILURE TO DO SO WITHOUT ANY EXPENSE TO OWNER.
- E. THIS SHEET INDICATES A STANDARD LEGEND SHEET. SOME SYMBOLS OR ABBREVIATIONS MAY APPEAR ON THIS SHEET, AND NOT ON THE PROJECT DRAWINGS.
- F. LINES OR OTHER SERVICES THAT ARE DAMAGED AS A RESULT OF THIS WORK SHALL PROMPTLY BE REPAIRED AT NO EXPENSE TO THE OWNER AND LANDLORD AND TO THE COMPLETE SATISFACTION OF THE OWNER AND LANDLORD.
- G. REFER TO SPECIFICATION SECTION FOR SEISMIC BRACING OF NON-STRUCTURAL ELEMENTS.
- H. REFER TO SPECIFICATION SECTION FOR THE PREPARATION AND SUBMITTAL REQUIREMENTS OF
- I. ALL ELECTRICAL WORK SHALL COMPLY WITH THE 2011 NATIONAL ELECTRICAL CODE AS AMENDED BY THE 2013 CALIFORNIA ELECTRICAL CODE.
- J. ALL PANELBOARDS WITH BRANCH CIRCUITS SERVING THE SAME VICINITY SHALL BE BONDED TOGETHER WITH MINIMUM #10 INSULATED CONTINUOUS COPPER CONDUCTOR WHERE MORE THAN TWO PANELS SERVE THE SAME LOCATION PER 517-14.
- . PLANS ARE PREPARED WITH REQUIRED BRANCH CIRCUITS INDICATED BY CIRCUIT NUMBER. PROVIDE AND OPERABLE SYSTEM INCLUDING HOME RUN (WHETHER OR NOT SHOWN). BRANCH CIRCUIT INSTALLATION SHALL COMPLY WITH SPECIFICATIONS AND N.E.C. (2011). PROVIDE #10 WIRE FOR 120 VOLT CIRCUIT RUNS OVER
- THE UNGROUNDED AND NEUTRAL CONDUCTORS OF A MULTI WIRE BRANCH CIRCUIT MUST BE GROUP TOGETHER IN ATLEAST ONE LOCATION BY WIRE TIES OR SIMILAR MEANS AT THE POINT OF ORIGINATION PER NEC 210.4.
- M. EACH MULTI WIRE BRANCH CIRCUIT SHALL BE PROVIDED WITH MEANS THAT WILL SIMULTANEOUSLY DISCONNECT ALL UNGROCOMUDEDICTICORSDUBICIÓRS, ATISTIHELPROPOTUS VHIETIEN GELE HETRANICOER CARCONIPORTIGINANTES PER 210.4B.

#### OUTLETS:

- 1. ALL BATHROOM, OUTDOOR, GARAGE RECEPTACLES, LAUNDRY AND KITCHEN COUNTER RECEPTACLES WITHIN SIX FEET OF A SINK ARE TO BE GFCI PROTECTED.
- 2. WALL MOUNTED OUTLETS DRAWN IN A LINE, OUT FROM THE WALL, SHALL BE CENTERED ABOVE EACH OTHER, AT SCHEDULED HEIGHTS. MOUNT ALL BOXES ON SAME SIDE OF STUD. USE BAR HANGERS OR SCRAP BLOCKS TO CENTER THE BOXES TO EACH OTHER.
- 3. ELECTRICAL OUTLETS LOCATED ON OPPOSITE SIDES OF ALL FIRE-RATED PARTY WALLS SHALL BE SEPARATED BY A HORIZONTAL DISTANCE OF AT LEAST 24 INCHES.
- 4. WHEN KITCHEN OR BATH OUTLETS AT PARTY WALLS CANNOT BE MOVED TO THE NEXT STUD BAY, FILL THE STUD BAY (OR PORTION OF) WITH FIRE RETARDANT MATERIAL SATISFACTORY TO LOCAL BUILDING / FIRE INSPECTION.
- 5. PROVIDE A W.P. RECEPTACLE NO FARTHER THAN 25 FEET FROM ANY OUTDOOR EQUIPMENT. SIMILARLY,
- PROVIDE A STANDARD RECEPTACLE FOR EQUIPMENT IN ATTICS OR MECHANICAL ROOMS.
- 6. PROVIDE DISCONNECTING MEANS FOR ALL EQUIPMENT REQUIRING SUCH.
- 7. OUTLET BOXES LOCATED IN 1 HOUR RATED WALLS AND CEILINGS SHALL BE STEEL OR 1 HOUR FIRE RATED PLASTIC AND SHALL HAVE ANNULAR SPACE SEALED WITH 1 HR RATED FIRE STOPPING. PER NEC 300-21 AND UBC-709, 710.
- 8. ALL PLASTIC CONDUIT OR CABLE IN 1 HR WALLS SHALL HAVE A F RATING.
- 9. ALL DUPLEX RECEPTACLES IN ALL INHABITABLE ROOMS SHALL BE PROTECTED WITH ARC-FAULT CIRCUIT INTERRUPTERS PER CEC 210-12 AND SHALL BE TAMPERPROOF WHERE REQUIRED BY CEC 406.10.

#### LIGHTING:

- 1. ALL WALL MOUNTED FIXTURES ARE TO BE LOCATED AT HEIGHTS ESTABLISHED BY ARCHITECT. HEIGHTS ARE TO BE SET AFTER SUBMITTALS ARE APPROVED. (FINAL FIXTURES SIZES ARE KNOWN.)
- 2. ALL SITE AND BUILDING EXTERIOR FIXTURES ARE TO BE CONTROLLED BY A TIME SWITCH THAT HAS A PHOTOCELL
- OVERRIDE. EACH FIXTURE TYPE SHALL BE PROVIDED A TIME SWITCH POLE. TIME SWITCH POLES CAN BE COMBINED AT HOUSE PANEL CIRCUITS TO FILL AND BALANCE CIRCUITS. ALLOW ONE SPARE TIME SWITCH POLE PER PANEL.

#### COMMISIONING AND ACCEPTANCE TESTING:

THE CONTRACTOR SHALL ENGAGE A PROFESSIONAL COMMISSIONING THIRD PARTY AGENT OR CONSULTANT, CERTIFIED TO PERFORM THE MEP SYSTEMS COMMISSIONING AND TO PROVIDE A REPORT FOR ALL FUNCTIONAL PEFORMANCE TESTS COMPLETED AS PART OF THE ACCEPTANCE TEST PROCESS. THE LIGHTING CONTROLS ACCEPTANCE TEST TECHNICIANS SHALL BE CERTIFIED THRU AN APPROVED TRAINING PROGRAM, AND REGISTERED WITHIN THE STATE OF CALIFORNIA. BUILDING COMMISSIONING REQUIREMENTS SHALL BE MET AS OUTLINED IN THE 2013 TITLE 24 STANDARDS, SECTION 120.8. THE FOLLOWING SYSTEMS MUST UNDERGO ACCEPTANCE TESTING:

- 1. AUTOMATIC DAYLIGHTING CONTROLS 2. AUTOMATIC TIME SWITCH CONTROLS
- 3. OCCUPANCY SENSORS 4. OUTDOOR LIGHTING SHUTOFF CONTROLS
- 5. OUTDOOR MOTION SENSORS 6. MULTILEVEL DIMMING COTNROLS
- 7. PLUG LOAD CONTROLLERS 8. DEMAND RESPONSE (DR) CONTROLS
- DEMAND RESPONSE LIGHTING CONTROLS:

THE FACILITY MUST BE ABLE TO RESPOND TO A DEMAND RESPONSE SIGNAL FROM THE LOCAL UTILITY OR OTHER ENTITY SO THAT TOTL ENERGY USE FOR LIGHTING CAN DROP TO A LEVEL AT LEAST 15% BELOW BUILDING'S MAXIMUM TOTAL LIGHTING POWER. THE LIGHTING AUTOMATED CONTROLS SHALL BE COMPATIBLE WITH THE LOCAL UTILITY'S DR PROTOCOL, AND LIGHTING SHALL BE REDUCED IN A MANNER CONSISTENT WITH UNIFORM ILLUMINATION LEVELS AS LISTED IN THE TITLE 24 STANDARDS, TABLE 130-A.

## 1LEGEND AND ABBREVIATIONS 1

SYMBOL	: ALL ELECTRICAL SHEETS					
31MBOL	DESCRIPTION		SYMBOL	DESCRIPTION	SYMBOL	DESCRIPTION
SIGNAL			EQUIPMENT	·	OUTLETS	
DI I	TELEPHONE OUTLET: +18" AFF U.O.N.		LQOII WILINI	PANELBOARD / TERMINAL CABINET — SEE SCHEDULE	⊕ ⊕	RECEPTACLE: DUPLEX 20 AMP, 3WG,125V, NEMA 5-20R
N	DATA OUTLET: +18" AFF U.O.N. (SINGLE, DOUBLE)	$\dashv$	_	PANELBOARD — SEE SCHEDULE		RECEPTACLE: DUPLEX 20 AMP, 3WG,125V, NEMA 5-20R WALL MOUNTED +18" AFF U.O.N. (FOR RECEPTACLES SERVING EQUIPMENT, REFER TO EQUIPMENT SCHEDULE, FOR OUTLETS
₽	TELEPHONE/DATA OUTLETS IN SAME OUTLET BOX			TERMINAL CABINET, SURFACE MOUNTED SIZE & TYPE AS NOTED		ABOVE COUNTER, VERIFY MNTG HEIGHT)
₩	TELEVISION OUTLET: +18" AFF U.O.N.			MAIN SWITCHBOARD OR MOTOR CONTROL CENTER,		AC CO DUT A DIEV
DS	MAGNETIC DOOR SWITCH			SEE ONE LINE DIAGRAM		AS   BUT 4−PLEX
			<u> </u>	TELEPHONE TERMINAL BOARD: 4' x 8' x 3/4" PLYWOOD OR AS NOTED w/ DOUBLE DUPLEX RECEPT. & 1 #6 GND	€	AS  BUT GROUND FAULT PROTECTIVE. (SUFFIX C: INDICATES ABOVE COUNTER OR SINK — VERIFY HEIGHT; D: DEDICATED)
SINGLE LINE	E DIAGRAM		\D\	MOTOR, N.I.E.S. CONNECT AS REQ., NUMBER INDICATES HP	$\bigcirc$	120V OR 240V SPECIAL APPLIANCE OR EQUIPMENT RECEPTACLE
M	METER SOCKET		X	DETAIL DESIGNATION; TOP NUMBER INDICATES DETAIL,		(VERIFY FOR NEMA TYPE AND EXACT LOCATION)
<b>₹</b> M	TRANSFORMER RATED METER SOCKET AND CT		XX	BOTTOM LETTER/NUMBER INDICATES SHEET	Ю	JUNCTION BOX, WALL MOUNTED/RECESSED, TYPE AS REQ'D.
—N—	NEUTRAL BUS		AC _	MECHANICAL AND PLUMBING EQUIPMENT DESIGNATION	0	JUNCTION BOX, SIZE & TYPE AS INDICATED OR AS REQ'D.  JUNCTION BOX, FLOOR MOUNTED, SIZE & TYPE AS INDICATED
—G—	GROUND BUS		•	CEILING EXHAUST FAN, N.I.E.S. CONNECTION BY ELECTRICAL CONTRACTOR		OR AS REQ'D.
<u></u> →	CIRCUIT BREAKER			COMBINATION STARTER/DISCONNECT, FUSED. SIZE AND TYPE	<b>O</b> ~	JUNCTION BOX WITH FLEX CONNECTION TO EQUIPMENT
~ ~	FUSIBLE SWITCH		_	AS REQUIRED OR NOTED	<b>→</b> ∀	120V OR 240V SPECIAL APPLIANCE OR EQUIPMENT RECEPTACLE (VE FOR NEMA TYPE AND EXACT LOCATION)
			45	FUSED DISCONNECT SWITCH, SIZE PER UNIT LABEL		PRE-MANUFACTURED INTERCONNECT CABLE
IDE ALADIA			4	NON-FUSED DISCONNECT SWITCH	~	CONNECTION TO EQUIPMENT BY ELECTRICAL CONTRACTOR
FACE	FIRE ALARM CONTROL PANEL			CONTROL EQUIPMENT		CEILING MOUNTED DUPLEX RECEPTACLE
F	PULL STATION +45" U.O.N.		- 42	CIRCUIT BREAKER DISCONNECT SWITCH	•	DUPLEX RECEPTACLE FLUSH w/ FINISHED FLOOR NEMA 5-20R.
<u>⊩</u> DE	FIRE ALARM HORN +80" AFF U.O.N.		-	DISTRIBUTION TRANSFORMER, MOUNTING AS NOTED		PLUGMOLD MULTI-OUTLET ASSEMBLY, WIREMOLD OR
	FIRE ALARM STROBE LIGHT +80" AFF U.O.N.			BELL, TYPE AS NOTED ON PLANS	44 141	EQUAL W/ OUTLETS AS SHOWN.
	FIRE ALARM STROBE/HORN +80" AFF U.O.N.			LOW VOLTAGE BUZZER	•	EQUIPMENT CONNECTION
	DUCT SMOKE DETECTOR—S.M.D. FOR EXACT LOCATION			LOW VOLTAGE PUSH BUTTON	$\dashv$	
\$D	CLNG AREA SMOKE DETECTOR, 120V WITH BATTERY BACK	(_IIP /2		INDICATES KEYED NOTES THIS SHEET		
(H)	HEAT DETECTOR	<u> </u>	<del>                                     </del>		WIRING	
ANN	FIRE ALARM ANNUNCIATOR		(T)	THERMOSTAT, NIES, INSTALL & CONNECT AS REQUIRED		CONDUIT RUN CONCEALED BELOW FLOOR OR FINISHED GRADE
FS	FIRE SPRINKLER FLOW SWITCH		<b>S</b> 9	CIRCUIT BREAKER SHUNT TRIP MODULE		SAWCUT EXISTING SLAB AND PATCH EXISTING CONCRETE TO MATCH IN LIKE AND KIND AFTER INSTALLATION OF CONDUITS.
53	FIRE SPRINKLER SUPERVISORY SWITCH OR POST INDICATO	OR				
FSD	FIRE SMOKE DAMPER					CONDUIT CONCEALED IN CEILING OR WALL
<u></u>	CARBON MONOXIDE DETECTOR, 120V WITH BATTERY BACK	(-UP 2				HOMERUN TO RESPECTIVE PANEL OR TERMINAL CABINET-
				DOOR LIMIT SWITCH	_	OVERHEAD.  HOMERUN TO RESPECTIVE PANEL OR TERMINAL CABINET—
NI.	IOTE, ALL DEVICE AND OUTLET MOUNTING LIFICUTE ADE MEAC	NIDED	DS	DOOR LIMIT SWITCH		UNDERGROUND, MAY RUN TO NEAREST WALL OR COLUMN WHERE CONDUIT CAN BE CONCEALED AND RUN OVERHEAD TYPICAL FOR POWER, TEL., LV, SIGNAL, ETC.
	<u>IOTE:</u> ALL DEVICE AND OUTLET MOUNTING HEIGHTS ARE MEASI ROM THE CENTER OF OUTLETS	UKED	LIGHTING	CUREAGE MOUNT FLUORESCENT CTRIR LIGHT		CONDUIT RISER — UP
			<b>⊢</b> 0−1	SURFACE MOUNT FLUORESCENT STRIP LIGHT.		CONDUIT RISER — DOWN
	OVIDE 4"X4" SQUARE X 2 1/4" DEEP OUTLET AN 4" CONDUIT AND PULL WIRE TO ACCESSIBLE CEIL			SURFACE MOUNTED FLUORESCENT FIXTURE, (SUBSCRIPT INDICATES SWITCHING CONTROL)		
	IRING BY OTHERS)			2x4 RECESSED FLUORESCENT FIXTURE	<del>_</del>	EXISTING FEEDER TO REMAIN
				(SUBSCRIPT INDICATES SWITCHING CONTROL)		
				POWER TRACK WITH DECORATIVE SHADE TRACK HEADS		RANCH CIRCUIT WITHOUT FURTHER DESIGNATION INDICATES IDICATES A 2 #12 WIRE CIRCUIT
				FLUORESCENT STRIP FIXTURE	A[	DDITIONAL NO. OF #12: — HH, 3 #12: — H, 2 #12 &
			•	INCANDESCENT OR HID FIXTURE	SI	#12 GND: <del>            ,</del> 5 #12 & 1 #12 GND: ETC. OTHER WIRE ZES: <del>         ,</del> , 2 #10 & 1 #12 GND: <del>         ,</del> , 3 #4 & 1 #8
			Ю	WALL MOUNTED INCANDESCENT OR HID FIXTURE	E	TC. #10 '#12 " #4 '#8 " " #4 '#8 " "   #4 '#8     #4 '#8     #4   #6   #4   #6   #4   #6   #4   #6   #6
			<u>⊢</u> •	WALL MOUNTED FLUORESCENT FIXTURE		•
				SURFACE MOUNTED FLUORESCENT WRAPAROUND	ABBREVIAT	
				FIXTURE WITH EMERGENCY BALLAST.	MT FI	EMPTY CONDUIT WITH PULLSTRING
				DUAL LAMP EMERGENCY LIGHTING BATTERY UNIT ON WALL OR COLUMN MOUNT. (SEE FIXTURE SCHEDULE TYPE "EM1")	EL NI	EMERGENCY LIGHT  NIGHT LIGHT
	INDEX OF DRAWINGS			EXIT SIGN — DIRECTIONAL ARROWS AS INDICATED	NL (E)	EXISTING
	) INDEX OF DIVAMINGS		₩		(E) (R)	RELOCATED
			<u></u>	FIXTURE TAG DESIGNATION, SEE FIXTURE SCHEDULE  PHOTO ELECTRIC CONTROL	(M)	MODIFIED
E0.1A	LEGEND, NOTES AND GENERAL NOTES		\$	SINGLE POLE TOGGLE SWITCH	С	CONDUIT
E0.1B	LCP AND LIGHTING FIXTURE SCHEDULE		\$ <sup>2</sup>	TWO POLE TOGGLE SWITCH	WP	WEATHERPROOF
			\$ <sup>3</sup>	THREE-WAY TOGGLE SWITCH	EOL	INDICATES DEVICE w/ END-OF-LINE RESISTOR
E2.0	LIGHTING CONTROLS  POWER AND SIGNAL PLAN			KEY OPERATED SINGLE POLE TOGGLE SWITCH	NIES	NOT IN ELECTRICAL SECTION OF THESE PLANS & SPECIFICATIONS
E2.0 E2.1 E2.1D	POWER AND SIGNAL PLAN		\$ K			INVECCO MATER ATTENANCE
E2.1	POWER AND SIGNAL PLAN		\$ HP	MOTOR RATED SINGLE POLE SWITCH, @ UNIT UNO	UNO PFR	UNLESS NOTED OTHERWISE  PROVIDE FOR FUTURE BREAKER
E2.1 E2.1D	POWER AND SIGNAL PLAN ELECTRICAL DEMOLITION PLAN		<u> </u>	MOTOR RATED SINGLE POLE SWITCH, @ UNIT UNO SINGLE POLE TOGGLE WITH PILOT LIGHT	PFB	PROVIDE FOR FUTURE BREAKER
E2.1 E2.1D E2.2	POWER AND SIGNAL PLAN ELECTRICAL DEMOLITION PLAN LIGHTING PLAN		\$ HP	MOTOR RATED SINGLE POLE SWITCH, @ UNIT UNO  SINGLE POLE TOGGLE WITH PILOT LIGHT  MOTION DETECTOR AND BOX, CEILING; WALL MOUNTED, FURNISHED INSTALLED & CONNECTED BY ELECTRICAL CONTRACTOR, LOWER CASE	PFB RE:	PROVIDE FOR FUTURE BREAKER  REFERENCE, REFER TO AND COORDINATE WITH
E2.1 E2.1D E2.2 E3.1	POWER AND SIGNAL PLAN ELECTRICAL DEMOLITION PLAN LIGHTING PLAN SINGLE LINE DIAGRAM		\$ HP \$ P	MOTOR RATED SINGLE POLE SWITCH, @ UNIT UNO  SINGLE POLE TOGGLE WITH PILOT LIGHT  MOTION DETECTOR AND BOX, CEILING; WALL MOUNTED, FURNISHED	PFB RE:	PROVIDE FOR FUTURE BREAKER
E2.1 E2.1D E2.2 E3.1 E3.2	POWER AND SIGNAL PLAN ELECTRICAL DEMOLITION PLAN LIGHTING PLAN SINGLE LINE DIAGRAM PANEL SCHEDULES		\$ HP \$ P	MOTOR RATED SINGLE POLE SWITCH, @ UNIT UNO  SINGLE POLE TOGGLE WITH PILOT LIGHT  MOTION DETECTOR AND BOX, CEILING; WALL MOUNTED, FURNISHED INSTALLED & CONNECTED BY ELECTRICAL CONTRACTOR, LOWER CASE LETTER INDICATES CIRCUIT OR FIXTURE CONTROLLED BY DETECTOR. AIM	PFB RE:	PROVIDE FOR FUTURE BREAKER  REFERENCE, REFER TO AND COORDINATE WITH  HOTE: SYMBOLS INDICATED ABOVE MAY NOT
E2.1 E2.1D E2.2 E3.1 E3.2 E4.1 E4.2	POWER AND SIGNAL PLAN ELECTRICAL DEMOLITION PLAN LIGHTING PLAN SINGLE LINE DIAGRAM PANEL SCHEDULES LTG TITLE 24 CALCULATIONS LTG TITLE 24 CALCULATIONS LTG TITLE 24 CALCULATIONS		\$ HP \$ P \$ 0S a \$ os	MOTOR RATED SINGLE POLE SWITCH, @ UNIT UNO  SINGLE POLE TOGGLE WITH PILOT LIGHT  MOTION DETECTOR AND BOX, CEILING; WALL MOUNTED, FURNISHED INSTALLED & CONNECTED BY ELECTRICAL CONTRACTOR, LOWER CASE LETTER INDICATES CIRCUIT OR FIXTURE CONTROLLED BY DETECTOR. AIM ADJUSTABLE SENSORS PER DIRECTIONAL ARROWS WHERE INDICATED.  LV OERRIDE SWITCH	PFB RE:	PROVIDE FOR FUTURE BREAKER  REFERENCE, REFER TO AND COORDINATE WITH  IOTE: SYMBOLS INDICATED ABOVE MAY NOT IECESSARILY APPEAR AS PART OF THESE
E2.1 E2.1D E2.2 E3.1 E3.2 E4.1 E4.2 E4.3 E4.4	POWER AND SIGNAL PLAN ELECTRICAL DEMOLITION PLAN LIGHTING PLAN SINGLE LINE DIAGRAM PANEL SCHEDULES LTG TITLE 24 CALCULATIONS LTG TITLE 24 CALCULATIONS LTG TITLE 24 CALCULATIONS LTG TITLE 24 CALCULATIONS		\$ HP \$ P \$ P \$ OS \$ S OS \$ D \$ D	MOTOR RATED SINGLE POLE SWITCH, © UNIT UNO  SINGLE POLE TOGGLE WITH PILOT LIGHT  MOTION DETECTOR AND BOX, CEILING; WALL MOUNTED, FURNISHED INSTALLED & CONNECTED BY ELECTRICAL CONTRACTOR, LOWER CASE LETTER INDICATES CIRCUIT OR FIXTURE CONTROLLED BY DETECTOR. AIM ADJUSTABLE SENSORS PER DIRECTIONAL ARROWS WHERE INDICATED.  LV OERRIDE SWITCH  DIMMER SWITCH AND BOX	PFB RE:	PROVIDE FOR FUTURE BREAKER  REFERENCE, REFER TO AND COORDINATE WITH  IOTE: SYMBOLS INDICATED ABOVE MAY NOT IECESSARILY APPEAR AS PART OF THESE
E2.1 E2.1D E2.2 E3.1 E3.2 E4.1 E4.2 E4.3 E4.4	POWER AND SIGNAL PLAN ELECTRICAL DEMOLITION PLAN LIGHTING PLAN SINGLE LINE DIAGRAM PANEL SCHEDULES LTG TITLE 24 CALCULATIONS		\$ HP \$ P \$ 0S a \$ os	MOTOR RATED SINGLE POLE SWITCH, @ UNIT UNO  SINGLE POLE TOGGLE WITH PILOT LIGHT  MOTION DETECTOR AND BOX, CEILING; WALL MOUNTED, FURNISHED INSTALLED & CONNECTED BY ELECTRICAL CONTRACTOR, LOWER CASE LETTER INDICATES CIRCUIT OR FIXTURE CONTROLLED BY DETECTOR. AIM ADJUSTABLE SENSORS PER DIRECTIONAL ARROWS WHERE INDICATED.  LV OERRIDE SWITCH	PFB RE:	PROVIDE FOR FUTURE BREAKER  REFERENCE, REFER TO AND COORDINATE WITH  IOTE: SYMBOLS INDICATED ABOVE MAY NOT IECESSARILY APPEAR AS PART OF THESE
E2.1 E2.1D E2.2 E3.1 E3.2 E4.1 E4.2 E4.3 E4.4 E4.5	POWER AND SIGNAL PLAN ELECTRICAL DEMOLITION PLAN LIGHTING PLAN SINGLE LINE DIAGRAM PANEL SCHEDULES LTG TITLE 24 CALCULATIONS		\$ HP \$ P \$ O \$ os \$ os	MOTOR RATED SINGLE POLE SWITCH, © UNIT UNO  SINGLE POLE TOGGLE WITH PILOT LIGHT  MOTION DETECTOR AND BOX, CEILING; WALL MOUNTED, FURNISHED INSTALLED & CONNECTED BY ELECTRICAL CONTRACTOR, LOWER CASE LETTER INDICATES CIRCUIT OR FIXTURE CONTROLLED BY DETECTOR. AIM ADJUSTABLE SENSORS PER DIRECTIONAL ARROWS WHERE INDICATED.  LV OERRIDE SWITCH  DIMMER SWITCH AND BOX  DIMMER/OCCUPANCY SENSOR COMBO SWITCH AND BOX	PFB RE:	PROVIDE FOR FUTURE BREAKER  REFERENCE, REFER TO AND COORDINATE WITH  IOTE: SYMBOLS INDICATED ABOVE MAY NOT IECESSARILY APPEAR AS PART OF THESE
E2.1 E2.1D E2.2 E3.1 E3.2 E4.1 E4.2 E4.3 E4.4 E4.5 E4.6 SE1	POWER AND SIGNAL PLAN ELECTRICAL DEMOLITION PLAN LIGHTING PLAN SINGLE LINE DIAGRAM PANEL SCHEDULES LTG TITLE 24 CALCULATIONS		\$ HP \$ P \$ OS \$ OS \$ D/OS	MOTOR RATED SINGLE POLE SWITCH, © UNIT UNO  SINGLE POLE TOGGLE WITH PILOT LIGHT  MOTION DETECTOR AND BOX, CEILING; WALL MOUNTED, FURNISHED INSTALLED & CONNECTED BY ELECTRICAL CONTRACTOR, LOWER CASE LETTER INDICATES CIRCUIT OR FIXTURE CONTROLLED BY DETECTOR. AIM ADJUSTABLE SENSORS PER DIRECTIONAL ARROWS WHERE INDICATED.  LV OERRIDE SWITCH  DIMMER SWITCH AND BOX  DIMMER/OCCUPANCY SENSOR COMBO SWITCH AND BOX	PFB RE:	PROVIDE FOR FUTURE BREAKER  REFERENCE, REFER TO AND COORDINATE WITH  IOTE: SYMBOLS INDICATED ABOVE MAY NOT IECESSARILY APPEAR AS PART OF THESE
E2.1 E2.1D E2.2 E3.1 E3.2 E4.1 E4.2 E4.3 E4.4 E4.5	POWER AND SIGNAL PLAN ELECTRICAL DEMOLITION PLAN LIGHTING PLAN SINGLE LINE DIAGRAM PANEL SCHEDULES LTG TITLE 24 CALCULATIONS LTG TITLE 24 CALCULATIO	<b>A</b>	\$ HP \$ P \$ OS \$ OS \$ D/OS	MOTOR RATED SINGLE POLE SWITCH, © UNIT UNO  SINGLE POLE TOGGLE WITH PILOT LIGHT  MOTION DETECTOR AND BOX, CEILING; WALL MOUNTED, FURNISHED INSTALLED & CONNECTED BY ELECTRICAL CONTRACTOR, LOWER CASE LETTER INDICATES CIRCUIT OR FIXTURE CONTROLLED BY DETECTOR. AIM ADJUSTABLE SENSORS PER DIRECTIONAL ARROWS WHERE INDICATED.  LV OERRIDE SWITCH  DIMMER SWITCH AND BOX  DIMMER/OCCUPANCY SENSOR COMBO SWITCH AND BOX	PFB RE:	PROVIDE FOR FUTURE BREAKER  REFERENCE, REFER TO AND COORDINATE WITH  IOTE: SYMBOLS INDICATED ABOVE MAY NOT IECESSARILY APPEAR AS PART OF THESE
E2.1 E2.1D E2.2 E3.1 E3.2 E4.1 E4.2 E4.3 E4.4 E4.5 E4.6 SE1 SE2 SE3	POWER AND SIGNAL PLAN ELECTRICAL DEMOLITION PLAN LIGHTING PLAN SINGLE LINE DIAGRAM PANEL SCHEDULES LTG TITLE 24 CALCULATIONS	<b>3</b> -0	\$ HP \$ P \$ OS \$ OS \$ D/OS	MOTOR RATED SINGLE POLE SWITCH, © UNIT UNO  SINGLE POLE TOGGLE WITH PILOT LIGHT  MOTION DETECTOR AND BOX, CEILING; WALL MOUNTED, FURNISHED INSTALLED & CONNECTED BY ELECTRICAL CONTRACTOR, LOWER CASE LETTER INDICATES CIRCUIT OR FIXTURE CONTROLLED BY DETECTOR. AIM ADJUSTABLE SENSORS PER DIRECTIONAL ARROWS WHERE INDICATED.  LV OERRIDE SWITCH  DIMMER SWITCH AND BOX  DIMMER/OCCUPANCY SENSOR COMBO SWITCH AND BOX	PFB RE:	PROVIDE FOR FUTURE BREAKER  REFERENCE, REFER TO AND COORDINATE WITH  NOTE: SYMBOLS INDICATED ABOVE MAY NOT RECESSARILY APPEAR AS PART OF THESE PRAWINGS IF NOT REQUIRED.

CJ W ARCHITECTURE


130 Portola Road, suite A Portola Valley, CA 94028

(650) 851-9335 / (Fax) 851-9337

#### Tantech Engineers MEP CONSULTING

**ENGINEERS** 1431 Cedar Street San Carlos, CA 94070 (415) 269-4283

These plans are copyrighted and are subject to copyright protection as an "architectural work" under Sec. 102 of the Copyright Act, 17 U.S.O. as amended December 1990 and known as Architectural Works Copyright Protection Act of 1990. The protection includes but is not limited to the overall form as well as the arrangement and composition o spaces and elements of the design. Under such protection, unauthorized use of these plans, work or home represented, can legally result in the cessation of construction or building being seized and /or monetary compensation to CJW

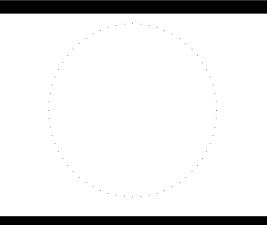

• PROJECT •

LifeMoves Maple Street Shelter 1580 Maple Street Redwood City CA 94063

• SHEET TITLE •

Legend, general notes

• REVISIONS •

No. Notes Date 6.17.16 BLDG SUBMITTAL 1 PLAN CHECK # 1 8.15.16 ADDENDUM # 3 8.25.16 ADDENDUM # 5 9.23.16 PLAN CHECK #2 ADDENDUM # 6


° DATE: 06/17/16

CONFORMANCE WITH DESIGN INTENT PRIOR TO SUBMITTING TO

THE BUILDING DIVISION FOR APPROVAL. (CBC 106.3.5)

#### NOTES:

- MOUNTING HEIGHTS OF ALL ELECTRICAL EQUIPMENT SHALL CONFORM TO ADA REQUIREMENTS.
- 2. ALL CONTROLS AND SWITCHES INTENDED TO BE USED BY THE OCCUPANT OF THE ROOM OR AREA TO CONTROL LIGHTING AND RECEPTACLE OUTLETS, APPLIANCES OR COOLING, HEATING AND VENTILATING EQUIPMENT, SHALL LOCATED NO MORE THAN 48" MEASURED FROM THE TOP OF THE JUNCTION BOX OR DEVICE BOX NOR LESS THAN 15" MEASURED TO THE BOTTOM OF THE JUNCTION OR DEVICE BOX ABOVE THE FINISH FLOOR.
- 3. ALL RECEPTACLES OUTLETS ON BRANCH CIRCUITS OF MORE THAN 30-AMPERES OR LESS AND COMMUNICATION SYSTEM RECEPTACLES SHALL BE LOCATED NO MORE THAN 48" MEASURED FROM THE TOP OF RECEPTACLE OUTLET BOX OR RECEPTACLE HOUSING NOR LESS THAN 15" MEASURED TO THE BOTTOM OF THE RECEPTACLE OUTLET BOX OR RECEPTACLE HOUSING ABOVE THE FINISH FLOOR.

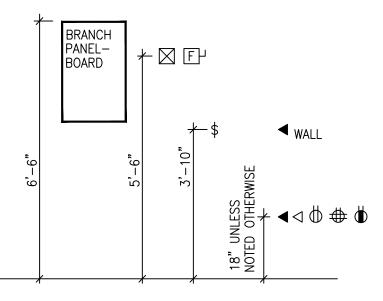


STANDARD MOUNTING HEIGHTS


N.T.S.
RE: ALL ELECTRICAL DRAWINGS

## Z FIXTURE SCHEDULE NOTES RE: E0.1-3

- OWNER TO APPROVE ALL FIXTURE SUBMITTALS PRIOR TO PURCHASE. PROVIDE ALL CUT SHEETS WITH CORRESPONDING TAG AND MODEL NUMBERS AND SHOW EXPLICITLY ALL STYLES, FINISHES AND COLORS— OTHERWISE CONTRACTOR WILL BEAR ALL RESTOCKING AND RELATED COSTS TO OBTAIN THE PROPER FIXTURE.
- 2. MANUFACTURER AND DESCRIPTION NOTED ARE TO ESTABLISH MINIMUM STANDARDS FOR FIXTURES. EQUIVALENT WILL BE REVIEWED BASED ON APPEARANCE, CONSTRUCTION AND PHOTOMETRICS. DESCRIPTION SHALL PREVAIL OVER MANUFACTURER CATALOG NUMBERS.
- FINISH MATERIALS AND COLOR OF ALL LIGHT FIXTURES SHALL BE VERIFIED WITH ARCHITECT AS PART OF SHOP DRAWINGS SUBMITTAL PRIOR TO ORDERING. PROVIDE SAMPLE COLOR CHIPS AND/OR SAMPLES AS REQUESTED.
- 4. PRISMATIC DIFFUSER LENSES SHALL BE 100% VIRGIN ACRYLIC, MINIMUM 0.125" THICKNESS, PATTERN #12A UNLESS OTHERWISE NOTED.
- 5. ALL FIXTURES SHALL HAVE A MINIMUM OF AN UNCONDITIONAL TWO YEAR WARRANTY ON ALL BALLASTS (PARTS AND LABOR).
- 6. ALL EQUIPMENT SHALL BE LISTED AND LABELED BY A NATIONALLY RECOGNIZED TESTING LABORATORY FOR THE SPECIFIC APPLICATION IN WHICH USED. IT SHALL BE INSTALLED AS PER LISTING OOR LABELING.
- 7. VERIFY EXACT MOUNTING HEIGHTS AND REFERENCE HEIGHTS (I.E., BOTTOM OF FIXTURE, CENTER LINE OF OUTLET BOX, ETC.) WITH ARCHITECT PRIOR TO ROUGH—IN.
- 8. SEE ARCHITECTURAL REFLECTED CEILING PLAN FOR EXACT LOCATION OF LIGHT FIXTURES IN CEILING.
- 9. SURFACE MOUNTED FIXTURES SHALL BE SECURED TO BUILDING STRUCTURE TOGGLE BOLTS ARE NOT ACCEPTABLE.
- 10. ALL PENDANT MOUNTED FIXTURES SHALL BE INSTALLED WITH CANOPIES AND STEMS SUCH THAT THEY SWING A MINIMUM OF 45° IN ALL DIRECTIONS WITHOUT HITTING ANY OBSTRUCTIONS. IF THERE ARE OBSTRUCTIONS WITHIN THE 45° SWING AREA, PROVIDE SWAY BRACING TO RESTRICT ANY MOVEMENT.
- 11. PROVIDE SEISMIC BRACING FOR ALL FIXTURES AS REQUIRED BY STATE OF CALIFORNIA BUILDING CODES AND LOCAL JURISDICTION.
- 12. SURFACE MOUNTED FIXTURES SHALL CLEAR SPRINKLER HEADS BY 12" MINIMUM.
- 13. LED SHALL BE 4000K COLOR TEMPERATURE

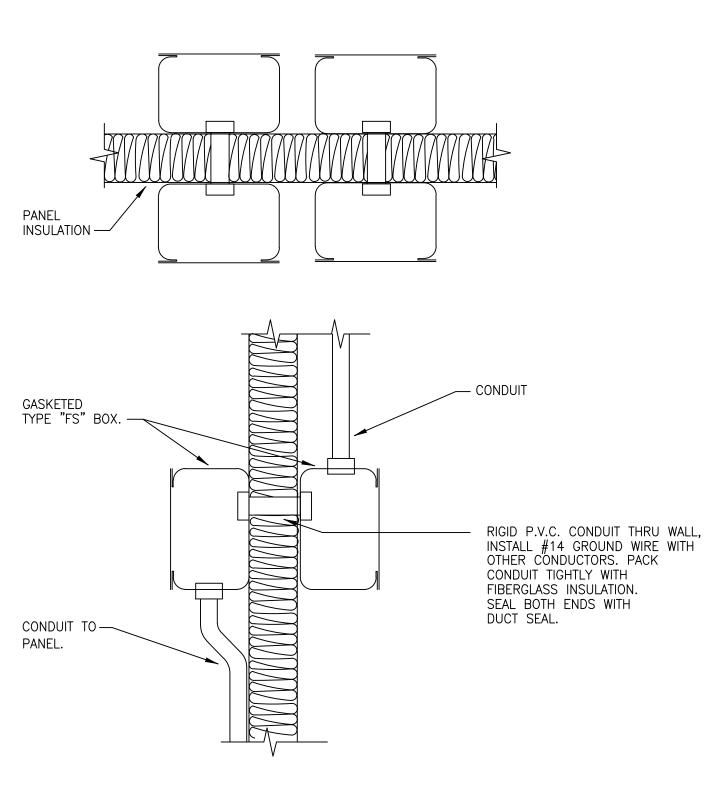


PENETRATION THRU
FREEZER/COOLER WALL
N.T.S.
RE: E2.1

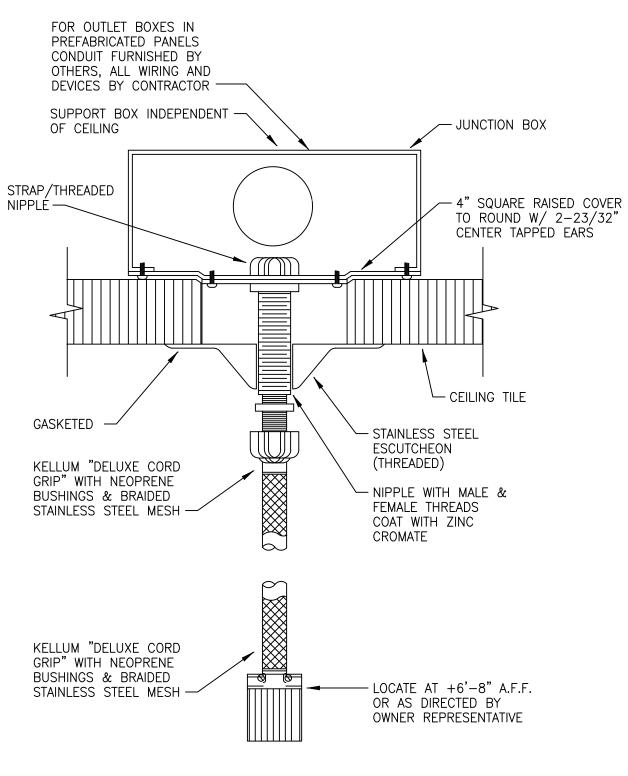

1 CEILING PENETRATION DETAIL N.T.S. RE: E2,1

	$\subseteq$	) FIXTI _ RE: E2.2	URE SCHEDULE					
-	TAG	SYMBOL	DESCRIPTION	MANUFACTURER AND CATALOG #	LAMPS	FIXTURE WATT	VOLT	REMARKS
	A		RECESSED 2'X2' LED INDIRECT WITH PERFORATED CENTER BASKET 4000K	LITHONIA 2BLT2-40L-ADSM-EZ1-LP840 HE WILLIAMS	30w LED	30w	120	
	A1		SAME AS A EXCEPT WITH 90 CRI COLOR TEMPERATURE	LITHONIA 2BLT2-40L-ADSM-EZ1LP940 HE WILLIAMS	30w LED	30w	120	USE IN HOUSING BED AREA
	В		SURF MOUNT 1'X8' LED	FAILSAFE HVL8-8-LD4-2STD-35-UNV-0-EDD1	73w LED	73w	120	
	B1		SURF MOUNT 1'X2' LED	FAILSAFE HVL8-2-LD4-1L0-35-UNV-0-EDD1	26.2w LED	26.2w	120	
	B2		SAME AS "B1" EXCEPT 1'x4'	FAILSAFE HVL8-4-LD4-1STD-35-UNV-0-EDD1	34.3w LED	34.3w	120	
	C1		SURF MOUNT 2' LED WALL LIGHT, COLOR TO BE SELECTED BY ARCHITECT	VISA LIGHTING CV1800 LNW DIM 120	10w LED	10w	120	LOCATE ABOVE MIRROR
	C2		SAME AS "C1" EXCEPT 4'	VISA LIGHTING CV1804 LNW DIM 120	28w LED	28w	120	LOCATE ABOVE MIRROR
•	C3		SAME AS "C1" EXCEPT 5'	VISA LIGHTING CV1806 LNW DIM 120	36w LED	36w	120	LOCATE ABOVE MIRROR
	C4		SAME AS "C1" EXCEPT 3'	VISA LIGHTING CV1802 LNW DIM 120	24w LED	24w	120	LOCATE ABOVE
4	K1		SURF MOUNT 1' STRIP LED, SPLASH PROOF	PARAMOUNT SC4-1-1-3-120	10w/LF LED	10w	120	MINITOR
	K2		SAME AS "B1" EXCEPT 4' STRIP	PARAMOUNT SC4-1-4-3-120	10w/LF LED	40w	120	
	E1	₩ 	UNIVERSAL MOUNT LED EXIT SIGN EMERGENCY BATTERY PACK 90 MINUTES MINIMUM.	TBD	PROVIDED w/ FIXT		120	
•	X	Ю	EXTERIOR LED WALL PACK	GARDCO 104L-16L-530NG1-4-120-BK	30W LED MAX		120	
	X2	۵	EXTERIOR LED DOWNLIGHT, WET LOCATION LABEL	WILLIAMS L60-L20C-840-26	26W LED		120	
	S1	<b>□•</b>	PARKING LOT LUMINAIRE SINGLE HEAD ALUMINUM HOUSING, ARM MOUNTED, TYPE 5 DISTRIBUTION ALUMINUM REFLECTOR, INTEGRAL LED DRIVER, TEMPERED GLASS LENS. UL WET LOCATION LABEL	GARDCO P21 MR1 A2-1-5W 55LA- NW-208-BLP-BD	1-55 WATT LED 4000K 70 CRI	208		SEE SE1
			4" STRAIGHT SQUARE STEEL POLE FACTORY PRIMED AND PAINTED, BLACK ANODIZED 10'-0"					
	S1A	□•	SIMILAR TO 'S1' EXCEPT TWIN HEAD. TYPE 3 DISTRIBUTION	GARDCO P21 MR1 A2-1-3 55LA- NW-208-BLP-BD	1-55W LED 4000K 70 CRI	208		SEE SE1
	S2	<b>-+-</b>	SIMILAR TO 'SA' EXCEPT TWIN HEAD.  4" STRAIGHT SQUARE STEEL POLE FACTORY PRIMED AND PAINTED, BLACK ANODIZED 10'-0"	GARDCO P21 MR1 A2-2-5W 55LA- NW-208-BLP-BD	2-55 WATT LED 4000K 70 CRI	208		SEE 5 SE1
	[S3]	¤	EXTERIOR LED BOLLARD, WET LOCATION LABEL	GARDCO BRM-830 43 MR NW 360 UNIV-BLP	41w LED	120		
	S4	8	EXTERIOR LED TRELLIS LIGHT, WET LOCATION LABEL	BRUCK 105015 BK	9.6w LED	120		
	S5		EXTERIOR LED STEP LIGHT, WET LOCATION LABEL	BRUCK 138022-BN-3-HL	2.6w LED	120		

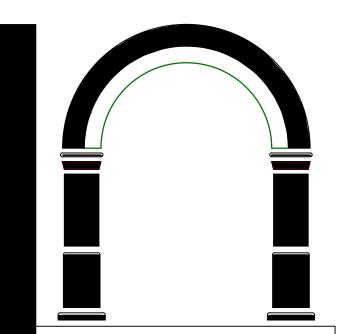

CJ W ARCHITECTURE

130 Portola Road, suite A Portola Valley, CA 94028

(650) 851-9335 / (Fax) 851-9337


Tantech Engineers

MEP CONSULTING
ENGINEERS

1431 Cedar Street
San Carlos, CA 94070

(415) 269-4283

These plans are copyrighted and are subject to copyright protection as an "architectural work" under Sec. 102 of the Copyright Act, 17 U.S.O. as amended December 1990 and known as Architectural Works Copyright Protection Act of 1990. The protection includes but is not limited to the overall form as well as the arrangement and composition of spaces and elements of the design. Under such protection, unauthorized use of these plans, work or home represented, can legally result in the cessation of construction or building being seized and /or monetary compensation to CJW

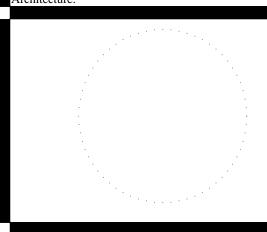

• PROJECT •

LifeMoves Maple Street Shelter 1580 Maple Street Redwood City CA 94063

• SHEET TITLE •


LCP, lighting fixture schedule

	• REV	ISIONS °
No.	Date 6.17.16	Notes BLDG SUBMITTAL
2	8.15.16	PLAN CHECK # 1 ADDENDUM # 3
3	8.25.16	ADDENDUM # 5
4	9.23.16	PLAN CHECK #2 ADDENDUM # 6

JOB: 2015.2801

° DATE: 06/17/16

° SHEET: E0.1B

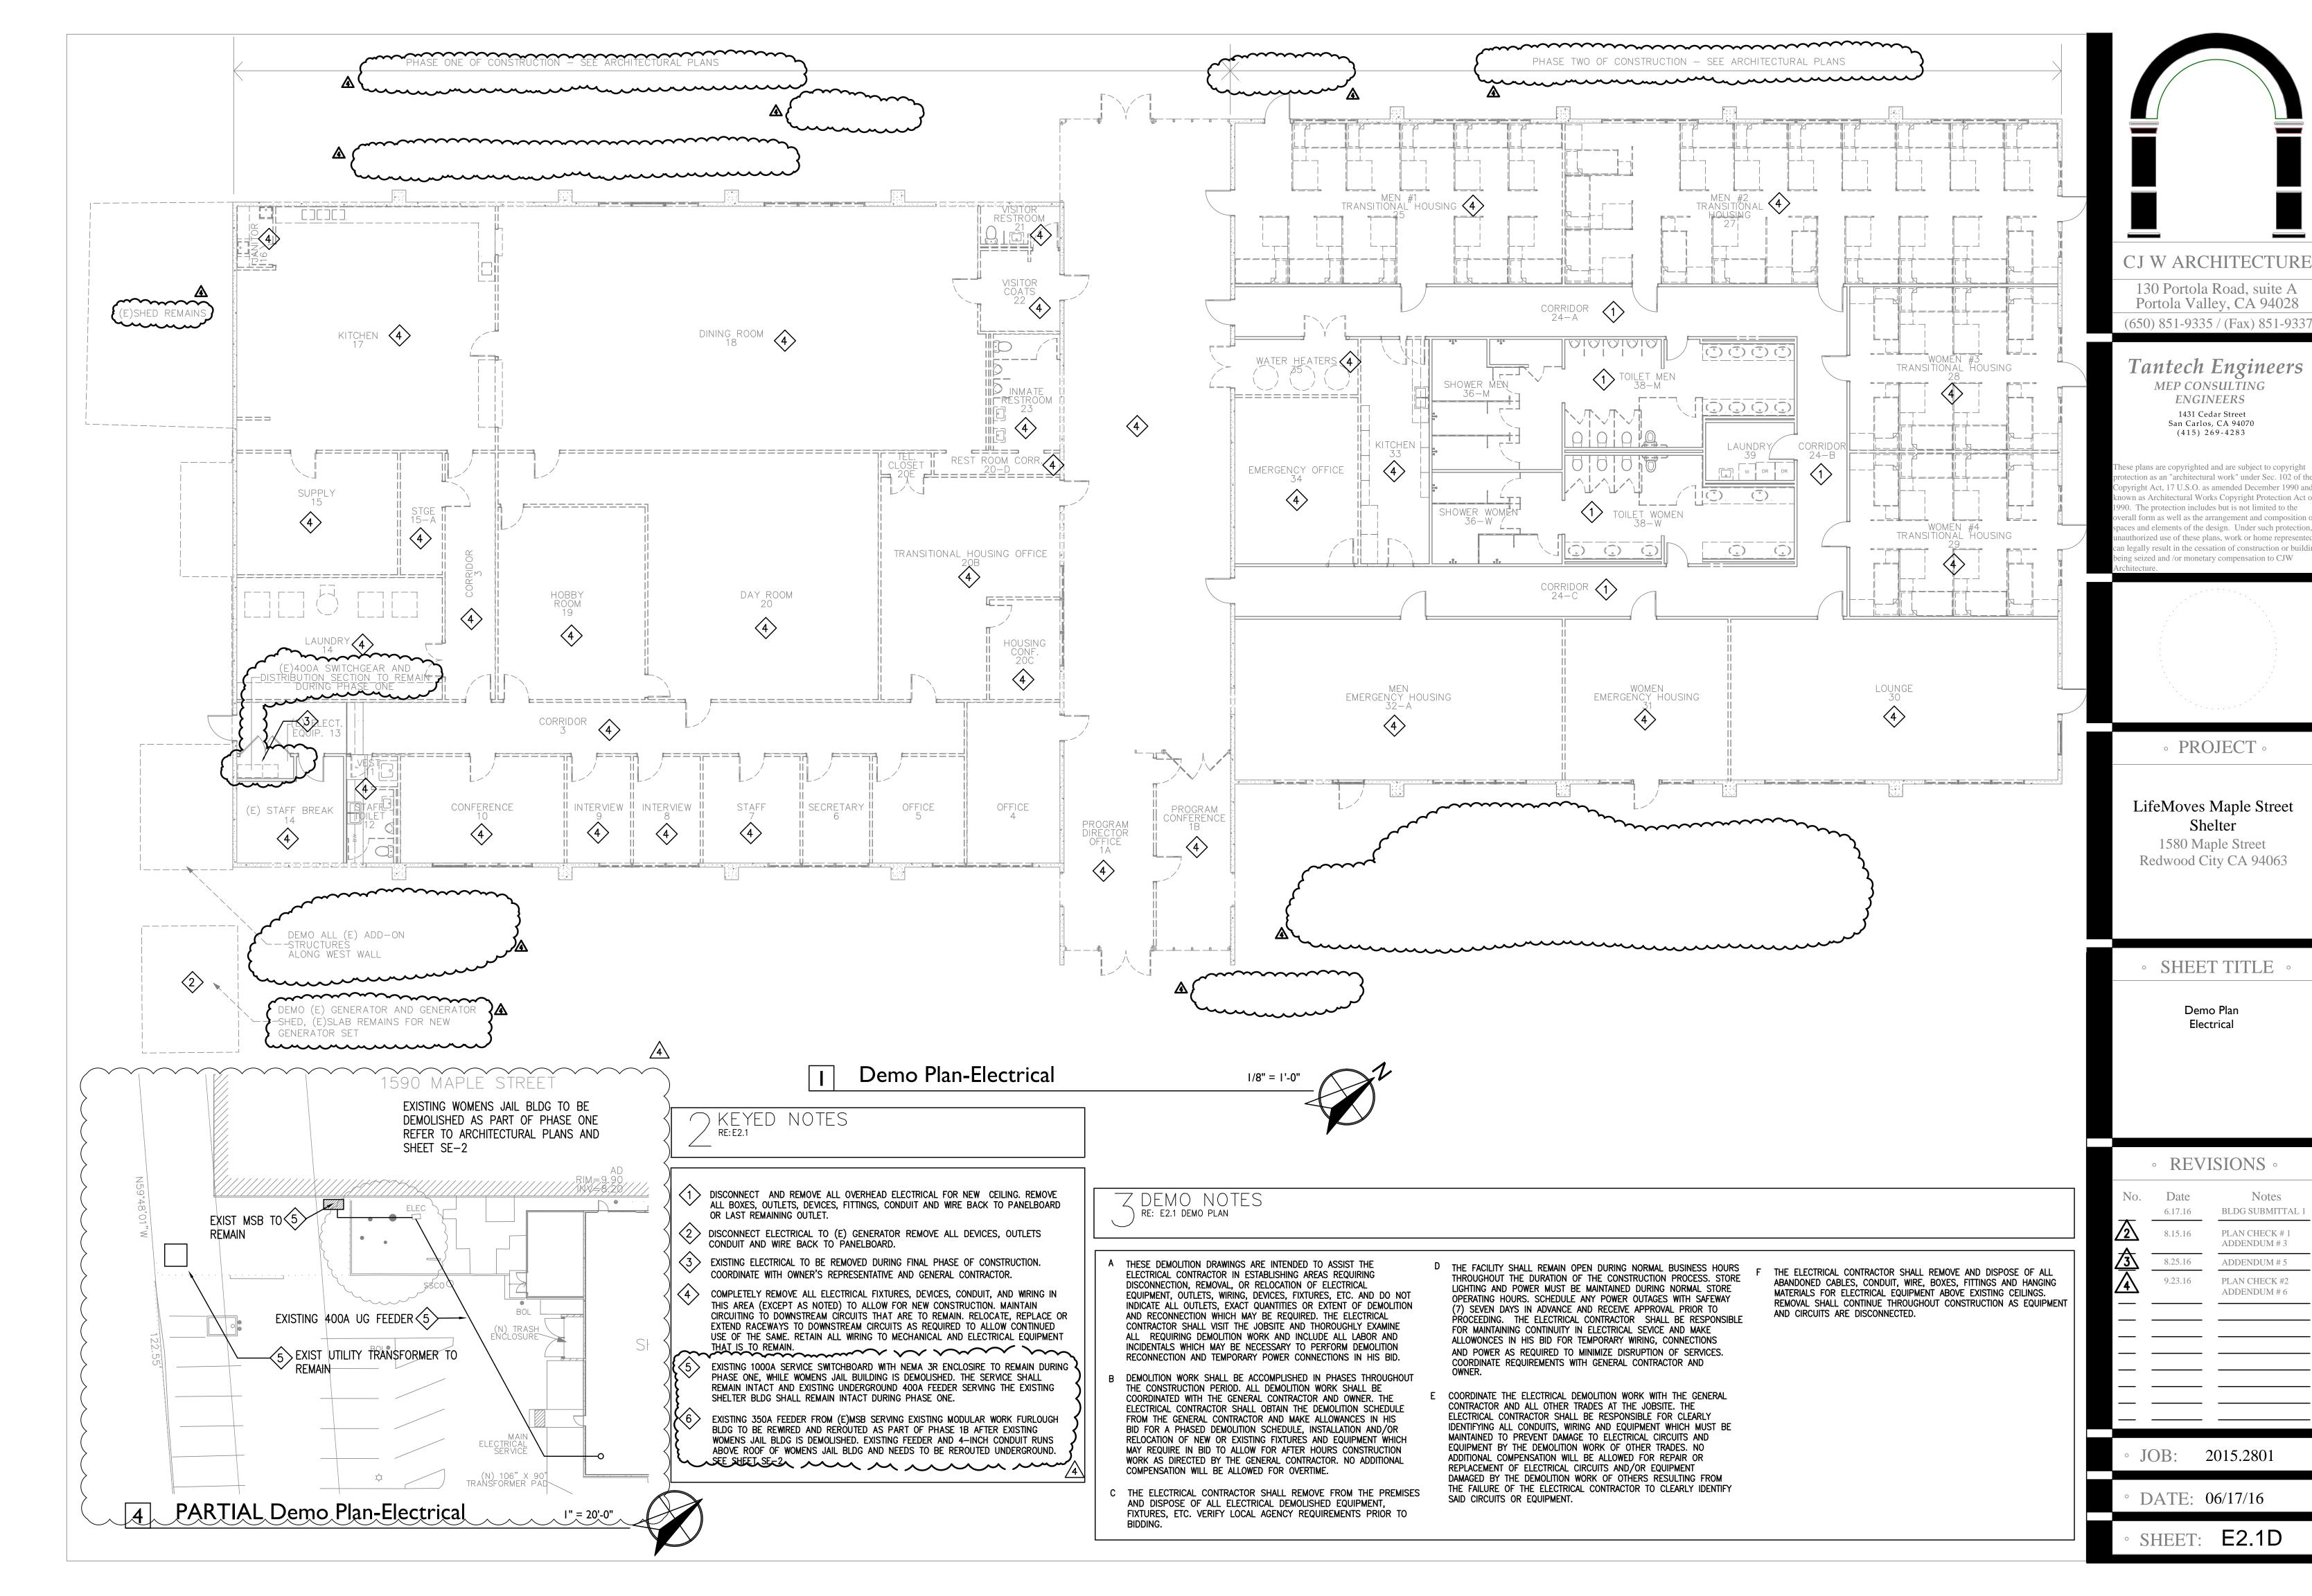

1PANEL SCHEDULE

NOTE: EACH MULTI WIRE BRANCH CIRCUIT MUST HAVE
A MEANS TO SIMULTANEOUSLY DISCONNECT ALL
UNGROUNDED CONDUCTORS AT THE POINT
WHERE THE BRANCH CIRCUIT ORIGINATES PER
NEC 210.4

			12	0/2	08 V	OLT	S, 3 P	HAS	E, 4 WI	RE	& GRO	UND	)					MAIN MOUN	NTING
PA	ANEL EM		TY	PE	:	BOI	LT-ON		BUS:		100	AMPS	3					IXI LUGS ONLY ☐ SURF	ACE
• •			MIN	IIML	МСВ	INT	ERRUPT	ING (	CAPACIT	Y:	10	0,000	SYM	1. Al	MPS			□ CB 🖾 FLUS	Н
CKT	LOAD DESCRIPTION	L	RE	В	RKR	L		PH	ASE KVA	A LO	AD		L	BF	RKR	R	L	LOAD DESCRIPTION	CK
NO	AND LOCATION	G	C	P	Т	L	Α		В		С		L	Р	Т	С	G	AND LOCATION	NC
1	LTS-CORRIDOR			1	20		1.1	1.3						1	20	7		REC-EXAM RMOFFICE #50	
3	LTS-STAFF/OFFICE			1	20				1.7	1.0				1	20			REC-DINE/TV	- 4
5	LTS-BATHROOMKITCHEN			1	20		570.0				1.2	1.0		1	20			REC-DINE/TV	(
7	LTS-MED RESPITE			1	20		1.4	1.0						1	20			REC-DINE/TV	
9	LTS-EMERGENCY HOUSING			1	20				0.6	1.0				1	20			REC-DINE/TV	10
_	LTS-CORRIDOR EAST			1	20						0.9	0.7		1	20	4		REC-RECEPTION	1:
	LTS-WOMEN'S/MEN'S EAST			1	20		1.0	0.7						1	20	4		REC-COMPUTER/IT	14
15	LTS-MEN'S TRANSITIONAL			1	20				1.8	0.7				1	20	4		REC-COMPUTER/IT	1
_	LTS- WOMEN'S TRANSITIONAL			1	20						1.8	0.9		1	20	5		REC-OFFICE 20	18
19	LTS-LAUNDRY/LINEN/EXAM			1	20		0.6	0.9		3				1	20	5		REC-OFFICE 20	20
	LTS-DINING			1	20				1.6	0.7		7-		1	20	4		REC-OFFICE 16,17	2
_	LTS-RECEPTION		_	1	20						0.4	1.1		1	20	6		REC-OFFICE 18,19	2
	SPARE		_	1	20		1.0	1.0						1	20			SPARE	2
	SPARE			2	20					1.0		3		1	20			SPARE	2
29		1				_							2	1	20			SPARE	30
	SPARE			2	20		1.0							1	20			SPARE	32
33		_				$\perp$				1.0				1	20			REFRIG CONDENSATE VAPO	
	STEAMTABLE			2	30						2.2	1.2		2	20			REFRIG COND UNIT	36
37		1					2.2	1.2					-		- 3			N N	
	STEAMTABLE	_		2	30		b:		2.2	1.2				2	20			REFRIG COND UNIT	40
41		1_	_			_					2.2	1.2							
	ISOLATED GROUND BUS	SUE	вто	ΔΤΩ	IS		14.4	_	14.5		14.							PER PHASE	
	200% RATED NEUTRAL		1000				120		121	71122	123							PER PHASE	
		TO	TAL	CO	NNEC	TEC	LOAD			43.7	KVA+[	3.8	(LC	L) F	<va td="" x<=""><td>25%</td><td>6] =</td><td>47.5 KVA= 67</td><td>AMP</td></va>	25%	6] =	47.5 KVA= 67	AMP

P	ANEL EMX	92	TY	PE	: 1	ВОІ	S, 3 PI LT-ON ERRUPT		BUS:		225	AMP	S	M. A	MPS			MAIN  ☑ LUGS ONLY  ☐ CB	MOUN1 □ SURFA ☑ FLUSH	
CKT NO	LOAD DESCRIPTION AND LOCATION	L	R E	-	RKR	OL		PH	ASE K	VA LO	AD		L		RKR	R E	L	LOAD DESCR		CKT NO
		G	С	P	Т	L	Α		E	3	С		L	Р	Т	С	G		WI IOIY	2,235
_	LTS-EXTERIOR		Ш	1	20		0.6	0.3						2	20			LTS-PARKING		2
	LTS-BOLLARDS		$\sqcup$	1	20				0.7	0.3							$\simeq$		~~~	***
	LTS-TRELLIS/DRIVEWAY	-		1	20						0.1	1.0		1	20			LTS KENNEL		6
_	SPARE	-	$\sqcup$	1	20									1	20	_	$\sim$	SPARE		48
	SPARE	_	$\sqcup$	1	20									1	20			SPARE		10
	SPARE	4	$\sqcup$	1	20									1	20			SPARE		12
_	SPARE	-		1	20									1	20			SPARE		14
_	SPARE	1		1	20						-			1	20			SPARE		16
17	SPARE	_	$\sqcup$	1	20	_								1	20			SPARE		18
19			$\sqcup$			_	12.6							1	20			SPARE		20
	PANEL EM		Ш	3	100				13.7		- Annual I			1	20			SPARE		22
23		1_									15.8			1	20			SPARE		24
25		_	$\sqcup$																	26
27			$\sqcup$																	28
29			$\sqcup$													<u></u>				30
31		4	Ш							1			Ш							32
33		1																		34
35		+																		36
37		+	$\sqcup$																	38
39		+	$\sqcup$																	40
41		_							1/2-11			_								42
	ISOLATED GROUND BUS 200% RATED NEUTRAL	SU	вто	TA	LS		13.5 113		14 12		16. 14	-	45.200					ER PHASE PER PHASE		
		TO	TAL	CO	NNEC	TEC	LOAD			45.1	KVA+[	0.0	(LC	CL)	<b>KVA</b> x	25%	6] =	45.1 K	VA= 125	<b>AMPS</b>

_			12	0/2	08 V	DLT	S, 3 PHAS	E, 4 WIRE	& GROUNI	)					MAIN	MOUN	ITING
PA	ANEL K		TY	PE	: 1	BOI	LT-ON	BUS:	225 AMP	S					X LUGS ONLY	SURF	ACE
77 S. A.			MIN	IIMU	МСВ	INT	ERRUPTING	CAPACITY:	10,000	SY	M. A	MPS	100		□СВ	IX FLUS	н
CKT	LOAD DESCRIPTION AND LOCATION	L	R E	В	RKR	L	Pl	HASE KVA LO	)AD	L	В	RKR	R	L	LOAD DESCI		CK
NO	AND LOCATION	G	С	Р	Т	L	Α	В	С	L	Р	T	C	G	AND LOCA	IION	NO
1	DISPOSER			2	20		1.3 1.0				1	20			REC-KITCHEN		2
13			): 2:					1.3 1.0			1	20			REC-KITCHEN		4
5	REC-KITCHEN UNDER HOOD			1	20				1.0 1.0		1	20			REC-KITCHEN		6
7	SHUNT TRIP										1	20			SPARE		8
9	REC-KITCHEN UNDER HOOD			1	20			1.0			1	20			SPARE		10
11	SHUNT TRIP										1	20			SPARE		12
13	REC-KITCHEN UNDER HOOD			1	20		1.0	5 2			1	20			SPARE		14
	SHUNT TRIP		_					1.0			1	20			SPARE		16
17	SPARE			1	20				1.0		1	20			SPARE		18
	SPARE			1	20						2	20			SPARE		20
21	HOOD CONTROL PANEL		i i	1	20			0.5									22
	HOOD LIGHTS	į.		1	20		10 10		0.4		2	20			SPARE		24
25							0.7										26
	EXH FAN EF-1			3	15			0.7			2	20			SPARE		28
29									0.7								
31			Ĉ.				0.6	110			2	20			SPARE		32
	MAKE UP AIRE MUA-1		,	3	15			0.6									34
35	200 - 100 -	_							0.6		1	20			SPARE		36
37							3.0				1	20			SPARE		38
_	DISH WASHER			3	30			3.0			1	20			SPARE		40
41				$\vdash$					3.0		1	20			SPARE		42
	ISOLATED GROUND BUS	SIII	вто	TAI	9		7.6	9.1	7.7	CC	NN	ECTE	DK	/AP	ER PHASE		
	200% RATED NEUTRAL	301	טוכ	ΠAL	_0		63	76	64	CC	NN	ECTE	DA	<b>MPS</b>	PER PHASE		
		TO	TAL	CO	NNEC	TEC	LOAD	24.4	KVA+[ 0.0	(L	CL)	KVA x	25%	6] =	24.4 K	VA= 68	AMPS

P	ANEL LR		TY	PE	: 1	80	LT-ON		E, 4 WIRE BUS: CAPACITY:	100		S	VI. A	MPS				MOUN SURF	
CKT	LOAD DESCRIPTION	L	R	В	RKR	L		PH	ASE KVA LC	AD		ГС	В	RKR	R	L	LOAD DESCRI		CK
NO	AND LOCATION	G	C	P	Т	L	Α		В	С		L	Р	Т	С	G	AND LOCATI	ON	NO
1	REC-LAUNDRY			1	20		1.0	1.0					1	20			REC-LAUNDRY		2
3	REC-LAUNDRY			1	20				1.0 1.0				1	20			REC-LAUNDRY		4
5	REC-LAUNDRY			1	20					1.0	1.0		1	20			REC-LAUNDRY		6
7	REC-LAUNDRY			1	20		1.0	1.0					1	20			REC-LAUNDRY		8
	REC-LAUNDRY			1	20		18-57		1.0 1.0				1	20			REC-LAUNDRY		10
11	REC-LAUNDRY			1	20		225			1.0	1.0		1	20			REC-LAUNDRY		12
13	REC-LAUNDRY			1	20		1.0	1.0	70-				1	20			REC-LAUNDRY		14
	REC-LAUNDRY			1	20				1.0 1.0				1	20			REC-LAUNDRY		16
17	REC-LAUNDRY			1	20					1.0	0.8		1	20	4		REC-LAUNDRY ABO	VE CTR	
19	REC-LAUNDRY			1	20		1.0	1.0					1	20			REC-LAUNDRY		20
	REC-LAUNDRY			1	20				1.0 1.0	7.0	71		1	20			REC-LAUNDRY		22
23	REC-LAUNDRY			1	20		2020			1.0	1.0		1	20			SPARE		24
25	SPARE			1	20				<u> </u>				1	20			SPARE		26
27	SPARE			1	20		2,720						1	20			SPARE		28
29	SPARE			1	20						1		1	20			SPARE		30
31	SPARE			1	20								1	20			SPARE		32
33	SPARE			1	20								1	20			SPARE		34
35	SPARE			1	20				400				1	20			SPARE		36
37	SPARE			1	20						T T		1	20			SPARE		38
39	SPARE			1	20								1	20			SPARE		40
41	SPARE			1	20								1	20			SPARE		42
	ISOLATED GROUND BUS	CLI	D TO	ΤΛ.			8.0		8.0	7.8	3	CO	NN	ECTE	D K	VAP	ER PHASE		A 480
	200% RATED NEUTRAL	SU	ВТС	IA	LS		67		67	65	j	CO	NN	ECTE	DA	<b>MPS</b>	PER PHASE		
	The second secon	TO.	TAL	CO	NNEC	TEL	LOAD		23.8	KVA+[	0.0	(LC	CL)	KVAx	25%	6] =	23.8 KVA	= 66	AMPS

				12	0/2	08 V	OLT	S, 3 P	HAS	E, 4 WI	RE 8	& GRO	UNE	)					MAIN	MOUNT	ING
	PA	ANEL P1		TY	PE	:	BOI	T-ON		BUS:		225 A	MP	S					X LUGS ONLY	SURFAC	EΙ
				MIN	IMU	MCB	INT	ERRUPT			Υ.	10	000	SYI	M A	MPS			□СВ	X FLUSH	_
3			L	R			L	LI TITOL I	77.5270307		in vale	Control of the Contro	000	L			R	L			
	CKT	LOAD DESCRIPTION	T	E	В	RKR	C		PH	ASE KVA	LO	AD		С	B	RKR	Ε	T	LOAD DESCR		CKT
	NO	AND LOCATION	G	C	Р	Т	L	Α	Î	В		С		L	Р	Т	C	G	AND LOCA	TION	NO
	1	REC-STAFF MTG (COFFEE)		1	1	20		1.5	0.5				Ť		1	20			LCP POWER		2
3		REC-STAFF MTG (MICROWAVE)		1	1	20				1.5	0.5				1	20			TELEPHONE CABIN	IET .	4
.\ ]		REC-STAFF MTG (FRIDGE)		1	1	20						0.8	1.2		1	20	6		REC-BATHROOM		6
+\_ ]	7	REC-STAFF MTG (FRIDGE)		1	1	20		0.8	0.8						1	20	4		REC-BATHROOM		8
		REC-STAFF MTG CONV		1	1	20		97.9		1.5	1.2				1	20	6		REC-CORRIDOR		10
3	11	REC-STAFF MTG (DISPOSER)		5	1	20		8.0				1.0	1.0		1	20			REC-MEDICAL RES	PITE 5	12
	13	REC-STAFF MTG (ABOVE CTR)		2	1	20		0.4	1.0						1	20			REC-MEDICAL RES	PITE 5	14
	15	REC-DW		1	1	20				1.0	1.0				1	20			REC-MEDICAL RES	PITE 4	16
		REC-TOILETS		2	1	20						0.4	1.0		1	20			REC-MEDICAL RES	PITE 4	18
	19	SPARE			1	20			1.0						1	20			<b>REC-MEDICAL RES</b>	PITE 4	20
		SPARE			1	20					1.0	- 0			1	20			REC-MEDICAL RES	PITE 4	22
	23	WATER HTR CONTROL PNL			1	20						1.9	1.0		1	20			REC-EMERGENCY	HSG	24
	25	WATER HTR CONTROL PNL			1	20		1.9							1	20			SPARE		26
	27	REC/LTS ATTIC			1	20				0.3	- g				1	20			SPARE		28
		REC-CORRIDOR		4	1	20						0.7	0.6		1	20			EXH FAN EF-2		30
	31	REC-EXTERIOR		2	1	20		0.4							1	20			SPARE		32
		REC-EXTERIOR		2	1	20				0.4					1	20			SPARE		34
	_	SPARE			1	20									1	20			SPARE		36
3	_	SPARE			1	20			1.0						1	20			GENERAC BATTER	Y CHARGEF	
\		SPARE			1	20					1.0				1	20			GENERATOR HEAT	ER	40
7	41	SMOKE DETECTOR	Ш		1	20						0.1	0.5	_	1	20			EXH FANS 4,5,6,8		42
			SUE	R TC	ΤΔΙ	9		9.3		9.4		10.2		1					ER PHASE		
		ISOLATED GROUND BUS	JUL	, 10	11/1			78		78		85		CO	NN	ECTE	AA C	MPS	PER PHASE	*P100 #250-01	
,		200% RATED NEUTRAL	TOT	AL	CO	NNEC	TED	LOAD			28.9	KVA+[	0.0	(LC	CL)	KVA x	25%	6] =	28.9 K\	/A= 80	AMPS


_	ANIEL DO		348				The state of the s		E, 4 WI	RE 8								MAIN MOUNT	ING
PA	ANEL P2		TY	PE	:	BOI	LT-ON		BUS:		225 A	MP	S					☑ LUGS ONLY ☐ SURFA	CE
			MIN	IIMU	MCB	INT	ERRUPT	ING (	CAPACIT	Y:	10,	,000	SY	M. A	MPS			□ CB □ FLUSH	
CKT		L	R	В	RKR	L		PH	IASE KVA	LO	AD		L	В	RKR	R	L	LOAD DESCRIPTION	CI
NO	AND LOCATION	G	C	Р	Т	L	А		В		С		L	Р	Т	С	G	AND LOCATION	N
1	SPARE		3	1	20		0.6	1.0						1	20	5		REC-CORRIDOR	
3	SPARE		3	1	20				0.6	0.8				1	20	4		REC-MEN'S TRANSITIONAL	
_	SPARE		3	1	20		0.00				0.6	1.2		1	20	6		REC-WOMEN'S	
7	REC-TRANSITIONAL HSG			1	20		1.0	0.6						1	20	3		REC-CORRIDOR	
9	REC-TRANSITIONAL HSG			1	20				1.0	1.0				1	20			REC-WOMEN'S EMERGENCY	
11	REC-TRANSITIONAL HSG			1	20						1.0	1.0		1	20			REC-WOMEN'S TRANSITIONA	
13	REC-TRANSITIONAL HSG			1	20		1.0	1.0						1	20			REC-WOMEN'S TRANSITIONA	
15	REC-TRANSITIONAL HSG			1	20				1.0	1.0				1	20			REC-WOMEN'S TRANSITIONA	
17	KENNEL POWER			1	20		11111				1.0	1.0		1	20			REC-WOMEN'S TRANSITIONA	
19	KENNEL POWER			1	20		1.0	1.0						1	20			REC-MEN'S TRANSITIONAL	2
21	REC-MEN'S EMERG HSG			1	20		X-9/		0.2	1.0				1	20			SPARE	1
23	WATER HEATER CONT PNL			1	20			Ì		32	1.9	1.0		1	20			REC-MEN'S TRANSITIONAL	1
25	WATER HEATER CONT PNL			1	20		1.9	0.6						1	20			SPARE	1
27	REC/LTS-ATTIC			1	20				0.3					1	20			EXH FAN EF-3	1
29	SPARE			1	20									1	20			SPARE	3
31	SPARE			1	20									1	20			SPARE	1
	SPARE			1	20							1		1	20			SPARE	1
35	SPARE			1	20									1	20			SPARE	3
37																			3
39	SPARE			1	20									1	20			SPARE	4
41	SMOKE DETECTOR			1	20				174	20 33	0.1								1
	ISOLATED GROUND BUS 200% RATED NEUTRAL	SUE	вто	ATC	LS		9.7 81		6.9 58	- 3	8.8 73		-					PER PHASE	
$\forall$	200% RATED NEUTRAL	TO	TAI	00	NINIEO	TET				0E 4			_	_		_		PER PHASE	A N AT
Ш		110	IAL	CO	MINEC	IEL	LOAD			25.4	KVA+[	U.U	(L(	JL)	KVA x	25%	0] =	25.4 KVA= 71	AM

232525

D 4	NITI NA ++		1						E, 4 VVIRE								MAIN	MOUN	
PF	NEL M **		1	PE			LT-ON		BUS:	400 A							LUGS ONLY	SURFA	
	1.61		MIN	IIMU	MCB	INT	ERRUPT	ING (	CAPACITY:	10	,000	SY	M A	MPS			□ CB	FLUSH	<u> </u>
скт	LOAD DESCRIPTION	L	R	В	RKR	L		PH	ASE KVA LC	AD		L	В	RKR	R	L	LOAD DESCR		CI
NO	AND LOCATION	G	С	Р	Т	L	Α		В	С		L	Р	Т	С	G	AND LOCA	TION	N
1		7		$\vdash$		П	4.2	5.0					-						
3	AC-1			3	50				4.2 5.0	A.2540			3	50			AC-7		
5	100.000	- 8								4.2	5.0								-
1		-					3.6	2.8		1330									-
	AC-2			3	45				3.6 2.8				3	30			AC-8		
11		-								3.6	2.8								$\equiv$
13							3.6	4.2	<u>[                                    </u>										-
	AC-3			3	45				3.6 4.2				3	50			AC-9		
17										3.6	4.2		8						$=$ $\angle$
19							4.2	4.2		5									-/
	AC-4			3	50				4.2 4.2				3	50			AC-10		- 2
23										4.2	4.2								-/
25		-					2.6												_ ;
	AC-5			3	30				2.6	7.00			3	50			SPARE		
29		_								2.6							_		- 2
31		_	_				4.2	1.0					1	20			REC-ROOF		
	AC-6			3	50				4.2 0.5				1	20			DUCT SMOKE DET		;
35		_								4.2	0.1		1	20			FIRE SMOKE DAME	PER	
37												_	1	20			SPARE		;
	SPARE	$\perp$	_	3	20	Ш							1	20			SPARE		4
41		_									-		1	20			SPARE		1
	ISOLATED GROUND BUS	SU	вто	TAI	S		39.6		39.1	38.7		-					ER PHASE		
	200% RATED NEUTRAL						330	1	326	323		_			_		PER PHASE		
		TO	TAL	CO	NNEC	TEC	LOAD		117.4	KVA+[	0.0	(L	CL)	KVA x	25%	6] =	117.4 K	/A= 326	AM

120/208 VOLTS, 3 PHASE, 4 WRE & GROUND

PA	ANEL M2		TY	PE	: 1	ВО	TS, 3 PI LT-ON		BUS:		& GRO 400 A				.,			MAIN  IXI LUGS ONLY	MOUNT  SURFAC	
			MIN	IIMU	MCB	INT	ERRUPT	ING (	CAPACIT	Y:	10,	,000	SYI	M. A	MPS		500	□ CB	₩ FLUSH	
СКТ	LOAD DESCRIPTION	L	R	В	RKR	L		PH	ASE KV	A LO	AD		L	В	RKR	RE	L	LOAD DESC		СКТ
NO	AND LOCATION	G	C	P	Т	L	Α		В		C		L	Р	Т	С	G	AND LOCA	ATION	NO
1				F			0.6	0.8												- 2
3	AC-1 ECO POWER EXHAUST			3	15	1			0.6	0.8				3	15		j.	AC-7 ECO POWER	R EXHAUST	4
5		-									0.6	0.8								- 6
1		_					0.6	0.6					1							- 8
	AC-2 ECO POWER EXHAUST			3	15				0.6	0.6				3	15			AC-8 ECO POWER	REXHAUST	10
11		1		$\vdash$							0.6	0.6						G.		- 12
13							0.6	0.6									Ú			14
	AC-3 ECO POWER EXHAUST		_	3	15				0.6	0.6				3	15			AC-9 ECO POWER	R EXHAUST	16
17		1_	_	=							0.6	0.6								18
19		1_	-				0.6	0.6					1							20
_	AC-4 ECO POWER EXHAUST	-	_	3	15				0.6	0.6				3	15			AC-10 ECO POWE	R EXHAUST	22
23		1_	-	=		_	0.0	0.0			0.6	0.6		=		_				- 24
25	AO E EOO DOMED EVALATION	1—	1		45	_	0.6	0.6	0.0						45			ODADE		26
	AC-5 ECO POWER EXHAUST			3	15		ā.		0.6	0.6	0.0	0.0		3	15			SPARE		28
29		1—	-	F			0.0	4.0			0.6	0.6		4	00			ODADE		30
31	AC CECO DOWED EX MICE	1—	$\vdash$	3	15		0.6	1.0	0.0	4.0				1	20	_	-	SPARE SPARE		32
33	AC-6 ECO POWER EXHAUST	-	$\vdash$	3	15				0.6	1.0	0.6	1.0		1	20	-	-	SPARE		34 36
37			$\vdash$								0.0	1.0	5 0	1	20			SPARE		38
	SPARE		$\vdash$	3	20	9 9			18					1	20		ž	SPARE		40
41	OI ALL			J	20									1	20			SPARE		42
즴	ISOLATED GROUND BUS		<u> </u>				7.8		7.8		7.8		CO	MNI		D K	/Δ E	PER PHASE		42
님	200% RATED NEUTRAL	SU	BTC	ATC	LS		65		65		65	91						PER PHASE		
님	200/0 IVAILD INCOTION	TO	ΤΔΙ	CO	NNEC	TEL	LOAD		00		KVA+[	0.0			KVAx			777	VA= 65	AMPS

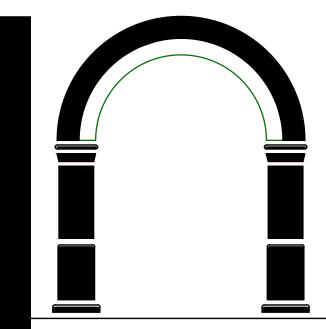

MOUNTING

CJ W ARCHITECTURE


130 Portola Road, suite A Portola Valley, CA 94028 (650) 851-9335 / (Fax) 851-9337

Tantech Engineers

MEP CONSULTING
ENGINEERS

1431 Cedar Street San Carlos, CA 94070 (415) 269-4283

These plans are copyrighted and are subject to copyright protection as an "architectural work" under Sec. 102 of the Copyright Act, 17 U.S.O. as amended December 1990 and known as Architectural Works Copyright Protection Act of 1990. The protection includes but is not limited to the overall form as well as the arrangement and composition of spaces and elements of the design. Under such protection, unauthorized use of these plans, work or home represented, can legally result in the cessation of construction or building being seized and /or monetary compensation to CJW Architecture.

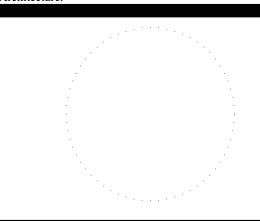

#### • PROJECT •

LifeMoves Maple Street Shelter 1580 Maple Street Redwood City CA 94063

• SHEET TITLE •

Panel Schedule

• REVISIONS •

No. Date
6.17.16
BLDG SUBMITTAL 1

8.15.16
PLAN CHECK # 1
ADDENDUM # 3


8.25.16
PLAN CHECK #2
ADDENDUM # 6

• JOB: 2015.2801

° DATE: 06/17/16

• SHEET: **E3.2** 

INDOOR LIGHTING GE-NRCCLTI-D IE, (Revised soft) GENRCLTI-D IE, (Revised soft) Indoor Lighting Repeal of 6] Project Name: LifeMoves Maple St  A. General Information  Glimate Zone: Conditioned Floor Area: 10,173 3 Unconditioned Floor Area: 730  Building Type: Conditioned Spaces Cond	STATE OF CALIFORNIA  INDOOR LIGHTING CEC-NRCCLTI-01-E (Revised 08/15) CERTIFICATE OF COMPLIANCE Indoor Lighting Project Name: LifeMoves Maple St  C. Summary of Allowed Lighting Power Conditioned and Unconditioned space Lighting must not be combined for compliance Indoor Lighting Power for Conditioned Spaces    NRCC-LTI-01-E, page 4	Allowed Lighting Power Unconditioned NRCC-LTI-03-E, page 1  Dies and verify forms are completed and signed.)  Field Inspector  Integral current limiter, or for a supplementary ack lighting, to be recognized for compliance.  Trying an auditorium, a convention center, a ized for compliance.  Field Inspector  Field Inspector  Field Inspector  Field Inspector  Field Inspector	INDOOR LIGHTING  GEO.NRCOLTID-1E (Revised 08/15)  CERTIFICATE OF COMPLIANCE Indoor Lighting  Project Name: LifeMoves Maple St  E. Declaration of Required Certificates of Acceptance Declare by checking all of the Certificates of Acceptance that will be submitted. (Retain copies and verify forms  YES NO Form/Title  V NRCA-LTI-02-A - Must be submitted for occupancy sensors and automatic time switch co  V NRCA-LTI-03-A - Must be submitted for automatic daylight controls.  V NRCA-LTI-04-A - Must be submitted for demand responsive lighting controls.  A separate Lighting Schedule Must Be Filled Out for Conditioned and Unconditioned Spaces. Installed Lighting CONDITIONED SPACE  F. Indoor Lighting Schedule and Field Inspection Energy Checklist  The actual Indoor lighting power listed on this page and on the next page includes all installed permanent and When Complete Building Method is used for compliance, list each different type of luminaire on separate I when Complete Building Method or Tailored Method is used for compliance, list each different type of luminaire on separate I have a category Method or Tailored Method is used for compliance, list each different type of luminaire on separate I have a category Method or Tailored Method is used for compliance form (NRCC-LTI-05-E) when	pontrols.
CA Building Energy Efficiency Standards - 2013 Nonresidential Compliance  August 2015	CA Building Energy Efficiency Standards - 2013 Nonresidential Compliance	August 2015	CA Building Energy Efficiency Standards - 2013 Nonresidential Compliance	August 2015
NDOOR LIGHTING GEO-MECCELTHOLE (presented 6th) GEO-MECCELTHOLE (presented 6th) GEO-MECCELTHOLE (presented 6th) GEO-MECCELTHOLE (presented 6th) Indoor Lighting Indoor Lighting GEO-MECCELTHOLE (presented 6th) Indoor Lighting	Complete Luminaire Description (i.e., LED, under cabinet, furniture mounted (i.e., LED, under cabinet, furnitur	ned for any office the same general and portable lighting) may be grouped together. This allowance  atts Per Square Foot Office Location Field Inspector  6 7 8 9 10  If F ≤ 0.3, Watts enter per zero; square G05 x G07 Which these portable Iuminaires are installed  (G04 / 0.3, G05) (G06-0.3)  G05 G06-0.3  Enter sum total of all pages into NRCC-LTI-	INDOOR LIGHTING CEC-NRGC-LT-LOT-E (Revised 08/15) CERTIFICATE OF COMPILANCE Indoor Lighting Project Name: LifeMoves Maple St  A separate Lighting Schedule Must Be Filled Out for Conditioned and Unconditioned Spaces. Installed Lighting F  CONDITIONED SPACE  UNCONDITIONED SPACE  HINDOOR LIGHTING SCHEDULE and FIELD INSPECTION ENERGY CHECKLIST  Luminaire Schedule  A  B  C  D  E  F  How wastage was determined  O  Complete Luminaire Description  Lee, 3 lamp fluorescent troffer,  E  E  S  S  S  S  S  S  S  S  S  S  S	Location   Field Inspector 1   G   H
CA Building Energy Efficiency Standards - 2013 Nonresidential Compliance  August 2015	CA Building Energy Efficiency Standards - 2013 Nonresidential Compliance	August 2015	CA Building Energy Efficiency Standards - 2013 Nonresidential Compliance	August 2015

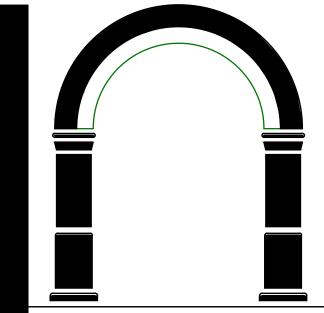


CJ W ARCHITECTURE

130 Portola Road, suite A Portola Valley, CA 94028 (650) 851-9335 / (Fax) 851-9337

# Tantech Engineers MEP CONSULTING ENGINEERS

1431 Cedar Street San Carlos, CA 94070 (415) 269-4283

These plans are copyrighted and are subject to copyright protection as an "architectural work" under Sec. 102 of the Copyright Act, 17 U.S.O. as amended December 1990 and known as Architectural Works Copyright Protection Act of 1990. The protection includes but is not limited to the overall form as well as the arrangement and composition of spaces and elements of the design. Under such protection, unauthorized use of these plans, work or home represented, can legally result in the cessation of construction or building being seized and /or monetary compensation to CJW Architecture.

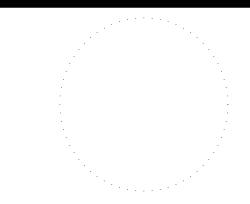

• PROJECT •

LifeMoves Maple Street Shelter 1580 Maple Street Redwood City CA 94063

• SHEET TITLE •

Title 24 Lighting

• REVISIONS •
---------------


No.	Date	Notes
	6.17.16	BLDG SUBMITTAL 1
2	8.15.16	PLAN CHECK # 1 ADDENDUM # 3
<u>3</u>	8.25.16	ADDENDUM # 5
4	9.23.16	PLAN CHECK #2 ADDENDUM # 6

• JOB: 2015.2801

° DATE: 06/17/16

• SHEET: **E4.1** 

A separate Lighting Schedule Must Be Filled Out for Conditioned and Unconditioned Spaces. Installed Lighting Power listed on this Lighting Schedule Display Conditioned Space    H. INDOOR LIGHTING SCHEDULE and FIELD INSPECTION ENERGY CHECKUST  Luminaire Schedule	Indoor Lig							
BLINDOORLIGHTING SCHOLUS and FIELD INSPECTION ENERGY CHECKLIST   Luminale Schedule   December   D	Project Nam	e: LifeMoves Maple St						Date Prepared: 9/24/2016
Luminaire Schedule  B C D D D D D D D D D D D D D D D D D	1			conditioned	l Spaces.	Installed L	ighting Pow	er listed on this Lighting Schedu
Luminaire Schedule  B C D D D D D D D D D D D D D D D D D	H INDO	DE LICHTING SCHEDULE and FIELD INSPECTION	ENERCY CHEC	VIICT				
How wattige was determined by the control of the co	H. INDOC		ENERGY CHEC		nstalled W	atts		Location
Complete luminaire Description  By B	Α	В	С			Е	F	G
A 30W LED 30.0 P 9 19 570 Office <= 250 self.  B 73w LED 73.0 P 9 6 438 Kilchen. Food Preparation  B 73w LED 73.0 P 9 6 438 Kilchen. Food Preparation  B 73w LED 24.1 P 9 22 530 Corridor/Restroom/Suppo  B 73w LED 24.1 P 9 22 530 Corridor/Restroom/Suppo  B 23 42w LED 24.1 P 9 1 22 530 Corridor/Restroom/Suppo  B 23 43w LED 34.3 P 11 377 Corridor/Restroom/Suppo  C 1 10W LED 10.0 P 11 377 Corridor/Restroom/Suppo  C 2 2w LED 34.3 P 10.0 P 18 504 Corridor/Restroom/Suppo  C 2 2w LED 35.0 P 18 504 Corridor/Restroom/Suppo  C 3 35w LED 35.0 P 2 18 504 Corridor/Restroom/Suppo  B 35.0 P 2 70 Corridor/Restroom/Suppo  B 35.0 P 2 70 Corridor/Restroom/Suppo  B 18 504 Corridor/Restroom/Suppo  B					-		e e	
A 30W LED 30.0 P 9 19 570 Office <= 250 self.  B 73w LED 73.0 P 9 6 438 Kilchen. Food Preparation  B 73w LED 73.0 P 9 6 438 Kilchen. Food Preparation  B 73w LED 24.1 P 9 22 530 Corridor/Restroom/Suppo  B 73w LED 24.1 P 9 22 530 Corridor/Restroom/Suppo  B 23 42w LED 24.1 P 9 1 22 530 Corridor/Restroom/Suppo  B 23 43w LED 34.3 P 11 377 Corridor/Restroom/Suppo  C 1 10W LED 10.0 P 11 377 Corridor/Restroom/Suppo  C 2 2w LED 34.3 P 10.0 P 18 504 Corridor/Restroom/Suppo  C 2 2w LED 35.0 P 18 504 Corridor/Restroom/Suppo  C 3 35w LED 35.0 P 2 18 504 Corridor/Restroom/Suppo  B 35.0 P 2 70 Corridor/Restroom/Suppo  B 35.0 P 2 70 Corridor/Restroom/Suppo  B 18 504 Corridor/Restroom/Suppo  B							illed nis ar (č	
A 30W LED 30.0 P 9 19 570 Office <= 250 self.  B 73w LED 73.0 P 9 6 438 Kilchen. Food Preparation  B 73w LED 73.0 P 9 6 438 Kilchen. Food Preparation  B 73w LED 24.1 P 9 22 530 Corridor/Restroom/Suppo  B 73w LED 24.1 P 9 22 530 Corridor/Restroom/Suppo  B 23 42w LED 24.1 P 9 1 22 530 Corridor/Restroom/Suppo  B 23 43w LED 34.3 P 11 377 Corridor/Restroom/Suppo  C 1 10W LED 10.0 P 11 377 Corridor/Restroom/Suppo  C 2 2w LED 34.3 P 10.0 P 18 504 Corridor/Restroom/Suppo  C 2 2w LED 35.0 P 18 504 Corridor/Restroom/Suppo  C 3 35w LED 35.0 P 2 18 504 Corridor/Restroom/Suppo  B 35.0 P 2 70 Corridor/Restroom/Suppo  B 35.0 P 2 70 Corridor/Restroom/Suppo  B 18 504 Corridor/Restroom/Suppo  B	or	Complete Luminaire Description	per	efault IA8	ling to (c)	er aires	Insta in th	
A 30W LED 30.0 □ □ 19 570 Office < 250 sqf.  B 73w LED 73.0 □ □ 6 438 Kitchen, Food Preparation  B 73w LED 73.0 □ □ 6 438 Kitchen, Food Preparation  B 73w LED 24.1 □ □ 22 530 Confider/Restroom/Suppc  B 73w LED 24.1 □ □ 12 2530 Confider/Restroom/Suppc  B 23 42w LED 24.1 □ □ 13 27 All Others  B 23 43w LED 34.3 □ □ 11 377 Confider/Restroom/Suppc  C 1 10W LED 10.0 □ 18 504 Confider/Restroom/Suppc  C 2 2w LED 34.3 □ □ 18 504 Confider/Restroom/Suppc  C 2 2w LED 35.0 □ □ 18 504 Confider/Restroom/Suppc  C 3 35w LED 35.0 □ □ 18 504 Confider/Restroom/Suppc  C 3 35w LED 35.0 □ □ 18 504 Confider/Restroom/Suppc  B 35w LED 35.0 □ □ 18 504 Confider/Restroom/Suppc  C 2 2w LED 35.0 □ □ 18 504 Confider/Restroom/Suppc  C 2 2w LED 35.0 □ □ 18 504 Confider/Restroom/Suppc  C 2 2w LED 35.0 □ □ 18 504 Confider/Restroom/Suppc  C 2 2w LED 35.0 □ □ 18 504 Confider/Restroom/Suppc  C 2 2w LED 35.0 □ □ 18 504 Confider/Restroom/Suppc  C 2 2w LED 35.0 □ □ 18 504 Confider/Restroom/Suppc  C 3 35w LED 35.0 □ □ 18 504 Confider/Restroom/Suppc  C 3 35w LED 35.0 □ □ 18 504 Confider/Restroom/Suppc  C 3 35w LED 35.0 □ □ 18 504 Confider/Restroom/Suppc  C 3 35w LED 35.0 □ □ 18 504 Confider/Restroom/Suppc  C 3 35w LED 35.0 □ □ 18 504 Confider/Restroom/Suppc  C 3 35w LED 35.0 □ □ 18 504 Confider/Restroom/Suppc  C 3 35w LED 35.0 □ □ 18 504 Confider/Restroom/Suppc  C 4 504 Confider/Restroom/Suppc  C 5 504 Confider/Suppc  C 5 504 Confider/Suppc  C 5 504 Confider/Suppc  C 5 504 Confider/Suppc  C 5 504 Confid	Jame tem <sup>-</sup>		Vatts	EC De	130.0	lumk umir	otal Vatts H03 3	· ·
STATE OF CALIFORNIA  INSTALLED   73.0   0   6   4.58   Confident/Restroom/Suppo B   73W LED   73.0   0   6   4.58   Stochen. Food Preparation B   24 LH LED   24.1   0   22   5.30   Confident/Restroom/Suppo B   24 LW LED   32.0   0   1   32   All Others B   34.3   0   1   11   37   Confident/Restroom/Suppo B   34.3   0   1   11   37   Confident/Restroom/Suppo C   11   10W LED   10.0   0   16   6   60   Confident/Restroom/Suppo C   2   28W LED   28.0   0   18   504   Confident/Restroom/Suppo C   2   28W LED   28.0   0   0   18   504   Confident/Restroom/Suppo C   3   35W LED   35.0   0   0   2   7.0   Confident/Restroom/Suppo C   3   35W LED   35.0   0   0   2   7.0   Confident/Restroom/Suppo C   3   35W LED   35.0   0   0   2   7.0   Confident/Restroom/Suppo C   3   35W LED   35.0   0   0   2   7.0   Confident/Restroom/Suppo C   3   35W LED   35.0   0   0   0   0   3   3   3   3   3		· · · · · · · · · · · · · · · · · · ·						
B. TAWLED		7,11 ===						
B1 24.1w LED								
AS WELED 32.0								· ·
Set Set Complete Set Set Complete Set Set Set Set Set Set Set Set Set						1		1
C1 10W LED 10.0				-		11		
C2 28W LED 28.0 0 18 504 Corridor/Restroom/Support C3 35W LED 35.0 0 1 2 70 Corridor/Restroom/Support C3 35W LED 35.0 0 1 2 70 Corridor/Restroom/Support C3 SW LED 35.0 0 0 1 2 70 Corridor/Restroom/Support C3 SW LED 35.0 0 0 1 2 70 Corridor/Restroom/Support C3 SW LED 35.0 0 0 0 0 0 0 0 0 0 0 0 0 0 0 0 0 0 0				-				1 '''
CA Building Energy Efficiency Standards - 2013 Nonresidential Compliance  CA Building Energy Efficiency Standards - 2013 Nonresidential Compliance  STATE OF CALIFORNIA  NECC-LTI-01-E; Page 2  NRCC-LTI-01-E;								1
INSTALLED WATTS PAGE TOTAL:  A Building Energy Efficiency Standards - 2013 Nonresidential Compliance  STATE OF CALIFORNIA  INDOOR LIGHTING  RECHTICATE Reviewed 0019  CALIFORNI  CERTIFICATE OF COMPLIANCE  Indoor Lighting  Project Name: LifeNowed 0019  CALIFORNI  CERTIFICATE OF COMPLIANCE  1. Lectrify that this Certificate of Compliance documentation is accurate and complete.  DOCUMENTATION AUTHOR'S DECLARATION STATEMENT  1. Lectrify that this Certificate of Compliance documentation is accurate and complete.  Documentation Author Name: Tantech Engineers  Organic: 1431 Cedar St  CRystate Or						2		
CA Building Energy Efficiency Standards - 2013 Nonresidential Compliance  STATE OF CALIFORRIA  NDOOR LIGHTING  SECENTICATE Interested But 19  Date Prepared: 9/24/2016  Date Prepared: 9/24/2016  Date Prepared: 9/24/2016  Decumentation Author Name: Interested Progress of Security Pro		, con 225		TALLED W	ATTS PAG	SE TOTAL:		Enter sum total of all pages
TATE OF CALIFORNIA  NDOOR LIGHTING  ECRNECCLIFLOT (Revised 08/15)  CERTIFICATE OF COMPLIANCE  Indoor Lighting  Project Name: LifeMoves Maple St  Date Prepared: 9/24/2016  DOCUMENTATION AUTHOR'S DECLARATION STATEMENT  1. I certify that this Certificate of Compliance documentation is accurate and complete.  Documentation Author Name:  Tantech Engineers  Documentation Author Signature:  Tantech Engineers  Signature Date: 9/24/2016  CCA Certification Identification (if applicable):  Lity/State/Zip:  San Carlos, CA 94070  RESPONSIBLE PERSON'S DECLARATION STATEMENT  I certify the following under penalty of perjury, under the laws of the State of California:  1. The information provided on this Certificate of Compliance is true and correct.  2. I ame ligible under Division 3 of the Business and Professions Code to accept responsibility for the building design or system design identified on this Certific (responsible designer).  3. The energy features and performance specifications, materials, components, and manufactured devices for the building design or system design identified Compliance conform to the requirements of Title 24, Part 1 and Part 6 of the California Code of Regulations.  4. The building design features or system design features identified on this Certificate of Compliance are consistent with the information provided on other at documents, worksheets, calculations, plans and specifications submitted to the enforcement agency for an approval with this building permit application.  5. I will ensure that a completed signed copy of this Certificate of Compliance and performance agency for all applicable inspections. I understand that a completed signed copy of this Certificate of Compliance is required to be included we builder provides to the building owner at occupancy.  Responsible Designer Name:  TANTECH ENGINEERS  Date Signed:  1431 CEDAR ST  Date Signed:  1431 CEDAR ST								, ,
DOCUMENTATION AUTHOR'S DECLARATION STATEMENT	CA Building	g Energy Efficiency Standards - 2013 Nonresidential Co	ompliance					
Date Prepared: 9/24/2016			ompliance					
Project Name: LifeMoves Maple St   Date Prepared: 9/24/2016	STATE OF CA	ALIFORNIA R LIGHTING	ompliance					CALIFORNI
DOCUMENTATION AUTHOR'S DECLARATION STATEMENT  1. I certify that this Certificate of Compliance documentation is accurate and complete.  Documentation Author Name:  Tantech Engineers  Company:  Tantech Engineers  Address:  1431 Cedar St  City/State/Zip:  San Carlos, CA 94070  RESPONSIBLE PERSON'S DECLARATION STATEMENT  I certify the following under penalty of perjury, under the laws of the State of California:  1. The information provided on this Certificate of Compliance is true and correct.  2. I am eligible under Division 3 of the Business and Professions Code to accept responsibility for the building design or system design identified on this Certifications, materials, components, and manufactured devices for the building design or system design identified Compliance conform to the requirements of Title 24, Part 1 and Part 6 of the California Code of Regulations.  4. The building design features or system design features identified on this Certificate of Compliance are consistent with the information provided on other a documents, worksheets, calculations, plans and specifications submitted to the enforcement agency for approval with this building permit application.  5. I will ensure that a completed signed copy of this Certificate of Compliance shall be made available with the building permit application.  5. I will ensure that a completed signed copy of this Certificate of Compliance shall be made available with the building permit application.  6. TANTECH ENGINEERS  Responsible Designer Signature:  TANTECH ENGINEERS  Company:  TANTECH ENGINEERS  Date Signed:  1431 CEDAR ST	STATE OF CA	ALIFORNIA R LIGHTING TI-01-E (Revised 08/15)	ompliance					CALIFORN
1. I certify that this Certificate of Compliance documentation is accurate and complete.    Documentation Author Name: Tantech Engineers   Documentation Author Signature:	STATE OF CA INDOOF CEC-NRCC-L CERTIFICA	ALIFORNIA R LIGHTING TI-01-E (Revised 08/15) TE OF COMPLIANCE	ompliance					CALIFORN
Documentation Author Name: Tantech Engineers   Documentation Author Signature:	STATE OF CA INDOOF CEC-NRCC-L CERTIFICA Indoor Lig	ALIFORNIA R LIGHTING TI-01-E (Revised 08/15) TE OF COMPLIANCE thting	ompliance					
Company: Tantech Engineers	STATE OF CA INDOOF CEC-NRCC-L CERTIFICA Indoor Lig Project Nam	ALIFORNIA R LIGHTING TI-01-E (Revised 08/15) TE OF COMPLIANCE thting e: LifeMoves Maple St						
Address: 1431 Cedar St  City/State/Zip: San Carlos, CA 94070  RESPONSIBLE PERSON'S DECLARATION STATEMENT  I certify the following under penalty of perjury, under the laws of the State of California:  1. The information provided on this Certificate of Compliance is true and correct.  2. I am eligible under Division 3 of the Business and Professions Code to accept responsibility for the building design or system design identified on this Certific (responsible designer).  3. The energy features and performance specifications, materials, components, and manufactured devices for the building design or system design identified Compliance conform to the requirements of Title 24, Part 1 and Part 6 of the California Code of Regulations.  4. The building design features or system design features identified on this Certificate of Compliance are consistent with the information provided on other a documents, worksheets, calculations, plans and specifications submitted to the enforcement agency for approval with this building permit application.  5. I will ensure that a completed signed copy of this Certificate of Compliance shall be made available with the building permit(s) issued for the building, and enforcement agency for all applicable inspections. I understand that a completed signed copy of this Certificate of Compliance is required to be included we builder provides to the building owner at occupancy.  Responsible Designer Name:  TANTECH ENGINEERS  Company:  TANTECH ENGINEERS  Date Signed:  ChildState/Zip.  Date Signed:  ChildState/Zip.  Date Signed:  ChildState/Zip.  Date Signed:	STATE OF CA INDOOF CEC-NRCC-L CERTIFICA Indoor Lig Project Nam  DOCUMEN 1.   Certification	ALIFORNIA R LIGHTING TI-01-E (Revised 08/15) ATE OF COMPLIANCE Athing e: LifeMoves Maple St  ATATION AUTHOR'S DECLARATION STATEMENT fy that this Certificate of Compliance documentation an Author Name:		complete.	Docum	entation Autho		
City/State/Zip:  San Carlos, CA 94070  RESPONSIBLE PERSON'S DECLARATION STATEMENT  I certify the following under penalty of perjury, under the laws of the State of California:  The information provided on this Certificate of Compliance is true and correct.  I am eligible under Division 3 of the Business and Professions Code to accept responsibility for the building design or system design identified on this Certificate of Compliance conform to the requirements of Title 24, Part 1 and Part 6 of the California Code of Regulations.  The building design features or system design features identified on this Certificate of Compliance are consistent with the information provided on other and occuments, worksheets, calculations, plans and specifications submitted to the enforcement agency for approval with this building permit application.  I will ensure that a completed signed copy of this Certificate of Compliance shall be made available with the building permit(s) issued for the building, and is enforcement agency for all applicable inspections. I understand that a completed signed copy of this Certificate of Compliance is required to be included we builder provides to the building owner at occupancy.  Responsible Designer Name:  TANTECH ENGINEERS  Company:  TANTECH ENGINEERS  Date Signed:  Company:  TANTECH ENGINEERS  Company:  TANTECH ENGINEERS  Date Signed:  Compliance Carlos Address:  License:  License:  Company:	STATE OF CA INDOOF CEC-NRCC-L CERTIFICA Indoor Lig Project Nam  DOCUMEN 1. I certi Documentation	ALIFORNIA R LIGHTING TI-01-E (Revised 08/15) TE OF COMPLIANCE thting e: LifeMoves Maple St  ITATION AUTHOR'S DECLARATION STATEMENT fy that this Certificate of Compliance documentation on Author Name: Tantech Engineers		complete.		re Date:	or Signature:	
RESPONSIBLE PERSON'S DECLARATION STATEMENT  I certify the following under penalty of perjury, under the laws of the State of California:  The information provided on this Certificate of Compliance is true and correct.  I am eligible under Division 3 of the Business and Professions Code to accept responsibility for the building design or system design identified on this Certificate of Compliance conform to the requirements of Title 24, Part 1 and Part 6 of the California Code of Regulations.  The building design features or system design features identified on this Certificate of Compliance are consistent with the information provided on other a documents, worksheets, calculations, plans and specifications submitted to the enforcement agency for approval with this building permit application.  I will ensure that a completed signed copy of this Certificate of Compliance shall be made available with the building permit(s) issued for the building, and renforcement agency for all applicable inspections. I understand that a completed signed copy of this Certificate of Compliance is required to be included we builder provides to the building owner at occupancy.  Responsible Designer Name:  TANTECH ENGINEERS  Company:  TANTECH ENGINEERS  Date Signed:  Company:  TANTECH ENGINEERS  Date Signed:  Company:	STATE OF CANDOOF CEC-NRCC-L CERTIFICA Indoor Lig Project Nam  DOCUMEN 1. I certi Documentati Company:	ALIFORNIA R LIGHTING TI-01-E (Revised 08/15) TE OF COMPLIANCE thting e: LifeMoves Maple St  ITATION AUTHOR'S DECLARATION STATEMENT fy that this Certificate of Compliance documentation on Author Name: Tantech Engineers Tantech Engineers		complete.	Signatu	re Date: 9/2	or Signature:	Date Prepared: 9/24/2016
I certify the following under penalty of perjury, under the laws of the State of California:  1. The information provided on this Certificate of Compliance is true and correct.  2. I am eligible under Division 3 of the Business and Professions Code to accept responsibility for the building design or system design identified on this Certificate of Compliance designer).  3. The energy features and performance specifications, materials, components, and manufactured devices for the building design or system design identified Compliance conform to the requirements of Title 24, Part 1 and Part 6 of the California Code of Regulations.  4. The building design features or system design features identified on this Certificate of Compliance are consistent with the information provided on other and documents, worksheets, calculations, plans and specifications submitted to the enforcement agency for approval with this building permit application.  5. I will ensure that a completed signed copy of this Certificate of Compliance shall be made available with the building permit(s) issued for the building, and renforcement agency for all applicable inspections. I understand that a completed signed copy of this Certificate of Compliance is required to be included we builder provides to the building owner at occupancy.  Responsible Designer Name:  TANTECH ENGINEERS  Address:  1431 CEDAR ST  License:  Company:  TANTECH ENGINEERS  Address:  1431 CEDAR ST	STATE OF CAINDOOF CEC-NRCC-L CERTIFICA Indoor Lig Project Nam  DOCUMEN 1. I certi Documentati Company: Address:	ALIFORNIA R LIGHTING TI-01-E (Revised 08/15) TTE OF COMPLIANCE Thiting E: LifeMoves Maple St  ITATION AUTHOR'S DECLARATION STATEMENT To that this Certificate of Compliance documentation on Author Name: Tantech Engineers  Tantech Engineers  1431 Cedar St		complete.	Signatu CEA Ce	re Date: 9/2 rtification Iden	or Signature:	Date Prepared: 9/24/2016
<ol> <li>The information provided on this Certificate of Compliance is true and correct.</li> <li>I am eligible under Division 3 of the Business and Professions Code to accept responsibility for the building design or system design identified on this Certific (responsible designer).</li> <li>The energy features and performance specifications, materials, components, and manufactured devices for the building design or system design identified Compliance conform to the requirements of Title 24, Part 1 and Part 6 of the California Code of Regulations.</li> <li>The building design features or system design features identified on this Certificate of Compliance are consistent with the information provided on other all documents, worksheets, calculations, plans and specifications submitted to the enforcement agency for approval with this building permit application.</li> <li>I will ensure that a completed signed copy of this Certificate of Compliance shall be made available with the building permit(s) issued for the building, and in enforcement agency for all applicable inspections. I understand that a completed signed copy of this Certificate of Compliance is required to be included we builder provides to the building owner at occupancy.</li> <li>Responsible Designer Name:</li></ol>	STATE OF CAINDOOF CEC-NRCC-L CERTIFICA Indoor Lig Project Nam  DOCUMEN 1. I certi Documentati Company: Address:	ALIFORNIA R LIGHTING TI-01-E (Revised 08/15) TE OF COMPLIANCE Thing E: LifeMoves Maple St  TATION AUTHOR'S DECLARATION STATEMENT Try that this Certificate of Compliance documentation on Author Name: Tantech Engineers Tantech Engineers 1431 Cedar St		complete.	Signatu CEA Ce	re Date: 9/2 rtification Iden	or Signature: 4/2016 utification (if applic	Date Prepared: 9/24/2016
<ul> <li>The energy features and performance specifications, materials, components, and manufactured devices for the building design or system design identified Compliance conform to the requirements of Title 24, Part 1 and Part 6 of the California Code of Regulations.</li> <li>The building design features or system design features identified on this Certificate of Compliance are consistent with the information provided on other at documents, worksheets, calculations, plans and specifications submitted to the enforcement agency for approval with this building permit application.</li> <li>I will ensure that a completed signed copy of this Certificate of Compliance shall be made available with the building permit(s) issued for the building, and renforcement agency for all applicable inspections. I understand that a completed signed copy of this Certificate of Compliance is required to be included we builder provides to the building owner at occupancy.</li> <li>Responsible Designer Name: TANTECH ENGINEERS</li> <li>Company: TANTECH ENGINEERS</li> <li>Date Signed:</li> <li>License:</li> <li>City(State/City)</li> </ul>	STATE OF CAINDOOF CEC-NRCC-L CERTIFICA Indoor Lig Project Nam  DOCUMEN 1. I certi Documentati Company: Address: City/State/Zig	ALIFORNIA R LIGHTING TI-01-E (Revised 08/15) TTE OF COMPLIANCE Thing e: LifeMoves Maple St  TTATION AUTHOR'S DECLARATION STATEMENT fy that this Certificate of Compliance documentation on Author Name: Tantech Engineers Tantech Engineers 1431 Cedar St : San Carlos, CA 94070		complete.	Signatu CEA Ce	re Date: 9/2 rtification Iden	or Signature: 4/2016 utification (if applic	
Compliance conform to the requirements of Title 24, Part 1 and Part 6 of the California Code of Regulations.  4. The building design features or system design features identified on this Certificate of Compliance are consistent with the information provided on other all documents, worksheets, calculations, plans and specifications submitted to the enforcement agency for approval with this building permit application.  5. I will ensure that a completed signed copy of this Certificate of Compliance shall be made available with the building permit(s) issued for the building, and renforcement agency for all applicable inspections. I understand that a completed signed copy of this Certificate of Compliance is required to be included we builder provides to the building owner at occupancy.  Responsible Designer Name:  TANTECH ENGINEERS  Address:  1431 CEDAR ST  Responsible Designer Signature:  License:  License:  Phone:	STATE OF CAINDOOF CEC-NRCC-L CERTIFICA Indoor Lig Project Nam  DOCUMEN 1. I certif Documentati Company: Address: City/State/Zig RESPONSI I certify th 1. The i 2. I am	ALIFORNIA R LIGHTING TI-01-E (Revised 08/15) TTE OF COMPLIANCE Thing e: LifeMoves Maple St  TATION AUTHOR'S DECLARATION STATEMENT fy that this Certificate of Compliance documentation on Author Name: Tantech Engineers Tantech Engineers 1431 Cedar St : San Carlos, CA 94070 BLE PERSON'S DECLARATION STATEMENT e following under penalty of perjury, under the laws of formation provided on this Certificate of Compliance eligible under Division 3 of the Business and Profession	is accurate and o	alifornia: ect.	Signatu CEA Cei Phone:	re Date: 9/2- rtification Ider 415-269-	or Signature: 4/2016 httification (if application)	Date Prepared: 9/24/2016
documents, worksheets, calculations, plans and specifications submitted to the enforcement agency for approval with this building permit application.  5. I will ensure that a completed signed copy of this Certificate of Compliance shall be made available with the building permit(s) issued for the building, and renforcement agency for all applicable inspections. I understand that a completed signed copy of this Certificate of Compliance is required to be included we builder provides to the building owner at occupancy.  Responsible Designer Name:  TANTECH ENGINEERS  Address:  1431 CEDAR ST  Responsible Designer Signature:  License:  Date Signed:  License:	STATE OF CAINDOOF CEC-NRCC-L CERTIFICA Indoor Lig Project Nam  DOCUMEN 1. I certif Documentati Company: Address: City/State/Zig RESPONSI I certify th 1. The i 2. I am (resp	ALIFORNIA R LIGHTING TI-01-E (Revised 08/15) TTE OF COMPLIANCE Thiting e: LifeMoves Maple St  TATION AUTHOR'S DECLARATION STATEMENT fy that this Certificate of Compliance documentation on Author Name: Tantech Engineers Tantech Engineers 1431 Cedar St : San Carlos, CA 94070 BLE PERSON'S DECLARATION STATEMENT e following under penalty of perjury, under the laws of formation provided on this Certificate of Compliance eligible under Division 3 of the Business and Professionsible designer).	is accurate and o	alifornia: ect. pt responsik	Signatu CEA Cei Phone:	re Date: 9/2: rtification Ider 415-269:	or Signature: 4/2016 httfication (if application) -4283	Date Prepared: 9/24/2016  Table):  m design identified on this Certifi
5. I will ensure that a completed signed copy of this Certificate of Compliance shall be made available with the building permit(s) issued for the building, and a enforcement agency for all applicable inspections. I understand that a completed signed copy of this Certificate of Compliance is required to be included we builder provides to the building owner at occupancy.  Responsible Designer Name:  TANTECH ENGINEERS  Company:  TANTECH ENGINEERS  Date Signed:  License:  City(State/City)  Responsible Designer Signature:  Date Signed:  License:	STATE OF CAINDOOF CEC-NRCC-L CERTIFICA Indoor Lig Project Nam  DOCUMEN 1. I certif Documentation Company: Address: City/State/Zig RESPONSI I certify the 1. The i 2. I am (resp 3. The company)	ALIFORNIA R LIGHTING TI-01-E (Revised 08/15) TTE OF COMPLIANCE Thiting e: LifeMoves Maple St  TATION AUTHOR'S DECLARATION STATEMENT fy that this Certificate of Compliance documentation on Author Name: Tantech Engineers Tantech Engineers 1431 Cedar St : San Carlos, CA 94070 BLE PERSON'S DECLARATION STATEMENT e following under penalty of perjury, under the laws of formation provided on this Certificate of Compliance eligible under Division 3 of the Business and Professionsible designer). nergy features and performance specifications, mate plance conform to the requirements of Title 24, Part	of the State of Ce is true and corrons Code to acce	alifornia: ect. pt responsik ts, and man ne California	Signatu CEA Cei Phone:  pility for the ufactured a Code of R	re Date: 9/2: rtification Ider 415-269: e building of devices for Regulations.	or Signature: 4/2016 httfication (if application) -4283 design or systems the building design of the building design or systems.	Date Prepared: 9/24/2016  able):  m design identified on this Certifies esign or system design identified
builder provides to the building owner at occupancy.  Responsible Designer Name: TANTECH ENGINEERS  Company: TANTECH ENGINEERS  Address: 1431 CEDAR ST  City/State/Gip: Phage:	STATE OF CAINDOOF CEC-NRCC-L CERTIFICA Indoor Lig Project Nam  DOCUMEN 1. I certif Documentation Company: Address: City/State/Zig RESPONSI I certify th 1. The i 2. I am (resp 3. The company 4. The identification of the company 4. The identification of the company in the compa	ALIFORNIA R LIGHTING TI-01-E (Revised 08/15) TTE OF COMPLIANCE Thing e: LifeMoves Maple St  TATION AUTHOR'S DECLARATION STATEMENT fy that this Certificate of Compliance documentation on Author Name: Tantech Engineers Tantech Engineers  1431 Cedar St : San Carlos, CA 94070 BLE PERSON'S DECLARATION STATEMENT e following under penalty of perjury, under the laws of formation provided on this Certificate of Compliance eligible under Division 3 of the Business and Profession on Sible designer). In pergy features and performance specifications, mate of silications of the requirements of Title 24, Part is uilding design features or system design features ide	of the State of Ce is true and corrons Code to accertals, componen 1 and Part 6 of the of the on this Co	alifornia: ect. pt responsik ts, and man ne California ertificate of	Signatu CEA Cei Phone:  pility for the a Code of R Compliance	re Date: 9/2- rtification Ider 415-269- e building codevices for Regulations. Re are consi	or Signature:  4/2016  Attification (if application)  4283  design or system the building design of the building d	Date Prepared: 9/24/2016  Date Prepared: 9/24/2016  Date Prepared: 9/24/2016  Date Prepared: 9/24/2016
Responsible Designer Name: TANTECH ENGINEERS  Company: TANTECH ENGINEERS  Address: 1431 CEDAR ST  City/State/Ziry: Phone:	STATE OF CAINDOOF CEC-NRCC-L CERTIFICA Indoor Lig Project Nam  DOCUMEN 1. I certif Documentation Company: Address: City/State/Zig RESPONSI I certify th 1. The i 2. I am (resp 3. The e Comp 4. The i docu 5. I will	ALIFORNIA R LIGHTING TI-01-E (Revised 08/15) TTE OF COMPLIANCE Thing e: LifeMoves Maple St  TATION AUTHOR'S DECLARATION STATEMENT fy that this Certificate of Compliance documentation on Author Name: Tantech Engineers Tantech Engineers  1431 Cedar St : San Carlos, CA 94070 BLE PERSON'S DECLARATION STATEMENT e following under penalty of perjury, under the laws of formation provided on this Certificate of Compliance eligible under Division 3 of the Business and Profession on sible designer). In the person of the Business and Profession on sible designer). In the person of the Business and Profession on sible designer). In the person of the Business and Profession on sible designer). In the person of the Business and Profession on sible designer). In the person of the Business and Profession on sible designer). In the person of the Business and Profession on sible designer). In the person of the Business and Profession on sible designer). In the person of the Business and Profession on sible designer). In the person of the Business and Profession on sible designer). In the person of the Business and Profession on sible designer). In the person of the Business and Profession on sible designer). In the person of the Business and Profession on sible designer). In the person of the Business and Profession on sible designer of the Business and Profession on sible designer). In the person of the Business and Profession on sible designer of the	of the State of Ce is true and corrors Code to accerals, componen 1 and Part 6 of the ons submitted to the of Compliance	alifornia: ect. pt responsib ts, and man ne California ertificate of o the enforc shall be ma	Signatu CEA Cei Phone:  pility for the Code of R Compliancement age ade availab	e building of devices for degulations. e are consiency for apple with the	or Signature:  4/2016  utification (if application)  4283  design or system the building design with the proval with the building perm	Date Prepared: 9/24/2016  Table):  m design identified on this Certifies esign or system design identified information provided on other as building permit application. iit(s) issued for the building, and
Company: TANTECH ENGINEERS  Address: 1431 CEDAR ST  City/State/Zipy  Phone:	STATE OF CAINDOOF CEC-NRCC-L CERTIFICA Indoor Lig Project Nam  DOCUMEN 1.   certif Documentation Company: Address: City/State/Zig RESPONSI I certify th 1.   The i 2.   I am (resp 3.   The e docu 5.   Will enfor	ALIFORNIA R LIGHTING TI-01-E (Revised 08/15) TTE OF COMPLIANCE Thiting  e: LifeMoves Maple St  TATION AUTHOR'S DECLARATION STATEMENT  fy that this Certificate of Compliance documentation on Author Name: Tantech Engineers  Tantech Engineers  1431 Cedar St  San Carlos, CA 94070  BLE PERSON'S DECLARATION STATEMENT e following under penalty of perjury, under the laws of the formation provided on this Certificate of Compliance eligible under Division 3 of the Business and Profession on sible designer). In pregy features and performance specifications, mate of the sign features of the requirements of Title 24, Part is uilding design features or system design features ide ments, worksheets, calculations, plans and specifications ensure that a completed signed copy of this Certificat cement agency for all applicable inspections. I understanding the sign of the sections. I understanding the sign of the section of the	of the State of Ce is true and corrors Code to accerals, componen 1 and Part 6 of the ons submitted to the of Compliance	alifornia: ect. pt responsib ts, and man ne California ertificate of o the enforc shall be ma	Signatu CEA Cei Phone:  pility for the Code of R Compliancement age ade availab	e building of devices for degulations. e are consiency for apple with the	or Signature:  4/2016  utification (if application)  4283  design or system the building design with the proval with the building perm	Date Prepared: 9/24/2016  Table):  m design identified on this Certifies on system design identified information provided on other as building permit application. iit(s) issued for the building, and interest of the system of t
Address: 1431 CEDAR ST License:	STATE OF CAINDOOF CEC-NRCC-L CERTIFICA Indoor Lig Project Nam  DOCUMEN  1. I certif Documentati Company: Address: City/State/Zig RESPONSI I certify th 1. The i 2. I am (resp 3. The c Comp 4. The b docu 5. I will enfor	ALIFORNIA R LIGHTING TI-01-E (Revised 08/15) TTE OF COMPLIANCE Thiting  e: LifeMoves Maple St  TATION AUTHOR'S DECLARATION STATEMENT fy that this Certificate of Compliance documentation on Author Name: Tantech Engineers  Tantech Engineers  1431 Cedar St  San Carlos, CA 94070 BLE PERSON'S DECLARATION STATEMENT e following under penalty of perjury, under the laws of the formation provided on this Certificate of Compliance eligible under Division 3 of the Business and Profession onsible designer). nergy features and performance specifications, material provides to the requirements of Title 24, Part is uilding design features or system design features idements, worksheets, calculations, plans and specifications ensure that a completed signed copy of this Certificate cement agency for all applicable inspections. I underser provides to the building owner at occupancy.	of the State of Ce is true and corrors Code to accerals, componen 1 and Part 6 of the ons submitted to the of Compliance	alifornia: ect. pt responsib ts, and man ne California ertificate of o the enforc shall be ma	Signatu  CEA Cei  Phone:  pility for the a Code of R Compliancement age ade availabed copy of	e building of devices for degulations, e are consiency for apple with the this Certific	or Signature:  4/2016  utification (if application)  4283  design or system the building design with the proval with the building permitate of Complicate of Compli	Date Prepared: 9/24/2016  Table):  m design identified on this Certifies on system design identified information provided on other as building permit application. iit(s) issued for the building, and interest of the system of t
1431 CEDAR ST	STATE OF CAINDOOF CEC-NRCC-L CERTIFICA Indoor Lig Project Nam  DOCUMEN 1. I certif Documentatio Company: Address: City/State/Zig RESPONSI I certify th 1. The i 2. I am (resp 3. The e Company 4. The b documentatio Light of the company Light	ALIFORNIA R LIGHTING TI-01-E (Revised 08/15) TTE OF COMPLIANCE Thiting  e: LifeMoves Maple St  TATION AUTHOR'S DECLARATION STATEMENT Ty that this Certificate of Compliance documentation on Author Name: Tantech Engineers  Tantech Engineers  1431 Cedar St  San Carlos, CA 94070  BLE PERSON'S DECLARATION STATEMENT e following under penalty of perjury, under the laws of the formation provided on this Certificate of Compliance eligible under Division 3 of the Business and Profession on sible designer). In the requirements of Title 24, Part is uilding design features or system design features ide ments, worksheets, calculations, plans and specification ensure that a completed signed copy of this Certificate cement agency for all applicable inspections. I underse provides to the building owner at occupancy.  TANTECH ENGINEERS	of the State of Ce is true and corrors Code to accerals, componen 1 and Part 6 of the ons submitted to the of Compliance	alifornia: ect. pt responsib ts, and man ne California ertificate of o the enforc shall be ma	Signatu CEA Cei Phone:  Phone:  oility for the code of Responer age available ded copy of	e building of devices for degulations. e are consiency for apple with the this Certification sible Designer	or Signature:  4/2016  utification (if application)  4283  design or system the building design with the proval with the building permitate of Complicate of Compli	Date Prepared: 9/24/2016  Table):  m design identified on this Certifies esign or system design identified information provided on other also building permit application. iit(s) issued for the building, and residual interests and interests are significated in the second interests.
CITY/STATE/ZIP: SAN CARLOS, CA 94070   Phone: 415-269-4283	STATE OF CAINDOOF CEC-NRCC-L CERTIFICA Indoor Lig Project Nam  DOCUMEN 1. I certif Documentati Company: Address: City/State/Zig RESPONSI I certify th 1. The i 2. I am (resp 3. The e Company 4. The b docu 5. I will enfor build Responsible I Company:	ALIFORNIA R LIGHTING TH-01-E (Revised 08/15) TE OF COMPLIANCE Thiting  E: LifeMoves Maple St  TATION AUTHOR'S DECLARATION STATEMENT To that this Certificate of Compliance documentation on Author Name: Tantech Engineers  Tantech Engineers  1431 Cedar St  San Carlos, CA 94070 BLE PERSON'S DECLARATION STATEMENT E following under penalty of perjury, under the laws of the formation provided on this Certificate of Compliance eligible under Division 3 of the Business and Profession onsible designer). Increy features and performance specifications, materially in the provided of the requirements of Title 24, Particulating design features or system design features ide ments, worksheets, calculations, plans and specification ensure that a completed signed copy of this Certificate coment agency for all applicable inspections. I underser provides to the building owner at occupancy.  TENTECH ENGINEERS  TANTECH ENGINEERS	of the State of Ce is true and corrors Code to accerals, componen 1 and Part 6 of the ons submitted to the of Compliance	alifornia: ect. pt responsib ts, and man ne California ertificate of o the enforc shall be ma	Signatu CEA Cei Phone:  pility for the a Code of R Compliance ement age ade available copy of Respor	e building of devices for Regulations ency for apple with the this Certific spide.	or Signature:  4/2016  utification (if application)  4283  design or system the building design with the proval with the building permitate of Complicate of Compli	Date Prepared: 9/24/2016  Table):  m design identified on this Certifies esign or system design identified information provided on other against the specific permit application. (it(s) issued for the building, and residued in the system of
	STATE OF CAINDOOF CEC-NRCC-L CERTIFICA Indoor Lig Project Nam  DOCUMEN 1. I certif Documentation Company: Address: City/State/Zig RESPONSI I certify th 1. The i 2. I am (resp 3. The company 4. The icon documentation build Responsible in the company Company: Address: Address:	ALIFORNIA R LIGHTING TI-01-E (Revised 08/15) TE OF COMPLIANCE Thiting  e: LifeMoves Maple St  TATION AUTHOR'S DECLARATION STATEMENT  fy that this Certificate of Compliance documentation on Author Name: Tantech Engineers  Tantech Engineers  1431 Cedar St  San Carlos, CA 94070  BLE PERSON'S DECLARATION STATEMENT  e following under penalty of perjury, under the laws of the Business and Profession on the Scrifficate of Compliance eligible under Division 3 of the Business and Profession on the Scriffication of the Review of Scriffication of the Review of Scriffication of the Review of Scriffication	of the State of Ce is true and corrors Code to accerals, componen 1 and Part 6 of the ons submitted to the of Compliance	alifornia: ect. pt responsib ts, and man ne California ertificate of o the enforc shall be ma	Signatu  CEA Cei  Phone:  Phone:  Dility for the code of Resport  Resport  Date Si  License	re Date: 9/20 rtification Ider 415-269 e building of devices for Regulations, e are consignery for appoint with the this Certific insible Designer gned:	or Signature:  4/2016  utification (if application)  4283  design or system the building design with the proval with the building permitate of Complicate of Compli	Date Prepared: 9/24/2016  Table):  m design identified on this Certifies esign or system design identified information provided on other as building permit application. iit(s) issued for the building, and in the system of the building, and in the system of the system

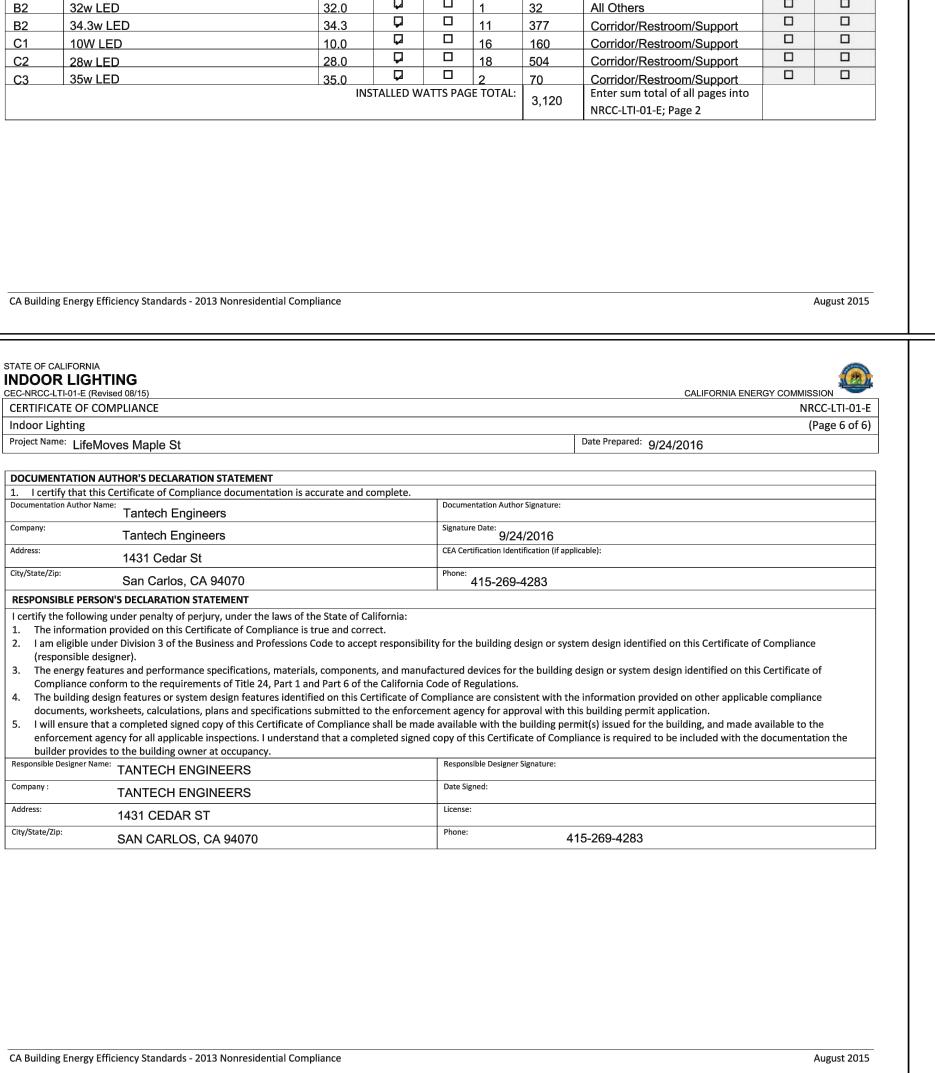

NRCC-LTI-01-E

Field Inspector

CA Building Energy Efficiency Standards - 2013 Nonresidential Compliance

controls, and demand responsive controls.

CA Building Energy Efficiency Standards - 2013 Nonresidential Compliance

INDOOR LIGHTING – LIGHTING CONTROLS

CEC-NRCC-LTI-02-E (Revised 05/15)

CERTIFICATE OF COMPLIANCE

										-				$\searrow$	$\sqrt{}$	$\sim$		$\geq \sim$
CEC-NRCC-LTI-	LIGHTING 01-E (Revised 08/15)						CALIFORNIA ENEI				CEC-NRCC-L	R LIGHTING TI-01-E (Revised 08/15)						
CERTIFICATE	OF COMPLIANCE							NF	RCC-LTI-01-E	>	CERTIFICA	ATE OF COMPLIANCE						
Indoor Light	ing							(	Page 5 of 6)	(	Indoor Lig	ghting						
Project Name:	LifeMoves Maple St						Date Prepared: 9/24/2016				Project Nam	<sup>ne:</sup> LifeMoves Maple St						Date P
· ·	ighting Schedule Must Be Filled Out for Condition		conditioned	d Spaces.	Installed Li	ghting Pow	er listed on this Lighting Schedule is	only for:				e Lighting Schedule Must Be Filled Out for Condit		onditionea	Spaces. I	nstalled Li	ghting Pow	er listo
H INDOOR	LIGHTING SCHEDULE and FIELD INSPECTION E	NERGY CHEC	CKLIST								H INDO	OR LIGHTING SCHEDULE and FIELD INSPECTION	ENERGY CHEC	KLIST				
TI. INDOOR	Luminaire Schedule	INCINCT CITE		Installed Wa	atts		Location	Field Ir	nspector 1		11. 114000	Luminaire Schedule	ENERGY CITE		nstalled Wa	atts		1
Α	В	С		D	E	F	G	1.0.0	Н		Α	В	С	1	D	E	F	+
Name or Item Tag	Complete Luminaire Description (i.e, 3 lamp fluorescent troffer, F32T8, one dimmable electronic ballast)	Watts per Luminaire		According to According to \$130.0(c)	Number Luminaires	Total Installed Watts in this area (H03 x H05)	Primary Function area in which these luminaires are installed	Pass	Fail		Name or Item Tag	Complete Luminaire Description (i.e, 3 lamp fluorescent troffer, F32T8, one dimmable electronic ballast)	Watts per Luminaire	CEC Default from NA8 both	According to page as 8130.0(c) sea	Number Luminaires	Total Installed Watts in this area (H03 x H05)	
C4	24w LED	24.0	<b>₽</b>		2	48	Corridor/Restroom/Support				K1	10W LED	10.0	đ		14	140	All
											K2	40w LED	40.0	₽		6	240	All
																<u> </u>		
																<u> </u>		
	-																	
		IN	STALLED W	/ATTS PAG	SE TOTAL:	48	Enter sum total of all pages into NRCC-LTI-01-E; Page 2						INS	STALLED W	ATTS PAG	E TOTAL:	380	Ent NR0

August 2015

NRCC-LTI-02-E

May 2015

CALIFORNIA ENERGY COMMISSION

CA Building Energy Efficiency Standards - 2013 Nonresidential Compliance

INDOOR LIGHTING – LIGHTING CONTROLS

**Lighting Control Schedule** 

also required to be filled out, signed, and submitted.

CA Building Energy Efficiency Standards - 2013 Nonresidential Compliance

Type/ Description of Lighting

Control (i.e.: occupancy sensor,

automatic time switch,

dimmer, automatic daylight,

etc...)

CEC-NRCC-LTI-02-E (Revised 05/15)

CERTIFICATE OF COMPLIANCE

Indoor Lighting - Lighting Controls Indoor Lighting - Lighting Controls (Page 1 of 3) Project Name: LifeMoves Maple St Project Name: Life Moves Maple St Date Prepared: 9/24/2016 The NRCC-LTI-02-E shall be used to document all mandatory and prescriptive lighting controls that are applicable to the project. A separate document must be filled out for Conditioned and Unconditioned Spaces. This page is used only for the following: ☑ CONDITIONED SPACES ☐ UNCONDITIONED SPACES Mandatory Lighting Control Declaration Statements (Indicate if the measure applies by checking yes or no below.) YES NO Control Requirements MANDATORY AND PRESCRIPTIVE INDOOR LIGHTING CONTROL SCHEDULE, PAF CALCULATION, and FIELD INSPECTION CHECKLIST Lighting shall be controlled by self-contained lighting control devices which are certified to the Energy Commission according to the Title 20 Appliance Efficiency Regulations in accordance with Section 110.9. Lighting shall be controlled by a lighting control a system or energy management control system in accordance with §110.9. An Installation Certificate shall be submitted in accordance with Section 130.4(b). One or more Track Lighting Integral Current Limiters shall be installed which have been certified to the Energy Commission in accordance with §110.9 and §130.0. Additionally, an Installation Certificate shall be submitted in accordance with Section 130.4(b). A Track Lighting Supplementary Overcurrent Protection Panel shall be installed in accordance with Section 110.9 and Section 130.0. Additionally, an Installation Certificate shall be installed in accordance with Section 130.4(b). All lighting controls and equipment shall comply with the applicable requirements in §110.9 and shall be installed in accordance with the manufacturer's Location in Building instructions in accordance with Section 130.1. All luminaires shall be functionally controlled with manually switched ON and OFF lighting controls in accordance with Section 130.1(a). General lighting shall be separately controlled from all other lighting systems in an area. Floor and wall display, window display, case display, ornamental, and special effects lighting shall each be separately controlled on circuits that are 20 amps or less. When track lighting is used, general, display, ornamental, and special effects lighting shall each be separately controlled; in accordance with Section 130.1(a)4. The general lighting of any enclosed area 100 square feet or larger, with a connected lighting load that exceeds 0.5 watts per square foot shall meet the multi-level lighting control requirements in accordance with Section 130.1(b). All installed indoor lighting shall be equipped with controls that meet the applicable Shut-OFF control requirements in Section 130.1(c). Lighting in all Daylit Zones shall be controlled in accordance with the requirements in Section 130.1(d) and daylit zones are shown on the plans. Lighting power in buildings larger than 10,000 square feet shall be capable of being automatically reduced in response to a Demand Responsive Signal in accordance with Section 130.1(e). Before an occupancy permit is granted for a newly constructed building or area, or a new lighting system serving a building, area, or site is operated for 1.  $\S130.1(a)$  = Manual area controls;  $\S130.0(b)$  = Multi Level;  $\S130.1(c)$  = Auto Shut-Off;  $\S130.1(d)$  = Mandatory Daylight;  $\S130.1(e)$  = Demand Responsive;  $\S140.6(d)$  = normal use, indoor lighting controls serving the building, area, or site shall be certified as meeting the Acceptance Requirements for Code Compliance in Additional lighting controls installed to earn a PAF; §140.6(d) = Prescriptive Secondary Sidelit Daylight Controls. accordance with Section 130.4.(a). The controls required to meet the Acceptance Requirements include automatic daylight controls, automatic shut-OFF 2. Check Table 140.6-A for correct Factor. PAFs shall not be traded between conditioned and unconditioned spaces. As a condition to earn a PAF, an Installation Certificate is

ndoor Lig Proiect Nam	ne: LifeMoves Maple St						Date Prepared: 9/24/2016	•	-
	Lifewoves Maple St						9/24/2016		
	. 11 h 1 C. h . d . h . A B . 57 . d C d			1.6			P	.1 6	
	e Lighting Schedule Must Be Filled Out for Conditi		onaitionea	Spaces. I	nstallea Li	gnting Pow	er listed on this Lighting Schedule is o	nıy for:	
1 COND	OITIONED SPACE  UNCONDITIONED SPA	ICE .							
H. INDOC	DR LIGHTING SCHEDULE and FIELD INSPECTION I  Luminaire Schedule	ENERGY CHEC		nstalled Wa	***		Location	Ciolal I	nspector 1
		С	1	istalled wa	E	F		Field II	H
Α	В	C		tage was	E	F	G		
			deter	•		g G			
			deter		-	ed or are			
- h0		r e	# <u>~</u>	According to §130.0(c)	i se	Total Installed Watts in this area (H03 x H05)			
ie oi Tag	Complete Luminaire Description	ts po inail	Defa NA8	rding :0(c)	inaii	I Ins			
Name or Item Tag	(i.e, 3 lamp fluorescent troffer, F32T8, one dimmable electronic ballast)	Watts per Luminaire	CEC Default from NA8	Acco 3130	Number Luminaires	Fota Wat HO3	Primary Function area in which these luminaires are installed	Pass	Fail
			Q.					P d S S	Fall
K1	10W LED	10.0	<u> </u>		14	140	All Others		
K2	40w LED	40.0			6	240	All Others		
		INS	TALLED W	A ITS PAG	E (OTAL:	380	Enter sum total of all pages into		
						l	NRCC-LTI-01-E; Page 2		

NRCC-LTI-02-E

(Page 2 of **3**)

May 2015

**Enter Control Credit total** 

into NRCC-LTI-01-E; Page

Date Prepared: 9/24/2016

(✓ all that apply, or enter 'E' if Exempted)

C D E F G H I J K L M N O

Control Credit PAGE TOTAL (Sum of Column M):

Standards Complying With 1

IF MULTIPLE PAGES ARE USED, ENTER SUM TOTAL OF Control Credit for all pages HERE (Sum of all Column M): 0

• PROJECT •

CJ W ARCHITECTURE

130 Portola Road, suite A

Portola Valley, CA 94028

(650) 851-9335 / (Fax) 851-9337

Tantech Engineers MEP CONSULTING

**ENGINEERS** 

1431 Cedar Street San Carlos, CA 94070

(415) 269-4283

These plans are copyrighted and are subject to copyright

rotection as an "architectural work" under Sec. 102 of the

Copyright Act, 17 U.S.O. as amended December 1990 and

known as Architectural Works Copyright Protection Act of

990. The protection includes but is not limited to the

overall form as well as the arrangement and composition of

paces and elements of the design. Under such protection

nauthorized use of these plans, work or home represente can legally result in the cessation of construction or buildin being seized and /or monetary compensation to CJW

LifeMoves Maple Street Shelter 1580 Maple Street Redwood City CA 94063

• SHEET TITLE •

Title 24 Lighting

• REVISIONS •

BLDG SUBMITTAL 1 8.15.16 PLAN CHECK # 1 ADDENDUM # 3 8.25.16 ADDENDUM # 5 9.23.16 PLAN CHECK #2 ADDENDUM # 6

STATE OF CALIFORNIA INDOOR LIGHTING POWER A CEC-NRCC-LTI-03-E (Revised 05/15) CERTIFICATE OF COMPLIANCE	ALLOWANCE				CALIFORNIA	ENEF	RGY COMMISSION NRCO
Certificate of Compliance - Indoor Light	ing Power Allowance						(Pa
Project Name: LifeMoves Maple St			Date Pro	pared:	9/24/2016		
A separate page must be filled out for  CONDITIONED spaces	Conditioned and Unconditioned Spaces. This page is o  UNCONDITIONED spaces	nly for:					
·	·						
C -2 AREA CATEGORY METHOD GENERAL  Do not include portable lighting for	ALLIGHTING POWER ALLOWANCE offices. Portable lighting for offices shall be documented	ما ممار نامم	scation B of NBCC	I TI 01	_		
	nary function area as defined in §100.1 of the Standard	-	r section B of NACC-	L11-01	L.		
1 , 3 3 1	A		В		С		D
AREA CATEG	ORY (From §140.6 Table 140.6-C)		WATTS				ALLO\
Location in Building	Primary Function Area per Table 140.	6-C	PER (ft <sup>2</sup> )	Х	AREA (ft <sup>2</sup> )	=	WAT
KENNEL	All Others		0.60		730		438
						1	
			TOTAL	S	730		
Ente	r sum total Area Category allowed watts into sect	on C-1 o	of NRCC-LTI-03-E (	this c	ompliance form	)	438
							^ ^
CA Building Energy Efficiency Standards - 201	3 Nonresidential Compliance		^ ^	^	^ ^		
CA Building Energy Efficiency Standards - 201	3 Nonresidential Compliance			<u> </u>		<u> </u>	
STATE OF CALIFORNIA	3 Nonresidential Compliance			<u> </u>			
	3 Nonresidential Compliance	CALIFO	ORNIA ENERGY COMMIS	SION			
STATE OF CALIFORNIA OUTDOOR LIGHTING	3 Nonresidential Compliance	CALIFO		SION C-LTO	-01-E		
STATE OF CALIFORNIA OUTDOOR LIGHTING CEC-NRCC-LTO-01-E (Revised 05/15)	3 Nonresidential Compliance	CALIFO	NRC				
STATE OF CALIFORNIA OUTDOOR LIGHTING CEC-NRCC-LTO-01-E (Revised 05/15) CERTIFICATE OF COMPLIANCE			NRC	C-LTO			
STATE OF CALIFORNIA OUTDOOR LIGHTING CEC-NRCC-LTO-01-E (Revised 05/15) CERTIFICATE OF COMPLIANCE Outdoor Lighting Project Name: LifeMoves Maple St	Dat	e Prepared: <b>9</b>	NRC (F 0/24/2016 uminated Hardscap	C-LTO age 1	of 4)		
STATE OF CALIFORNIA OUTDOOR LIGHTING CEC-NRCC-LTO-01-E (Revised 05/15) CERTIFICATE OF COMPLIANCE Outdoor Lighting Project Name: LifeMoves Maple St  Project Address: 1580 Maple St Re	Dat	e Prepared: <b>9</b>	NRC (F 0/24/2016	C-LTO age 1	of 4)		
OUTDOOR LIGHTING CEC-NRCC-LTO-01-E (Revised 05/15) CERTIFICATE OF COMPLIANCE Outdoor Lighting Project Name: LifeMoves Maple St  Project Address: 1580 Maple St Ref	dwood City, CA	e Prepared: 9	NRC (F 0/24/2016 uminated Hardscap 64,228	C-LTO age 1	of 4)		
STATE OF CALIFORNIA  OUTDOOR LIGHTING  CEC-NRCC-LTO-01-E (Revised 05/15)  CERTIFICATE OF COMPLIANCE  Outdoor Lighting  Project Name: LifeMoves Maple St  Project Address: 1580 Maple St Re  General Information Phase of Construction:	dwood City, CA  v Construction	e Prepared: 9 Total IIII	NRC (F 0/24/2016 uminated Hardscap 64,228 teration	C-LTO age 1	of 4)		
STATE OF CALIFORNIA OUTDOOR LIGHTING CEC-NRCC-LTO-01-E (Revised 05/15)  CERTIFICATE OF COMPLIANCE Outdoor Lighting Project Name: LifeMoves Maple St  Project Address: 1580 Maple St Re General Information Phase of Construction:  New Outdoor Lighting Zone (OLZ)	dwood City, CA  v Construction	e Prepared: 9  Total IIII  Alt  OLZ-3	NRC (F 0/24/2016  uminated Hardscap 64,228  teration  3 □ OLZ	e Area	of 4)		
STATE OF CALIFORNIA OUTDOOR LIGHTING CEC-NRCC-LTO-01-E (Revised 05/15) CERTIFICATE OF COMPLIANCE Outdoor Lighting Project Name: LifeMoves Maple St  Project Address: 1580 Maple St Re General Information Phase of Construction:  New Outdoor Lighting Zone (OLZ) I have confirmed with the AHJ which  LIGHTING COMPLIANCE DOCUMENTS (C	dwood City, CA  V Construction	e Prepared: 9  Total IIII  ☑ Alt  ☑ OLZ-3 nations, 9	NRC (F 0/24/2016  uminated Hardscap 64,228  teration 3 □ OLZ see Title 24 Part 6, §	e Area	of 4)		
STATE OF CALIFORNIA OUTDOOR LIGHTING CEC-NRCC-LTO-01-E (Revised 05/15) CERTIFICATE OF COMPLIANCE Outdoor Lighting Project Name: LifeMoves Maple St  Project Address: 1580 Maple St Re General Information Phase of Construction:   Outdoor Lighting Zone (OLZ) I have confirmed with the AHJ which  LIGHTING COMPLIANCE DOCUMENTS (Constructions on the use of the published by the California Energy Comments)	dwood City, CA  v Construction	e Prepared: 9  Total IIII  ☑ Alt  ☑ OLZ-3 nations, 9	NRC (F 0/24/2016  uminated Hardscap 64,228  teration 3 □ OLZ see Title 24 Part 6, §	e Area	of 4)		
STATE OF CALIFORNIA OUTDOOR LIGHTING CEC-NRCC-LTO-01-E (Revised 05/15)  CERTIFICATE OF COMPLIANCE Outdoor Lighting Project Name: LifeMoves Maple St  Project Address: 1580 Maple St Re General Information Phase of Construction:  Outdoor Lighting Zone (OLZ) I have confirmed with the AHJ which  LIGHTING COMPLIANCE DOCUMENTS (Constructions on the use of the published by the California Energy Comm	dwood City, CA  v Construction	e Prepared: 9  Total IIII  ☑ Alt  ☑ OLZ-3 nations, 9	NRC (F 0/24/2016  uminated Hardscap 64,228  teration 3 □ OLZ see Title 24 Part 6, §	e Area	of 4)		
STATE OF CALIFORNIA OUTDOOR LIGHTING CEC-NRCC-LTO-01-E (Revised 05/15) CERTIFICATE OF COMPLIANCE Outdoor Lighting Project Name: LifeMoves Maple St  Project Address: 1580 Maple St Re General Information Phase of Construction: New Outdoor Lighting Zone (OLZ) I have confirmed with the AHJ which  LIGHTING COMPLIANCE DOCUMENTS (Constructions on the use of the published by the California Energy Commediate NRCC-LTO-01-E  NRCC-LTO-01-E	dwood City, CA  V Construction Addition  OLZ-1 OLZ-2  OLZ applies to this site. For default lighting zone design the ck box for each document included)  s and all Energy Efficiency Standards compliance documents, ission.  Certificate of Compliance  Outdoor Lighting Controls Certificate of Compliance	Total IIII  Alt  OLZ-3  nations, 9	NRC (F 0/24/2016  uminated Hardscap 64,228  teration 3 □ OLZ see Title 24 Part 6, §	e Area	of 4)		
STATE OF CALIFORNIA OUTDOOR LIGHTING CEC-NRCC-LTO-01-E (Revised 05/15) CERTIFICATE OF COMPLIANCE Outdoor Lighting Project Name: LifeMoves Maple St  Project Address: 1580 Maple St Re General Information Phase of Construction: New Outdoor Lighting Zone (OLZ) I have confirmed with the AHJ which  LIGHTING COMPLIANCE DOCUMENTS (Constructions on the use of the published by the California Energy Commediate NRCC-LTO-01-E NRCC-LTO-01-E	dwood City, CA  v Construction	Total IIII  Alt  OLZ-3  nations, 9	NRC (F 0/24/2016  uminated Hardscap 64,228  teration 3 □ OLZ see Title 24 Part 6, §	e Area	of 4)		
STATE OF CALIFORNIA OUTDOOR LIGHTING CEC-NRCC-LTO-01-E (Revised 05/15) CERTIFICATE OF COMPLIANCE Outdoor Lighting Project Name: LifeMoves Maple St  Project Address: 1580 Maple St Re General Information Phase of Construction: New Outdoor Lighting Zone (OLZ) I have confirmed with the AHJ which  LIGHTING COMPLIANCE DOCUMENTS (Constructions on the use of the published by the California Energy Commediate NRCC-LTO-01-E NRCC-LTO-01-E NRCC-LTO-03-E	dwood City, CA  V Construction	Total IIII  Alt  OLZ-3  nations, 9	NRC (F  N/24/2016  uminated Hardscap 64,228  teration 3 □ OLZ see Title 24 Part 6, §	e Area	of 4)		
STATE OF CALIFORNIA OUTDOOR LIGHTING CEC-NRCC-LTO-01-E (Revised 05/15) CERTIFICATE OF COMPLIANCE Outdoor Lighting Project Name: LifeMoves Maple St  Project Address: 1580 Maple St Re General Information Phase of Construction: New Outdoor Lighting Zone (OLZ) I have confirmed with the AHJ which  LIGHTING COMPLIANCE DOCUMENTS (Construction) In the Compliance of the published by the California Energy Communication NRCC-LTO-01-E NRCC-LTO-03-E  Summary of Allowed Outdoor	dwood City, CA  V Construction Addition  OLZ-1 OLZ-2  OLZ applies to this site. For default lighting zone design the ck box for each document included)  s and all Energy Efficiency Standards compliance documents, ission.  Certificate of Compliance  Outdoor Lighting Controls Certificate of Compliance  Outdoor Lighting Power Allowance Certificate of Compliance	Total Illi  Alt  OLZ-3  nations, s	NRC (F  0/24/2016  uminated Hardscap 64,228  teration 3 □ OLZ see Title 24 Part 6, §	e Area	of 4)		
STATE OF CALIFORNIA OUTDOOR LIGHTING CEC-NRCC-LTO-01-E (Revised 05/15) CERTIFICATE OF COMPLIANCE Outdoor Lighting Project Name: LifeMoves Maple St  Project Address: 1580 Maple St Re General Information Phase of Construction: New Outdoor Lighting Zone (OLZ) I have confirmed with the AHJ which  LIGHTING COMPLIANCE DOCUMENTS (Constructions on the use of the published by the California Energy Commediate NRCC-LTO-01-E NRCC-LTO-01-E NRCC-LTO-03-E  Summary of Allowed Outdoor 1. Sum Total ALLOWED Out	dwood City, CA  V Construction Addition  OLZ-1 OLZ-2  OLZ applies to this site. For default lighting zone design the ck box for each document included)  So and all Energy Efficiency Standards compliance documents, ission.  Certificate of Compliance  Outdoor Lighting Controls Certificate of Compliance  Outdoor Lighting Power Allowance Certificate of Compliance  Lighting Power  door Lighting Wattage from NRCC-LTO-03-E, page 1	Total IIII  Alt  OLZ-3  nations, 9	NRC (F  N/24/2016  uminated Hardscap 64,228  teration 3 □ OLZ see Title 24 Part 6, §	e Area	of 4)		
STATE OF CALIFORNIA OUTDOOR LIGHTING CEC-NRCC-LTO-01-E (Revised 05/15) CERTIFICATE OF COMPLIANCE Outdoor Lighting Project Name: LifeMoves Maple St  Project Address: 1580 Maple St Re General Information Phase of Construction: New Outdoor Lighting Zone (OLZ) I have confirmed with the AHJ which  LIGHTING COMPLIANCE DOCUMENTS (C For detailed instructions on the use of the published by the California Energy Comm NRCC-LTO-01-E NRCC-LTO-02-E NRCC-LTO-03-E  Summary of Allowed Outdoor 1. Sum Total ALLOWED Out	dwood City, CA  V Construction Addition  OLZ-1 OLZ-2  OLZ applies to this site. For default lighting zone design the ck box for each document included)  s and all Energy Efficiency Standards compliance documents, ission.  Certificate of Compliance  Outdoor Lighting Controls Certificate of Compliance  Outdoor Lighting Power Allowance Certificate of Compliance	Total Illi  Alt  OLZ-3  nations, s	NRC (F  0/24/2016  uminated Hardscap 64,228  teration 3 □ OLZ see Title 24 Part 6, §	e Area	of 4)		

☐ Field Inspector ☐ Field Inspector

☐ Field Inspector

May 2015

✓ NRCI-LTO-01-E - Must be submitted for all buildings

CA Building Energy Efficiency Standards - 2013 Nonresidential Compliance

☑ NRCI-LTO-02-E - Must be submitted for a lighting control system, or for an Energy Management Control System (EMCS), to be recognized for compliance.

☑ NRCA-LTO-02-A - Must be submitted for outdoor lighting controls.

**Declaration of Required Certificates of Acceptance** – Declare by checking all of the Certificates of Acceptance that will be submitted. (Retain copies and verify forms are completed and signed.)

ERTIFICATE OF COM	PLIANCE						NRCC-LTI-03
ertificate of Complia	nce - Indoor Ligh	ting Power Allo	wance				(Page 3 of
pject Name: LifeMoves	Maple St				Date Prepared: 9/24/201	6	
separate page mus  CONDITIONED sp			d Unconditioned Spa NDITIONED spaces	aces. This page is only for:			
AREA CATEGORY I	METHOD ADDITION		WATTAGE ALLOWA	NCE (from Table 140.6-C Footnotes)			
Α	В	C <sup>2</sup>	D	E		F	G
Primary Function	Sq Ft or	Additional Watts Allowed	Wattage Allowance (B x C)	Description(s) and Quantity of Luminaire Types in each Primary Fu		Total Design Watts <sup>3</sup>	ALLOWED WATTS Smaller of D or F
				nter into TOTAL AREA CATEGORY METHOD ADI			0
Additional watts are Precision commerci	e available only w al and industrial v	hen allowed ac work; Per linear	cording to the footn foot of white board	ard. All other additional Area Category allo otes on bottom of Table 146-C, which inclu or chalk board; Accent, display and feature with §130.0(c) of the Standards.	ude: Specialized task v	work; Ornamental	lighting;

CERTIFICATE OF	COMPLIANCE	NRCC-LTI-C
Certificate of Co	ompliance - Indoor Lighting Power Allowance	(Page 4 d
Project Name: LifeM	oves Maple St	Date Prepared: 9/24/2016
DOCUMENTATIO	N AUTHOR'S DECLARATION STATEMENT	
	this Certificate of Compliance documentation is accurate	<u></u>
Documentation Author	<sup>r Name:</sup> Tantech Engineers	Documentation Author Signature:
Company:	Tantech Engineers	Signature Date: 9/24/2016
Address:	1431 Cedar St	CEA Certification Identification (if applicable):
City/State/Zip:	San Carlos, CA 94070	Phone: 415-269-4283
DECDONICIDI E DEI	RSON'S DECLARATION STATEMENT	
I certify the follow  1. The information  2. I am eligible	wing under penalty of perjury, under the laws of the State tion provided on this Certificate of Compliance is true and under Division 3 of the Business and Professions Code to	
The information of the control	wing under penalty of perjury, under the laws of the State tion provided on this Certificate of Compliance is true and under Division 3 of the Business and Professions Code to designer). Features and performance specifications, materials, comp conform to the requirements of Title 24, Part 1 and Part 6 design features or system design features identified on tworksheets, calculations, plans and specifications submit that a completed signed copy of this Certificate of Completagency for all applicable inspections. I understand that a iddes to the building owner at occupancy.	correct. correct. cocept responsibility for the building design or system design identified on this Certificate of Compliance nents, and manufactured devices for the building design or system design identified on this Certificate of
I certify the follow     The information     I am eligible (responsible)     The energy form compliance     The building documents,     I will ensure enforcement builder proving the following the proving t	wing under penalty of perjury, under the laws of the State tion provided on this Certificate of Compliance is true and under Division 3 of the Business and Professions Code to designer).  features and performance specifications, materials, comp conform to the requirements of Title 24, Part 1 and Part 6 design features or system design features identified on t worksheets, calculations, plans and specifications submit that a completed signed copy of this Certificate of Compl t agency for all applicable inspections. I understand that a ides to the building owner at occupancy.  Name: TANTECH ENGINEERS	correct. Independent of the building design or system design identified on this Certificate of Compliance Independent of the building design or system design identified on this Certificate of compliance of the California Code of Regulations. It is Certificate of Compliance are consistent with the information provided on other applicable compliance and to the enforcement agency for approval with this building permit application. Independent of the building permit of the building, and made available to the completed signed copy of this Certificate of Compliance is required to be included with the documentation the    Responsible Designer Signature:
I certify the follow     The information of the composition of th	wing under penalty of perjury, under the laws of the State tion provided on this Certificate of Compliance is true and under Division 3 of the Business and Professions Code to designer). Features and performance specifications, materials, comp conform to the requirements of Title 24, Part 1 and Part 6 design features or system design features identified on tworksheets, calculations, plans and specifications submit that a completed signed copy of this Certificate of Completagency for all applicable inspections. I understand that a iddes to the building owner at occupancy.	correct. Independent of the building design or system design identified on this Certificate of Compliance  Independent of the building design or system design identified on this Certificate of compliance of the California Code of Regulations.  It is Certificate of Compliance are consistent with the information provided on other applicable compliance and to the enforcement agency for approval with this building permit application.  Independent of the building permit of the building, and made available to the completed signed copy of this Certificate of Compliance is required to be included with the documentation the    Responsible Designer Signature:   Date Signed:
I certify the follow     The information     I am eligible (responsible)     The energy form compliance     The building documents,     I will ensure enforcement builder proving the following the proving t	wing under penalty of perjury, under the laws of the State tion provided on this Certificate of Compliance is true and under Division 3 of the Business and Professions Code to designer).  features and performance specifications, materials, comp conform to the requirements of Title 24, Part 1 and Part 6 design features or system design features identified on t worksheets, calculations, plans and specifications submit that a completed signed copy of this Certificate of Compl t agency for all applicable inspections. I understand that a ides to the building owner at occupancy.  Name: TANTECH ENGINEERS	correct. Independent of the building design or system design identified on this Certificate of Compliance Independent of the building design or system design identified on this Certificate of compliance of the California Code of Regulations. It is Certificate of Compliance are consistent with the information provided on other applicable compliance and to the enforcement agency for approval with this building permit application. Independent of the building permit of the building, and made available to the completed signed copy of this Certificate of Compliance is required to be included with the documentation the  Responsible Designer Signature:

A. OUTD	OOR LIGHTING SCHEDULE and FIELD	INSPECTION	I ENERGY	' CHECK	LIST					
	Luminaire Schedule		Inst	alled W	/atts		Location	Cutoff	1	eld ecto
Α	В	С		)	E	F	G	Н		ī
Name or Item Tag	Complete Luminaire Description	Watts per Luminaire	How wat detern CEC Default from NA8	_	Number of Luminaires	Total Installed Watts in this area (C x E)	Primary Function area in which these luminaires are installed	BUG Rating	Pass	·
X1	30w LED	30.0	Ø		15	450	Building Facade			١
X2	26 LED	26.0	包		6	156	Building Facade			
S2	2- 55w LED	110.0			2	220	Automotive Hardscape			
S1/S1A	55w LED	55.0			7	385	Automotive Hardscape			
S3	41w LED	41.0			17	697	Automotive Hardscape			
S4	10W LED	10.0	Ď		3	30	Automotive Hardscape			
S5	10W LED	10.0			3	30	Automotive Hardscape			
		INS	STALLED W.	ATTS PAC	GE TOTAL:	1,968	Enter sum total of all pages (Sum INSTALLED Outdoor lighting watt. NRCC-LTO-01-E; Page 1		1,96	38

CA Building Energy Efficiency Standards - 2013 Nonresidential Compliance

STATE OF CALIFORNIA
OUTDOOR LIGHTING

CEC-NRCC-LTO-01-E (Revised 06/14) CERTIFICATE OF COMPLIANCE

CJ W ARCHITECTURE

130 Portola Road, suite A Portola Valley, CA 94028

(650) 851-9335 / (Fax) 851-9337

### Tantech Engineers MEP CONSULTING **ENGINEERS**

1431 Cedar Street San Carlos, CA 94070 (415) 269-4283

These plans are copyrighted and are subject to copyright protection as an "architectural work" under Sec. 102 of the Copyright Act, 17 U.S.O. as amended December 1990 and known as Architectural Works Copyright Protection Act of 1990. The protection includes but is not limited to the overall form as well as the arrangement and composition of spaces and elements of the design. Under such protection, unauthorized use of these plans, work or home represented, can legally result in the cessation of construction or building being seized and /or monetary compensation to CJW

• PROJECT •

May 2015

CALIFORNIA ENERGY COMMISSION

NRCC-LTO-01-E

LifeMoves Maple Street Shelter 1580 Maple Street Redwood City CA 94063

• SHEET TITLE •

Title 24

0	REV	1810	JNS

No.	Date 6.17.16	Notes BLDG SUBMITTAL 1
2	8.15.16	PLAN CHECK # 1 ADDENDUM # 3
<b>3</b>	8.25.16	ADDENDUM # 5
<u> </u>	9.23.16	PLAN CHECK #2 ADDENDUM # 6
_		
_		
_		

DATE: 06/17/16SHEET: E4.4

CERTIFICATE OF COMPLIA Outdoor Lighting		-OT-F
Outdoor Lighting	/n 2	_£ 4\
and the Manager Manager	(Page 2	OT 4)
Project Name: LifeMoves Map	ple St Date Prepared: 9/24/2016	
	es exempt from the outdoor lighting power requirements in §140.7	
Name or Symbol	Description of exempt luminaire in accordance with the exemptions	
Schedule of luminaire	es exempt from the cutoff requirements in §130.2(b)	
Name or Symbol	Description of exempt luminaire in accordance with the exemptions	
,	<u> </u>	
Schedule of luminaire	es exempt from the outdoor lighting control requirements in §130.2(c)	
Name or Symbol	Description of exempt luminaire in accordance with the exemptions	


May 2015

CA Building Energy Efficiency Standards - 2013 Nonresidential Compliance

CERTIFICATE OF COMPLIANCE  Outdoor Lighting  Project Name: LifeMoves Maple St  DOCUMENTATION AUTHOR'S DECLAR  1. I certify that this Certificate of Cord Documentation Author Name:  Company:		NRCC-LTO (Page 4)  Date Prepared: 9/24/2016
DOCUMENTATION AUTHOR'S DECLAR 1. I certify that this Certificate of Cor		
DOCUMENTATION AUTHOR'S DECLAR  1. I certify that this Certificate of Cordinate of Cordinate Control (Control (C		расе ггератец. <b>3/24/2010</b>
I certify that this Certificate of Cor Documentation Author Name:		
Documentation Author Name:	mpliance documentation is accurate and complete	
	inpliance documentation is accurate and complete.	
Company:	Tantech Engineers	Documentation Author Signature:
	Tantech Engineers	Signature Date: 9/24/2016
Address:	1431 Cedar St	CEA Certification Identification (if applicable):
City/State/Zip:	San Carlos, CA 94070	Phone: 415-269-4283
RESPONSIBLE PERSON'S DECLARATION	ON STATEMENT	
worksheets, calculations, plans ar		Compliance are consistent with the information provided on other applicable compliance documents,
agency for all applicable inspection	ned copy of this Certificate of Compliance shall be m	cy for approval with this building permit application. ade available with the building permit(s) issued for the building, and made available to the enforcement is Certificate of Compliance is required to be included with the documentation the builder provides to the
	ned copy of this Certificate of Compliance shall be mons. I understand that a completed signed copy of the	ade available with the building permit(s) issued for the building, and made available to the enforcement
agency for all applicable inspection building owner at occupancy.	ned copy of this Certificate of Compliance shall be mons. I understand that a completed signed copy of th	ade available with the building permit(s) issued for the building, and made available to the enforcement s Certificate of Compliance is required to be included with the documentation the builder provides to the
agency for all applicable inspection building owner at occupancy.  Responsible Designer Name:	ned copy of this Certificate of Compliance shall be mons. I understand that a completed signed copy of the TANTECH ENGINEERS  TANTECH ENGINEERS	ade available with the building permit(s) issued for the building, and made available to the enforcement is Certificate of Compliance is required to be included with the documentation the builder provides to the Responsible Designer Signature:
agency for all applicable inspection building owner at occupancy.  Responsible Designer Name:  Company:	ned copy of this Certificate of Compliance shall be mons. I understand that a completed signed copy of th	ade available with the building permit(s) issued for the building, and made available to the enforcement is Certificate of Compliance is required to be included with the documentation the builder provides to the Responsible Designer Signature:  Date Signed:

CER	RTIFICATE OF COMPLIANCE NRCC-LTO-02-
Out	tdoor Lighting Controls (Page 1 of 3
Projec	ct Name: LifeMoves Maple St Date Prepared: 9/24/2016
	e NRCC-LTO-02-E shall be used to document all mandatory outdoor lighting controls that are applicable to the project.
	andatory Outdoor Lighting Control Declaration Statements
Che	eck all that apply:
	Lighting shall be controlled by self-contained lighting control devices which are certified to the Energy Commission according to the Title 20 Appliance
	Efficiency Regulations in accordance with §110.9(a).
	Lighting shall be controlled by a lighting control system or energy management control system in accordance with §110.9. An Installation Certificate shall be submitted in accordance with §130.4(b).
V	All lighting controls and equipment shall comply with the applicable requirements in §110.9 and shall be installed in accordance with the manufacturer's instructions in accordance with §130.1
	Part-Night Outdoor Lighting Controls, as defined in Section 100.1(b), shall meet the requirements in Section 110.9(b)5
	All outdoor incandescent luminaires rated over 100 watts, determined in accordance with Section 130.0(c), shall be controlled by a motion sensor.
	All outdoor luminaires rated for use with lamps greater than 150 lamp watts, determined in accordance with Section 130.0(c), shall comply with
_	Backlight, Uplight, and Glare (collectively referred to as "BUG") in accordance with Section 130.2(b)
	All installed outdoor lighting shall be controlled by a photocontrol or outdoor astronomical time-switch control in accordance with Section 130.2(c)1
	All installed outdoor lighting shall be circuited and independently controlled from other electrical loads by an automatic scheduling control in accordance with Section 130.2(c)2
	All installed outdoor lighting, where the bottom of the luminaire is mounted 24 feet or less above the ground, shall be controlled with automatic lighting controls in accordance with Section 130.2(c)3
	For Outdoor Sales Frontage, Outdoor Sales Lots, and Outdoor Sales Canopies lighting, an automatic lighting control in accordance with Section 130.2(c)4
	For Building Facade, Ornamental Hardscape and Outdoor Dining lighting, an automatic lighting control in accordance with Section 130.2(c)5
V	Before an occupancy permit is granted for a newly constructed building or area, or a new lighting system serving a building, area, or site is operated for normal use, indoor lighting controls serving the building, area, or site shall be certified as meeting the Acceptance Requirements for Code Compliance in accordance with §130.4.(a). Outdoor lighting controls shall comply with the applicable requirements of Section 130.2(c) and Reference Nonresidential
	Appendix NA7.8

TATE OF CALIFORNIA Electrical Power Distribution EC-NRCC-ELC-01-E (Revised 05/15)		CALIFORNIA ENERGY COM			STATE OF CALIFORNIA  Electrical Power Distribu  CEC-NRCC-ELC-01-E (Revised 05/15)	tion		c	ALIFORNIA ENERGY	
ERTIFICATE OF COMPLIANCE		N	NRCC-ELC		CERTIFICATE OF COMPLIANCE					NRCC-ELC-0
ectrical Power Distribution  Discription  LifeMoves Maple Street		Date Prepared: 7-26-2016	(Page 1	of 7)	Electrical Power Distribution  Project Name:  LifeMoves Maple Street			Date Prep	pared: 7-26-2016	(Page 2 d
General Information		7 20 2010			·				, 10 1010	
pject Address: 1580 Maple Street	C	Climate Zone: Conditioned Floor Area :	:		B. Electrical Service Metering  □ Each newly installed electrical ser	vice (in both existing and	I newly constructed buildin	gs) is required to be	e metered, as set o	ut in Table 130.5-
Redwood City, CA		3 10,173 Unconditioned Floor Are	ea :		which is reproduced below.    Fill out a separate line for each elements.	ctrical service that is co	nnected to the building.			
ilding Type:   Nonresidentia	I ☐ High-Rise Resid	ential			Electrical Service Sche		Electrical vice Rating Metering	capabilities (check	all that are preser	Field nt) Inspec
Schools   Relocatable Pu	ublic Schools 🔽 Conditioned Spa	•			A		В С	D	E	F G
ase of Construction:   New Construction:	tion   Addition	✓ Alteration					(at the time) kW demand	Historical peak demand (kW)	Rese:	Pass kWh per rate
							aneou e time) emand	cal pea	period Resettable	Pass
					Designation/location in building MSB exterior wall/Main Switchboard	/description 269	KVA			
					Тар	e 130.5-A - MINIMUM i	REQUIREMENTS FOR METE	RING OF ELECTRICA	AL LOAD	
							More than 50kVA	More than 250 kV		
					Meter Rating (kVA	50 kVA or les	and less than or equal to 250 kVA	and less than or equal to 1000kV		
					Instantaneous (at t time) kW demand	ne Required	Required	Required	Required	1
					Historical peak der	and Not required	Not required	Required	Required	1
					Resettable kWh	Required Not required	Required Not required	Required Not required	Required Required	
Building Energy Efficiency Standards - 2013 Nonre  ATE OF CALIFORNIA    ectrical Power Distribution   C-NRCC-ELC-01-E (Revised 05/15)	esidential Compliance	CALIFORNIA ENERGY COM	MMISSION	y 2015	CA Building Energy Efficiency Standard STATE OF CALIFORNIA Electrical Power Distrib CEC-NRCC-ELC-01-E (Revised 05/15)	ıtion	Compliance	C	CALIFORNIA ENERG)	
ATE OF CALIFORNIA  ectrical Power Distribution C-NRCC-ELC-01-E (Revised 05/15)  ERTIFICATE OF COMPLIANCE	esidential Compliance			(C-01-E	STATE OF CALIFORNIA  Electrical Power Distrib	ıtion	Compliance		CALIFORNIA ENERGY	Y COMMISSION  NRCC-ELC-
ATE OF CALIFORNIA  ectrical Power Distribution	esidential Compliance		MMISSION	(C-01-E	STATE OF CALIFORNIA  Electrical Power Distrib  CEC-NRCC-ELC-01-E (Revised 05/15)  CERTIFICATE OF COMPLIANCE	ution	Compliance	Date Pre		Y COMMISSION  NRCC-ELC- (Page 5
ATE OF CALIFORNIA  ectrical Power Distribution C-NRCC-ELC-01-E (Revised 05/15)  ERTIFICATE OF COMPLIANCE  ectrical Power Distribution	otor control center (in both existing of Table 130.5-B, shown on the next nat require overcurrent protection o added for individual branch circuits case, disaggregated wiring would no	Date Prepared: 7-26-2016  and newly constructed buildings) is required the page. devices rated 60A or greater. and loads throughout the building, and a per of the required as long as the metering system.	MMISSION NRCC-ELC (Page 3	C-01-E B of 7)	STATE OF CALIFORNIA  Electrical Power Distrib  CEC-NRCC-ELC-01-E (Revised 05/15)  CERTIFICATE OF COMPLIANCE  Electrical Power Distribution	o this form, approve the worksheets	; the tables shown below in	Date Pre  I this section are adv	Pared: 7-26-2016 visory only	Y COMMISSION  NRCC-ELC- (Page 5
Cectrical Power Distribution  NRCC-ELC-01-E (Revised 05/15)  RTIFICATE OF COMPLIANCE  Ectrical Power Distribution  Ect Name:  LifeMoves Maple Street  Disaggregation of Electrical Circuits  Each newly installed switchboard, panel, and modisaggregated according to the requirements of Individual branch circuits, taps or disconnects the As an alternative, current transformers can be a measurement system can be installed. In this is equivalent disaggregated measurements.  Fill out a separate line for each switchboard, modeling and modeling according to the requirements.	otor control center (in both existing of Table 130.5-B, shown on the next nat require overcurrent protection of added for individual branch circuits case, disaggregated wiring would not control center, panelboard and	Date Prepared: 7-26-2016  and newly constructed buildings) is required to page. devices rated 60A or greater. and loads throughout the building, and a per ot be required as long as the metering system subpanel.	MMISSION NRCC-ELC (Page 3 d to be rmanent m allows the	C-01-E B of 7)	STATE OF CALIFORNIA  Electrical Power Distrib  CEC-NRCC-ELC-01-E (Revised 05/15)  CERTIFICATE OF COMPLIANCE  Electrical Power Distribution  Project Name:  LifeMoves Maple Stree  E. Voltage Drop  Attach voltage drop worksheet to Field inspector has discretion to Feeder conductors and branch co	t this form, approve the worksheets recuits that are dedicated ractors is shown below	; the tables shown below in	Date Pre	Pared: 7-26-2016 visory only	Y COMMISSION  NRCC-ELC- (Page 5
E OF CALIFORNIA  Ctrical Power Distribution  NRCC-ELC-01-E (Revised 05/15)  RTIFICATE OF COMPLIANCE  ctrical Power Distribution  It Name:  LifeMoves Maple Street  Disaggregation of Electrical Circuits  Each newly installed switchboard, panel, and modisaggregated according to the requirements of an alternative, current transformers can be a measurement system can be installed. In this equivalent disaggregated measurements.  Eill out a separate line for each switchboard, modicated, motor control center, panelboard or	otor control center (in both existing of Table 130.5-B, shown on the next nat require overcurrent protection of added for individual branch circuits case, disaggregated wiring would not or control center, panelboard and	Date Prepared: 7-26-2016  and newly constructed buildings) is required to page. devices rated 60A or greater. and loads throughout the building, and a per ot be required as long as the metering system subpanel.	MMISSION NRCC-ELC (Page 3	C-01-E B of 7)	STATE OF CALIFORNIA  Electrical Power Distrib  CEC-NRCC-ELC-01-E (Revised 05/15)  CERTIFICATE OF COMPLIANCE  Electrical Power Distribution  Project Name:  LifeMoves Maple Stree  E. Voltage Drop  Attach voltage drop worksheet to Field inspector has discretion to Feeder conductors and branch company and project power.	t t t t t t t t t t t t t t t t t t t	the tables shown below in to emergency services are	Date Pre this section are adv exempt from these design load.	7-26-2016 visory only e requirements.	Y COMMISSION  NRCC-ELC- (Page 5
TE OF CALIFORNIA  Catrical Power Distribution  NRCC-ELC-01-E (Revised 05/15)  RTIFICATE OF COMPLIANCE  Catrical Power Distribution  Cat Name:  LifeMoves Maple Street  Disaggregation of Electrical Circuits  Each newly installed switchboard, panel, and mode disaggregated according to the requirements of lindividual branch circuits, taps or disconnects the As an alternative, current transformers can be a measurement system can be installed. In this equivalent disaggregated measurements.  Fill out a separate line for each switchboard, mode acceptable.  A	otor control center (in both existing of Table 130.5-B, shown on the next nat require overcurrent protection of added for individual branch circuits case, disaggregated wiring would not control center, panelboard and Electrical Service that supplications or panel	Date Prepared: 7-26-2016  and newly constructed buildings) is required the page. devices rated 60A or greater. and loads throughout the building, and a perfot be required as long as the metering system subpanel.  es that  Electrical Service Rating C	MMISSION NRCC-ELC (Page 5 d to be rmanent m allows th	C-01-E B of 7)	STATE OF CALIFORNIA  Electrical Power Distrib  CEC-NRCC-ELC-01-E (Revised 05/15)  CERTIFICATE OF COMPLIANCE  Electrical Power Distribution  Project Name:  LifeMoves Maple Stree  E. Voltage Drop  Attach voltage drop worksheet to Field inspector has discretion to Feeder conductors and branch complete An advisory table of typical power  Feeders. Feeder conductors shall be Branch Circuits. Branch circuit conductors	t t t t t t t t t t t t t t t t t t t	the tables shown below in to emergency services are	Date Pre	visory only e requirements.	Y COMMISSION  NRCC-ELC- (Page 5
E OF CALIFORNIA  ctrical Power Distribution  NRCC-ELC-01-E (Revised 05/15)  RTIFICATE OF COMPLIANCE  ctrical Power Distribution  It Name:  LifeMoves Maple Street  Disaggregation of Electrical Circuits  ach newly installed switchboard, panel, and modisaggregated according to the requirements of an alternative, current transformers can be a measurement system can be installed. In this equivalent disaggregated measurements.  ill out a separate line for each switchboard, modianel  A  Designation/location in building/description  PANEL EM & EMX/CORRIDOR/EM PNL	otor control center (in both existing of Table 130.5-B, shown on the next nat require overcurrent protection of added for individual branch circuits case, disaggregated wiring would not or control center, panelboard and electrical Service that supplications witchboard or panel B  Designation/location in building/description  MSB/EXTERIOR/MAIN SWBD	Date Prepared: 7-26-2016  and newly constructed buildings) is required to page. devices rated 60A or greater. and loads throughout the building, and a per ot be required as long as the metering system subpanel.  es that  Electrical Service Rating  C  kVA  50	MMISSION NRCC-ELC (Page 3 d to be rmanent m allows the Inspe	C-01-E B of 7)	STATE OF CALIFORNIA  Electrical Power Distrib  CEC-NRCC-ELC-01-E (Revised 05/15)  CERTIFICATE OF COMPLIANCE  Electrical Power Distribution  Project Name:  LifeMoves Maple Stree  E. Voltage Drop  Attach voltage drop worksheet to Field inspector has discretion to Feeder conductors and branch complete An advisory table of typical power  Feeders. Feeder conductors shall be Branch Circuits. Branch circuit conductors	t t t t t t t t t t t t t t t t t t t	the tables shown below in to emergency services are oltage drop of 2 percent at a maximum voltage drop of	design load.  f 3 percent at design	visory only e requirements.	Y COMMISSION  NRCC-ELC- (Page 5
E OF CALIFORNIA  Ctrical Power Distribution  NRCC-ELC-01-E (Revised 05/15)  RTIFICATE OF COMPLIANCE  Ctrical Power Distribution  It Name: LifeMoves Maple Street  Disaggregation of Electrical Circuits  It is ach newly installed switchboard, panel, and mode is aggregated according to the requirements of individual branch circuits, taps or disconnects the individual branch circuits and taps or disconnects the individual branch circuits and taps or disconnects the individual branch cir	otor control center (in both existing of Table 130.5-B, shown on the next nat require overcurrent protection of added for individual branch circuits case, disaggregated wiring would not otor control center, panelboard and  Electrical Service that supplication of panel B  Designation/location in building/description  MSB/EXTERIOR/MAIN SWBD  MSB/EXTERIOR/MAIN SWBD	Date Prepared: 7-26-2016  The and newly constructed buildings) is required to page.  It page.  I	MMISSION NRCC-ELC (Page 3  d to be  rmanent m allows th	C-O1-E B of 7)	STATE OF CALIFORNIA  Electrical Power Distrib  CEC-NRCC-ELC-01-E (Revised 05/15)  CERTIFICATE OF COMPLIANCE  Electrical Power Distribution  Project Name:  LifeMoves Maple Stree  E. Voltage Drop  Attach voltage drop worksheet to Field inspector has discretion to Feeder conductors and branch of An advisory table of typical power  Feeders. Feeder conductors shall be Branch Circuits. Branch circuit conductors and branch circuits.	t this form, approve the worksheets recuits that are dedicated a factors is shown below sized for a maximum voluctors shall be sized for the Manual, Chapter 8, Topefault Power Factor	oltage drop of 2 percent at one maximum voltage drop of a maximum voltage drop of a maximum voltage drop of a ble 8 2: Typical Power Factor	design load.  f 3 percent at design	visory only e requirements.	Y COMMISSION  NRCC-ELC- (Page 5
E OF CALIFORNIA  Ctrical Power Distribution  IRCC-ELC-01-E (Revised 05/15)  ATIFICATE OF COMPLIANCE  Ctrical Power Distribution  Thame:  LifeMoves Maple Street  Disaggregation of Electrical Circuits  ach newly installed switchboard, panel, and modisaggregated according to the requirements of an alternative, current transformers can be a measurement system can be installed. In this dequivalent disaggregated measurements. Ill out a separate line for each switchboard, modification in building/description  Chboard, motor control center, panelboard or banel  A  Designation/location in building/description  PANEL EM & EMX/CORRIDOR/EM PNL  PANEL K/CORRIDOR/KITCHEN PNL  PANEL LR/CORRIDOR/KITCHEN PNL  PANEL LR/CORRIDOR/KITCHEN PNL  PANEL LR/CORRIDOR/MCHANICAL PNL  PANEL M/CORRIDOR/MCHANICAL PNL  PANEL M/CORRIDOR/MCHANICAL PNL  PANEL M/CORRIDOR/MCHANICAL PNL	otor control center (in both existing of Table 130.5-B, shown on the next nat require overcurrent protection of added for individual branch circuits case, disaggregated wiring would not otor control center, panelboard and  Electrical Service that supplication of switchboard or panel B  Designation/location in building/description  MSB/EXTERIOR/MAIN SWBD  MSB/EXTERIOR/MAIN SWBD  MSB/EXTERIOR/MAIN SWBD  MSB/EXTERIOR/MAIN SWBD  MSB/EXTERIOR/MAIN SWBD	Date Prepared: 7-26-2016  The and newly constructed buildings) is required to page.  It page.  I	MMISSION NRCC-ELC (Page 3	C-01-E 3 of 7)	STATE OF CALIFORNIA  Electrical Power Distrib  CEC-NRCC-ELC-01-E (Revised 05/15)  CERTIFICATE OF COMPLIANCE  Electrical Power Distribution  Project Name:  LifeMoves Maple Stree  E. Voltage Drop  Attach voltage drop worksheet to Field inspector has discretion to Feeder conductors and branch of An advisory table of typical power  Feeders. Feeder conductors shall be Branch Circuits. Branch circuit conductors and branch circuits.	t t t t t t t t t t t t t t t t t t t	the tables shown below in to emergency services are a maximum voltage drop of a maximum voltage drop of the services are able 8 2: Typical Power Factor at 277 volts	design load.  f 3 percent at design	visory only e requirements.  In load.  Op Calculations  Clarifying Notes	Page 5
E OF CALIFORNIA  Ctrical Power Distribution  NRCC-ELC-01-E (Revised 05/15)  RTIFICATE OF COMPLIANCE  Ctrical Power Distribution  t Name: LifeMoves Maple Street  Disaggregation of Electrical Circuits  ach newly installed switchboard, panel, and modisaggregated according to the requirements of an alternative, current transformers can be a measurement system can be installed. In this dequivalent disaggregated measurements. ill out a separate line for each switchboard, modification in building/description  Chboard, motor control center, panelboard or banel  A  Designation/location in building/description  PANEL EM & EMX/CORRIDOR/EM PNL  PANEL EM & EMX/CORRIDOR/EM PNL  PANEL LR/CORRIDOR/KITCHEN PNL  PANEL LR/CORRIDOR/KITCHEN PNL  PANEL M/CORRIDOR/MCHANICAL PNL  PANEL M/CORRIDOR/MCHANICAL PNL  PANEL M/CORRIDOR/MECHANICAL PNL  PANEL P1/CORRIDOR/MECHANICAL PNL  PANEL P1/CORRIDOR/MECHANICAL PNL  PANEL P1/CORRIDOR/RECEPT PNL	otor control center (in both existing of Table 130.5-B, shown on the next nat require overcurrent protection of added for individual branch circuits case, disaggregated wiring would not otor control center, panelboard and switchboard or panel B  Designation/location in building/description  MSB/EXTERIOR/MAIN SWBD  MSB/EXTERIOR/MAIN SWBD  MSB/EXTERIOR/MAIN SWBD	Date Prepared: 7-26-2016  The and newly constructed buildings) is required to page.  devices rated 60A or greater.  and loads throughout the building, and a per ot be required as long as the metering system subpanel.  Electrical Service Rating  C  N  KVA  50  24.4  23.8  117.4	MMISSION NRCC-ELC (Page 3	E-01-E 3 of 7)  Be Beld Bector  BE	STATE OF CALIFORNIA  Electrical Power Distrib  CEC-NRCC-ELC-01-E (Revised 05/15)  CERTIFICATE OF COMPLIANCE  Electrical Power Distribution  Project Name:  LifeMoves Maple Stree  E. Voltage Drop  Attach voltage drop worksheet to Field inspector has discretion to Feeder conductors and branch of An advisory table of typical power  Feeders. Feeder conductors shall be Branch Circuits. Branch circuit conductors and Complian  Load Type	t t t t t t t t t t t t t t t t t t t	the tables shown below in to emergency services are a maximum voltage drop of a maximum voltage drop of able 8 2: Typical Power Factor at 277 volts  0.95	design load.  f 3 percent at design	visory only e requirements.	Page 5
E OF CALIFORNIA  Ctrical Power Distribution  NRCC-ELC-01-E (Revised 05/15)  RTIFICATE OF COMPLIANCE  Ctrical Power Distribution  t Name: LifeMoves Maple Street  Disaggregation of Electrical Circuits  ach newly installed switchboard, panel, and modisaggregated according to the requirements of an alternative, current transformers can be a measurement system can be installed. In this dequivalent disaggregated measurements. ill out a separate line for each switchboard, modification in building/description  Chboard, motor control center, panelboard or banel  A  Designation/location in building/description  PANEL EM & EMX/CORRIDOR/EM PNL  PANEL EM & EMX/CORRIDOR/EM PNL  PANEL LR/CORRIDOR/KITCHEN PNL  PANEL LR/CORRIDOR/KITCHEN PNL  PANEL M/CORRIDOR/MCHANICAL PNL  PANEL M/CORRIDOR/MCHANICAL PNL  PANEL M/CORRIDOR/MECHANICAL PNL  PANEL P1/CORRIDOR/MECHANICAL PNL  PANEL P1/CORRIDOR/MECHANICAL PNL  PANEL P1/CORRIDOR/RECEPT PNL	ptor control center (in both existing of Table 130.5-B, shown on the next nat require overcurrent protection of added for individual branch circuits case, disaggregated wiring would not occurred center, panelboard and switchboard or panel B  Designation/location in building/description  MSB/EXTERIOR/MAIN SWBD  MSB/EXTERIOR/MAIN SWBD  MSB/EXTERIOR/MAIN SWBD  MSB/EXTERIOR/MAIN SWBD  MSB/EXTERIOR/MAIN SWBD  MSB/EXTERIOR/MAIN SWBD  MSB/EXTERIOR/MAIN SWBD	Date Prepared: 7-26-2016  The and newly constructed buildings) is required to page.  It page.  I	MMISSION NRCC-ELC (Page 3	C-01-E 3 of 7)	STATE OF CALIFORNIA  Electrical Power Distrib  CEC-NRCC-ELC-01-E (Revised 05/15)  CERTIFICATE OF COMPLIANCE  Electrical Power Distribution  Project Name:  LifeMoves Maple Stree  E. Voltage Drop  Attach voltage drop worksheet to Field inspector has discretion to Feeder conductors and branch of An advisory table of typical power  Feeders. Feeder conductors shall be Branch Circuits. Branch circuit conductors and branch circuits conductors and branch circuits. Branch circuit conductors and branch circuits. Branch circuits and branch circuits. Branch circuits and branch circuits. Branch circuits and branch circ	t t t t t t t t t t t t t t t t t t t	the tables shown below in to emergency services are a maximum voltage drop of a maximum voltage drop of able 8 2: Typical Power Factor at 277 volts  0.95  0.9 (hardwired)	design load.  f 3 percent at design  NPF magnet  May be highe	visory only e requirements.  n load.  Clarifying Notes  cic ballasts use GU-2	Field Inspect  A values  24 values
E OF CALIFORNIA  Ctrical Power Distribution  IRCC-ELC-01-E (Revised 05/15)  ATIFICATE OF COMPLIANCE  Ctrical Power Distribution  Towns:  LifeMoves Maple Street  Disaggregation of Electrical Circuits  ach newly installed switchboard, panel, and modisaggregated according to the requirements of an alternative, current transformers can be a measurement system can be installed. In this dequivalent disaggregated measurements.  Ill out a separate line for each switchboard, model  A  Designation/location in building/description  PANEL EM & EMX/CORRIDOR/EM PNL  PANEL K/CORRIDOR/KITCHEN PNL  PANEL K/CORRIDOR/KITCHEN PNL  PANEL M/CORRIDOR/MCHANICAL PNL  PANEL M/CORRIDOR/MCHANICAL PNL  PANEL M/CORRIDOR/MECHANICAL PNL  PANEL P1/CORRIDOR/MECHANICAL PNL	ptor control center (in both existing of Table 130.5-B, shown on the next nat require overcurrent protection of added for individual branch circuits case, disaggregated wiring would not occurred center, panelboard and switchboard or panel B  Designation/location in building/description  MSB/EXTERIOR/MAIN SWBD  MSB/EXTERIOR/MAIN SWBD  MSB/EXTERIOR/MAIN SWBD  MSB/EXTERIOR/MAIN SWBD  MSB/EXTERIOR/MAIN SWBD  MSB/EXTERIOR/MAIN SWBD  MSB/EXTERIOR/MAIN SWBD	Date Prepared: 7-26-2016  The and newly constructed buildings) is required to page.  It page.  I	MMISSION NRCC-ELC (Page 3	C-01-E 3 of 7)	STATE OF CALIFORNIA  Electrical Power Distrib  CEC-NRCC-ELC-01-E (Revised 05/15)  CERTIFICATE OF COMPLIANCE  Electrical Power Distribution  Project Name:  LifeMoves Maple Stree  E. Voltage Drop  Attach voltage drop worksheet to Field inspector has discretion to Feeder conductors and branch of An advisory table of typical power  Feeders. Feeder conductors shall be Branch Circuits. Branch circuit conductors and branch circuits. Branch circuits and	t t t t t t t t t t t t t t t t t t t	the tables shown below in to emergency services are a maximum voltage drop of a maximum voltage drop of able 8 2: Typical Power Factor at 277 volts  0.95  0.9 (hardwired)  0.3 (GU-24)	design load.  f 3 percent at design  NPF magnet  May be highe	visory only requirements.  n load.  Clarifying Notes	Field Inspect  A values  24 values
E OF CALIFORNIA  Ctrical Power Distribution  NRCC-ELC-01-E (Revised 05/15)  RTIFICATE OF COMPLIANCE  Ctrical Power Distribution  It Name: LifeMoves Maple Street  Disaggregation of Electrical Circuits  ach newly installed switchboard, panel, and modisaggregated according to the requirements of an alternative, current transformers can be a measurement system can be installed. In this dequivalent disaggregated measurements. ill out a separate line for each switchboard, modification in building/description  Chboard, motor control center, panelboard or banel  A  Designation/location in building/description  PANEL EM & EMX/CORRIDOR/EM PNL  PANEL EM & EMX/CORRIDOR/EM PNL  PANEL LR/CORRIDOR/KITCHEN PNL  PANEL LR/CORRIDOR/KITCHEN PNL  PANEL M/CORRIDOR/MCHANICAL PNL  PANEL M/CORRIDOR/MCHANICAL PNL  PANEL M/CORRIDOR/MECHANICAL PNL  PANEL P1/CORRIDOR/MECHANICAL PNL  PANEL P1/CORRIDOR/MECHANICAL PNL  PANEL P1/CORRIDOR/RECEPT PNL	ptor control center (in both existing of Table 130.5-B, shown on the next nat require overcurrent protection of added for individual branch circuits case, disaggregated wiring would not occurred center, panelboard and switchboard or panel B  Designation/location in building/description  MSB/EXTERIOR/MAIN SWBD  MSB/EXTERIOR/MAIN SWBD  MSB/EXTERIOR/MAIN SWBD  MSB/EXTERIOR/MAIN SWBD  MSB/EXTERIOR/MAIN SWBD  MSB/EXTERIOR/MAIN SWBD  MSB/EXTERIOR/MAIN SWBD	Date Prepared: 7-26-2016  The and newly constructed buildings) is required to page.  It page.  I	MMISSION NRCC-ELC (Page 3	E-01-E 3 of 7)	STATE OF CALIFORNIA  Electrical Power Distrib  CEC-NRCC-ELC-01-E (Revised 05/15)  CERTIFICATE OF COMPLIANCE  Electrical Power Distribution  Project Name:  LifeMoves Maple Stree  E. Voltage Drop  Attach voltage drop worksheet to Field inspector has discretion to Feeder conductors and branch compliant An advisory table of typical power  Feeders. Feeder conductors shall be Branch Circuits. Branch circuit conductors and Type  Fluorescent lighting  Compact fluorescent lighting	t t t t t t t t t t t t t t t t t t t	the tables shown below in to emergency services are a maximum voltage drop of a maximum voltage drop of able 8 2: Typical Power Factor at 277 volts  0.95  0.9 (hardwired)  0.3 (GU-24)	design load.  f 3 percent at design  NPF magnet  May be highe	visory only e requirements.  n load.  Clarifying Notes  cic ballasts use GU-2	Field Inspect  A values  24 values
E OF CALIFORNIA  Ctrical Power Distribution  NRCC-ELC-01-E (Revised 05/15)  RTIFICATE OF COMPLIANCE  Ctrical Power Distribution  It Name: LifeMoves Maple Street  Disaggregation of Electrical Circuits  ach newly installed switchboard, panel, and modisaggregated according to the requirements of an alternative, current transformers can be a measurement system can be installed. In this dequivalent disaggregated measurements. ill out a separate line for each switchboard, modification in building/description  Chboard, motor control center, panelboard or banel  A  Designation/location in building/description  PANEL EM & EMX/CORRIDOR/EM PNL  PANEL EM & EMX/CORRIDOR/EM PNL  PANEL LR/CORRIDOR/KITCHEN PNL  PANEL LR/CORRIDOR/KITCHEN PNL  PANEL M/CORRIDOR/MCHANICAL PNL  PANEL M/CORRIDOR/MCHANICAL PNL  PANEL M/CORRIDOR/MECHANICAL PNL  PANEL P1/CORRIDOR/MECHANICAL PNL  PANEL P1/CORRIDOR/MECHANICAL PNL  PANEL P1/CORRIDOR/RECEPT PNL	ptor control center (in both existing of Table 130.5-B, shown on the next nat require overcurrent protection of added for individual branch circuits case, disaggregated wiring would not occurred center, panelboard and switchboard or panel B  Designation/location in building/description  MSB/EXTERIOR/MAIN SWBD  MSB/EXTERIOR/MAIN SWBD  MSB/EXTERIOR/MAIN SWBD  MSB/EXTERIOR/MAIN SWBD  MSB/EXTERIOR/MAIN SWBD  MSB/EXTERIOR/MAIN SWBD  MSB/EXTERIOR/MAIN SWBD	Date Prepared: 7-26-2016  The and newly constructed buildings) is required to page.  It page.  I	MMISSION NRCC-ELC (Page 3	C-01-E 3 of 7)  Be eld ector	STATE OF CALIFORNIA  Electrical Power Distrib  CEC-NRCC-ELC-01-E (Revised 05/15)  CERTIFICATE OF COMPLIANCE  Electrical Power Distribution  Project Name:  LifeMoves Maple Stree  E. Voltage Drop  Attach voltage drop worksheet to be field inspector has discretion to be feeder conductors and branch of the field inspector fast discretion to be feeder conductors and branch of the field inspector fast discretion to be feeder conductors and branch of the field inspector fast discretion to be feeders. Feeder conductors shall be be determined by the field inspector fast discretion to be feeders. Feeder conductors shall be be determined by the field inspector fast discretion to be feeders. Feeder conductors shall be be determined by the field inspector fast discretion to be feeders. Feeder conductors shall be be determined by the field inspector fast discretion to be feeders. Feeder conductors shall be be determined by the field inspector fast discretion to be feeders. Feeder conductors shall be be determined by the field inspector fast discretion to be feeders. Feeder conductors shall be be determined by the field inspector fast discretion to be feeders. Feeder conductors shall be be determined by the field inspector fast discretion to be feeders. Feeder conductors shall be be determined by the field inspector fast discretion to be feeders. Feeder conductors shall be determined by the field inspector fast discretion to be feeders. Feeder conductors and branch	t ton  t this form, approve the worksheets requits that are dedicated a factors is shown below sized for a maximum voluctors shall be sized for the Manual, Chapter 8, Ta Default Power Factor at 120 volts  0.95  0.9 (hardwired)  0.5 (GU-24)  0.7	the tables shown below in to emergency services are a maximum voltage drop of a maximum voltage	design load.  f 3 percent at design  NPF magnet  May be highe  po	visory only e requirements.  n load.  Clarifying Notes  cic ballasts use GU-2	Field Inspect
E OF CALIFORNIA  Ctrical Power Distribution  NRCC-ELC-01-E (Revised 05/15)  RTIFICATE OF COMPLIANCE  Ctrical Power Distribution  It Name: LifeMoves Maple Street  Disaggregation of Electrical Circuits  It is ach newly installed switchboard, panel, and modisaggregated according to the requirements of individual branch circuits, taps or disconnects the same alternative, current transformers can be a measurement system can be installed. In this is equivalent disaggregated measurements.  It is out a separate line for each switchboard, modification in building/description  Choard, motor control center, panelboard or banel  A  Designation/location in building/description  PANEL EM & EMX/CORRIDOR/EM PNL  PANEL K/CORRIDOR/KITCHEN PNL  PANEL LR/CORRIDOR/KITCHEN PNL  PANEL M/CORRIDOR/MCHANICAL PNL  PANEL M/CORRIDOR/MCHANICAL PNL  PANEL M/CORRIDOR/MECHANICAL PNL  PANEL P1/CORRIDOR/RECEPT PNL	ptor control center (in both existing of Table 130.5-B, shown on the next nat require overcurrent protection of added for individual branch circuits case, disaggregated wiring would not occurred center, panelboard and switchboard or panel B  Designation/location in building/description  MSB/EXTERIOR/MAIN SWBD  MSB/EXTERIOR/MAIN SWBD  MSB/EXTERIOR/MAIN SWBD  MSB/EXTERIOR/MAIN SWBD  MSB/EXTERIOR/MAIN SWBD  MSB/EXTERIOR/MAIN SWBD  MSB/EXTERIOR/MAIN SWBD	Date Prepared: 7-26-2016  The and newly constructed buildings) is required to page.  It page.  I	MMISSION NRCC-ELC (Page 3	C-01-E 3 of 7)  Be Beld Bector  Fall  D  D  D  D  D  D  D  D  D  D  D  D	STATE OF CALIFORNIA  Electrical Power Distrib  CEC-NRCC-ELC-01-E (Revised 05/15)  CERTIFICATE OF COMPLIANCE  Electrical Power Distribution  Project Name:  LifeMoves Maple Street  E. Voltage Drop  Attach voltage drop worksheet to seed in the seed	t this form, approve the worksheets recuits that are dedicated a factors is shown below sized for a maximum voluctors shall be sized for the Manual, Chapter 8, Ta Default Power Factor at 120 volts  0.95  0.9 (hardwired)  0.5 (GU-24)  0.7  1.0	the tables shown below in to emergency services are a maximum voltage drop of a maximum voltage drop of able 8 2: Typical Power Factor at 277 volts  0.95  0.9 (hardwired)  0.3 (GU-24)  0.5  1.0	design load.  f 3 percent at design  NPF magnet  May be highe  po	visory only requirements.  In load.  Clarifying Notes  Cic ballasts use GU-2  or if specifications cover factor drivers	Field Inspect
E OF CALIFORNIA  Ctrical Power Distribution  NRCC-ELC-01-E (Revised 05/15)  RTIFICATE OF COMPLIANCE  Ctrical Power Distribution  t Name: LifeMoves Maple Street  Disaggregation of Electrical Circuits  ach newly installed switchboard, panel, and modisaggregated according to the requirements of an alternative, current transformers can be a measurement system can be installed. In this dequivalent disaggregated measurements. ill out a separate line for each switchboard, modification in building/description  Chboard, motor control center, panelboard or banel  A  Designation/location in building/description  PANEL EM & EMX/CORRIDOR/EM PNL  PANEL EM & EMX/CORRIDOR/EM PNL  PANEL LR/CORRIDOR/KITCHEN PNL  PANEL LR/CORRIDOR/KITCHEN PNL  PANEL M/CORRIDOR/MCHANICAL PNL  PANEL M/CORRIDOR/MCHANICAL PNL  PANEL M/CORRIDOR/MECHANICAL PNL  PANEL P1/CORRIDOR/MECHANICAL PNL  PANEL P1/CORRIDOR/MECHANICAL PNL  PANEL P1/CORRIDOR/RECEPT PNL	ptor control center (in both existing of Table 130.5-B, shown on the next nat require overcurrent protection of added for individual branch circuits case, disaggregated wiring would not occurred center, panelboard and switchboard or panel B  Designation/location in building/description  MSB/EXTERIOR/MAIN SWBD  MSB/EXTERIOR/MAIN SWBD  MSB/EXTERIOR/MAIN SWBD  MSB/EXTERIOR/MAIN SWBD  MSB/EXTERIOR/MAIN SWBD  MSB/EXTERIOR/MAIN SWBD  MSB/EXTERIOR/MAIN SWBD	Date Prepared: 7-26-2016  The and newly constructed buildings) is required to page.  It page.  I	MMISSION NRCC-ELC (Page 3	C-01-E 3 of 7)  Be eld ector  Fil:  D  D  D  D  D  D  D  D  D  D  D  D  D	STATE OF CALIFORNIA  Electrical Power Distrib  CEC-NRCC-ELC-01-E (Revised 05/15)  CERTIFICATE OF COMPLIANCE  Electrical Power Distribution  Project Name:  LifeMoves Maple Stree  E. Voltage Drop  Attach voltage drop worksheet to Field inspector has discretion to Feeder conductors and branch of An advisory table of typical power  Feeders. Feeder conductors shall be Branch Circuits. Branch circuit conductors and branch circuits and branch circuits. Branch circuit conductors and branch circuits. Branch circuits and branch circuits. Branch circuit conductors and branch circuits. Branch circuits and branch circuits and branch circuits. Branch circuits and branch circuit	sized for a maximum voluctors shall be sized for a table for at 120 volts  0.95  0.9 (hardwired)  0.7  1.0  0.9	the tables shown below in to emergency services are a maximum voltage drop of a maximum voltage drop of able 8 2: Typical Power Factor at 277 volts  0.95  0.9 (hardwired)  0.3 (GU-24)  0.5  1.0  0.9	design load.  f 3 percent at design  NPF magnet  May be highe  po	visory only requirements.  In load.  Clarifying Notes  Cic ballasts use GU-2  or if specifications cover factor drivers	Field Inspect
Cof California Extrical Power Distribution RCC-ELC-01-E (Revised 05/15) TIFICATE OF COMPLIANCE Extrical Power Distribution  Name: LifeMoves Maple Street  LifeMoves Maple Stre	ptor control center (in both existing of Table 130.5-B, shown on the next nat require overcurrent protection of added for individual branch circuits case, disaggregated wiring would not occurred center, panelboard and switchboard or panel B  Designation/location in building/description  MSB/EXTERIOR/MAIN SWBD  MSB/EXTERIOR/MAIN SWBD  MSB/EXTERIOR/MAIN SWBD  MSB/EXTERIOR/MAIN SWBD  MSB/EXTERIOR/MAIN SWBD  MSB/EXTERIOR/MAIN SWBD  MSB/EXTERIOR/MAIN SWBD	Date Prepared: 7-26-2016  The and newly constructed buildings) is required to page.  It page.  I	MMISSION NRCC-ELC (Page 3	C-O1-E 3 of 7)  ne  eld ector  iii iii iii iii iii iii iii iii iii	STATE OF CALIFORNIA  Electrical Power Distrib  CEC-NRCC-ELC-01-E (Revised 05/15)  CERTIFICATE OF COMPLIANCE  Electrical Power Distribution  Project Name:  LifeMoves Maple Stree  E. Voltage Drop  Attach voltage drop worksheet to be field inspector has discretion to be feeder conductors and branch complian  Feeders. Feeder conductors shall be	sized for a maximum voluctors shall be sized for a table for at 120 volts  0.95  0.9 (hardwired)  0.5 (GU-24)  0.7  1.0  0.9  0.85	the tables shown below in to emergency services are a maximum voltage drop of able 8 2: Typical Power Factor at 277 volts  O.95  O.9 (hardwired)  O.3 (GU-24)  O.5  1.0  O.9  O.9	design load.  f 3 percent at design  NPF magnet  May be highe  po	visory only requirements.  In load.  Clarifying Notes  Cic ballasts use GU-2  or if specifications cover factor drivers	Field Inspect
CALIFORNIA  ectrical Power Distribution  C-NRCC-ELC-01-E (Revised 05/15)  ERTIFICATE OF COMPLIANCE  ectrical Power Distribution  ject Name:  LifeMoves Maple Street  Disaggregation of Electrical Circuits  Each newly installed switchboard, panel, and mode disaggregated according to the requirements of Individual branch circuits, taps or disconnects the As an alternative, current transformers can be a measurement system can be installed. In this equivalent disaggregated measurements.  Fill out a separate line for each switchboard, modepanel	ptor control center (in both existing of Table 130.5-B, shown on the next nat require overcurrent protection of added for individual branch circuits case, disaggregated wiring would not occurred center, panelboard and switchboard or panel B  Designation/location in building/description  MSB/EXTERIOR/MAIN SWBD  MSB/EXTERIOR/MAIN SWBD  MSB/EXTERIOR/MAIN SWBD  MSB/EXTERIOR/MAIN SWBD  MSB/EXTERIOR/MAIN SWBD  MSB/EXTERIOR/MAIN SWBD  MSB/EXTERIOR/MAIN SWBD	Date Prepared: 7-26-2016  The and newly constructed buildings) is required to page.  It page.  I	MMISSION NRCC-ELC (Page 3	C-01-E 3 of 7)  Be eld ector	STATE OF CALIFORNIA  Electrical Power Distrib CEC-NRCC-ELC-01-E (Revised 05/15)  CERTIFICATE OF COMPLIANCE Electrical Power Distribution Project Name:  LifeMoves Maple Stree  E. Voltage Drop Attach voltage drop worksheet to Field inspector has discretion to Feeder conductors and branch of An advisory table of typical power  Feeders. Feeder conductors shall be Branch Circuits. Branch circuit conductors and branch of Complian  Complian  Load Type Fluorescent lighting  Compact fluorescent lighting  LED lighting  Incandescent lighting  HID lighting  HID lighting  HVAC packages  Other motors <5 HP	t ton  t this form, approve the worksheets requires that are dedicated a factors is shown below actors shall be sized for the Manual, Chapter 8, Tail Default Power Factor at 120 volts  0.95  0.9 (hardwired)  0.5 (GU-24)  0.7  1.0  0.9  0.85  0.8	the tables shown below in to emergency services are a maximum voltage drop of a maximum voltage drop of a maximum voltage drop of a to the state of	design load.  f 3 percent at design  NPF magnet  May be highe  po	visory only requirements.  In load.  Clarifying Notes  Cic ballasts use GU-2  or if specifications cover factor drivers	Field Inspect

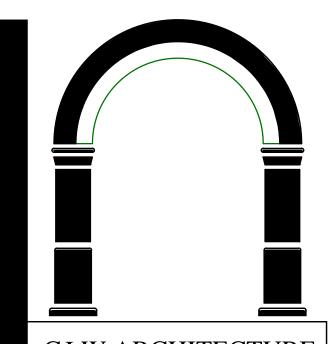


CJ W ARCHITECTURE

130 Portola Road, suite A Portola Valley, CA 94028 (650) 851-9335 / (Fax) 851-9337

#### Tantech Engineers MEP CONSULTING **ENGINEERS**

1431 Cedar Street San Carlos, CA 94070 (415) 269-4283

These plans are copyrighted and are subject to copyright protection as an "architectural work" under Sec. 102 of the Copyright Act, 17 U.S.O. as amended December 1990 and known as Architectural Works Copyright Protection Act of 1990. The protection includes but is not limited to the overall form as well as the arrangement and composition of spaces and elements of the design. Under such protection, unauthorized use of these plans, work or home represented can legally result in the cessation of construction or building being seized and /or monetary compensation to CJW

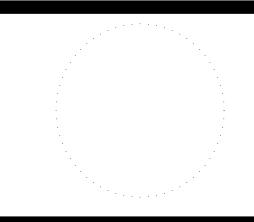

• PROJECT •

LifeMoves Maple Street Shelter 1580 Maple Street Redwood City CA 94063

• SHEET TITLE •

Title 24 Lighting

•	REVISIONS	0

No.	Date	Notes
	6.17.16	BLDG SUBMITTAL 1
2	8.15.16	PLAN CHECK # 1 ADDENDUM # 3
<u>3</u>	8.25.16	ADDENDUM # 5
4	9.23.16	PLAN CHECK #2 ADDENDUM # 6

° DATE: 06/17/16

• SHEET: **E4.5** 

Receptacles

Electric heating

including hot water

0 0

May 2015

Current transformers have been attached to individual branch circuits and loads throughout the building, and a permanent

CA Building Energy Efficiency Standards - 2013 Nonresidential Compliance

measurement system is installed that allows an equivalent degree of disaggregated measurement as required by the Standards..

CA Building Energy Efficiency Standards - 2013 Nonresidential Compliance

0.6

1.0

0.85

N/A

1.0

according to the load

May 2015

STATE OF CALIFORNIA  Electrical Power Distribution  CEC-NRCC-ELC-01-E (Revised 05/15)	CALIFORNIA ENERGY COMMISSION
CERTIFICATE OF COMPLIANCE	NRCC-ELC-01-E
Electrical Power Distribution	(Page 5 of 7)
Project Name: LifeMoves Maple Street	Date Prepared: 7-26-2016

#### E. Voltage Drop

☐ Attach voltage drop worksheet to this form,

☐ Field inspector has discretion to approve the worksheets; the tables shown below in this section are advisory only ☐ Feeder conductors and branch circuits that are dedicated to emergency services are exempt from these requirements.

☐ An advisory table of typical power factors is shown below		
	Fiel	d
	Inspector	
	Pass	Fail
Feeders. Feeder conductors shall be sized for a maximum voltage drop of 2 percent at design load.		
Branch Circuits. Branch circuit conductors shall be sized for a maximum voltage drop of 3 percent at design load.		

	Default Power Factor	Default Power Factor	
Load Type	at 120 volts	at 277 volts	Clarifying Notes
Fluorescent lighting	0.95	0.95	
Compact	0.9 (hardwired)	0.9 (hardwired)	
fluorescent lighting	0.5 (GU-24)	0.3 (GU-24)	NPF magnetic ballasts use GU-24 values
LED lighting	0.7	0.5	May be higher if specifications call for high power factor drivers
Incandescent lighting	1.0	1.0	
HID lighting	0.9	0.9	May be lower if NPF ballasts are specified
HVAC packages	0.85	0.9	
Other motors <5 HP	0.8	0.8	
Other motors >5 HP	0.85	0.85	
Kitchen equipment	0.9	N/A	
Receptacles	0.6	N/A	For dedicated receptacles, may be rated according to the load
Electric heating including hot water	1.0	1.0	
Other	0.85	0.85	

CA Building Energy Efficiency Standards - 2013 Nonresidential Compliance

STATE OF CALIFORNIA	_
Electrical Power Distribution	
CEC-NRCC-ELC-01-E (Revised 05/15)	CALIFORNIA ENERGY COMMISSION
CERTIFICATE OF COMPLIANCE	NRCC-ELC-01-E
Electrical Power Distribution	(Page 6 of 7)
Project Name: LifeMoves Maple Street	Date Prepared: 7-26-2016

#### F. Circuit Controls for 120-Volt Receptacles

☑ Controlled 120 volt receptacles shall be provided, as required by Section 130.5(d) of the Standards.

☐ In open office areas, controlled circuit receptacles are not required if, at time of final permit, workstations are installed, and each workstation is equipped with an occupant sensing control that is permanently mounted in each workstation, and which controls a hardwired, nonresidentialrated power strip. Plug-in strips and other plug-in devices that incorporate an occupant sensor shall not be used for this exception.

☐ Receptacles that are only for the following purposes are exempt: -Receptacles specifically for refrigerators and water dispensers in kitchenettes.

-Receptacles located a minimum of six feet above the floor that are specifically for clocks.

-Receptacles for network copiers, fax machines, A/V and data equipment other than personal computers in copy rooms.

		Fie	eld
		Inspe	ector
		Pass	Fail
1.	At least one controlled receptacle is installed within 6 feet of each uncontrolled receptacle, or split-wired duplex receptacles are installed, that have one controlled and one uncontrolled receptacle. This applies in all of the following spaces:  • Private offices, open office areas  • Receptions and lobbies  • Conference rooms		_
	<ul><li>Kitchenettes in office spaces</li><li>Copy room</li></ul>		
2.	Electric circuits serving controlled receptacles are equipped with automatic shut-OFF controls following the requirements prescribed in Section 130.1(c)1 through 5 (in many cases this will mean that the receptacles are connected to the same automatic shut-OFF system as the general lighting of the space).		
3.	Controlled receptacles shall have a permanent marking to differentiate them from uncontrolled receptacles.		
4.	For open office areas, controlled circuits shall be provided and marked to support installation and configuration of office furniture with receptacles that comply with Section 130.5(d) 1, 2, and 3.	0	
5.	For hotel and motel guest rooms at least one-half of the 120-volt receptacles in each guest room are controlled receptacles that comply with Section 130.5(d)1, 2, and 3 (see numbers 1,2 and 3 above). Electric circuits serving controlled receptacles have captive card key controls, occupancy sensing controls, or automatic controls such that, no longer than 30 minutes after the guest room has been vacated, power is switched off.		
6.	Plug-in strips and other plug-in devices that incorporate an occupant sensor are not used to comply with any of these requirements.		_

CA Building Energy Efficiency Standards - 2013 Nonresidential Compliance

STATE OF CALIFORNIA **Electrical Power Distribution** CALIFORNIA ENERGY COMMISSION CEC-NRCC-ELC-01-E (Revised 05/15) CERTIFICATE OF COMPLIANCE NRCC-ELC-01-E Electrical Power Distribution (Page 7 of 7) Date Prepared: 7-26-2016 LifeMoves Maple Street


. I certify that this Certificate of Compliance document	ation is accurate and complete.	
Documentation Author Name:  Tantech Engineers  Documentation Author Signature:		
Tantech Engineers	Signature Date:	
ddress: 1431 Cedar St	CEA/ HERS Certification Identification (if applicable):	
ity/State/Zip:	Phone:	
San Carlos, CA 94070	415-269-4283	

ertify the following under penalty of perjury, under the laws of the State of California 1. The information provided on this Certificate of Compliance is true and correct.

- 2. I am eligible under Division 3 of the Business and Professions Code to accept responsibility for the building design or system design identified on this Certificate of Compliance (responsible designer).
- 3. The energy features and performance specifications, materials, components, and manufactured devices for the building design or system design identified on this Certificate of Compliance conform to the requirements of Title 24, Part 1 and Part 6 of the California Code of Regulations.
- The building design features or system design features identified on this Certificate of Compliance are consistent with the information provided on other applicable compliance documents, worksheets, calculations, plans and specifications submitted to the enforcement agency for approval with this building permit application.
- I will ensure that a completed signed copy of this Certificate of Compliance shall be made available with the building permit(s) issued for the building, and made available to the enforcement agency for all applicable inspections. I understand that a completed signed copy of this Certificate of Compliance is required to be included with the documentation the builder provides to the building owner at occupancy.

Responsible Designer Name: Tantech Engineers	Responsible Designer Signature:
Company: Tantech Engineers	Date Signed:
Address: 1431 Cedar St	License:
City/State/Zip: Ph San Carlos, CA 94070	Phone: 415-269-4283

CA Building Energy Efficiency Standards - 2013 Nonresidential Compliance

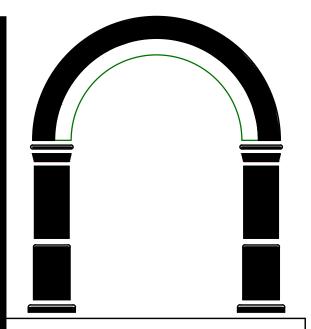

CJ W ARCHITECTURE

130 Portola Road, suite A Portola Valley, CA 94028 (650) 851-9335 / (Fax) 851-9337

#### Tantech Engineers MEP CONSULTING **ENGINEERS**

1431 Cedar Street San Carlos, CA 94070 (415) 269-4283

These plans are copyrighted and are subject to copyright otection as an "architectural work" under Sec. 102 of the opyright Act, 17 U.S.O. as amended December 1990 and known as Architectural Works Copyright Protection Act of 1990. The protection includes but is not limited to the verall form as well as the arrangement and composition of paces and elements of the design. Under such protection, nauthorized use of these plans, work or home represented, an legally result in the cessation of construction or building eing seized and /or monetary compensation to CJW

## • PROJECT •

LifeMoves Maple Street Shelter 1580 Maple Street Redwood City CA 94063

• SHEET TITLE •

Title 24 Lighting

#### • REVISIONS •

Notes BLDG SUBMITTAL 1 PLAN CHECK # 1 ADDENDUM # 3 ADDENDUM # 5


8.25.16


PLAN CHECK #2 ADDENDUM # 6

• JOB: 2015.2801

° DATE: 06/17/16

• SHEET: **E4.6** 

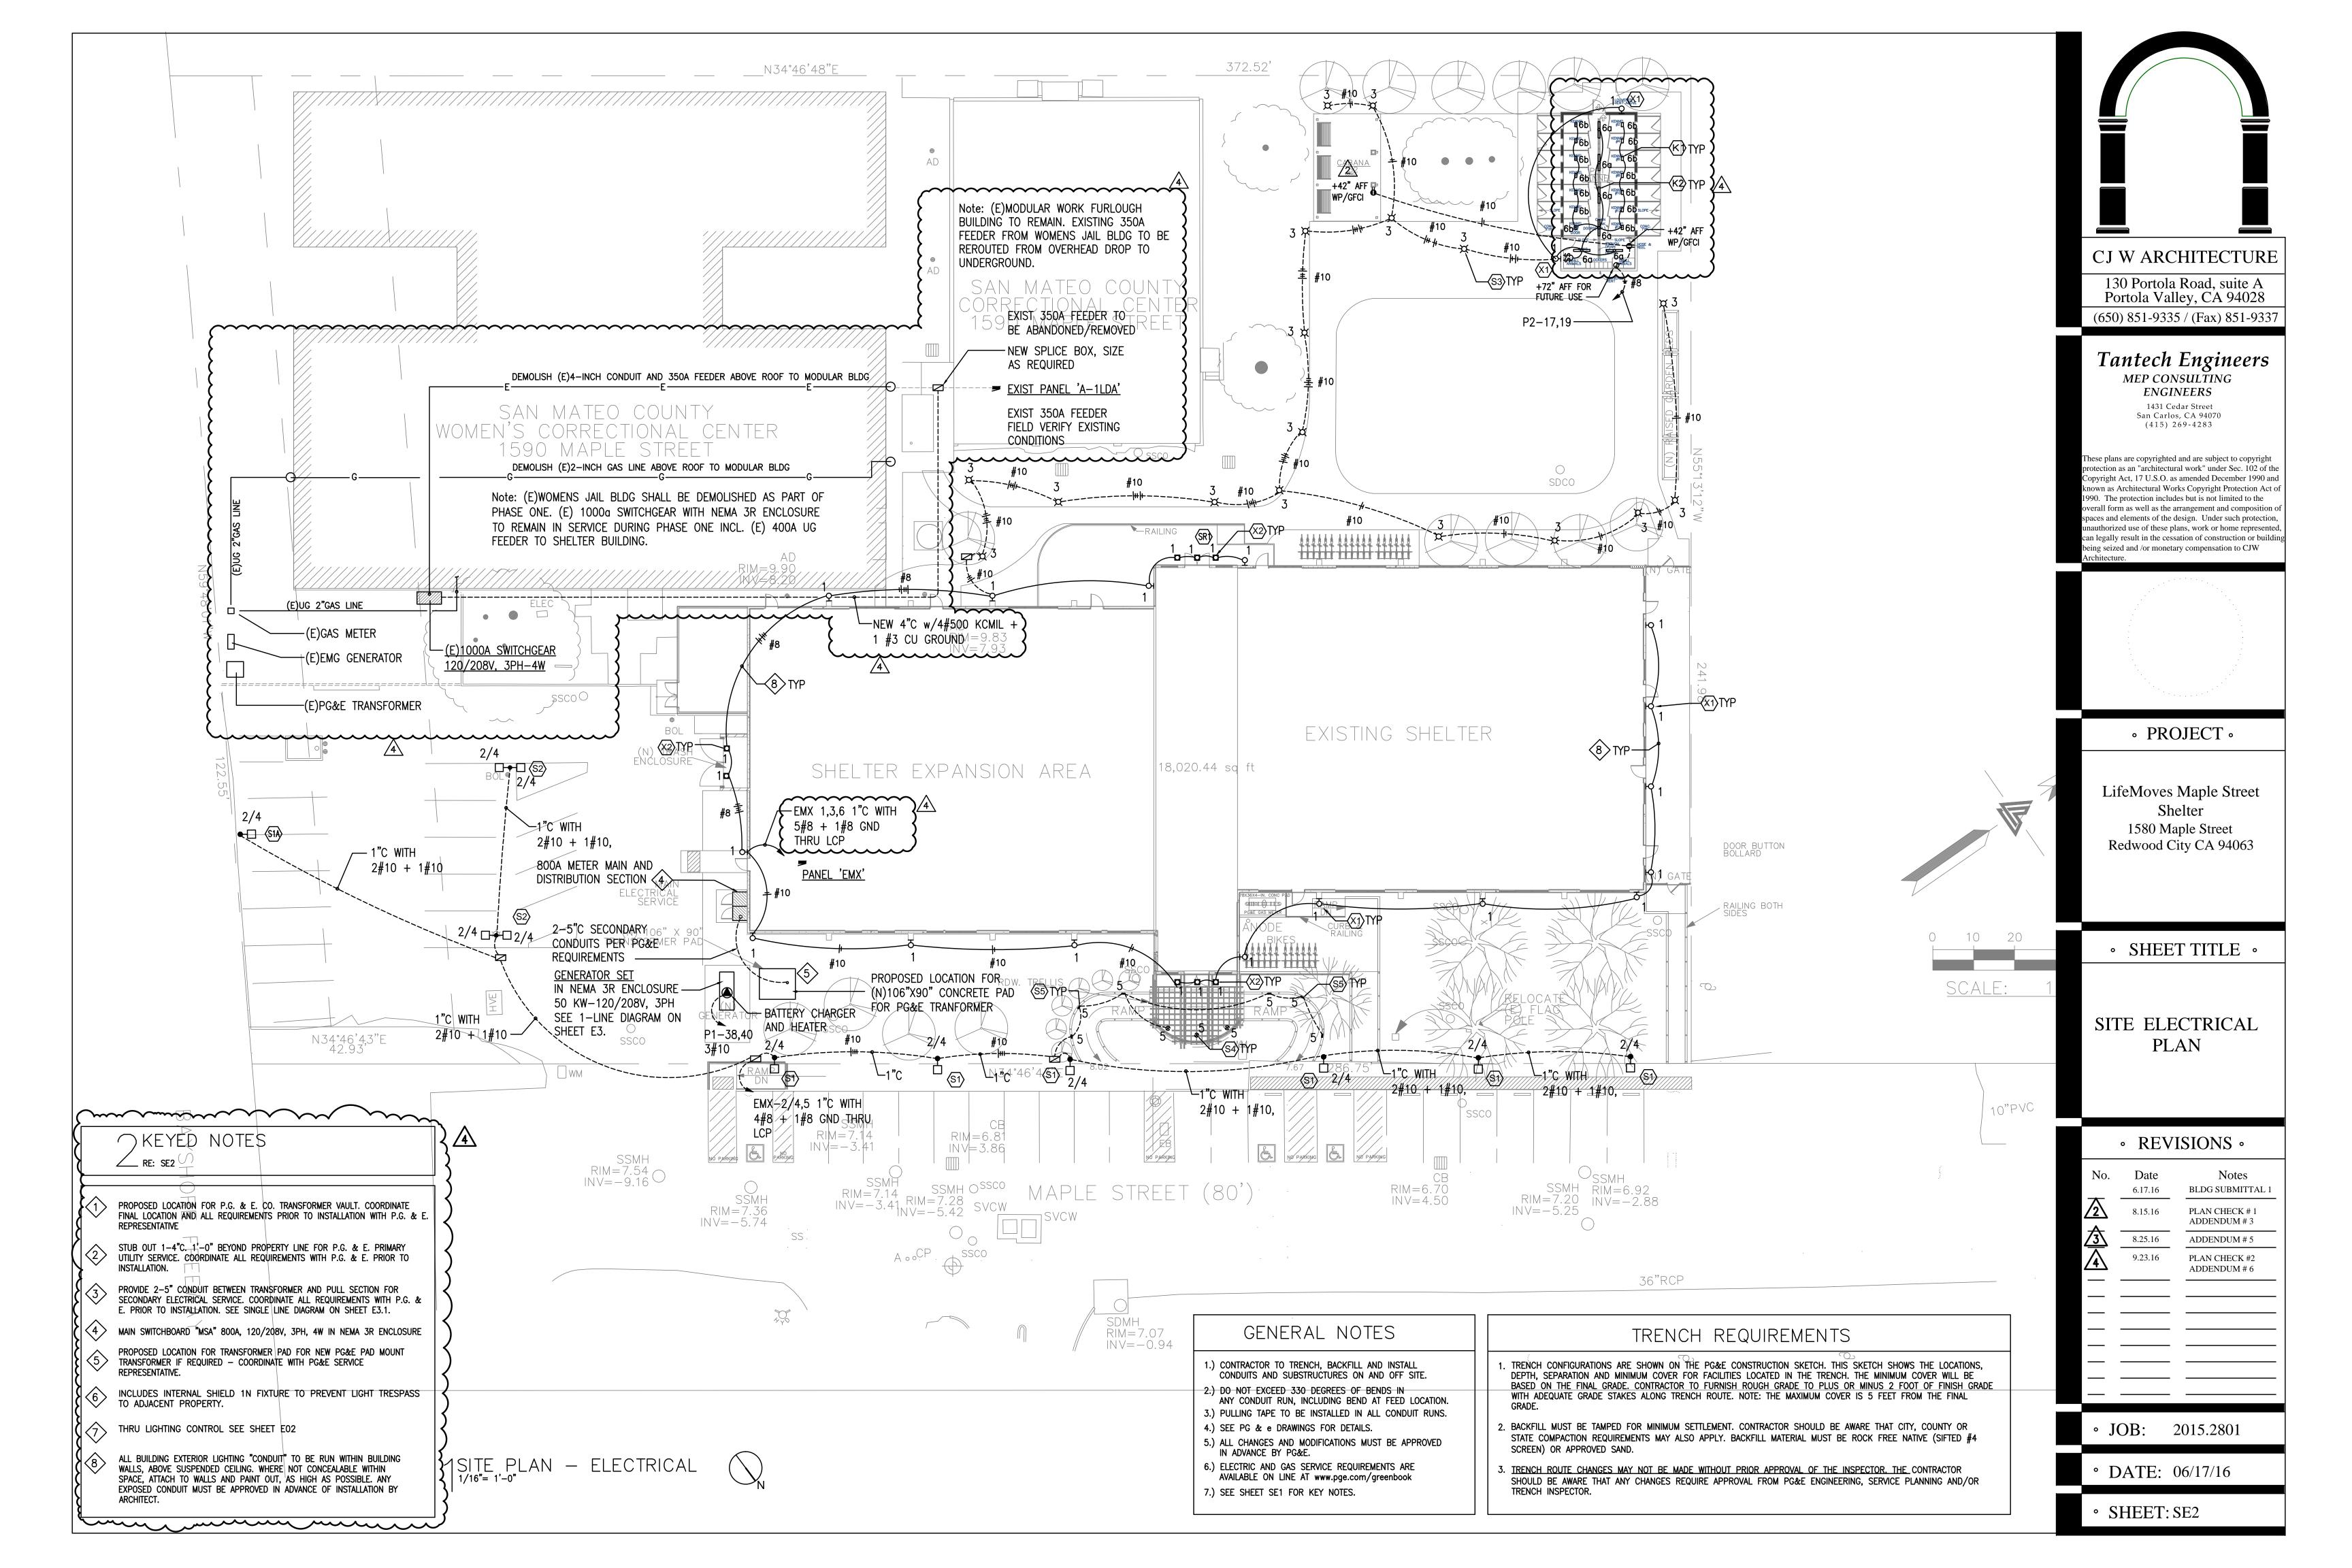


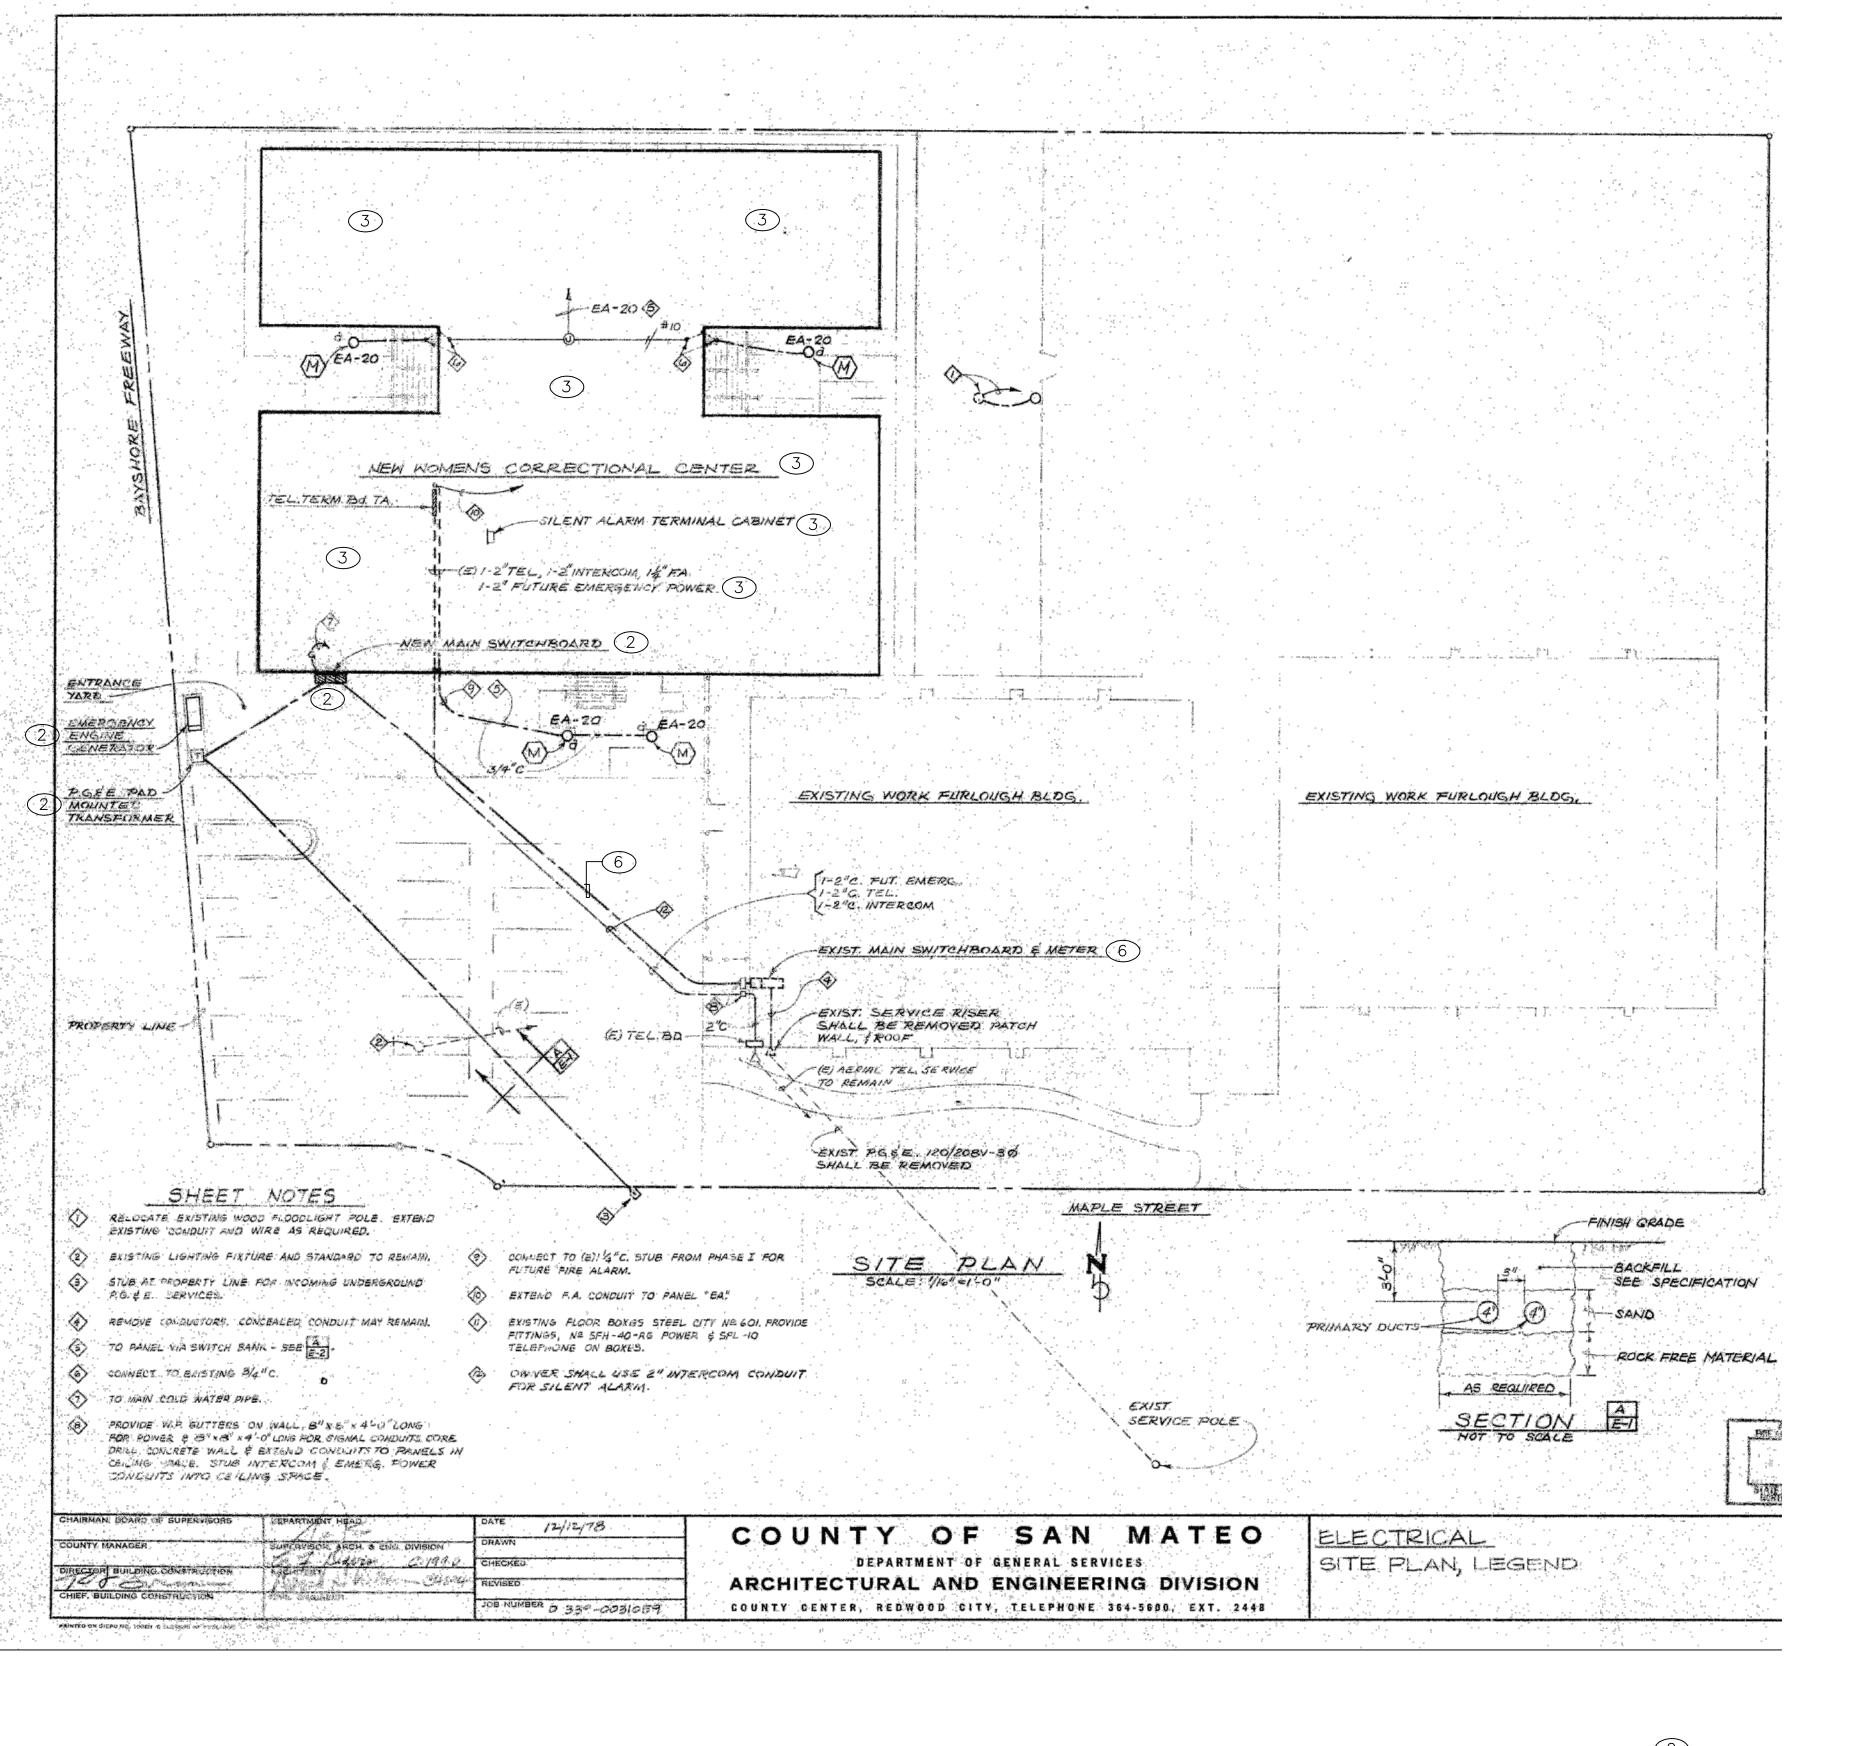

## Existing Jail Building Electrical Site Plan - Demolition

NOT TO SCALE



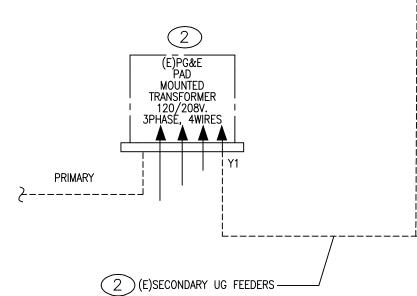

#### **KEYED SHEET NOTES:**

- 1) THE PLAN SHOWN ON THIS SHEET IS TAKEN FROM AVAILABLE RECORD DRAWINGS DATED 1978 FOR THE EXISTING WOMEN'S JAIL BUILDING WHICH SHALL BE DEMOLISHED AS PART OF PHASE ONE OF THIS PROJECT. THE CONTRACTOR SHALL PERFORM THE NECESSARY SITE VISITS TO FIELD VERIFY EXISTING CONDITIONS AND SHALL NOT RELY ON THIS DRAWING FOR 100% ACCURATE AS BUILT CONDITIONS.
- (2) THE EXISTING 1000A SERVICE AT 120/208V-3PH-4W AT WOMEN'S JAIL BUILDING, THE EXISTING OUTDOOR SWITCHGEAR WITH NEW 3R ENCLOSURE, THE EXISTING PAD MOUNT PG&E UTILITY TRANSFORMER, AND THE EXISTING EMERGENCY GENERATOR SET NEXT TO TRANSFORMER SHALL REMAIN.
- THE CONTRACTOR SHALL DEMOLISH AND REMOVE ALL EXISTING ELECTRICAL EQUIPMENT, WIRING, CIRCUITS, CONDUITS, LIGHTING FIXTURES INSIDE OF THE EXISTING WOMEN'S JAIL BUILDING. DISCONNECT AND SAFE OFF THE BREAKERS ASSOCIATED WITH THE BUILDING AS SHOWN ON SINGLE LINE DIAGRAM BELOW — VERIFY IN FIELD.
- (4) THE CONTRACTOR SHALL DEMOLISH AND REMOVE ALL EXISTING ELECTRICAL EQUIPMENT, WIRING, CIRCUITS, CONDUITS, LIGHTING FIXTURES INSIDE OF THE EXISTING WOMEN'S JAIL BUILDING. DISCONNECT AND SAFE OFF THE BREAKERS ASSOCIATED WITH THE BUILDING AS SHOWN ON SINGLE LINE DIAGRAM BELOW — VERIFY IN FIELD.
- THE CONTRACTOR SHALL DEMOLISH AND REMOVE EXISTING FEEDER FROM MSA TO EXISTING PANEL AT KITCHEN IN ADJACENT SHELTER BUILDING. VERIFY LOCATION OF PANEL IN SHELTER BUILDING AND DEMOLISH AND REMOVE THIS PANEL AND ALL ASSOCIATED CIRCUITS, WIRING, CONDUITS. SAFE OFF EXISTING 225A/3P BREAKER IN EXISTING MSA.
- (6) EXISTING UNDERGROUND 400A FEEDER AND EXISTING 400A/3P BREAKER AT MSA, AND EXISTING PANEL 1LDE IN ELECTRICAL CLOSET IN SHELTER BUILDING TO REMAIN DURING PHASE 1 OF PROJECT.
- 7) EXISTING FEEDER AND (E)4"CONDUIT THAT RUNS FROM MSA TO EXISTING MODULAR WORK FURLOUGH BLDG SHALL BE DEMOLISHED UP TO EXTERIOR JUNCTION/PULL BOX OUTSIDE OF WOMEN'S JAIL BLDG. THE EXISTING 350A/3P BREAKER SHALL REMAIN AND SHALL BE RECONNECTED TO A NEW UNDERGROUND FEEDER FROM MSA TO THE MODULAR WORK FURLOUGH BUILDING. THIS WORK SHALL BE DONE UNDER PHASE 1B OF PROJECT ALONG WITH RECONNECTING GAS LINE TO SAME BUILDING FROM EXISTING GAS METER . THE EXISTING 4-INCH CONDUIT RUNS ABOVE WOMEN'S JAIL BLDG AND RUNS DOWN TO EAST SIDE OF BLDG AND UNDERGROUND TO MODULAR WORK FURLOUGH BLDG.

SINGLE LINE DIAGRAM NOTES: WERE NOT AVAILABLE TO ENGINEER. THE CONTRACTOR SHALL UTILIZE THIS INFORMATION FOR REFERENCE ONLY AND SHALL


THIS SINGLE LINE DIAGRAM IS RECREATED FROM VISUAL OBSERVATIONS ONLY AND AS BUILT SINGLE LINE DIAGRAMS - (E)UNDERGROUND 2 PULL SECTION STILL BE RESPONSIBLE FOR FIELD VERIFICATION OF ALL EXISTING CONDITIONS. EXISTING MAIN SWITCHBOARD "MSA" -1000A, 120/208V-3Ø-4W CU BUSS, NEMA 3R ENCLOSURE (E)1000A BUSS 2 (E)METER

H NEUTRAL DISCONNECTILINK 6 3 WOMEN'S JAIL BLDG (E)GROUNDING 2 (E)PANEL B (E)EMG PANEL (E)PANEL A WOMEN'S JAIL ÈA - WOMEN'S KITCHEN AT WOMEN'S JAIL SHELTER BLDG JAIL BLDG 7 PROVIDE NEW 4"C w/4#500 KCMIL +1 # 3

Existing Jail Building Single Line Diagram - Demolition

NOT TO SCALE

(E)400A PANEL 1LDE SHELTER BLDG

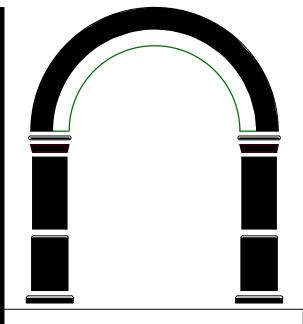

CJ W ARCHITECTURE

130 Portola Road, suite A Portola Valley, CA 94028 (650) 851-9335 / (Fax) 851-9337

#### Tantech Engineers MEP CONSULTING

**ENGINEERS** 1431 Cedar Street

San Carlos, CA 94070 (415) 269-4283

These plans are copyrighted and are subject to copyright rotection as an "architectural work" under Sec. 102 of the opyright Act, 17 U.S.O. as amended December 1990 and known as Architectural Works Copyright Protection Act of 990. The protection includes but is not limited to the verall form as well as the arrangement and composition of paces and elements of the design. Under such protection, nauthorized use of these plans, work or home represented, an legally result in the cessation of construction or building eing seized and /or monetary compensation to CJW

#### • PROJECT •

LifeMoves Maple Street Shelter 1580 Maple Street Redwood City CA 94063

#### SHEET TITLE

Jail Building Electrical Site Plan -**Demolition Work** 

### • REVISIONS •

No.	Date 6.17.16	Notes BLDG SUBMITTAL 1
2	8.15.16	PLAN CHECK # 1 ADDENDUM # 3
<u> </u>	8.25.16	ADDENDUM # 5
4	9.23.16	PLAN CHECK #2 ADDENDUM # 6
4		

JOB: 2015.2801

DATE: 06/17/16

• SHEET: {JDE-1}